


INDEX OF SHEETS

- 1 TITLE SHEET
- 2 QUANTITY SHEET
- 3 DRAINAGE SUMMARY SHEET
- 4 GENERAL PROJECT LAYOUT
- 5 CONSTRUCTION PHASING PLAN
- 6 GENERAL CONSTRUCTION & SAFETY NOTES
- 7-9 TYPICAL SECTIONS & DETAILS
- 10-11 TAXIWAY PROFILE
- 12-13 PAVING PLANS & GEOMETRIC LAYOUT
- 14-16 GRADING & DRAINAGE PLANS
- 17 DRAINAGE DETAILS
- 18 SEDIMENT & EROSION CONTROL DETAILS
- 19-20 PAVEMENT MARKING PLAN
- 21-22 AIRFIELD LIGHTING PLANS
- 23-25 AIRFIELD LIGHTING DETAILS
- 26 VAULT WIRING DIAGRAM
- 27 VAULT WIRING DETAILS
- 28 BORING LOGS
- 29 BORING LOGS
- 30-36 CROSS SECTIONS
- 37 WASTE AREA LAYOUT
- 38-40 WASTE AREA CROSS SECTIONS

VAOT STANDARD DRAWINGS

- AP-3 MISCELLANEOUS AIRPORT DETAILS
- AP-4 VISUAL APPROACH AIDS
- AP-11 TAXIWAY AND APRON MARKING DETAILS
- D-1 PRECAST REINFORCED CONCRETE PIPE DROP INLET W/ C.I. GRATE
- D-2 UNDERDRAIN AND CARRIER PIPE CONSTRUCTION DETAILS
- D-3 TREATED GUTTERS
- D-4 UNDERDRAIN FLUSHING BASIN
- D-15 PRECAST REINFORCED CONCRETE MANHOLE W/ CAST IRON COVER
- D-16 ENERGY DISSIPATOR FOR CULVERTS
- E-100 CONSTRUCTION APPROACH SIGNS
- E-121 STANDARD SIGN PLACEMENTS
- T-1 TEMPORARY EROSION CONTROL DETAILS
- T-2 TEMPORARY EROSION CONTROL DETAILS

STATE OF VERMONT AGENCY OF TRANSPORTATION

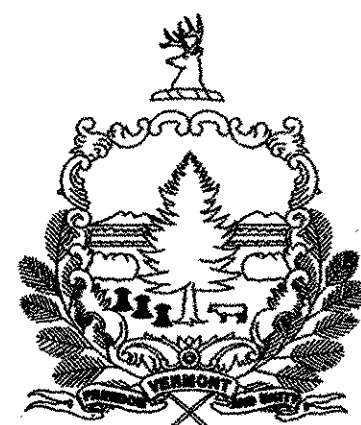

PROPOSED IMPROVEMENTS RUTLAND STATE AIRPORT CLARENDON, VERMONT AIR 04-3154 CONTRACT 1


PROJECT DESCRIPTION:

PROJECT 'A'


- (1) CONSTRUCT, MARK AND LIGHT PARTIAL PARALLEL TAXIWAY 'F' (WEST) TO RUNWAY 13 (35' X 1314 L.F.)

PROJECT 'B'

- (1) CONSTRUCT, MARK AND LIGHT PARTIAL PARALLEL TAXIWAY 'F' (EAST) BETWEEN TAXIWAY 'A' AND RUNWAY 1-19 (50' X 763 L.F.)
- (2) RECONSTRUCT TAXIWAY 'A' (50' X 240 L.F.)
- (3) EXPAND TERMINAL APRON (5100 S.Y.)
- (4) NEW WIND CONE AND SEGMENTED CIRCLE.

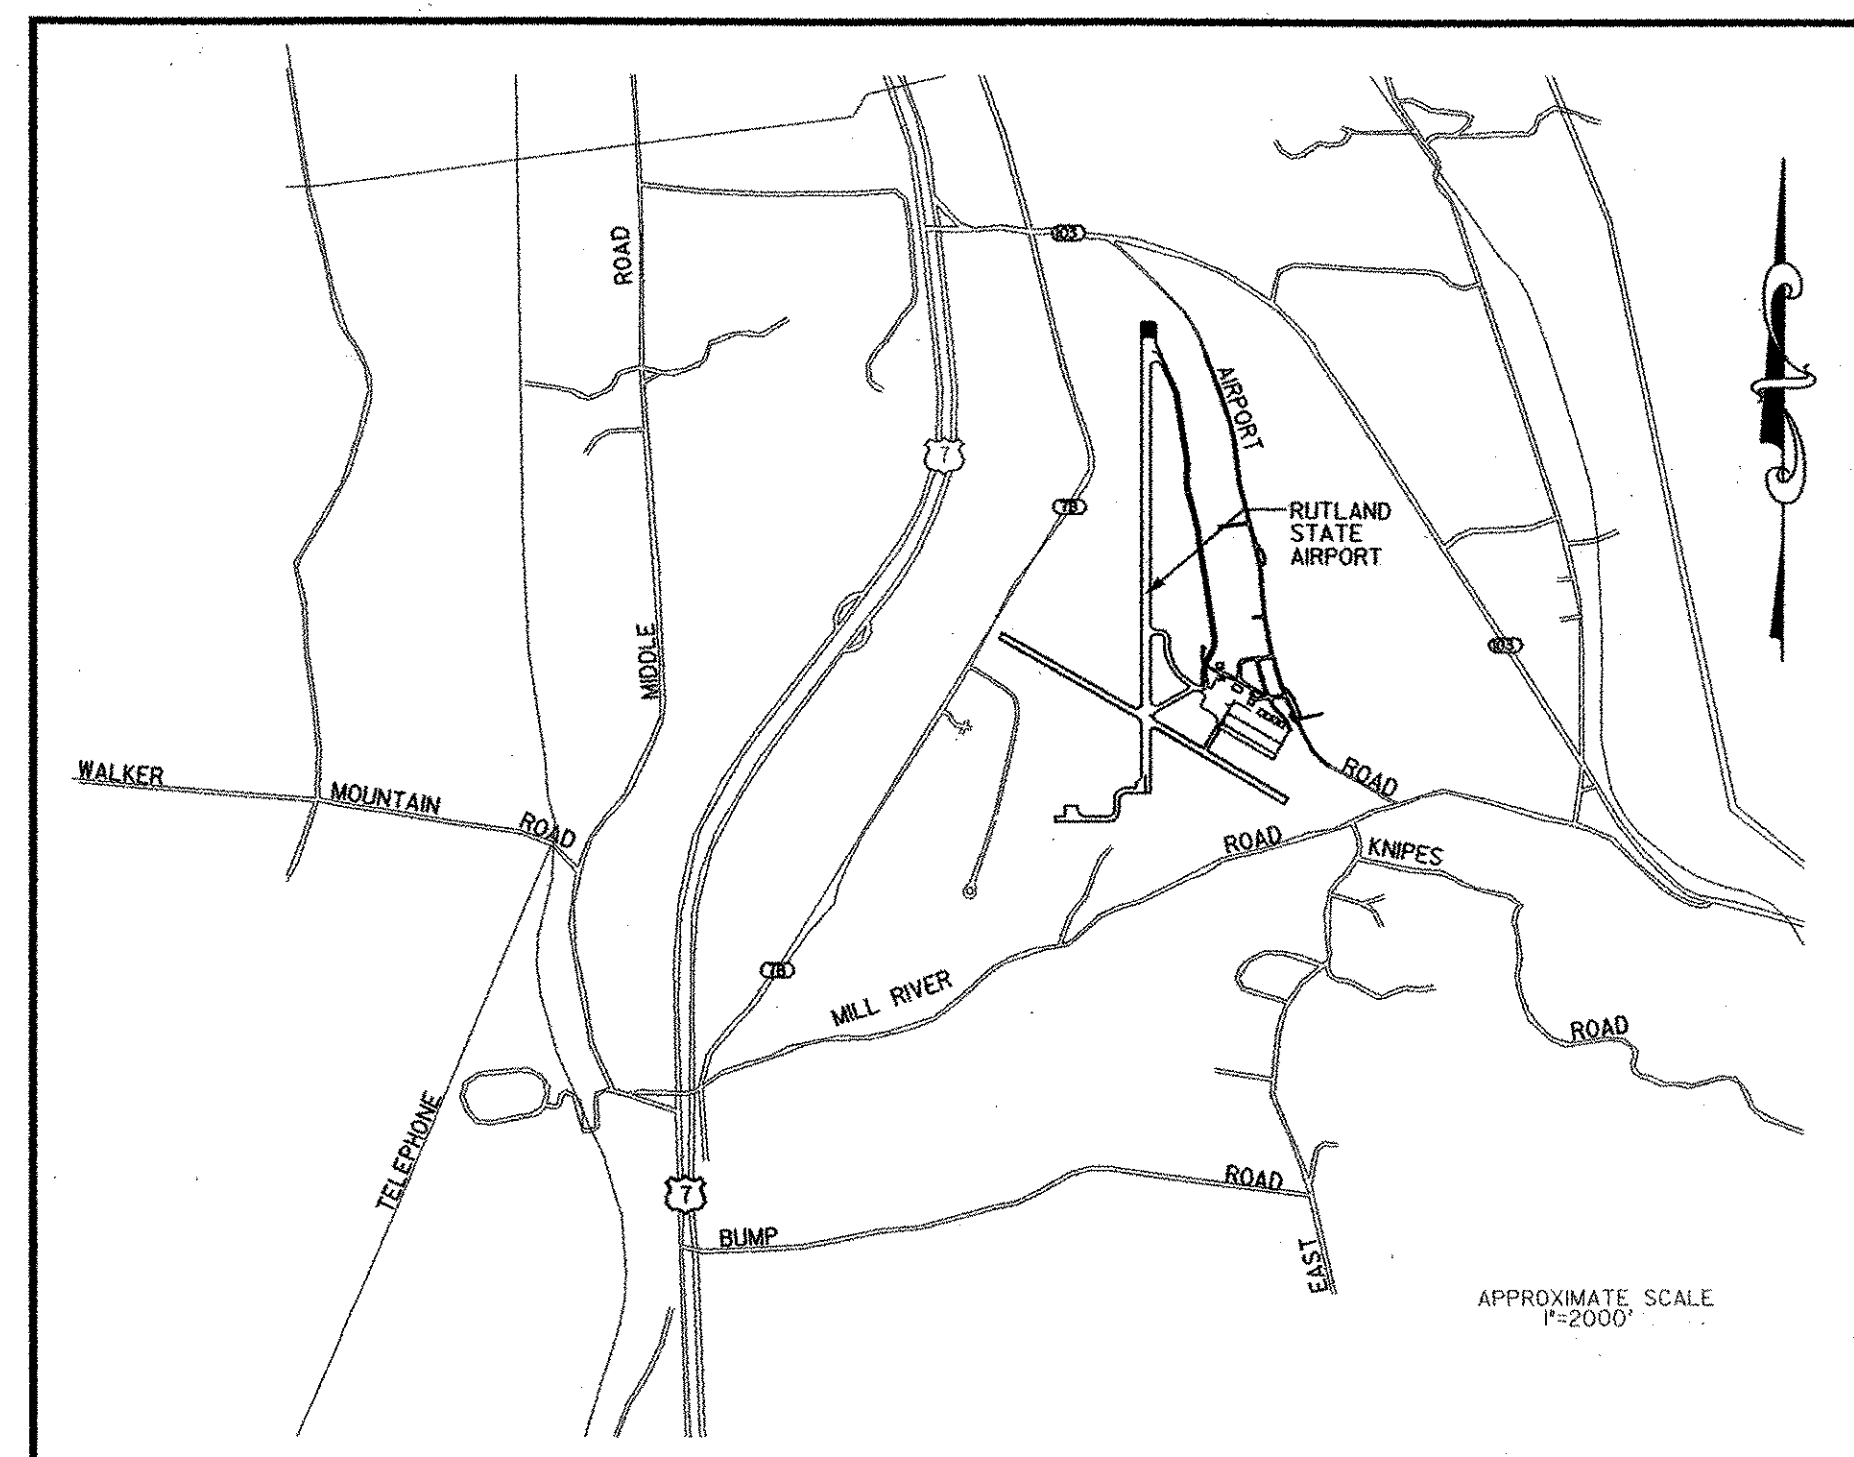

LOCATION MAP
NTS

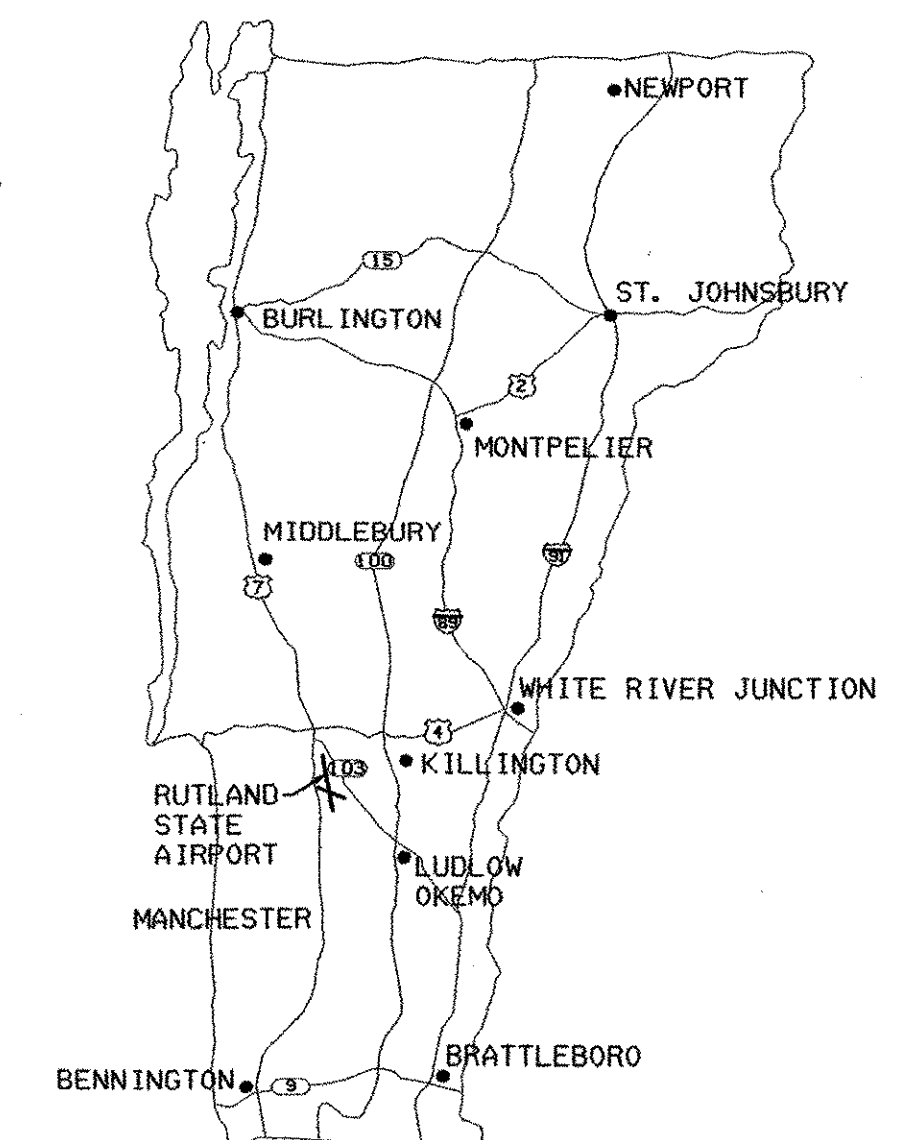

RECORD PLANS

CONTRACTOR: MUNSON EARTH MOVING CORP.

RESIDENT ENGINEER: *For* CHRIS BUMP

CONSTRUCTION BEGAN: JUNE 23, 2003

CONSTRUCTION COMPLETE:

RECORD PLANS BY: K. NORTH, N. GARBACIK

I HEREBY CERTIFY THAT ALL THE CONSTRUCTION REQUIRED BY THIS SET OF DRAWINGS HAS BEEN ACCOMPLISHED AS INDICATED HEREIN.

BY *For* RESIDENT ENGINEER

DATE 01-07-2005

NOTE: Any further information concerning final quantities, amounts or other details relative to this project may be found at Central Files in the electronic archives.

DESIGN CERTIFICATION

THESE PLANS AND SPECIFICATIONS HAVE BEEN PREPARED IN ACCORDANCE WITH CURRENT FAA STANDARDS IDENTIFIED IN ADVISORY CIRCULAR CHECKLIST, AC 00-2.12, DATED JULY, 1999. DEVIATIONS FROM FAA STANDARDS ARE DISCUSSED IN THE ENGINEERS REPORT, DATED FEBRUARY 2002.


For
URS CORPORATION

18 February 2003
DATE

STANDARD NOTE

THESE PLANS ARE SUBJECT TO SUCH ENGINEERING CHANGES AS MAY BE REQUIRED BY THE FEDERAL AVIATION ADMINISTRATION OR THE DIRECTOR OF OPERATIONS DIVISION.

CONSTRUCTION IS TO CARRIED ON IN ACCORDANCE WITH THESE PLANS AND THE STANDARD SPECIFICATION FOR CONSTRUCTION, DATED 2001, AS APPROVED BY THE FEDERAL HIGHWAY ADMINISTRATION ON JANUARY 3, 2001 FOR USE ON THIS PROJECT, INCLUDING ALL SUBSEQUENT REVISIONS AND SUCH REVISED SPECIFICATIONS AND SPECIAL PROVISIONS AS ARE INCORPORATED IN THESE PLANS.

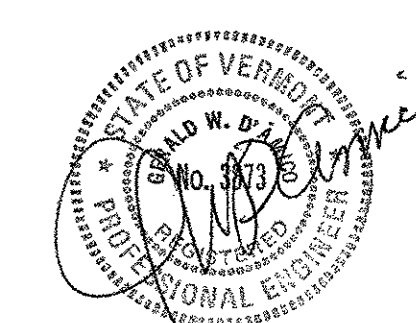

STATE OF VERMONT
APPROVED

David J. Davis
DIRECTOR, OPERATIONS DIVISION
2/20/03
DATE

[illegible]

CLARENCE, VERMONT

RUTLAND STATE AIRPORT

URS
1 NORTHWAY LN.
LATHAM, NEW YORK

Designed by: S.W.D.
Drawn by: M.G.M.
Checked by: M.K.C.
Approved by: S.W.D.

Scale: N/A

Date: FEB., 2003

Sheet 2 OF 40

Sheet No
2

A.I.P. 3-50-0015-17

PROJECT "B" TAXIWAY "F" (EAST) AND TAXIWAY "A"

CULVERTS AND STORM DRAINS							
LOCATION		SIZE & TYPE	LENGTH	FLOW LINE		TRENCH EXCAVATION CY	REMARKS
BEGIN	END			@ INLET	@ OUTLET		
183' LT 420+48	183' LT 420+72	15" RCP	24 LF	775.80	775.80	45 12	BETWEEN D1109 AND D1110
183' LT 420+48	125' RT 421+80	24" RCP	330 LF 328	775.54	774.20	272 356	BETWEEN D1111 AND D1112
114' LT 34+20	114' LT 37+80	30" RCP	360 LF 351	773.70	772.60	600 599	BETWEEN D1112 AND D1113
114' LT 37+80	114' LT 41+40	30" RCP CPEP (SL)	360 LF 368	772.60	771.50	620 605	BETWEEN D1113 AND D1114
114' LT 41+40	114' LT 45+00	30" RCP CPEP (SL)	360 LF 359	771.50	770.40	600 658	BETWEEN D1114 AND D1115
114' LT 45+00	75' RT 47+00	30" RCP CPEP (SL)	266 LF 265	770.40	769.60	200 353	D1115 TO OUTLET PLACE STONE FILL AT OUTLET
UNDERDRAIN							
LOCATION		SIZE & TYPE	LENGTH	FLOW LINE		TRENCH EXCAVATION CY	REMARKS
BEGIN	END			@ INLET	@ OUTLET		
FB 6							
57' +/- RT. 114+35	6" U.D.		778.50				CONNECT TO EXIST 6" CPEP UNDERDRAIN
28.5' LT. 416+00	6" U.D.	204 210 LF	777.99		180		INSTALL FB 6A
28.5' LT. 418+50	6" U.D.	280 250 LF	777.01		210		INSTALL FB 6B
230' LT. 419+50 +/-	6" U.D.	189 220 LF	776.00		185		INSTALL FB 6C
250' LT. 419+80 +/-	6" CARRIER PIPE	100 LF 93		774.0 +/-	85 0		TERMINATE @ D1109
WASTE AREA #2	6" CARRIER PIPE	200 LF					

***FINAL QUANTITIES ARE ARCHIVED
WITH THE FIELD BOOKS***

A.I.P. 3-50-0015-17

[illegible]

RUTLAND STATE AIRPORT
CLARENDON, VERMONT

TAXIWAY IMPROVEMENTS
DRAINAGE SUMMARY

URS
1 NORTHWAY LN.
LATHAM, NEW YORK

Designed by: G.W.D.
Drawn by: M.C.M.
Checked by: M.K.C.
Approved by: G.W.D.

Scale: N/A

Date: FEB., 2003

Sheet: 3 OF 40

Sheet No
3




PROJECT DESCRIPTION

PROJECT "A"
 (1) CONSTRUCT, MARK AND LIGHT PARTIAL PARALLEL TAXIWAY
 "F" (WEST) TO RUNWAY 13 (35' x 1314 L.F.)

PROJECT "B"
 (1) CONSTRUCT, MARK AND LIGHT PARTIAL PARALLEL TAXIWAY
 "F" (EAST) BETWEEN TAXIWAY "A" AND RUNWAY 1-19
 (50' x 763 L.F.)
 (2) RECONSTRUCT TAXIWAY "A" (50' x 240 L.F.)
 (3) EXPAND TERMINAL APRON (5100 S.Y.)
 (4) NEW WIND CONE AND SEGMENTED CIRCLE.




NOTES

- TWO (2) TRUCK ENTERING SIGNS TO BE PLACED ON ROUTE 7B AND AIRPORT ROAD APPROXIMATELY 150' AND 75' FROM THE CONTRACTOR'S ENTRANCES TO THE AIRPORT AND WASTE AREA. IN EACH DIRECTION. SIGNS TO BE PLACED AT LEAST 8' OFF ROADWAY EDGE OF PAVEMENT.
- BENCHMARK #1 DISK 650M, 1979
 374614.055N, 1521821.013E
 ELEVATION 782.54
- BENCHMARK #2 DISK 1105, 1987
 378552.173N, 1520976.989E.
 ELEVATION 773.79
 783.36 - DISK 100E

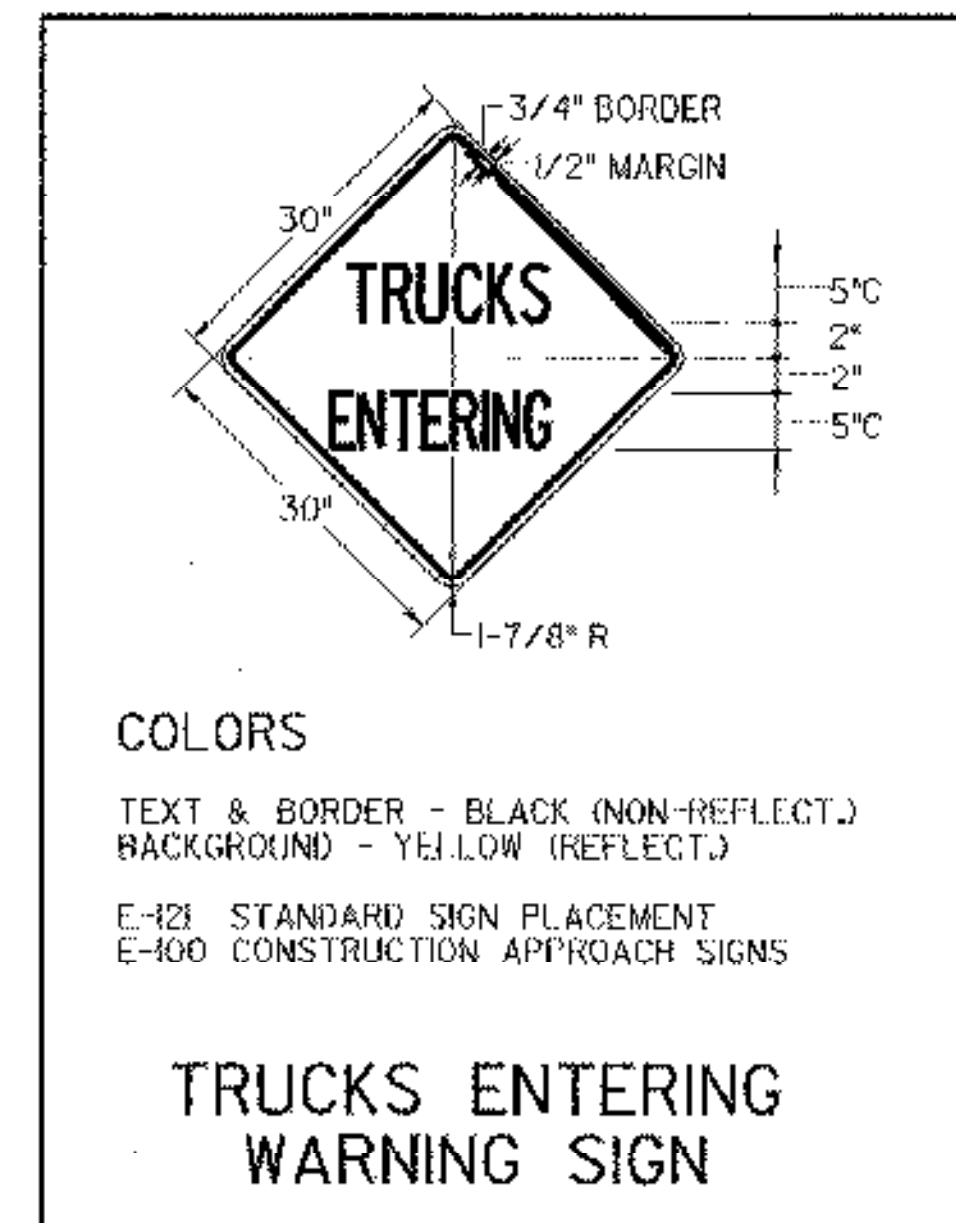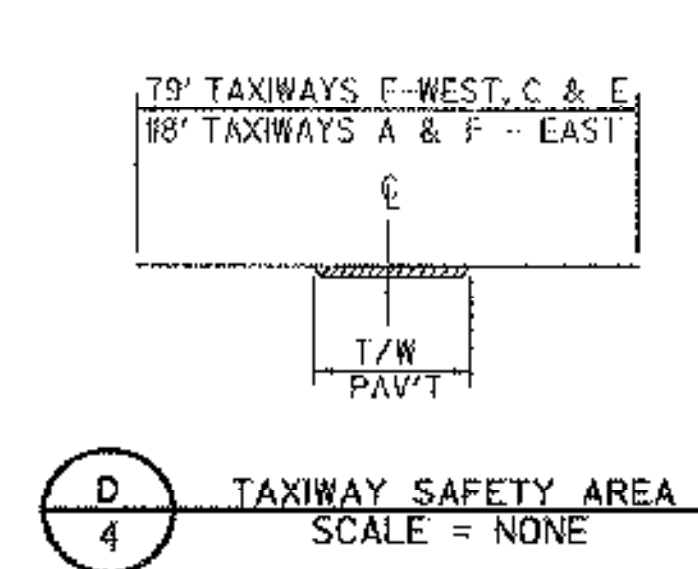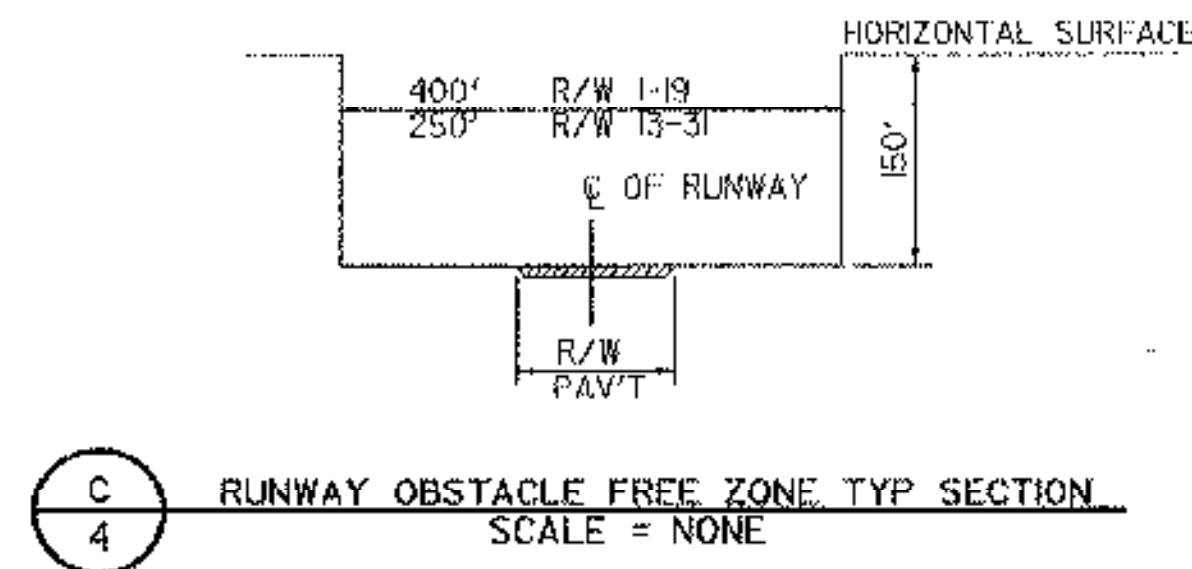

COLORS
 TEXT & BORDER - BLACK (NON-REFLECT.)
 BACKGROUND - YELLOW (REFLECT.)
 E-121 STANDARD SIGN PLACEMENT
 E-100 CONSTRUCTION APPROACH SIGNS

**TRUCKS ENTERING
 WARNING SIGN**

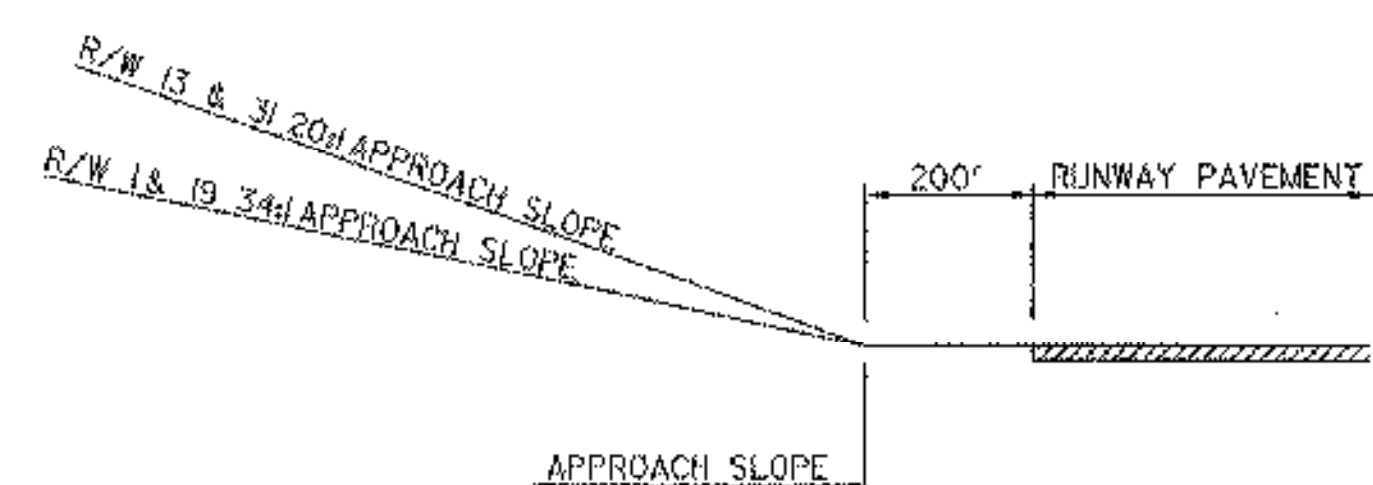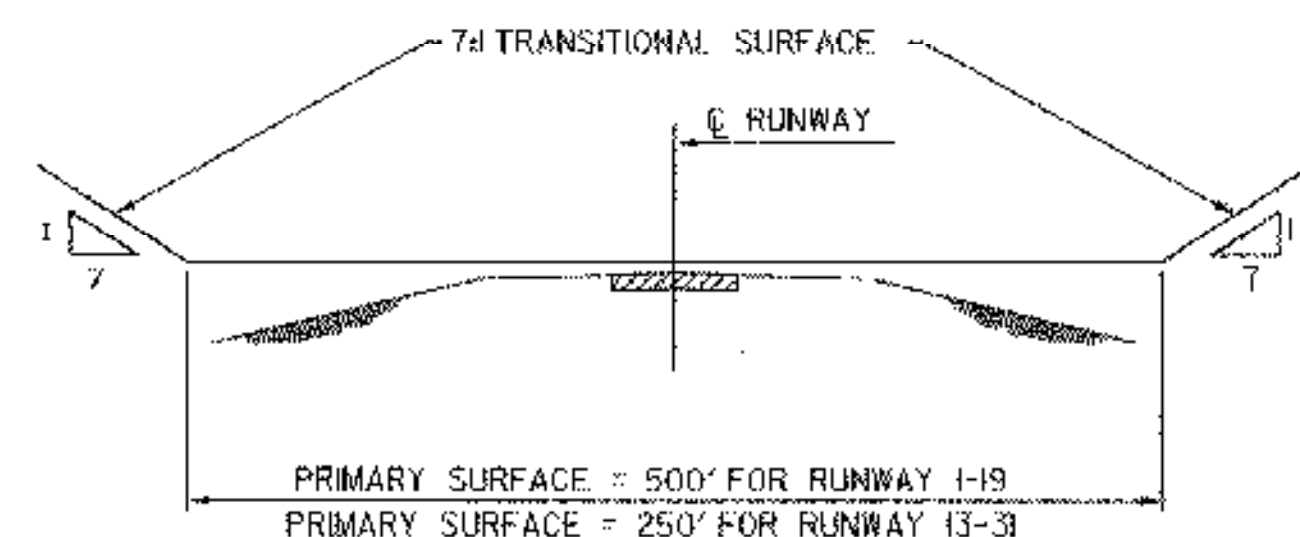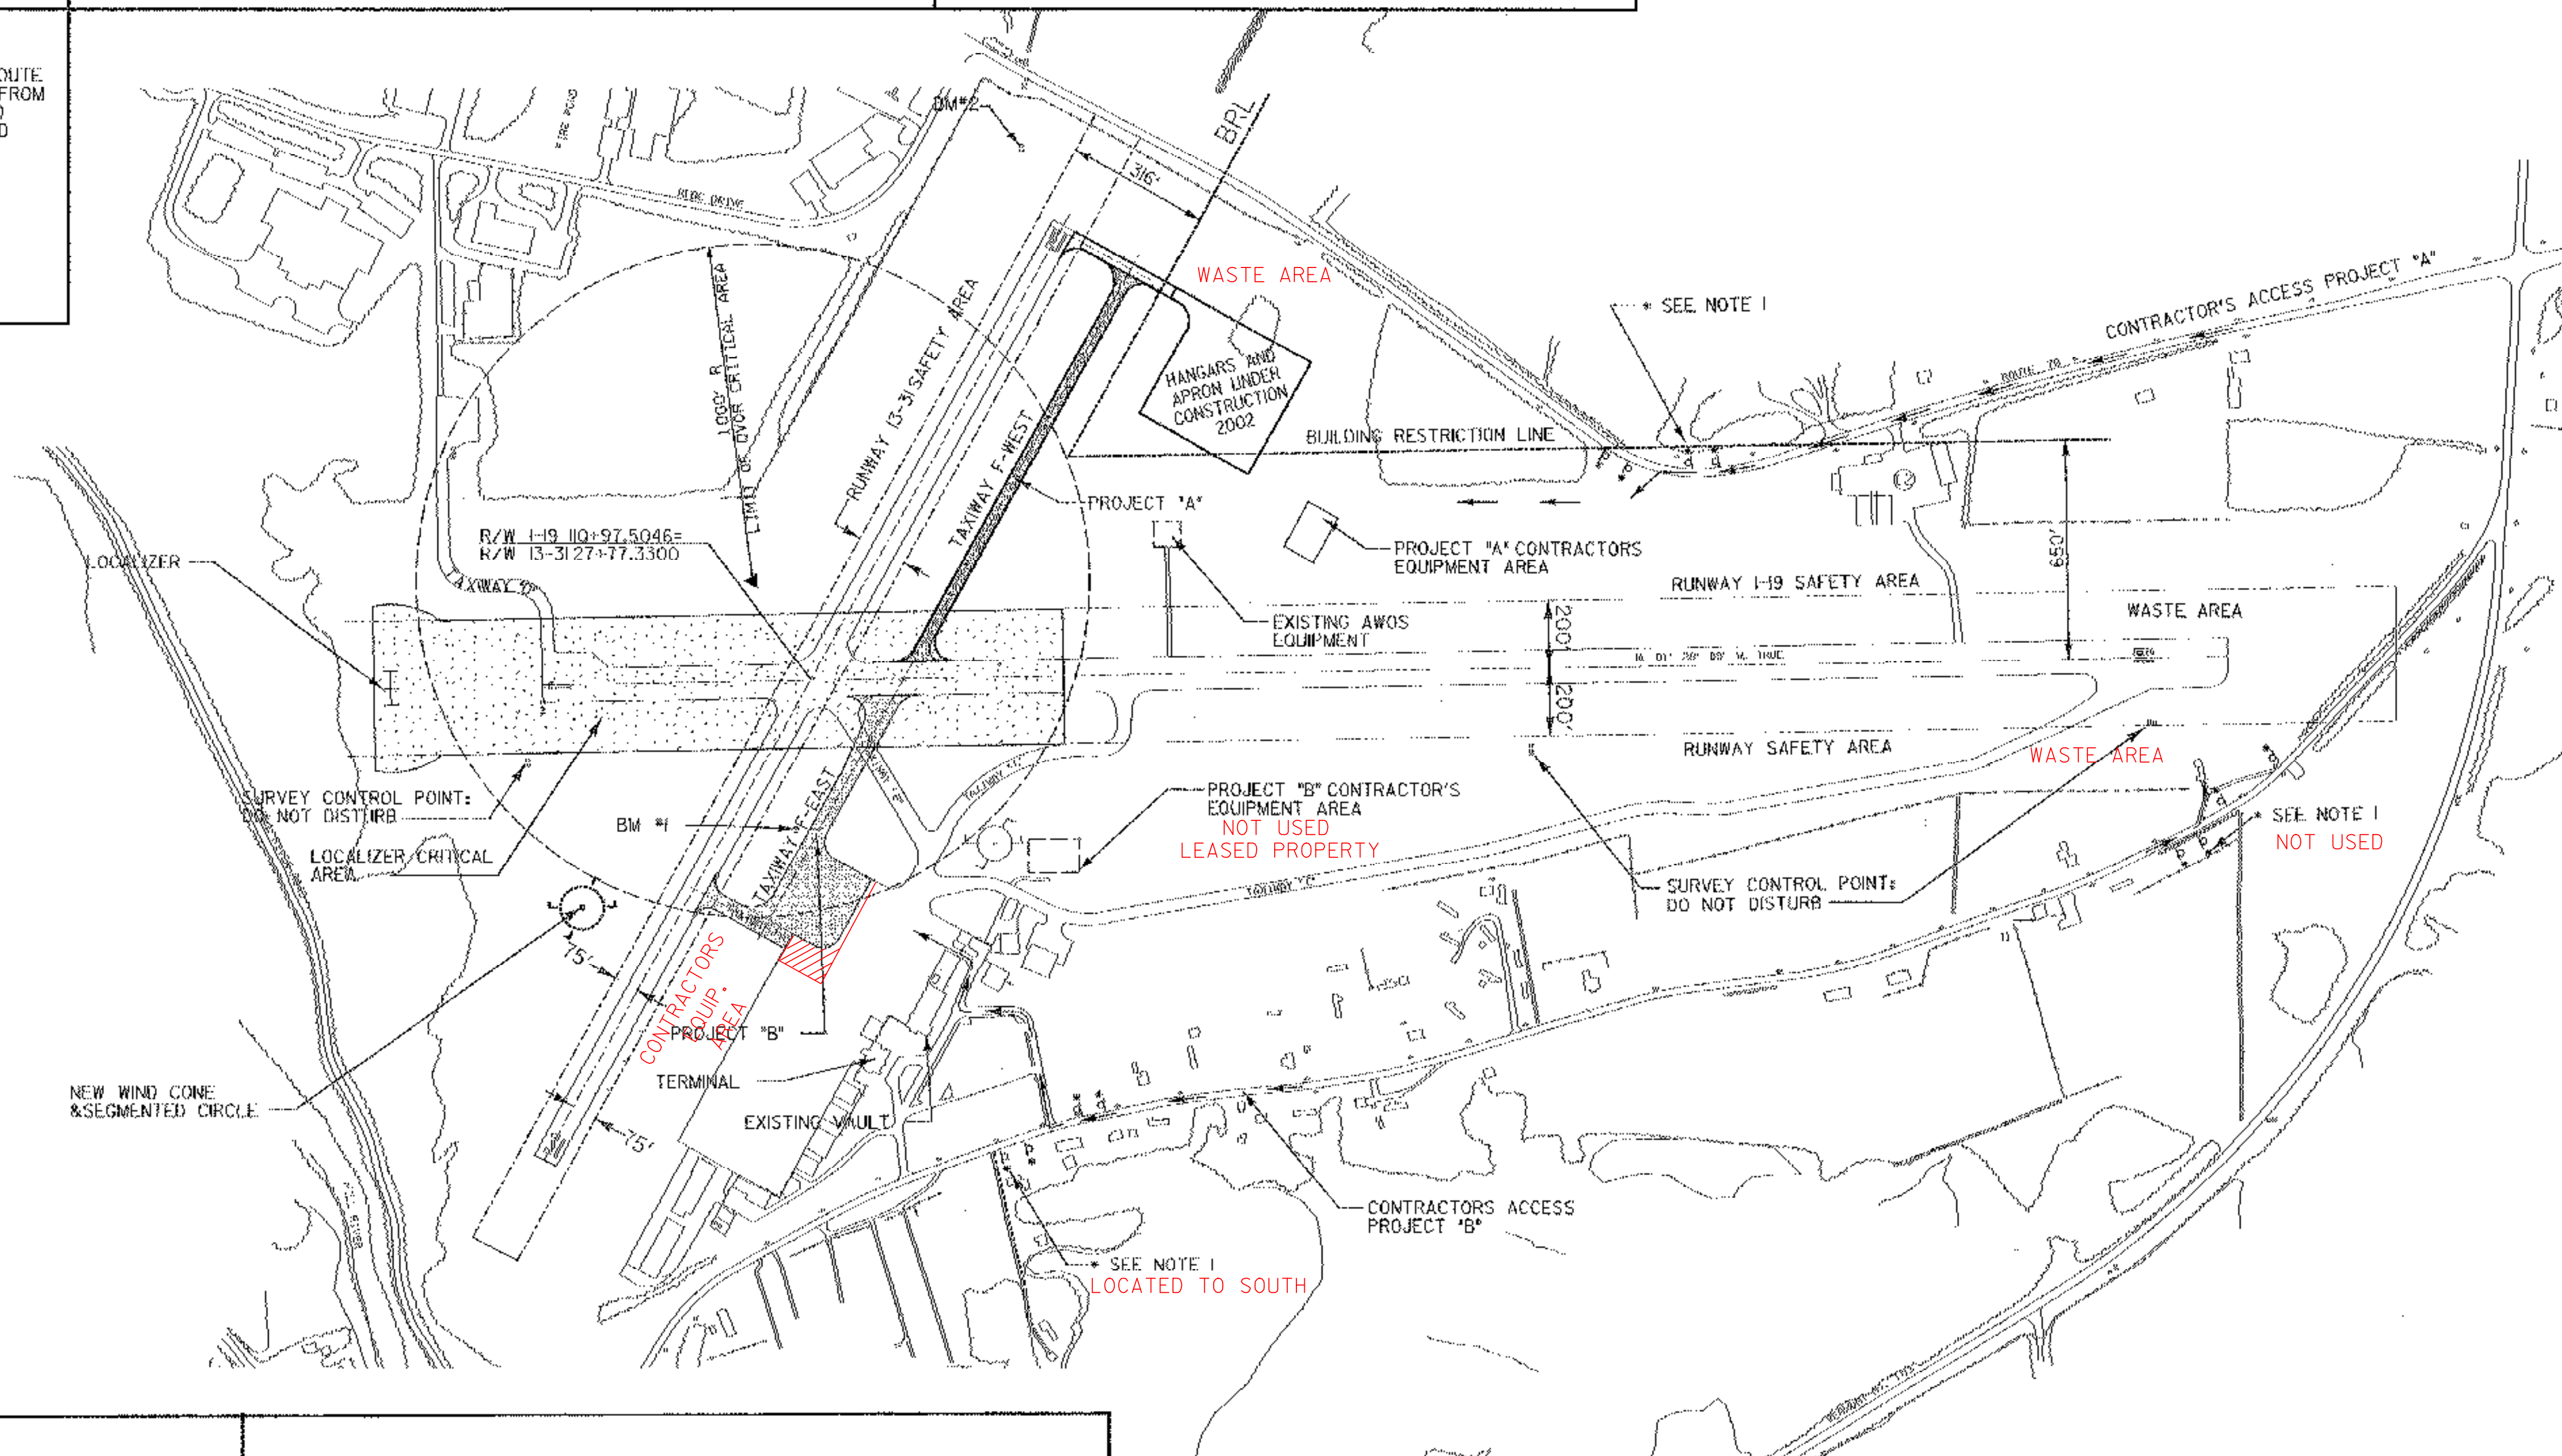

A
 4 TYPICAL SECTION F.A.R. PART 77 IMAGINARY SURFACES
 NOT TO SCALE

B
 4 TYPICAL PROFILE F.A.R. PART 77 IMAGINARY SURFACES
 NOT TO SCALE



REV.	DATE	DESCRIPTION

RUTLAND STATE AIRPORT
 CLARENDON, VERMONT
TAXIWAY IMPROVEMENTS
GENERAL PROJECT LAYOUT

URS
 1 NORTHWAY LN.
 LATHAM, NEW YORK

Designed by G.W.D.	Drawn by M.H.	Checked by:	Approved by:

Scale: 1" = 300'

Date: FEB., 2003

Sheet 4 OF 40

Sheet No

4


A.I.P. 3-50-0015-17



- TEMPORARY THRESHOLD NOT USED


ITEM 864.15

CONSTRUCTION PHASING

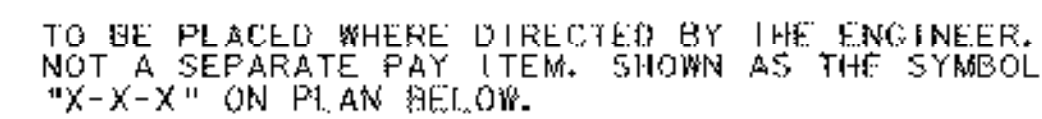

LOW PROFILE BARRICADE


SCALE: N. T. S.

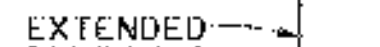

SCALE: N. T. S.

1. CLOSED RUNWAY MARKERS TO BE IN PLACE DURING CONSTRUCTION WHENEVER A RUNWAY IS CLOSED, AS DIRECTED BY ENGINEER.
2. CLOSED RUNWAY MARKER TO BE DURABLE YELLOW VINYL COATED WINDSCREEN MATERIAL. RE-USEABLE TEMPORARY "X" MARKERS ARE AVAILABLE FROM NACCI-877-NAC-ARPI OR WWW.AIRPORTNAC.COM. SECURELY FASTENED IN PLACE.
3. COST OF PLACING AND MAINTAINING THE CLOSED RUNWAY MARKER IS CONSIDERED NECESSARY AND INCIDENTAL TO CONSTRUCTION AND IS NOT A SEPARATE PAY ITEM.
4. CLOSED RUNWAY MARKER TO BE PLACED OVER NUMERALS, OR IN R/W OVERRUN AREA, JUST OFF THRESHOLD, AS DIRECTED BY THE ENGINEER.
5. AT COMPLETION OF CONTRACT, THE TEMPORARY X-MARKERS WILL BECOME THE PROPERTY OF THE AIRPORT.

1. CONTRACTOR'S MAIN ACCESS TO SITE TO BE FROM EITHER ROUTE 78 OR AIRPORT ROAD.
2. CONTRACTOR TO PROVIDE FLAG PERSON AT HAUL / ACCESS ROUTE WHEN CROSSING RUNWAYS, ACTIVE APRONS, TAXIWAYS, OR WHEN WORKING WITHIN THE LOCALIZER CRITICAL AREA WHEN DIRECTED BY THE ENGINEER.
3. FLAGPERSON TO CONTROL ACCESS WITHIN RUNWAY AND TAXIWAY SAFETY AREAS. NO GROUND VEHICLE TRAFFIC WILL BE ALLOWED TO ENTER RUNWAY SAFETY AREAS WHEN AIRCRAFT ARE APPROACHING OR DEPARTING RUNWAY 1-19.
4. FLAGPERSON IS TO HAVE AN AERONAUTICAL RADIO CAPABLE OF TRANSMITTING AND RECEIVING ON UNICOM FREQUENCY 122.8 MHZ.
5. HAUL ROUTES TO BE GRADED AND RETURNED TO ORIGINAL CONDITION UPON COMPLETION OF PROJECT.
6. WASTE AREA TO BE GRADED, SEED, LIMED & MULCHED. PROVIDE EROSION CONTROL AS DIRECTED BY THE ENGINEER. NO WASTE MATERIALS TO BE PLACED IN WETLANDS. REFER TO SHEET 37 FOR PLACEMENT LIMITS. COORDINATE ACCESS TO WASTE AREAS WITH VTRANS/ MAINTENANCE OFFICE.
7. PRIOR TO COMMENCING CONSTRUCTION, THE CONTRACTOR WILL STAKE OUT THE CONSTRUCTION AREAS AND ENCLOSE THESE AREAS WITH SNOW FENCE (MOB) (ITEM 620.70, AS DIRECTED BY THE ENGINEER.

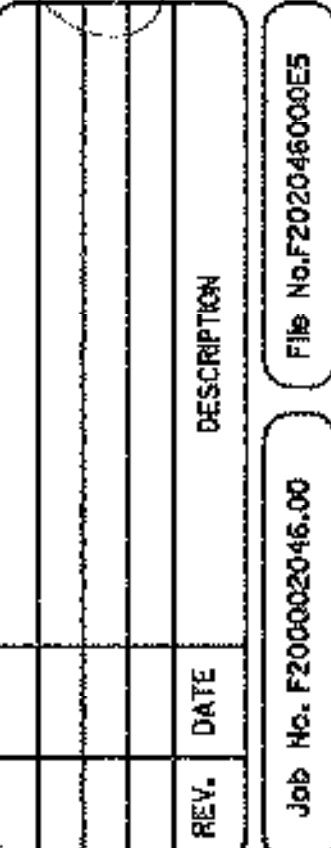

RUTLAND STATE AIRPORT
CLANDENDON, VERMONT

TAXIWAY IMPROVEMENTS CONSTRUCTION PHASING PLAN

URS
1 NORTHWAY LN.
LATHAM, NEW YORK

Checked by: _____
Approved by: _____

Date: FEB., 2003
 Sheet 5 OF 10
 Sheet No 5

[illegible]

14. PORTABLE FLOODLIGHTING - THE CONTRACTOR SHALL PROVIDE PORTABLE FLOODLIGHTING WHEN REQUIRED FOR CONSTRUCTION OPERATIONS. THE CONTRACTOR SHALL PROVIDE SUFFICIENT UNITS SO THAT ALL WORK AREAS ARE ILLUMINATED TO A LEVEL OF 5 HORIZONTAL FOOT CANDLES. THE LIGHTING LEVELS SHALL BE CALCULATED AND MEASURED IN ACCORDANCE WITH THE CURRENT STANDARDS OF THE ILLUMINATION ENGINEERING SOCIETY.
15. THE CONTRACTOR SHALL OBTAIN ALL THE PERMITS AND LICENSES REQUIRED FOR THE PROJECT WORK AT HIS OWN EXPENSE.
16. EXISTING TOPOGRAPHIC FIELD SURVEYS FOR THIS PROJECT AREA WERE PERFORMED BY LITTLE RIVER SURVEY CO. IN MAY, 2001.
17. THE HORIZONTAL CONTROL ON THIS PROJECT IS TIED TO THE 1983 AND 1988 NATIONAL GEODETIC HORIZONTAL AND VERTICAL DATUM, RESPECTIVELY.
18. ELECTRICAL WORK MUST BE PERFORMED BY A VERMONT LICENSED MASTER ELECTRICIAN OR JOURNEYMAN TYPE-S WITH PROPER TRAINING. A WORK NOTIFICATION BE OBTAINED AND THE COMPLETED WORK MUST BE IN COMPLIANCE WITH NFPA 70-1999 AND THE 1999 VERMONT ELECTRICAL SAFETY RULES. UPON COMPLETION OF THE WORK, THE CONTRACTOR SHALL HAVE A ELECTRICAL INSPECTOR # 802-786-0071 TO SCHEDULE A FINAL INSPECTION.

(A) FEDERAL AVIATION ADMINISTRATION (FAA) ADVISORY CIRCULARS (AC), ORDERS AND FEDERAL AVIATION REGULATIONS (FAR).

U. S. DEPARTMENT OF TRANSPORTATION
SUBSEQUENT DISTRIBUTION OFFICE
ARDMORE EAST BUSINESS CENTER
3341 Q 75TH AVE.
LANDOVER, MD. 20785

(1) AC 150/5370-2, "OPERATIONAL SAFETY ON AIRPORTS DURING CONSTRUCTION", CURRENT EDITION.

- (B) GENERAL SAFETY REQUIREMENTS

- (3) DURING PERFORMANCE OF THIS CONTRACT, THE AIRPORT RUNWAYS, TAXIWAYS, AND AIRCRAFT PARKING APRONS SHALL REMAIN IN USE BY AIRCRAFT TO THE MAXIMUM EXTENT POSSIBLE. ALL AIRCRAFT TRAFFIC ON THESE AREAS SHALL HAVE PRIORITY OVER THE CONTRACTOR'S TRAFFIC. THE OWNER RESERVES THE RIGHT TO ORDER THE CONTRACTOR AT ANY TIME TO VACATE ANY AREA NECESSARY TO MAINTAIN SAFE AIRCRAFT OPERATIONS. USE OF AREAS NEAR THE CONTRACTOR'S WORK AREAS OR CONTRACTOR'S OPERATIONS IS NOT PERMITTED TO THE CONTRACTOR'S OPERATION. THE CONTRACTOR SHALL NOT ALLOW EMPLOYEES, SUBCONTRACTORS, SUPPLIERS, OR ANY OTHER UNAUTHORIZED PERSON TO ENTER OR REMAIN IN ANY AIRPORT AREA WHICH WOULD BE HAZARDOUS TO PERSONS OR TO AIRCRAFT OPERATIONS.
- (4) ALL WORK TO BE PERFORMED WHICH IS CLOSE TO AN ACTIVE RUNWAY, TAXIWAY OR APRON SHALL BE PERFORMED WHEN THE RUNWAY, TAXIWAY OR APRON IS NOT IN USE. SUCH WORK SHALL BE COMPLETED PRIOR TO THE CLOSING FROM THE ENGINEER AND AIRPORT MANAGER. REQUESTED CLOSINGS SHALL BE DIRECTED TO THE ENGINEER AT LEAST 48 HOURS IN ADVANCE.

(1) THE FOLLOWING ARE CONSIDERED SAFETY PROBLEMS AND/OR HAZARDS:

- (L) INADEQUATE OR IMPROPER METHODS OF MARKING, BARRICADING, AND LIGHTING OF TEMPORARILY CLOSED PORTIONS OF THE AIRPORT OPERATIONS AREA.
- (M) TRASH OR OTHER MATERIALS WITH FOREIGN OBJECT DAMAGE (FOD) POTENTIAL; WHETHER ON RUNWAYS, TAXIWAYS, OR APRONS; OR IN RELATED SAFETY AREAS.
- (N) INADEQUATE BARRICADING OR OTHER MARKING WHICH IS PLACED TO SEPARATE CONSTRUCTION OR MAINTENANCE AREAS FROM OPEN AIRCRAFT OPERATING AREAS.
- (O) FAILURE TO CONTROL UNAUTHORIZED VEHICLE AND HUMAN ACCESS TO ACTIVE AIRCRAFT OPERATING AREAS.
- (P) FAILURE TO MAINTAIN RADIO COMMUNICATION BETWEEN CONSTRUCTION/MAINTENANCE VEHICLES AND RUTLAND UNIFORM.
- (Q) CONSTRUCTION/MAINTENANCE ACTIVITIES OR MATERIALS WHICH COULD HAMPER THE RESPONSE OF AIRCRAFT RESCUE AND FIRE FIGHTING (ARFF) EQUIPMENT FROM REACHING ALL AIRCRAFT OR ANY PART OF THE RUNWAY/TAXIWAY SYSTEM, RUNWAY APPROACH OR DEPARTURE AREAS AND AIRCRAFT PARKING LOCATIONS.

- (2) THE CONTRACTOR SHALL CONDUCT ACTIVITIES SO AS NOT TO VIOLATE ANY SAFETY STANDARDS CONTAINED HEREIN. THE CONTRACTOR SHALL INSPECT ALL CONSTRUCTION AND STORAGE AREAS AS OFTEN AS NECESSARY AND PROMPTLY TAKE ALL STEPS NECESSARY TO PREVENT/REMEDY ANY UNSAFE OR POTENTIALLY UNSAFE CONDITIONS OR ACTIVITIES DISCOVERED.
- (3) VTRANS WILL BE RESPONSIBLE FOR ISSUING APPROPRIATE NOTICE TO AIRMEN (NOTAM) CONCERNING CONSTRUCTION ACTIVITY ON THE AIRFIELD.

THIS PROJECT INCLUDES WORK WITHIN THE AIRCRAFT OPERATIONS AREA (AOA). ONLY THOSE VEHICLES AND EQUIPMENT NECESSARY FOR THE WORK TO PROGRESS MAY ENTER THE A.O.A. ALL PERMITTED VEHICLES SHALL BE EQUIPPED WITH A FLASHING AMBER (YELLOW) DOME-TYPE LIGHT, MOUNTED ON TOP OF THE VEHICLE AND OF SUCH INTENSITY TO CONFORM TO LOCAL CODES FOR MAINTENANCE AND EMERGENCY VEHICLES. ALL VEHICLES OPERATING WITHIN THE FIELD OF WORK AREA BOUNDARY SHALL BE IDENTIFIED WITH A SIGN ON EACH SIDE OF THE VEHICLE BEARING THE CONTRACTOR'S NAME IN 12-INCH MINIMUM LETTER HEIGHT.

(E) RADIO COMMUNICATIONS

THE CONTRACTOR WILL SUPPLY THE RESIDENT ENGINEER WITH TWO (2) HANDHELD RECHARGEABLE PORTABLE AERONAUTICAL RADIOS, CAPABLE OF TRANSMITTING AND RECEIVING ON THE UNICOM FREQUENCY OF 122.8 MHZ AT THE START OF THIS PROJECT. THESE RADIOS WILL HAVE A MINIMUM OF 3 WATTS OF TRANSMITTING POWER, SIMILAR TO ICOM MODEL IC-3A. THESE RADIOS WILL BECOME PROPERTY OF THE VERMONT AGENCY OF TRANSPORTATION.

DEBRIS, WASTE, AND LOOSE MATERIAL (INCLUDING DUST AND DIRT) CAPABLE OF CAUSING DAMAGE TO AIRCRAFT LANDING GEAR OR PROPELLERS, OR BEING INGESTED IN JET ENGINES, SHALL NOT BE ACCUMULATED OR STORED IN ANY AREAS OR ADJACENT GRASSED AREAS. MATERIALS OBSERVED TO BE WITHIN THESE AREAS SHALL BE REMOVED IMMEDIATELY BY THE CONTRACTOR. THE CONTRACTOR SHALL BE REQUIRED TO MAINTAIN A SUPERVISOR AND OPERATOR ON SITE AND READY AT ALL TIMES DURING CONSTRUCTION ACTIVITY. WHERE TRAVEL ON OR ACROSS RUNWAYS, RAMP AREAS, TAXIWAYS, OR AIRCRAFT APRONS IS REQUIRED, THE CONTRACTOR SHALL TAKE THE NECESSARY PRECAUTIONS AND EQUIPMENT TO KEEP SUCH SURFACES CLEAR OF DEBRIS.

IN ACCORDANCE WITH THE SPECIFICATIONS, THE CONTRACTOR SHALL, AT HIS OWN EXPENSE, FURNISH FLAGMEN AS NECESSARY TO CONTROL HIS TRAFFIC.

ALL CONTRACTOR VEHICLES THAT ARE REQUIRED TO CROSS ACTIVE RUNWAYS, RUNWAY SAFETY AREAS, TAXIWAYS AND APRONS SHALL DO SO UNDER THE DIRECT CONTROL OF A COMPETENT FLAGMAN WHO IS IN DIRECT RADIO CONTACT WITH GROUND CONTROL. ALL AIRCRAFT TRAFFIC ON RUNWAYS, TAXIWAYS, AND APRONS SHALL HAVE PRIORITY OVER CONTRACTOR'S TRAFFIC. AT NO TIME SHALL THE CONTRACTOR'S VEHICLES OR PERSONNEL

BE ALLOWED TO ENTER OR CROSS ACTIVE RUNWAYS OR CLEAR ZONES WITHOUT PROPER AUTHORIZATION.

- (1) OPEN FLAME, WELDING OR TORCH CUTTING OPERATIONS ARE PROHIBITED UNLESS ADEQUATE FIRE AND SAFETY PRECAUTIONS HAVE BEEN TAKEN AND THE PROCEDURE PREVIOUSLY APPROVED BY THE ENGINEER.
- (2) EQUIPMENT AND STOCKPILED MATERIAL SHALL BE CONSTRAINED IN A MANNER TO PREVENT MOVEMENT RESULTING FROM AIRCRAFT JET BLAST OR WIND CONDITIONS IN EXCESS OF 10 KNOTS.
- (3) THE CONTRACTOR SHALL PROVIDE BUCKET TYPE CONSTRUCTION BARRICADES WITH FLASHING YELLOW LIGHTS AS SHOWN ON THE DRAWINGS TO DELINEATE THE WORK AREAS WHEN CLOSED TO AIRPORT TRAFFIC. OPEN TRENCHES, EXCAVATIONS AND STOCKPILED MATERIAL LOCATED IN THE ROW SHALL BE PROMINENTLY MARKED WITH ORANGE FLAGS AND LIGHTED BY APPROVED LIGHT UNITS DURING HOURS OF LIMITED VISIBILITY AND DARKNESS.
- (4) ALL MATERIALS AND EQUIPMENT WHEN NOT IN USE SHALL BE PLACED IN APPROVED AREAS WHERE THEY WILL NOT CONSTITUTE A HAZARD TO AIRCRAFT OPERATIONS AND NOT PENETRATE CLEARANCE SURFACES. EQUIPMENT SHALL BE PARKED AT THE STAGING AREA WHEN NOT IN USE.
- (5) MAXIMUM EQUIPMENT HEIGHT SHALL NOT EXCEED 15 FEET UNLESS PRIOR APPROVAL IS OBTAINED FROM THE ENGINEER.
- (6) UPON COMPLETION OF ANY STAGE/PHASE OF WORK, THE ENGINEER WILL ARRANGE A PHYSICAL INSPECTION OF THE AREA WITH AIRPORT OPERATIONS PERSONNEL PRIOR TO OPENING ANY PORTION OF A RUNWAY, RAMP AREA OR AIRPORT ROADWAY THAT HAS BEEN CLOSED FOR WORK OR USED FOR A CROSSING POINT OR HAUL ROUTE BY THE CONTRACTOR.
- (7) ENTRANCE TO THE AIRFIELD IS SUBJECT TO SECURITY REQUIREMENTS.

- (8) THE CONTRACTOR SHALL PROVIDE THE ENGINEER WITH A CURRENT LIST OF ALL EMPLOYEES WORKING ON THE AIRPORT. THE LIST SHALL BE MAINTAINED CURRENT BY THE CONTRACTOR AND APPLIES TO ALL SUBCONTRACTORS.
- (9) EXCEPT FOR EMERGENCIES, ALL CONTACT WITH AIRPORT PERSONNEL SHALL BE MADE THROUGH THE RESIDENT ENGINEER. FOR EMERGENCIES INVOLVING SAFETY (HAZARDOUS MATERIALS, SECURITY, ETC.) THE CONTRACTOR SHALL MAKE DIRECT CONTACT WITH AIRPORT OPERATIONS FOLLOWED BY NOTIFICATION TO THE RESIDENT ENGINEER AS SOON AS POSSIBLE.
- (10) THE CONTRACTOR SHALL PROVIDE THE PHONE NUMBERS OF THREE PERSONNEL, INCLUDING THE PROJECT SUPERINTENDENT, WHO MAY BE CONTACTED IN AN EMERGENCY. PERSONNEL SHALL BE ON CALL 24 HOURS PER DAY FOR MAINTAINING AIRPORT HAZARD LIGHTING AND BARRICADES.
- (11) IN ACCORDANCE WITH THE SPECIFICATIONS, FEDERAL WAGE RATES SHALL BE POSTED OUTSIDE THE SITE FIELD OFFICE IN A WEATHERPROOF ENCLOSURE.

- (1) UNDERGROUND UTILITIES: THE LOCATION OF THE UNDERGROUND UTILITIES SHOWN ON THE PLANS ARE CONSIDERED TO BE ONLY ESTIMATED LOCATIONS. ALL UTILITY LOCATIONS SHALL BE FIELD VERIFIED BY THE CONTRACTOR PRIOR TO COMMENCING CONSTRUCTION. IN THE EVENT ANY UTILITY IS DAMAGED THE CONTRACTOR SHALL BE RESPONSIBLE FOR PAYING FOR INCURRED COSTS OF REPAIRS.
- (2) UTILITIES NOTIFICATION: AT LEAST TWO WORKING DAYS PRIOR TO COMMENCING CONSTRUCTION OPERATIONS IN AN AREA WHICH MAY INVOLVE THE EXCAVATION OF UTILITIES, THE ENGINEER CONTRACTOR SHALL NOTIFY THE RESIDENT ENGINEER, AND THE OWNER OF EACH UNDERGROUND UTILITY FACILITY AFFECTED.
- (3) THE FOLLOWING IS A LIST OF COMPANIES WITH POSSIBLE UTILITIES WITHIN THE CONSTRUCTION LIMITS.

<u>UTILITY</u>	<u>PHONE NUMBER</u>
DIGSAFE	1-888-DIG-SAFE
CVPS	1-800-649-2877
VTRANS: SEWER LINE (FORCE MAIN)	1-802-786-8881

TAXIWAY IMPROVEMENTS GENERAL CONSTRUCTION & SAFETY NOTES

**1 NORTHWAY LN.
LATHAM, NEW YORK**

Designed by: G.W.D.
Drawn by: C.L.S.
Checked by: M.K.C.
Approved by: G.W.D.


Scale: NTS

Date: FEB., 2003

Sheet 6 OF 40

Sheet No. _____

6

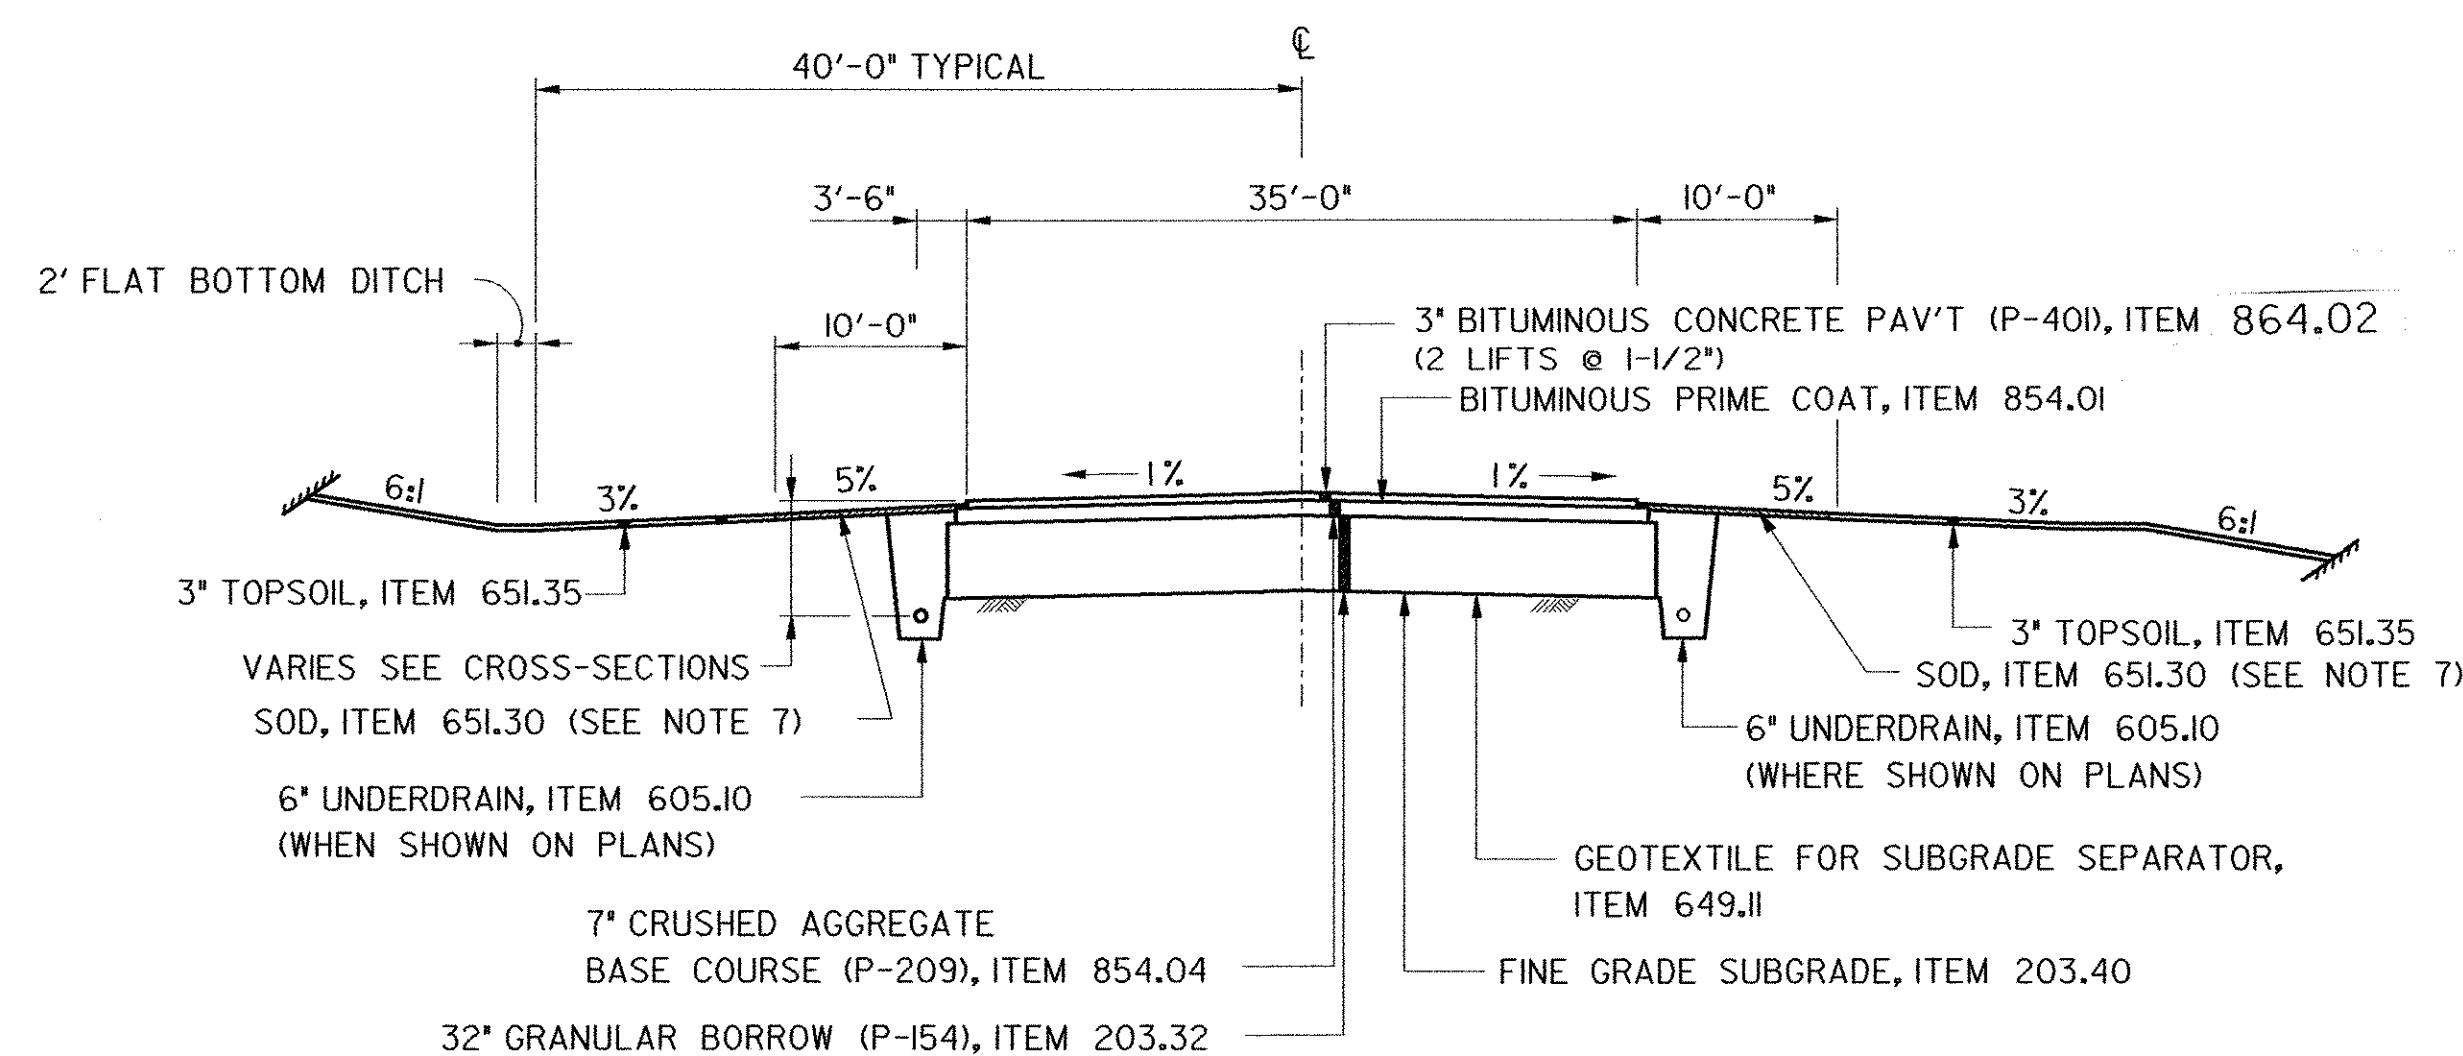

PARALLEL TAXIWAY "F" (WEST) TYPICAL
STA. 400+17.5 TO 413+31

GENERAL NOTES

- SUBGRADE UNDER AREAS TO BE PAVED TO BE COMPACTED TO 100% DENSITY, AASHTO T-180, ASTM D 1557.
- BITUMINOUS TACK COAT (EMULSIFIED ASPHALT, RS-1) TO BE APPLIED BETWEEN LIFTS OF BITUMINOUS CONCRETE PAVEMENT AT A RATE OF 0.01 TO 0.03 GAL/SY WHEN DIRECTED BY THE ENGINEER. (NOT A SEPARATE PAY ITEM).
- BITUMINOUS PRIME COAT, ITEM 854.01 (SS-1) TO BE APPLIED AT A RATE OF 0.15 GALLON/SY (MAX) BETWEEN CRUSHED AGGREGATE BASE COURSE AND NEW BITUMINOUS CONCRETE PAV'T.
- SEED, ITEM 651.15 TO BE APPLIED AS DIRECTED BY ENGINEER. THE SEED MIXTURE, SHALL CONFORM TO:

% WT	LBS / A		PUR %	GERM
20	14	TALL FESCUE (K-31)	95	85
10	7	PERENIAL RYE GRASS	95	85
1	1	MEDIUM RED CLOVER	95	85
2	2	EMPIRE BIRDS FOOT TREFOIL	98	85
22	15	CLIMAX TIMOTHY	95	85
25	17	CREeping RED FESCUE	98	85
10	7	ANNUAL RYE	95	85
10	7	ORCHARD GRASS	95	85
100	70			

THE SEED MIXTURE SHALL NOT HAVE A WEED CONTENT EXCEEDING 0.40% BY WEIGHT AND SHALL BE FREE OF ALL NOXIOUS WEED SEED.

- FERTILIZER, ITEM 651.18, FORMULA 10-20-10 TO BE USED WITH SEED. ITEM 651.15, APPLIED AT THE RATE OF 500 LBS / ACRE.

AGRICULTURAL LIMESTONE, ITEM 651.20, TO BE APPLIED AT RATE OF 2 TONS/ACRE OR AS DIRECTED BY ENGINEER.

HAY MULCH, ITEM 651.25, TO BE PLACED ON EARTH SLOPES AT THE RATE OF 2 TONS/ACRE.

TOPSOIL, ITEM 651.35, TO BE USED WITH SEED, ITEM 651.15, AS DIRECTED BY THE ENGINEER.


- EROSION CONTROL MATTING, ITEM 654.10, TO BE PLACED ON SLOPES OVER 5% WHEN DIRECTED BY THE ENGINEER.

- SOD TO BE PLACED ALONG SIDE TAXIWAY FROM E.P. TO 10' OFF PAVEMENT, ITEM 651.30.

- ALLOWABLE THICKNESS TOLERANCES:
SUBGRADE ± 1/2"
CONTROLLED MATERIAL ± 1/2"
PAVEMENT ± 3/16"
BASE COURSE ± 1/2"

- PAY LIMITS FOR SEED, LIME, FERTILIZER & MULCH ARE EQUAL TO THE APPROVED CONSTRUCTION LIMITS.

- GRANULAR BORROW (P-154), ITEM 203.32, LIMIT % PASSING .02MM TO 3 % (NON FROST SUSCEPTIBLE) ; COMPACTION REQUIREMENT IS 100% DENSITY, ASTM D 1557.

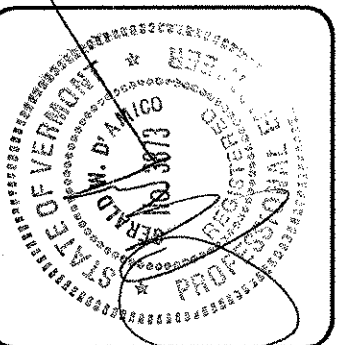

REV.	DATE	DESCRIPTION

RUTLAND STATE AIRPORT
CLARENDON, VERMONT

TAXIWAY IMPROVEMENTS
TYPICAL SECTIONS PROPOSED

URS
1 NORTHWAY LN.
LATHAM, NEW YORK


Designed by: G.W.D.
Drawn by: M.C.M.
Checked by: M.K.C.
Approved by: G.W.D.

Scale: AS SHOWN


Date: FEB., 2003

Sheet 7 OF 40


Sheet No
7

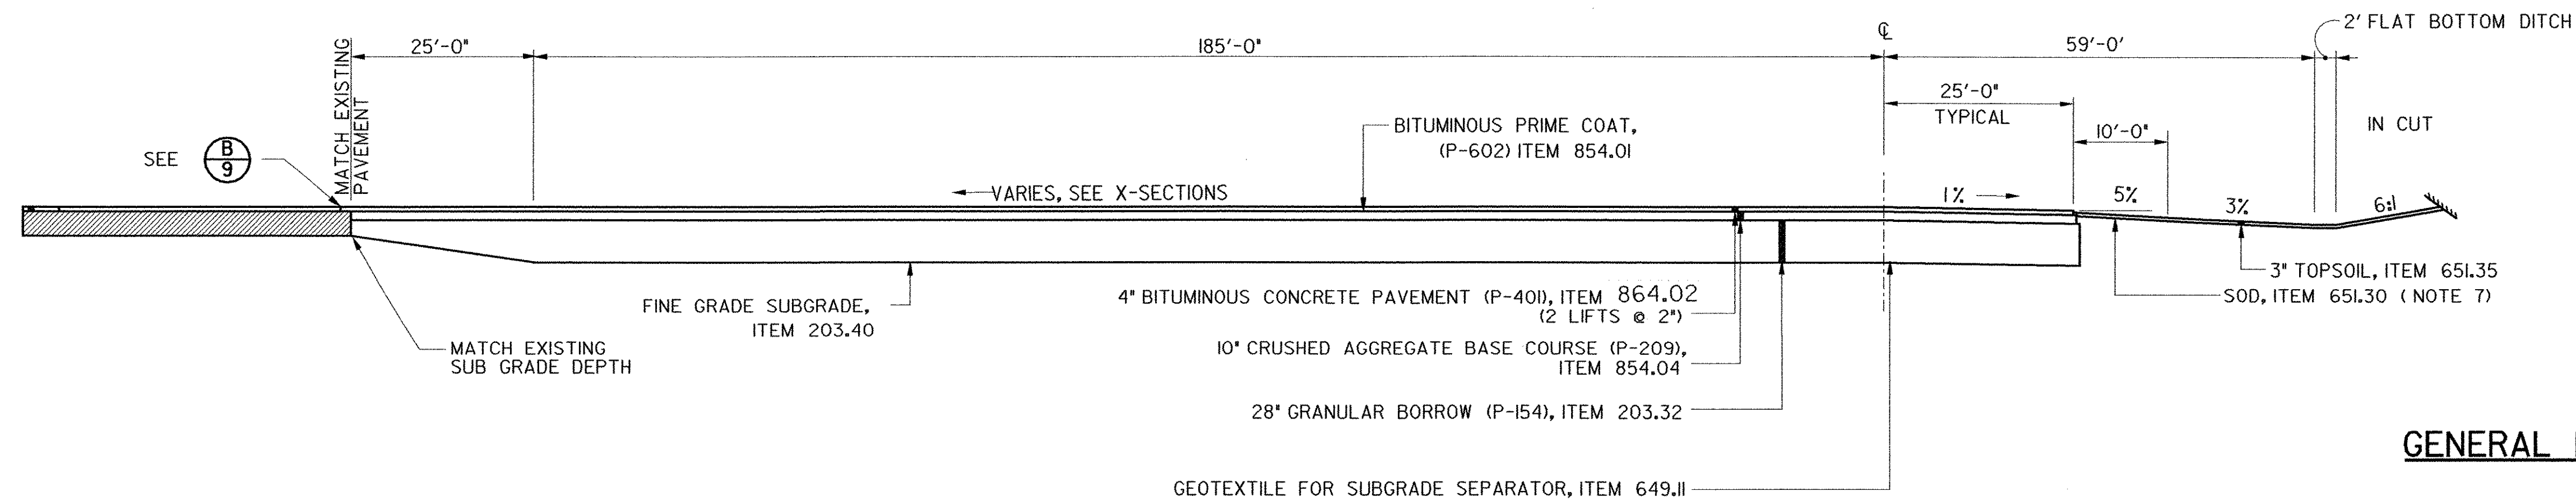

TAXIWAY/APRON - TYPICAL
STA. 419+60 TO 422+11

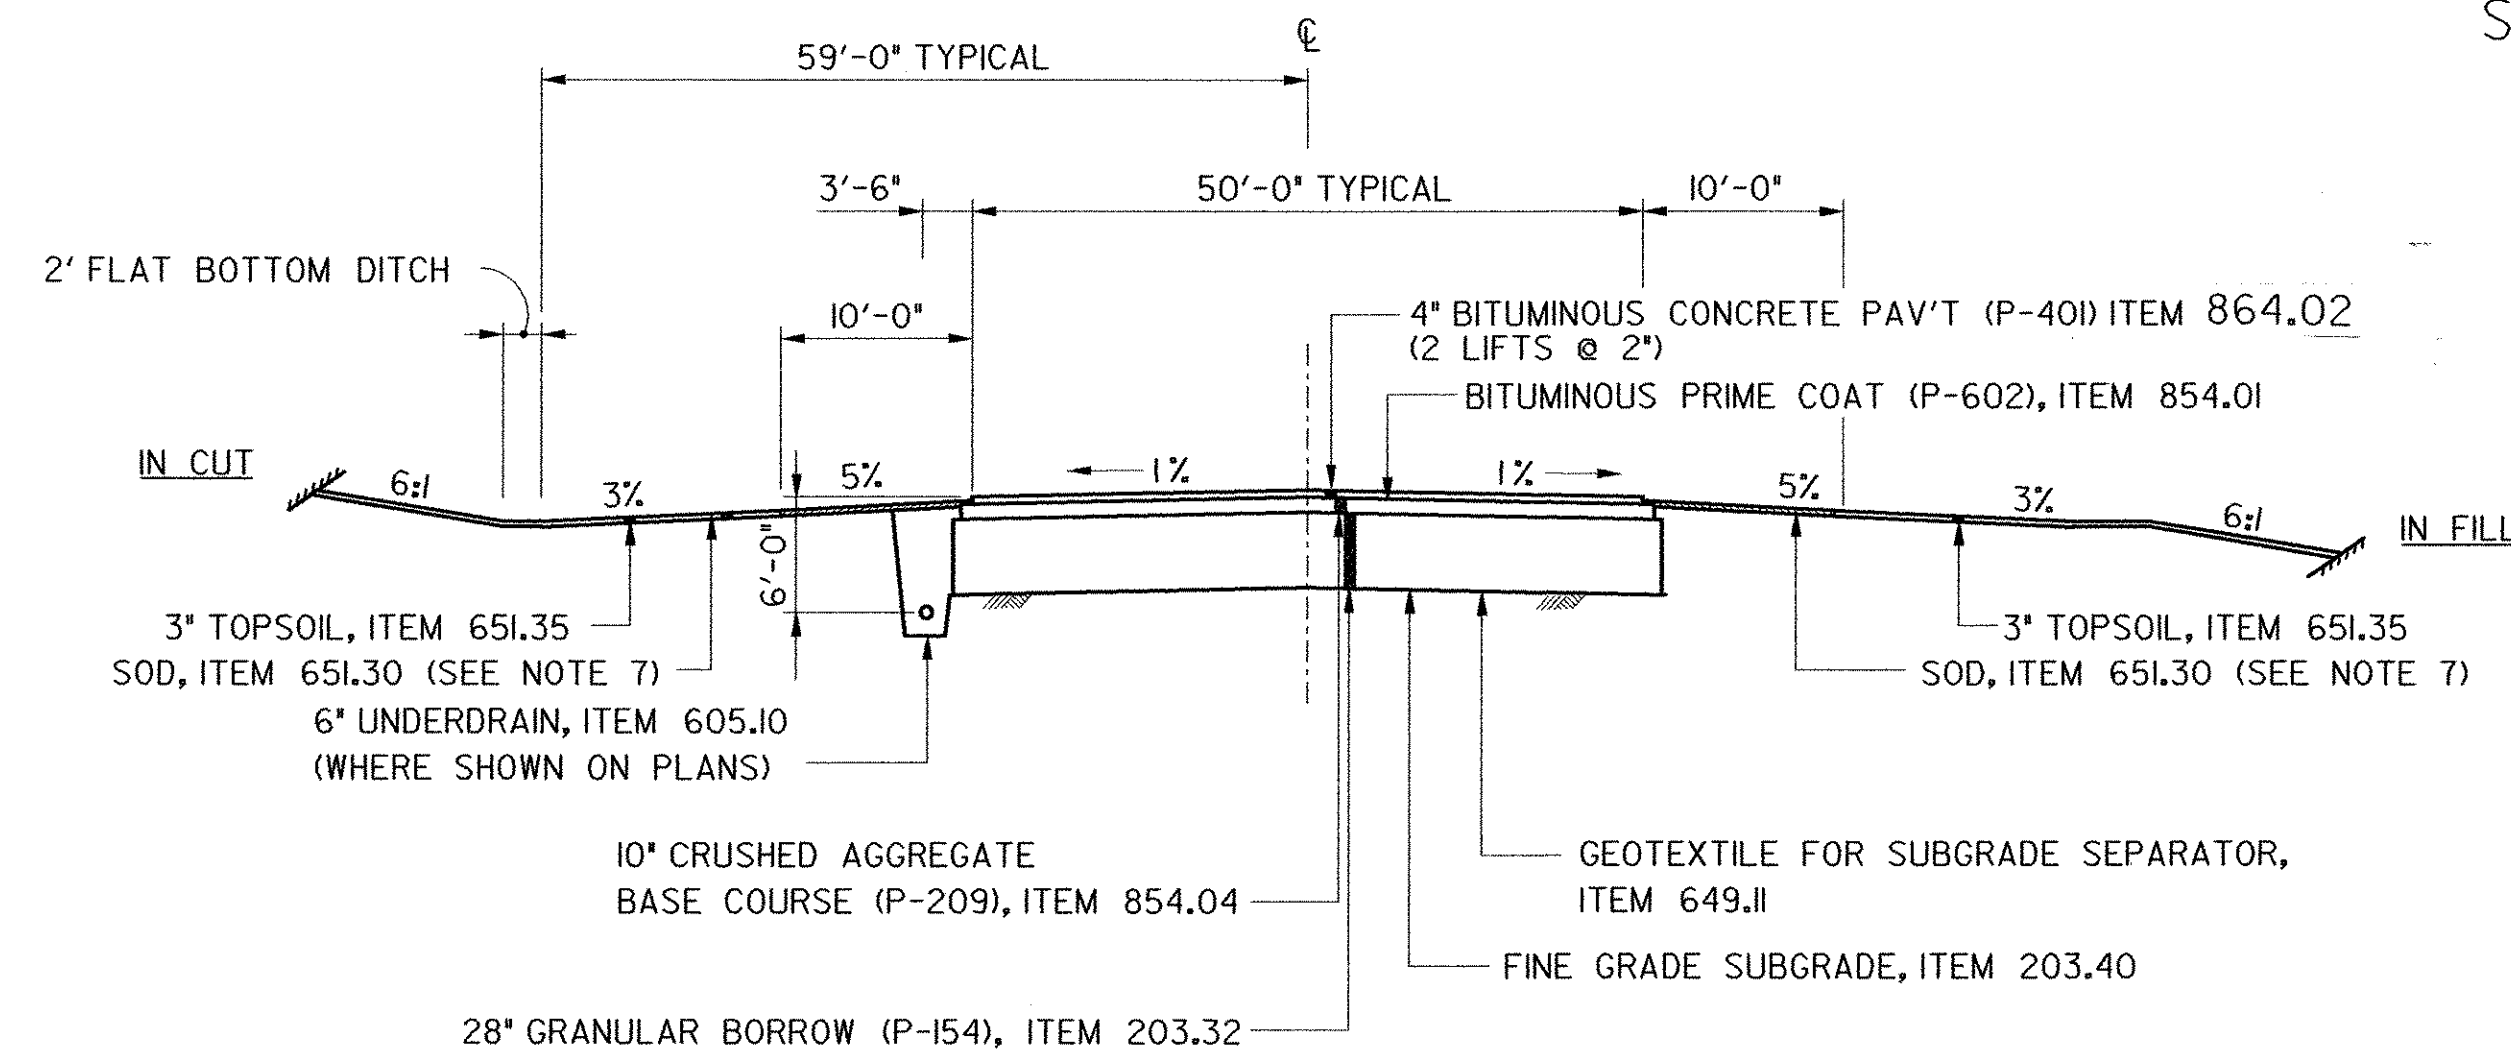

PARALLEL TAXIWAY "F" (EAST) TYPICAL
STA. 414+50 TO 419+60

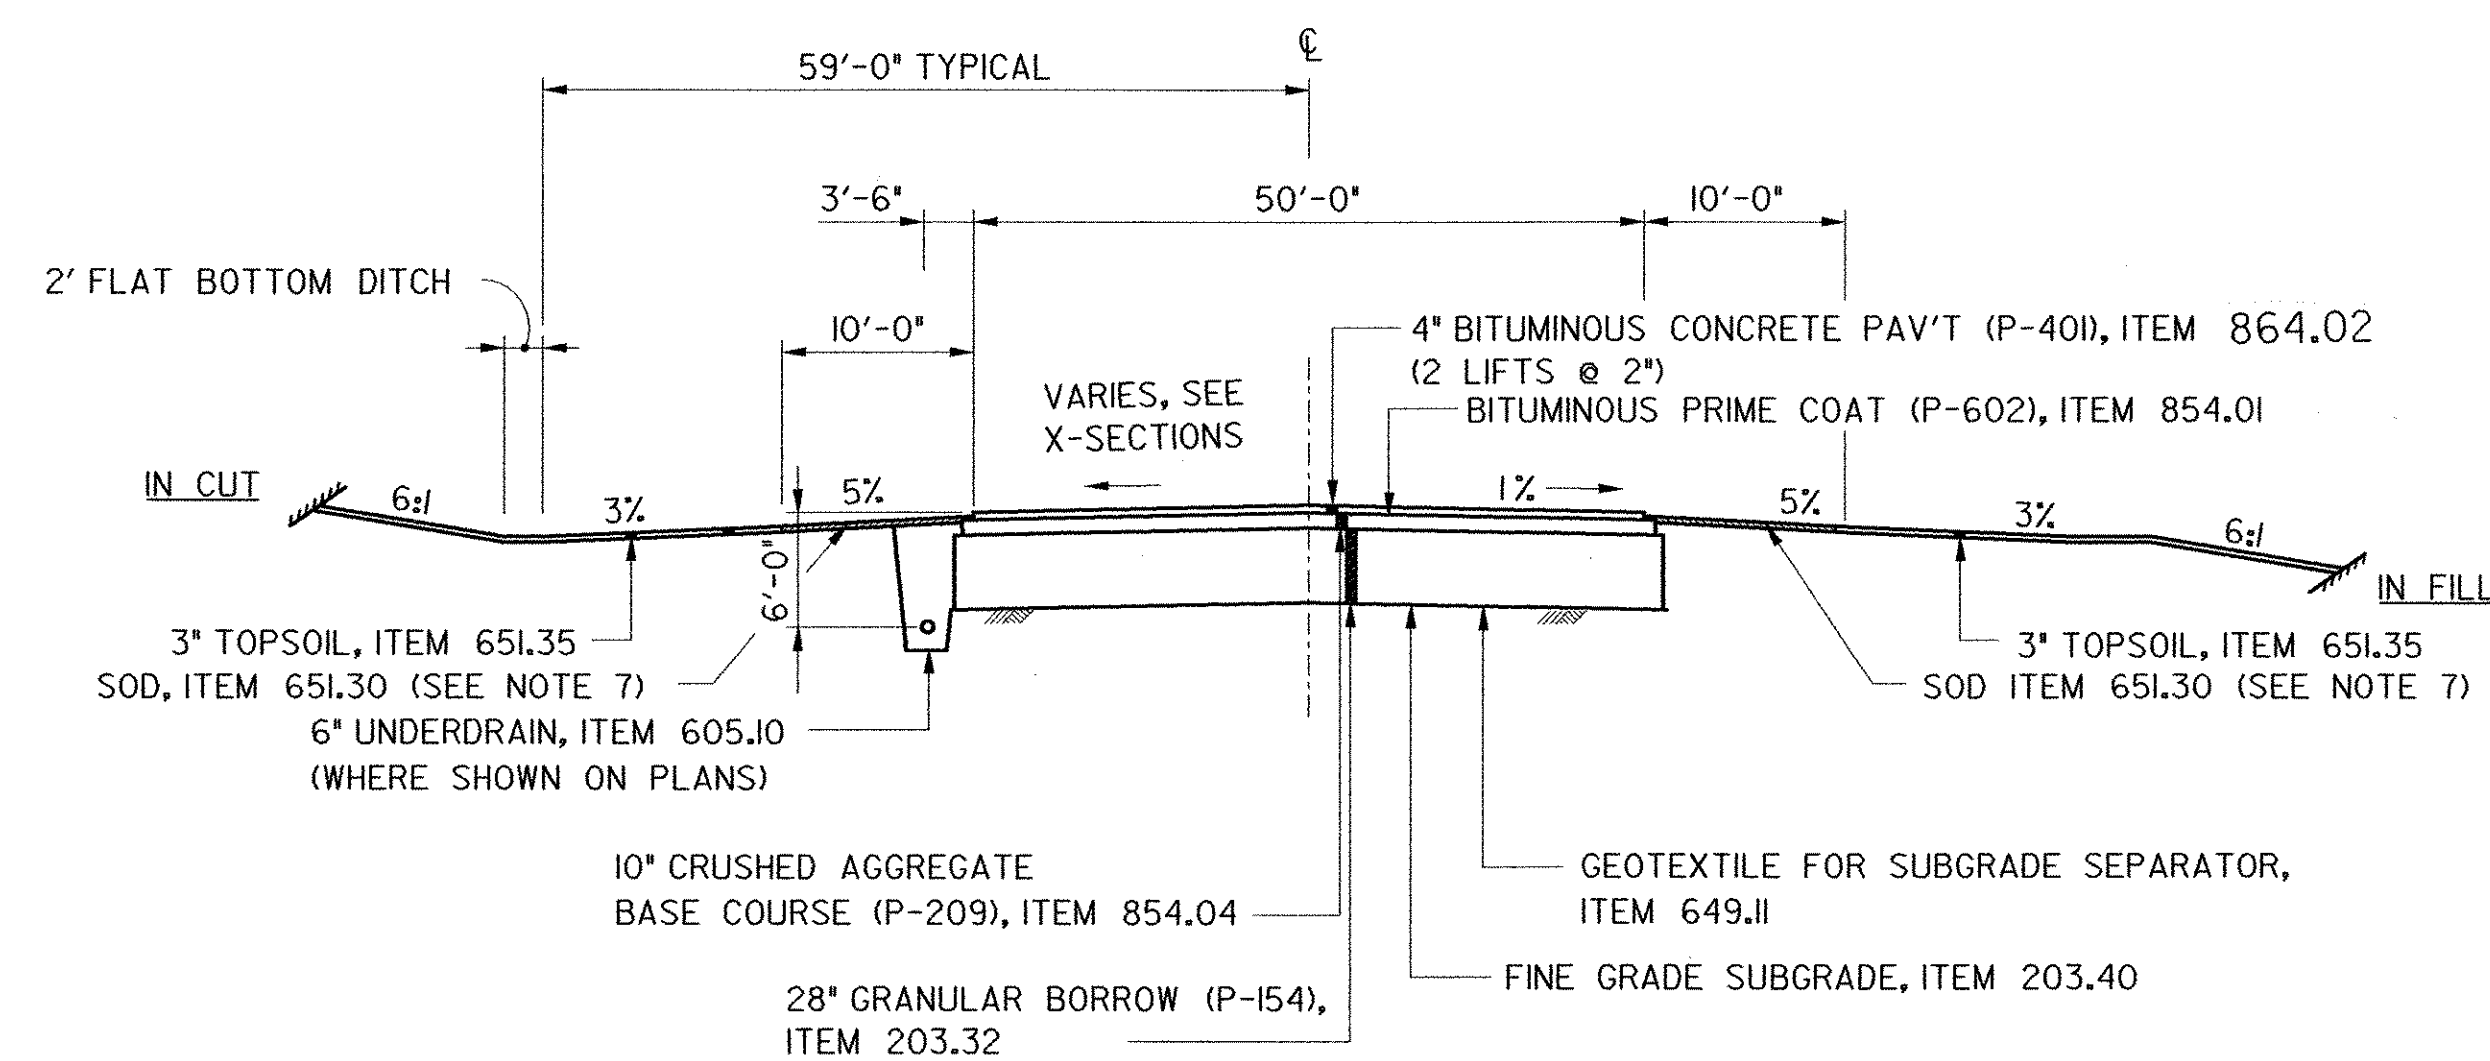

TAXIWAY "A" TYPICAL

GENERAL NOTES

- SUBGRADE UNDER AREAS TO BE PAVED TO BE COMPACTED TO 100% DENSITY, ASTM D 1557.
- BITUMINOUS TACK COAT (EMULSIFIED ASPHALT, RS-1) TO BE APPLIED BETWEEN LIFTS OF BITUMINOUS CONCRETE PAVEMENT AT A RATE OF 0.01 TO 0.03 GAL/SY WHEN DIRECTED BY THE ENGINEER. (NOT A SEPARATE PAY ITEM.)
- BITUMINOUS PRIME COAT (SS-1), ITEM 854.01, TO BE APPLIED AT A RATE OF 0.15 GALLON/SY BETWEEN CRUSHED AGGREGATE BASE COURSE AND NEW BITUMINOUS CONCRETE PAV'T.
- SEED, ITEM 651J5 TO BE APPLIED AS DIRECTED BY ENGINEER. THE SEED MIXTURE, SHALL CONFORM TO:

% WT	LBS / A		PUR %	GERM
20	14	TALL FESCUE (K-31)	95	85
10	7	PERENIAL RYE GRASS	95	85
1	1	MEDIUM RED CLOVER	95	85
2	2	EMPIRE BIRDS FOOT TREFOIL	98	85
22	15	CLIMAX TIMOTHY	95	85
25	17	CREeping RED FESCUE	98	85
10	7	ANNUAL RYE	95	85
10	7	ORCHARD GRASS	95	85
100	70			

- FERTILIZER, ITEM 651J8, FORMULA 10-20-10, ITEM 651J5, TO BE APPLIED AT THE RATE OF 500 LBS / ACRE.


AGRICULTURAL LIMESTONE, ITEM 65120, TO BE APPLIED AT RATE OF 2 TONS/ACRE OR AS DIRECTED BY ENGINEER.

HAY MULCH, ITEM 65125, TO BE PLACED ON EARTH SLOPES AT THE RATE OF 2 TONS/ACRE.

TOPSOIL, ITEM 65135, TO BE USED WITH SEED, ITEM 651J5, AS DIRECTED BY THE ENGINEER.

- EROSION CONTROL MATTING, ITEM 654J0, TO BE PLACED ON SLOPES OVER 5% WHEN DIRECTED BY THE ENGINEER.
- SOD, ITEM 65130 TO BE PLACED ALONG SIDE TAXIWAY FROM E.P. TO 10' OFF PAVEMENT.
- ALLOWABLE THICKNESS TOLERANCES:
SUBGRADE ± 1/2"
CONTROLLED MATERIAL ± 1/2"
PAVEMENT ± 3/16"
BASE COURSE ± 1/2"
- PAY LIMITS FOR SEED, LIME, FERTILIZER & MULCH ARE EQUAL TO THE APPROVED CONSTRUCTION LIMITS.
- GRANULAR BORROW (P-154), ITEM 203.32, LIMIT % PASSING .02MM TO 3 % (NON FROST SUSCEPTIBLE); COMPACTION REQUIREMENT IS 100% DENSITY, ASTM D 1557.

- EXISTING BITUMINOUS PAVEMENT FROM TAXIWAY "B" AREA TO BE REMOVED TO A DEPTH OF 8". PAYMENT TO BE MADE UNDER ITEM 203.28, EXCAVATION OF SURFACES AND PAVEMENTS. REGRADE DISTURBED AREA TO DRAW, USE PARENT MATERIAL AS FILL, WHERE REQUIRED (NOT A SEPARATE PAY ITEM) DISTURBED AREA TO BE SEEDED, LIMED, FERTILIZED, TOPSOILED, AND MULCHED.

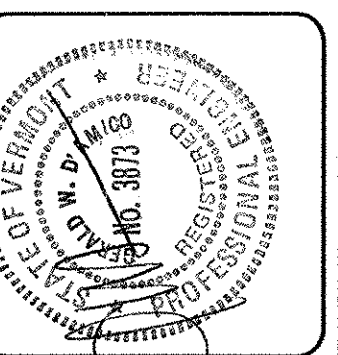

REV.	DATE	DESCRIPTION

RUTLAND STATE AIRPORT
CLARENDON, VERMONT

TAXIWAY IMPROVEMENTS
TYPICAL SECTIONS PROPOSED

URS
1 NORTHWAY LN.
LATHAM, NEW YORK

Designed by G.W.D.
Drawn by M.C.M.
Checked by M.K.C.
Approved by G.W.D.

Scale: AS SHOWN


Date: FEB., 2003

Sheet 8 OF 40


Sheet No

8


PROJECT "B"
A.I.P. 3-50-0015-17

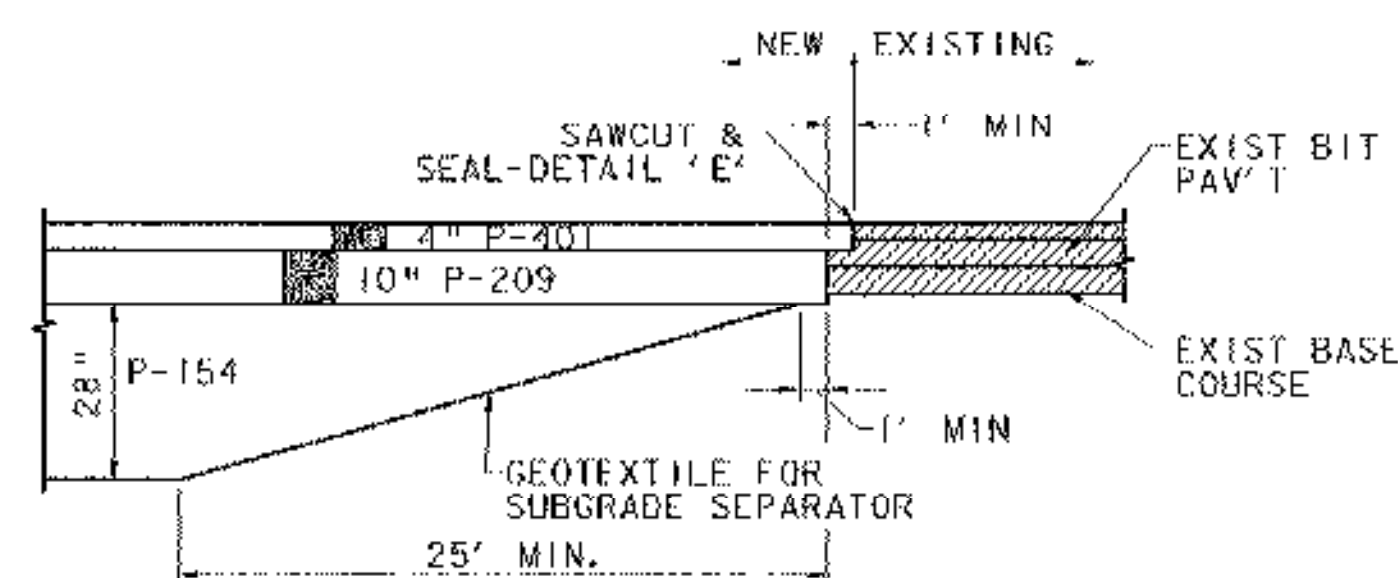


A PROPOSED SUBGRADE TRANSITION
SCALE: NONE

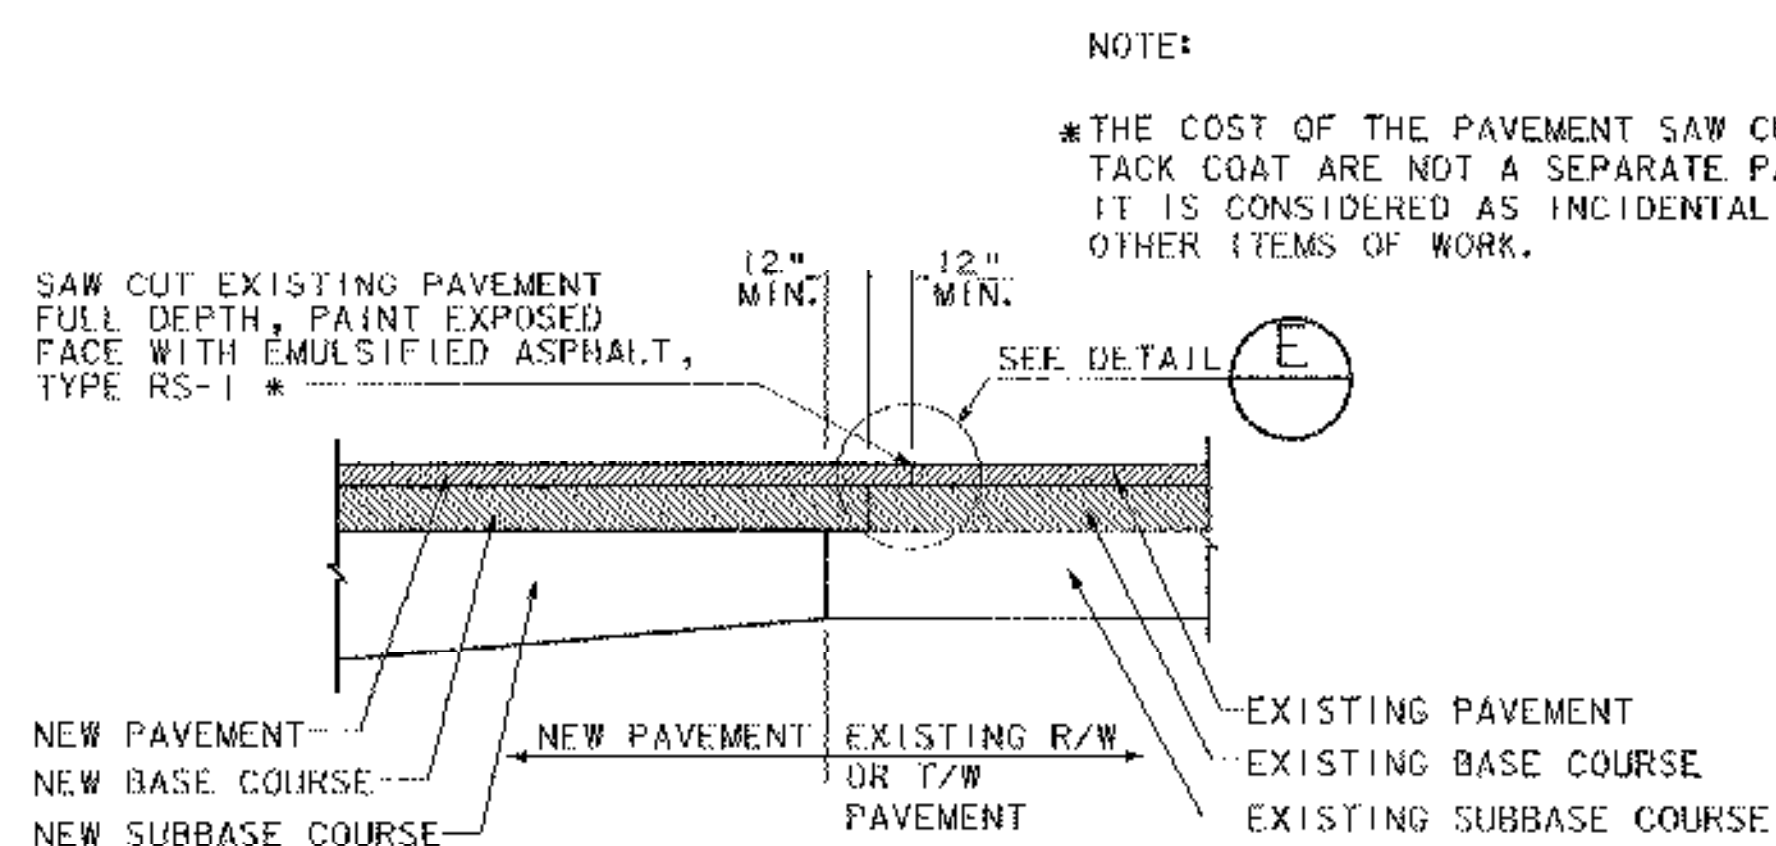


B BUTT JOINT DETAIL
SCALE: NONE

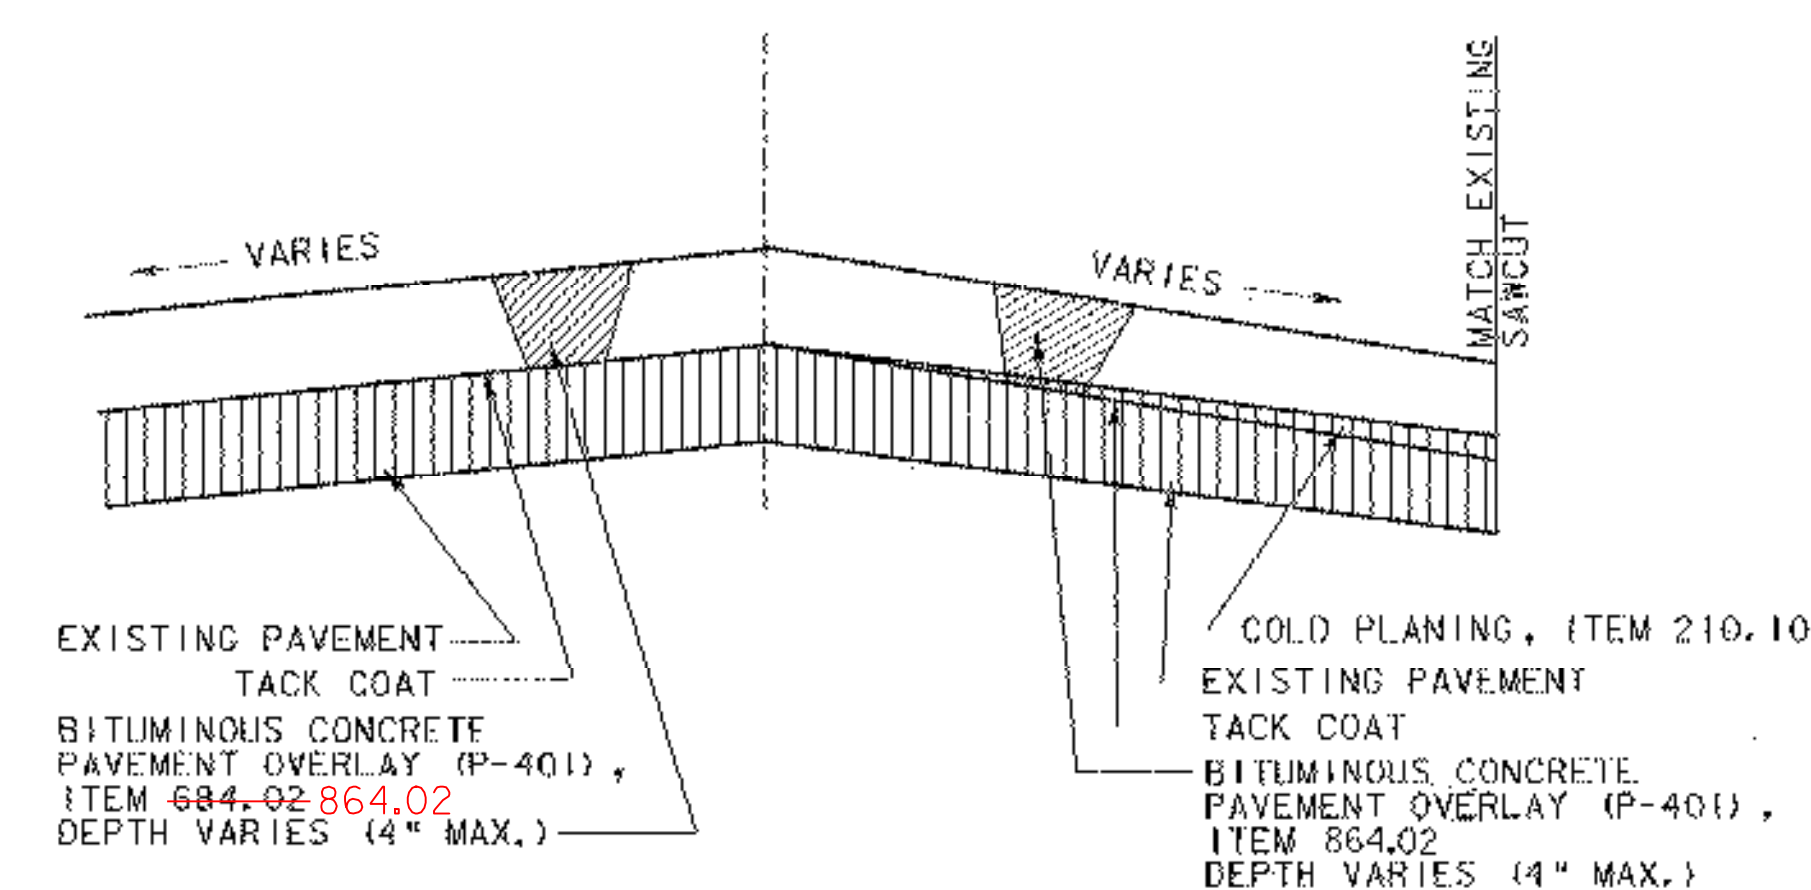


C TYPICAL OVERLAY SECTION
SCALE: NONE

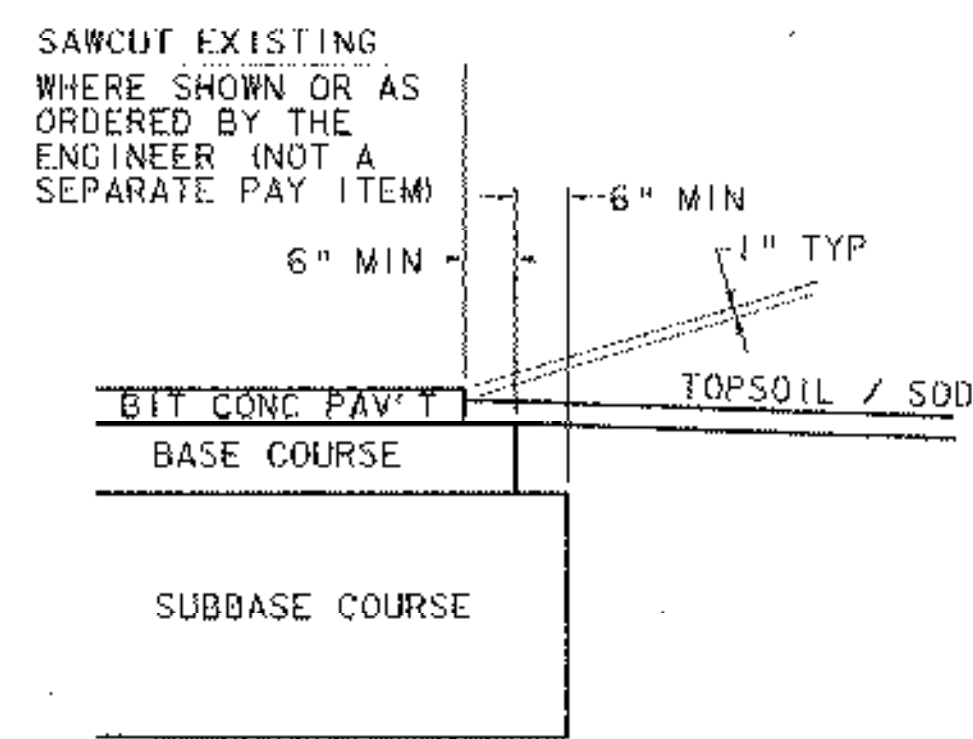

D PAVEMENT SECTION EDGE
SCALE: NONE

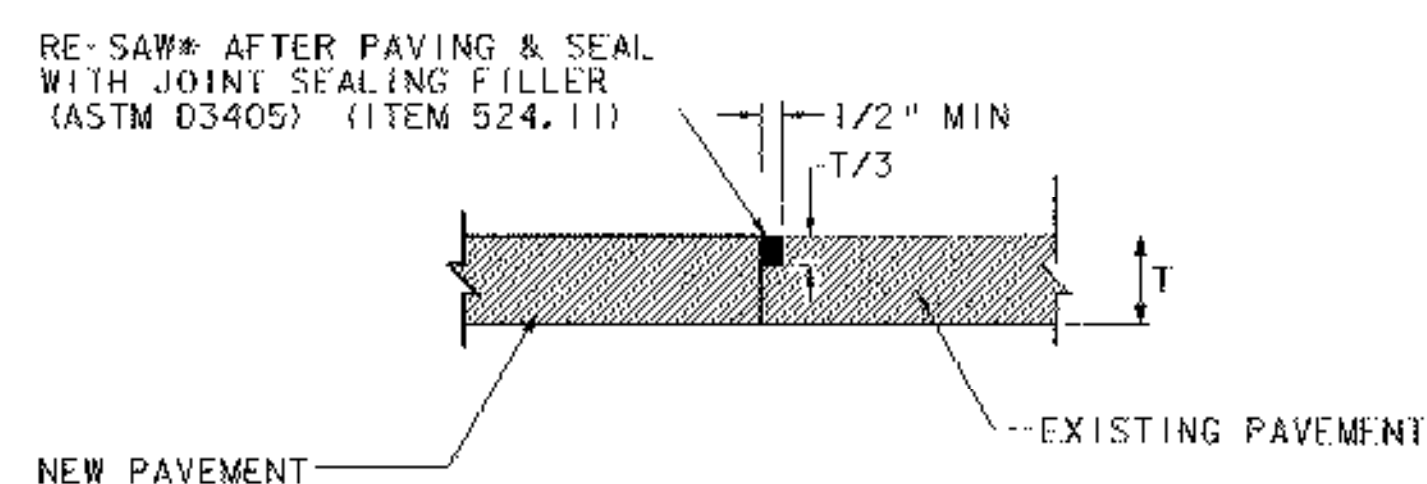

E SAWCUT DETAIL
SCALE: NONE

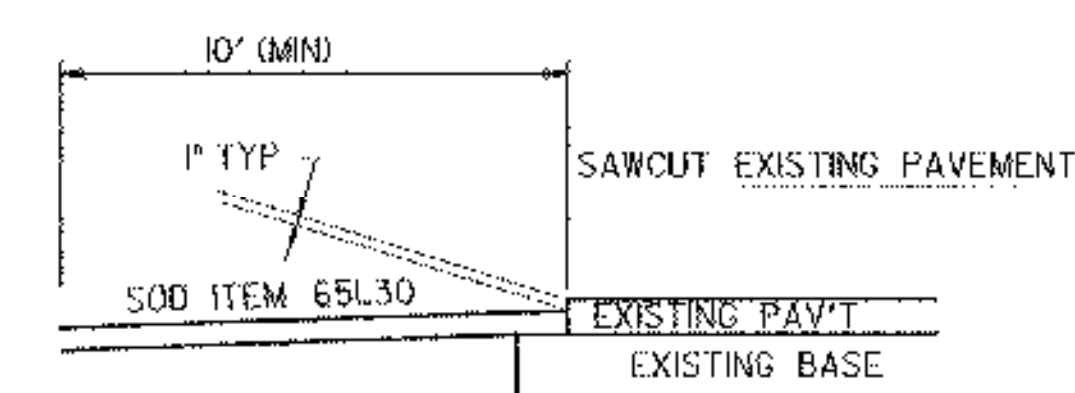

F SAW CUT - PAVEMENT EDGE
SCALE: NONE

URS
1 NORTHWAY LN.
LATHAM, NEW YORK


RUTLAND STATE AIRPORT
CLARENDON, VERMONT

TAXIWAY IMPROVEMENTS
PAVEMENT DETAILS


Designed by: G.M.D.
Drawn by: M.M.
Checked by: M.C.C.
Approved by: G.W.D.

Scale: NTS
Date: FEB., 2003
Sheet 9 OF 40
Sheet No
9



A.I.P. 3-50-0015-17

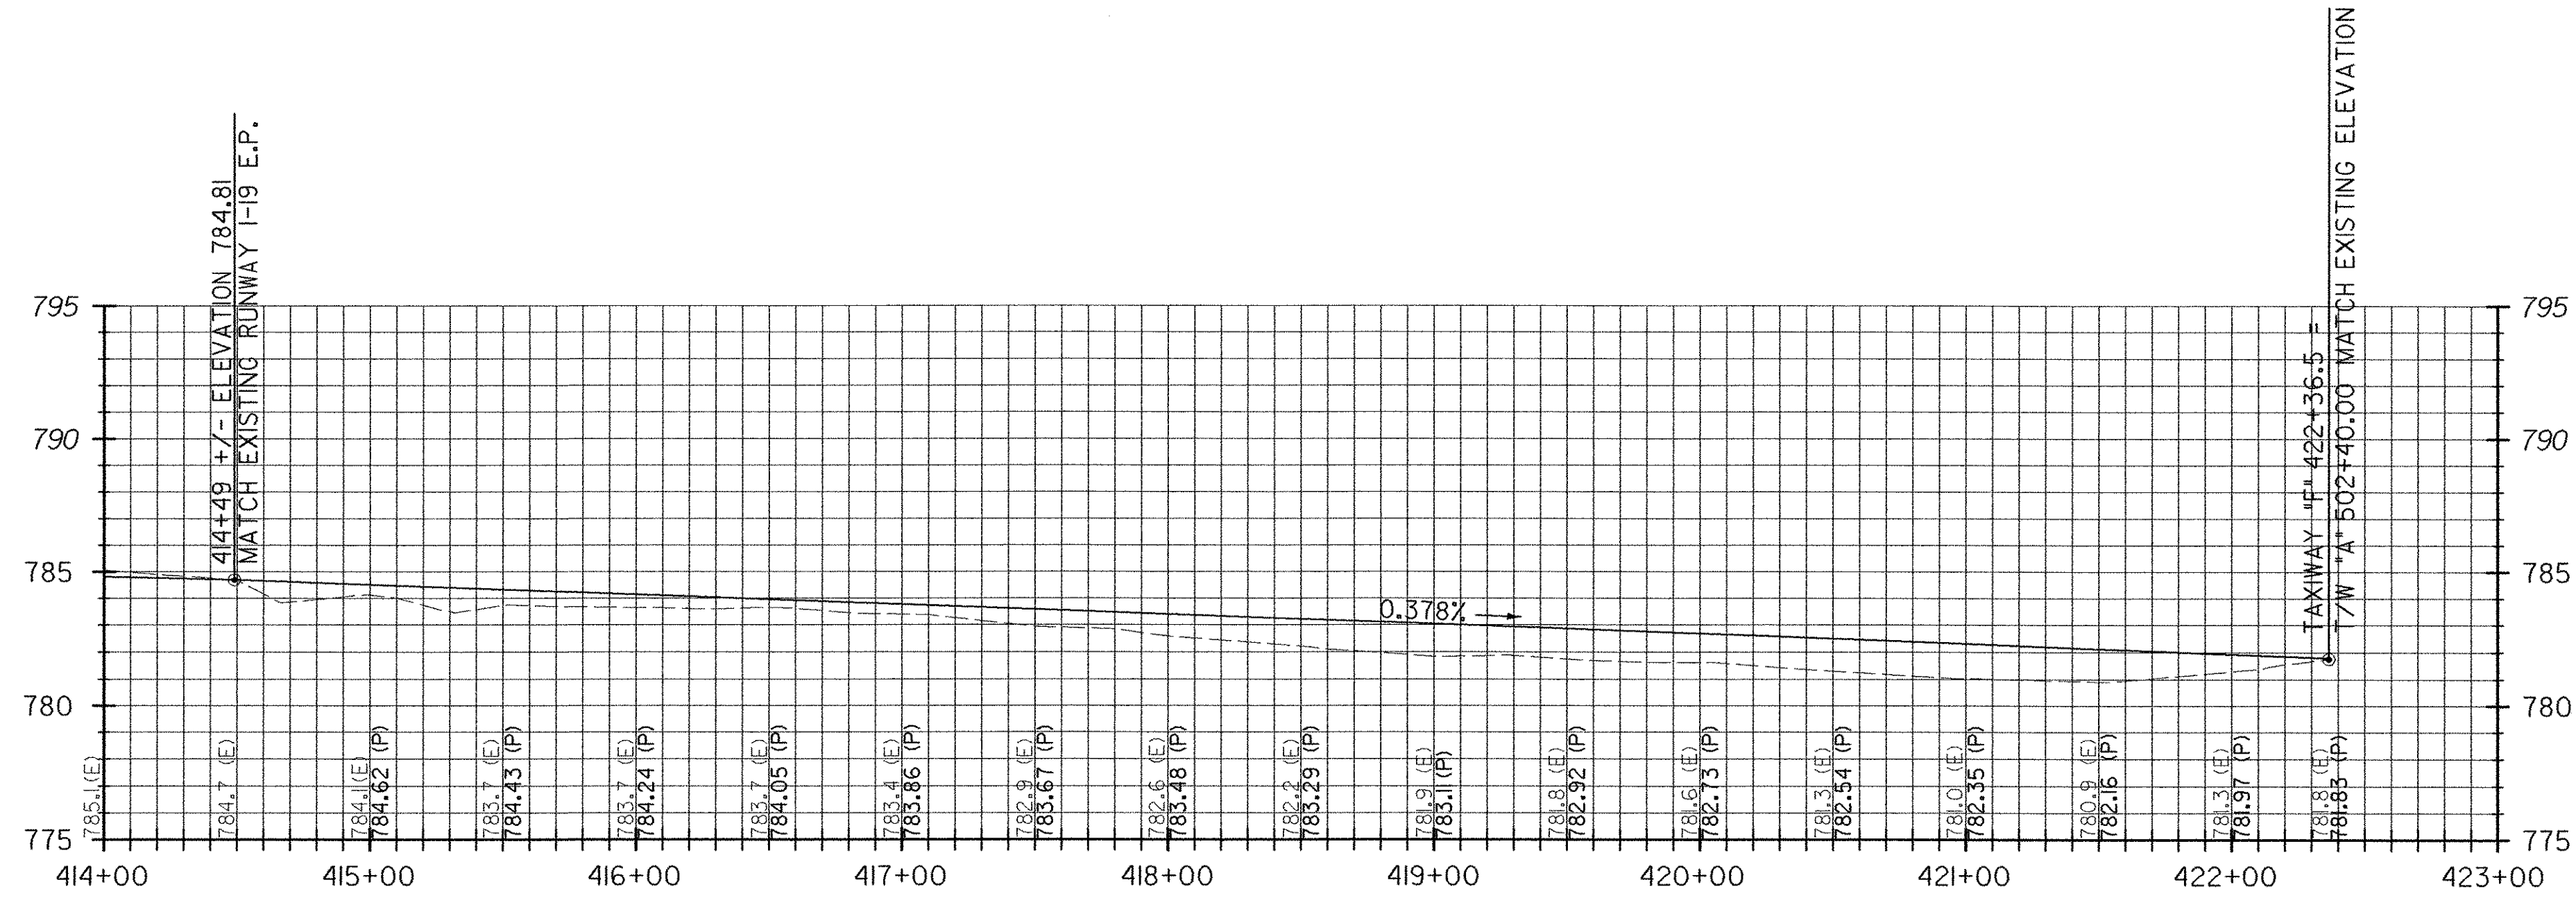

PARALLEL TAXIWAY "F" EAST PROFILE
STA. 414+00 TO 422+36.5

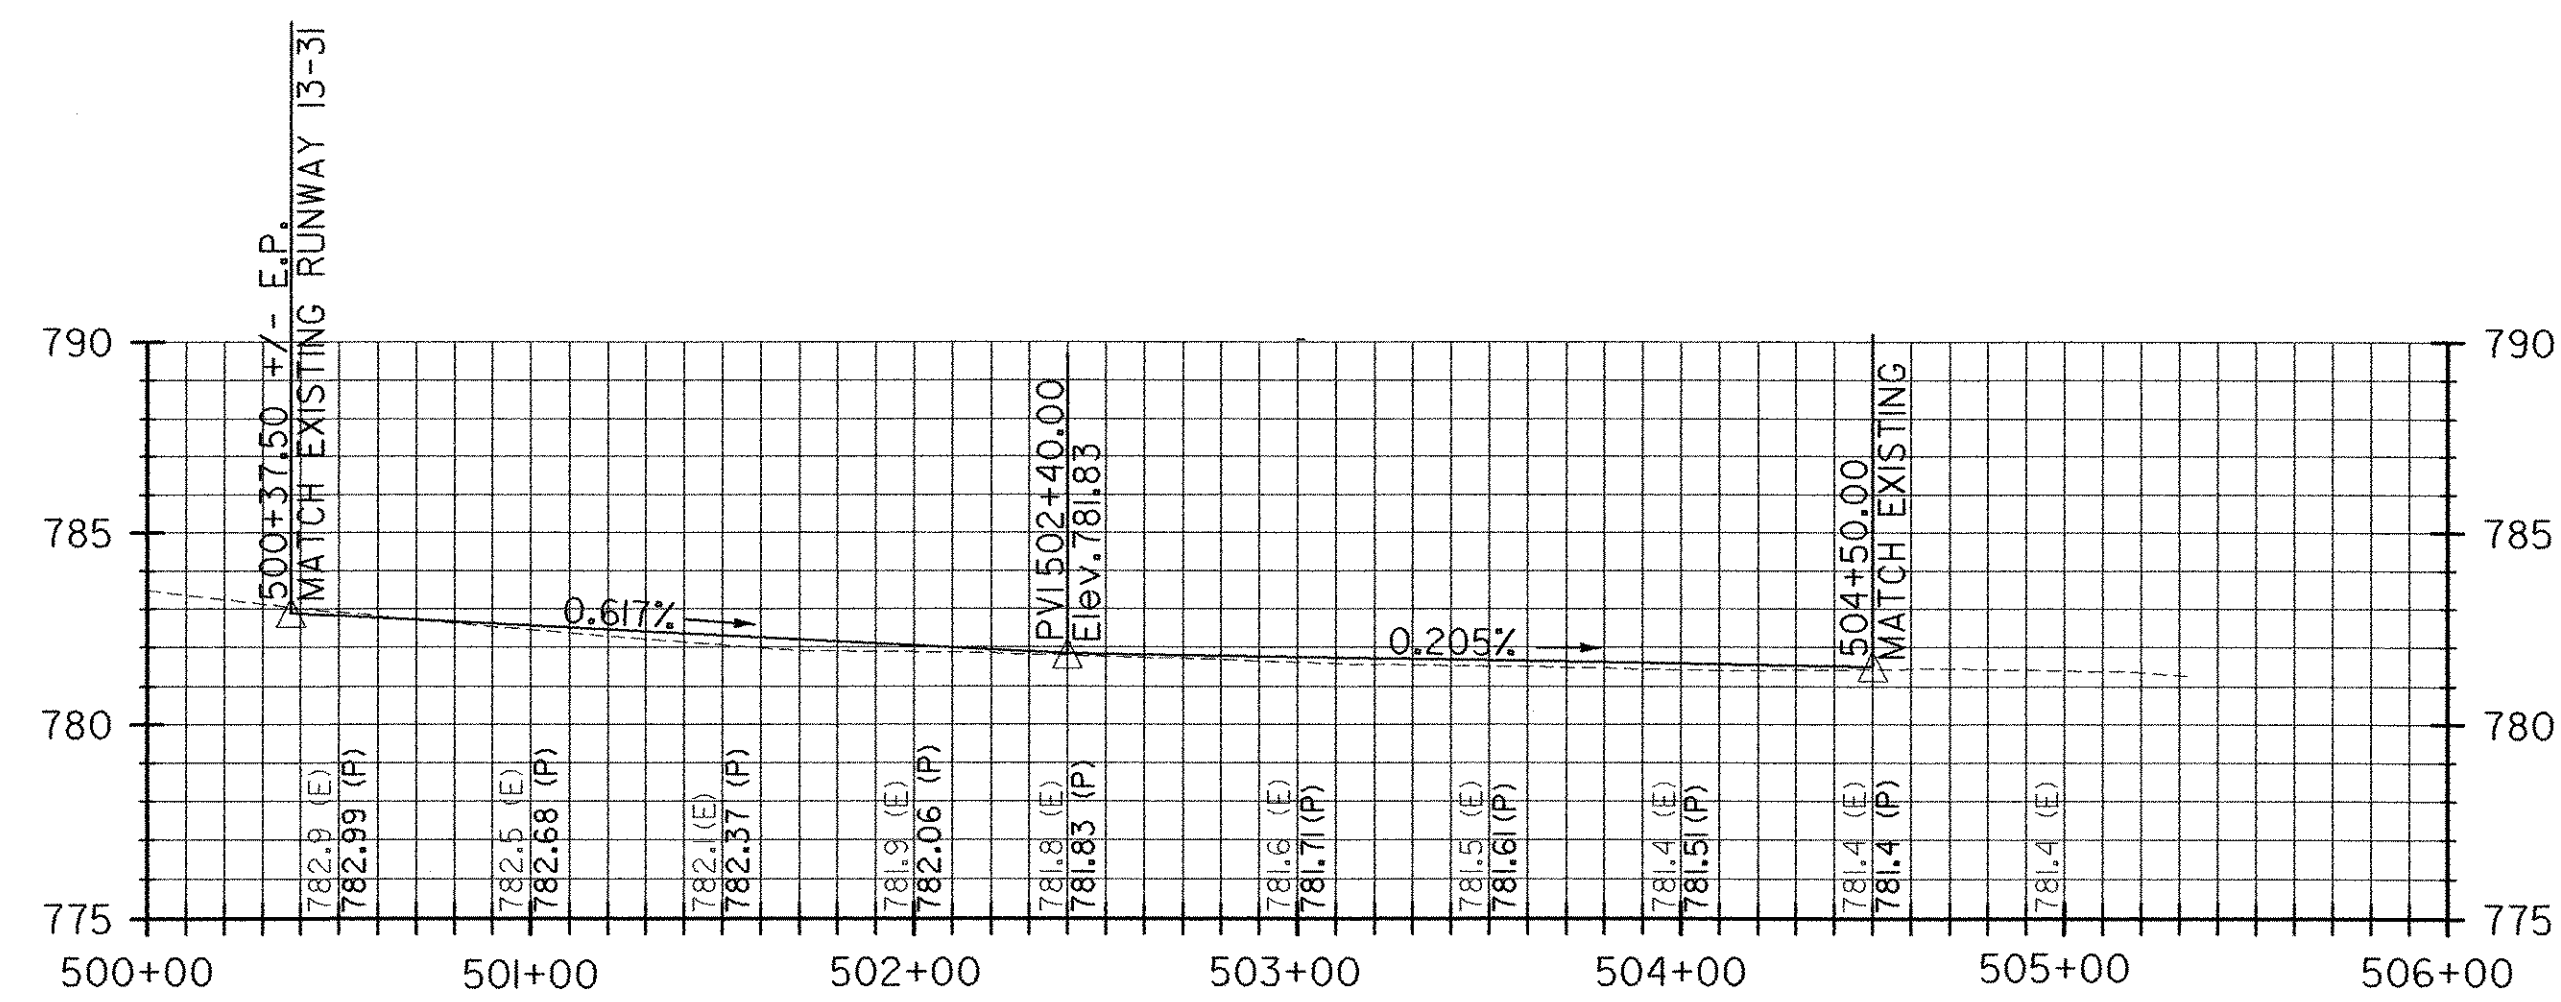

TAXIWAY "A" PROFILE
STA. 500+37.50 TO 505+00

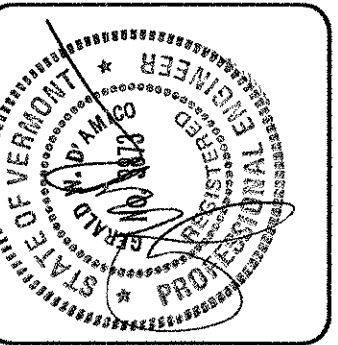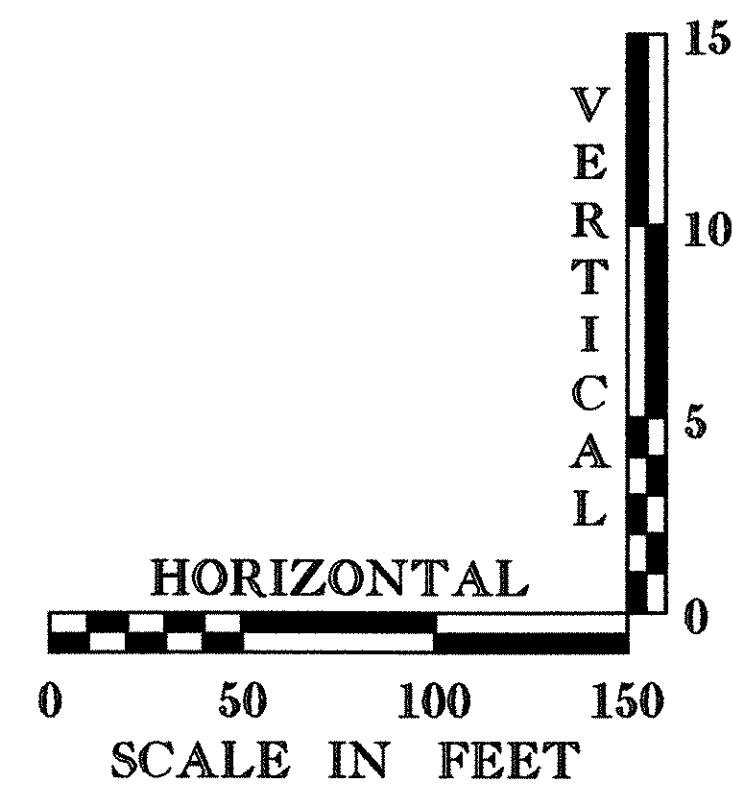

REV.	DATE	DESCRIPTION

Job No. F200002046.00 File No. F2020460IDE11

RUTLAND STATE AIRPORT
CLARENDON, VERMONT

TAXIWAY IMPROVEMENTS
PROFILES

URS
1 NORTHWAY LN.
LATHAM, NEW YORK

Designed by: G.W.D.
Drawn by: M.M.
Checked by: M.C.C.
Approved by: G.W.D.


Scale: AS SHOWN

Date: FEB., 2003

Sheet 11 OF 40

Sheet No
11

PROJECT "B"
A.I.P. 3-50-0015-17

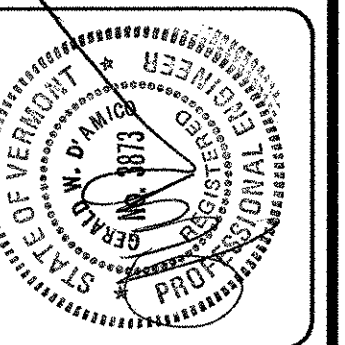

REV.		DATE	DESCRIPTION
Job No. F200002046.00			File No. F20020460DE2


RUTLAND STATE AIRPORT
CLARENDON, VERMONT

TAXIWAY IMPROVEMENTS
PAVING & GEOMETRIC LAYOUT


URS
1 NORTHWAY LN.
LATHAM, NEW YORK

Designed by: G.W.D.
Drawn by: M.C.M.
Checked by: M.A.C.
Approved by: G.W.D.

Scale: 1"=50'
Date: FEB., 2003
Sheet 12 OF 40
Sheet No 12

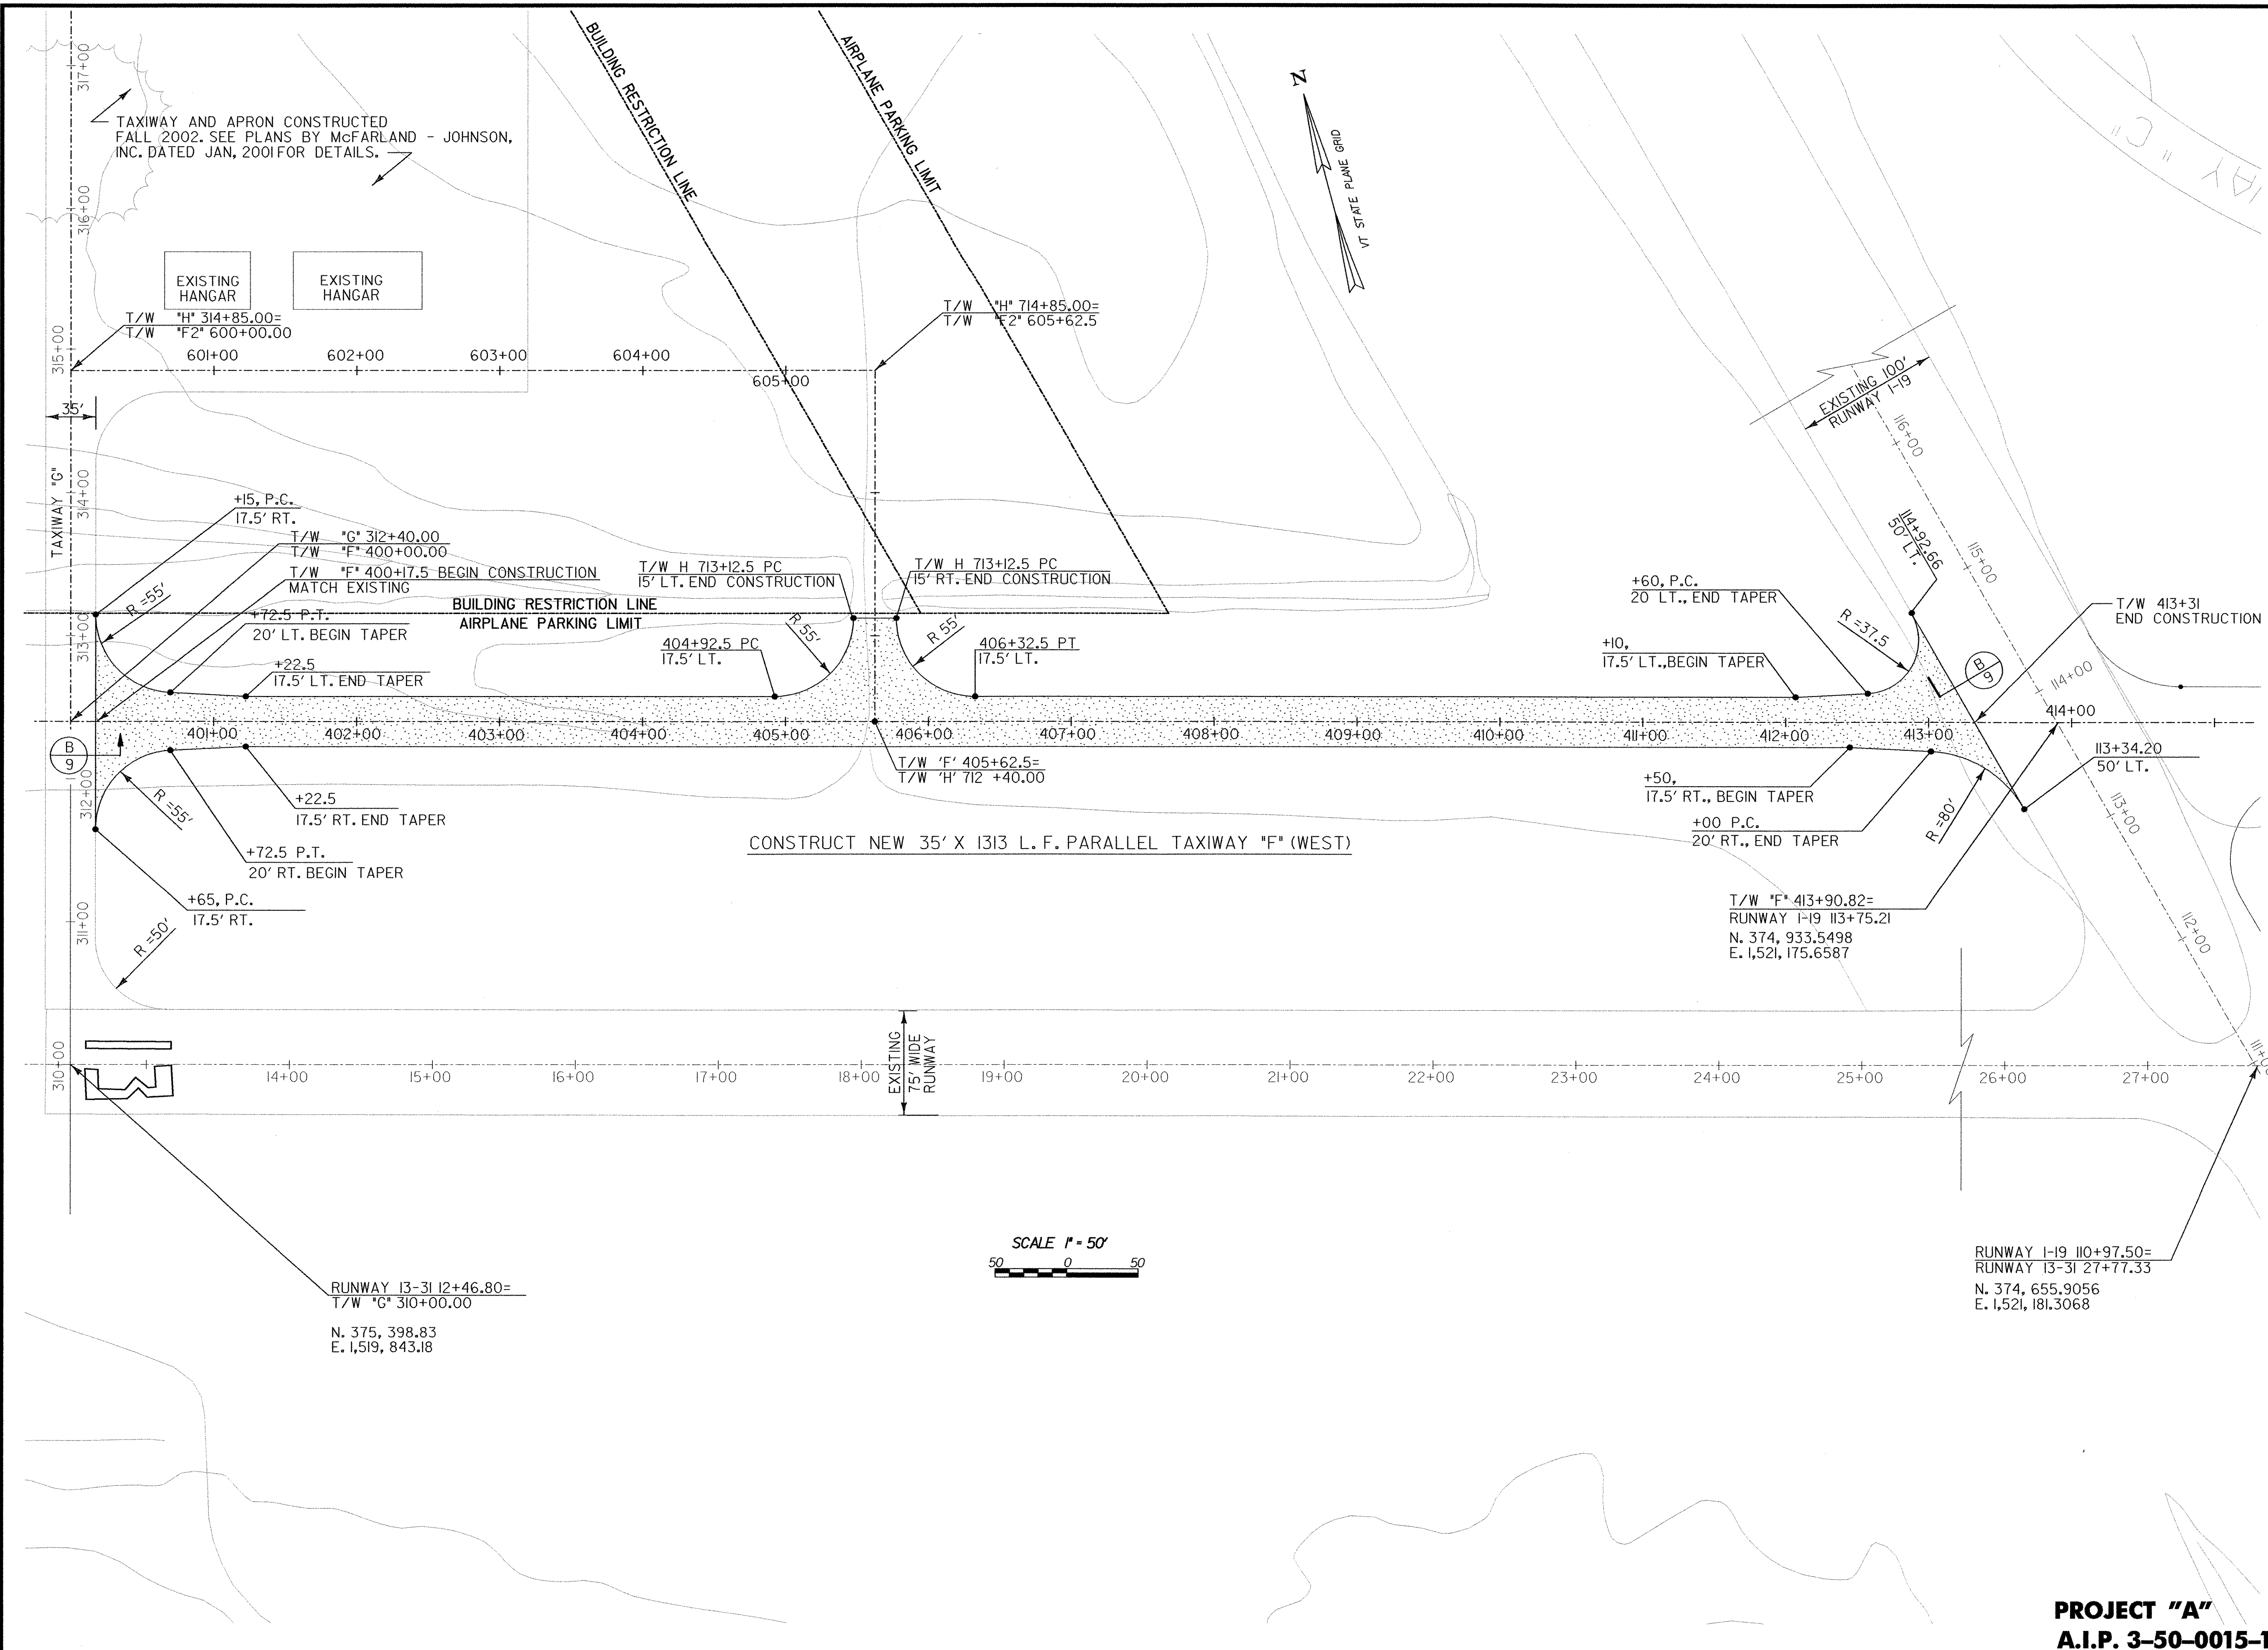

PROJECT "A"
A.I.P. 3-50-0015-17

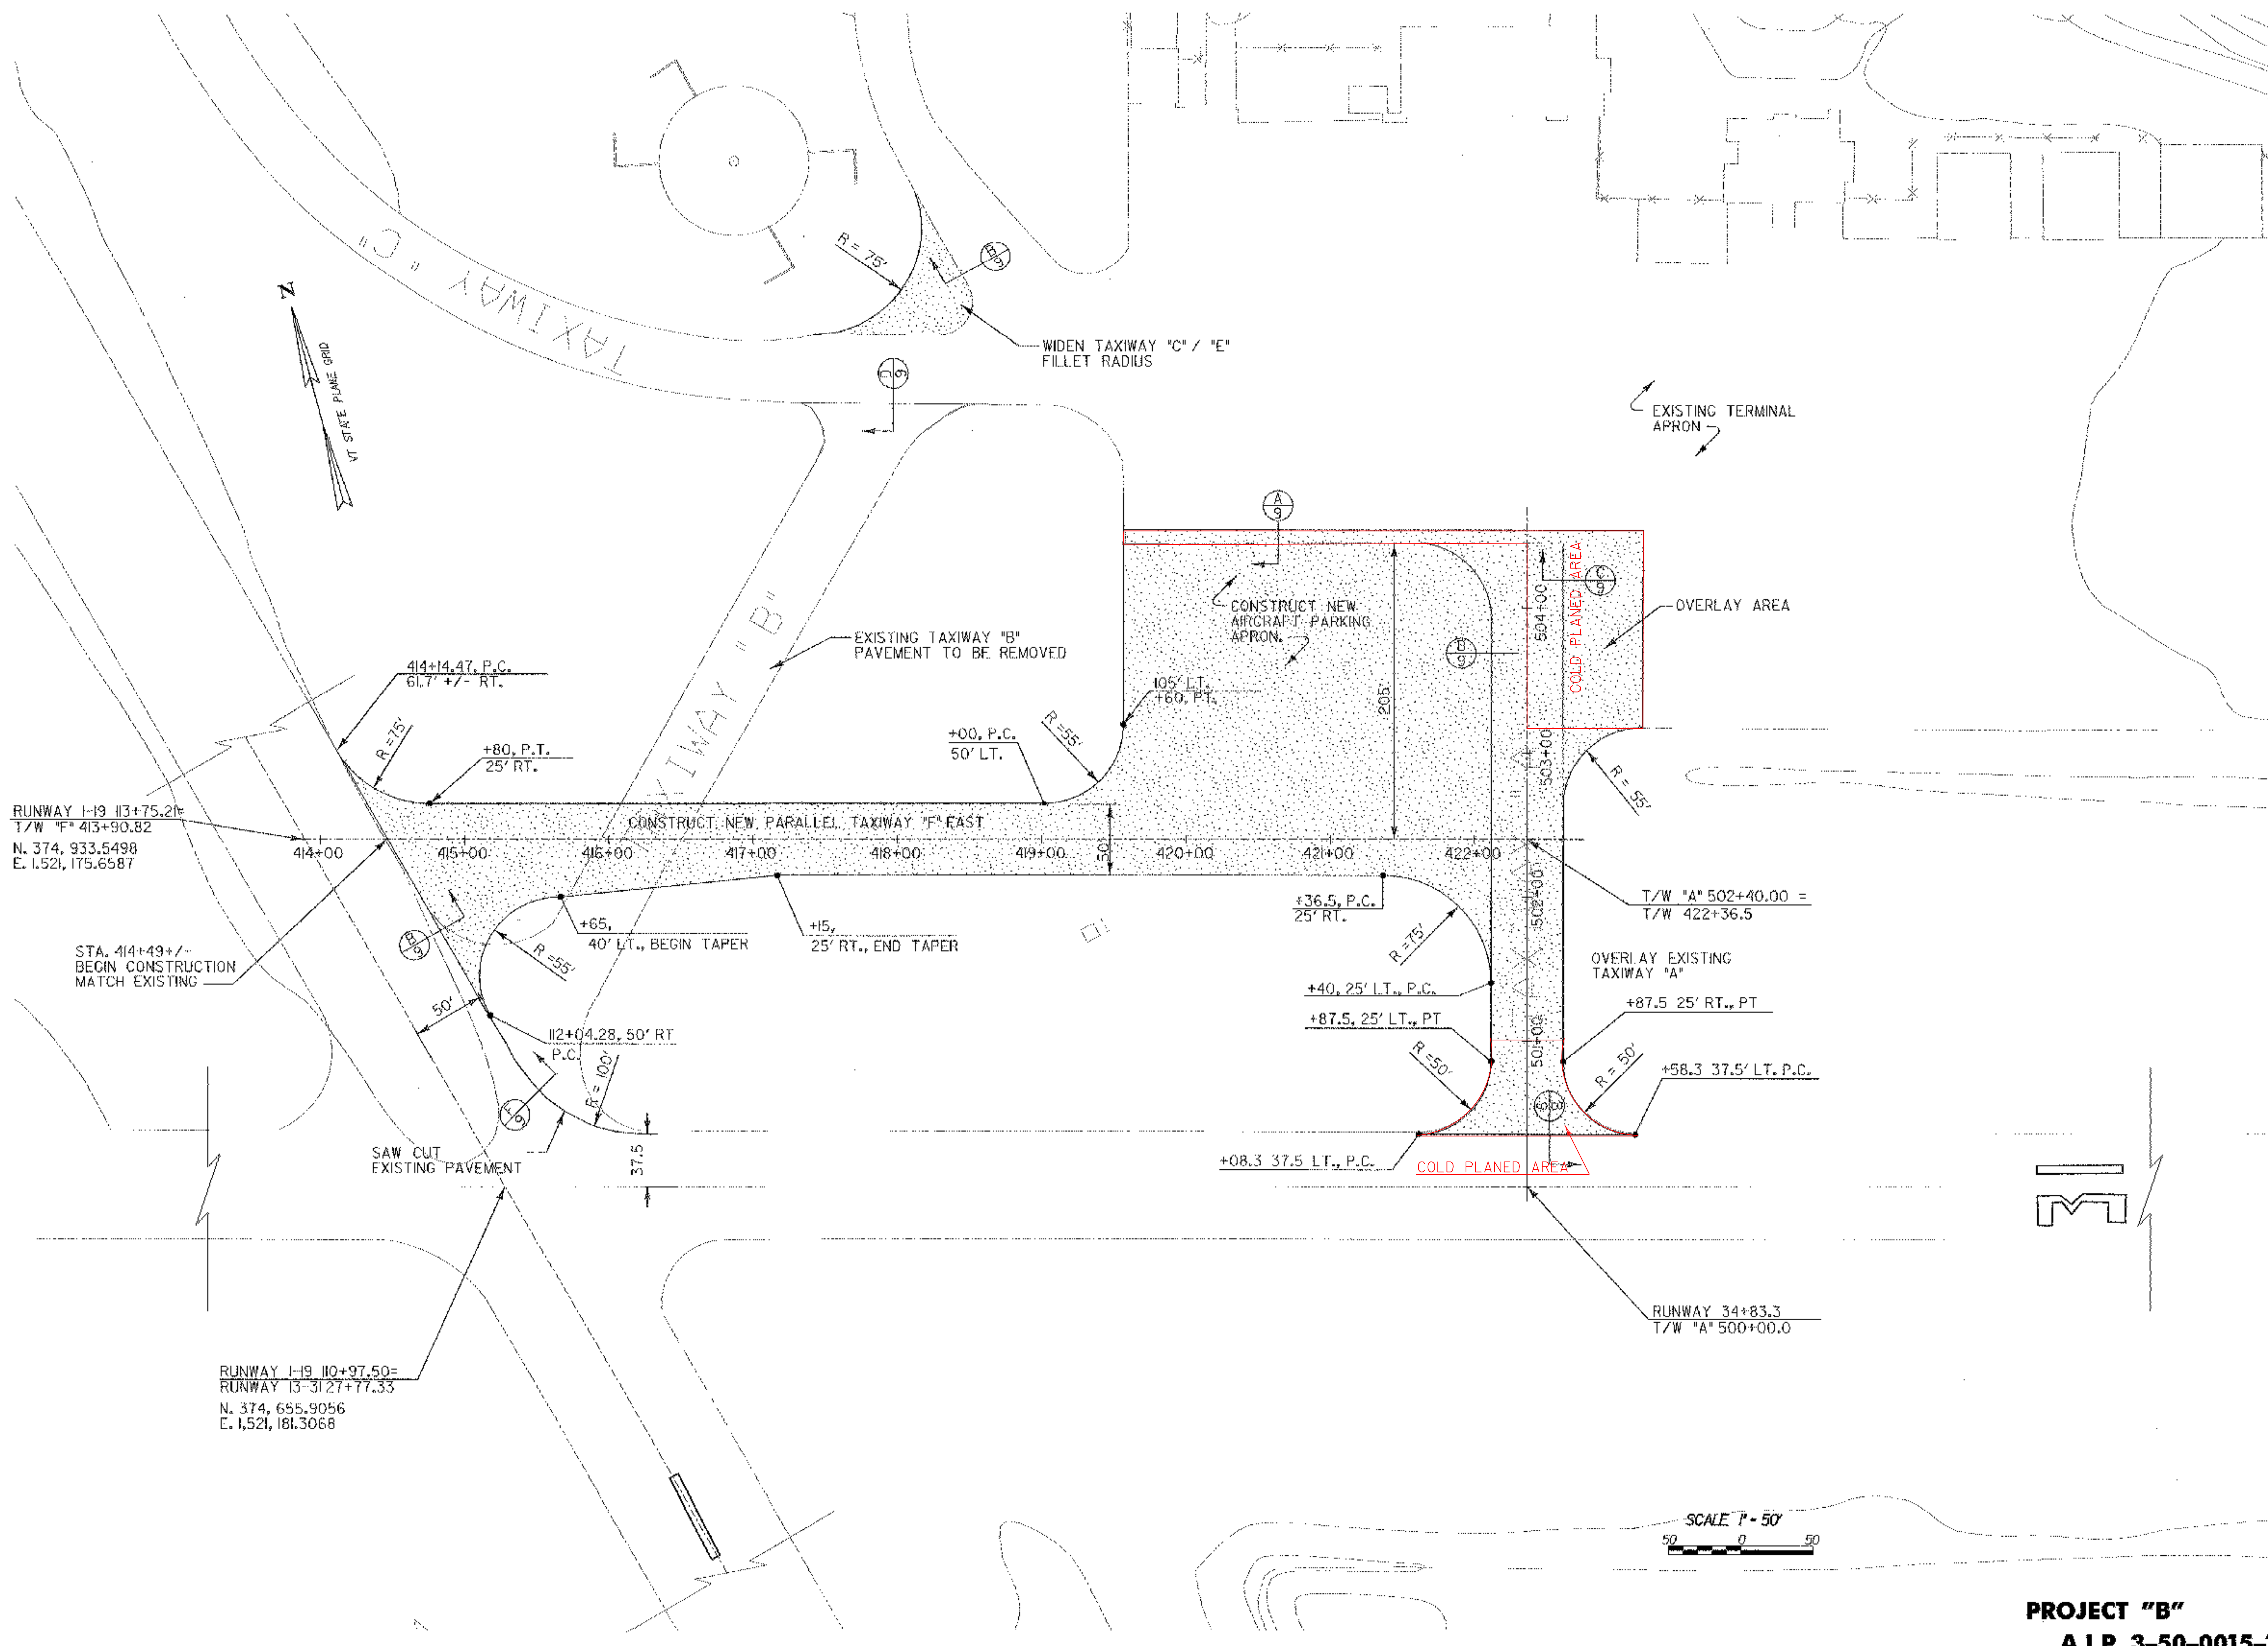

DESIGNED BY: G.M.D.
DRAWN BY: M.C.M.
CHECKED BY: M.K.C.
APPROVED BY: G.M.D.

Scale: 1" = 50'
Date: FEB., 2003
Sheet: 13 OF 40

PROJECT "B"
A.I.P. 3-50-0015-17

RUTLAND STATE AIRPORT
 CLARENDON, VERMONT

TAXIWAY IMPROVEMENTS
PAVING & GEOMETRIC LAYOUT

URS
 1 NORTHWAY LN.
 LATHAM, NEW YORK

REV. **DATE** **DESCRIPTION**

1 01/15/03 13

Job No. F200302046.00
File No. F2020460013



REV.	DATE	DESCRIPTION

RUTLAND STATE AIRPORT
CLARENDON, VERMONT

TAXIWAY IMPROVEMENTS
GRADING AND DRAINAGE PLAN

URS
1 NORTHWAY LN.
LATHAM, NEW YORK

Designed by: G.W.D.
Drawn by: M.C.M.
Checked by: M.C.C.
Approved by: G.W.D.

Scale: 1"=50'

Date: FEB., 2003

Sheet 14 OF 40

Sheet No
14

LEGEND

- EXISTING DROP INLET
- NEW DROP INLET #100
- NEW 6" DIA. UNDERDRAIN
- EXISTING 6" DIA. UNDERDRAIN
- EXISTING FLUSHING BASIN
- NEW FLUSHING BASIN
- FLOW LINE
- SILT FENCE
- LIMIT OF WETLANDS
- CONSTRUCTION LIMITS
- EXISTING CONTOURS
- PROPOSED CONTOURS

CONSTRUCT SPECIAL DITCH
60' LT. 113+32 TO 50' RT. 412+50

EXISTING 24" RCP X 156 LF
BY OTHERS

NEW ELECTRICAL DUCT
SEE SHEET 20-21

405+62.5, 85' LT. 96' L.F. X 24" DIA
RCP CLASS V W/ STONE FILL @ INLET AND
OUTLET, S= 0.333% AND 24" R.C.P.E.S.
AT INLET

85' L.F. R-777.5
W/ STONE FILL
TYPE 1

CUT AND PLUG
EXISTING UNDERDRAIN

INSTALL NEW FB25A
57.5' LT. 114+92 +X-
CONNECT TO EXISTING UNDERDRAIN

REMOVE EXISTING
FB25

INSTALL NEW FB24A
CONNECT NEW 6"
UNDERDRAIN 57.5' LT. R/W 113+32±

(EXISTING
TO REMAIN)

NOTES :

- ALL ELEVATIONS REFERENCE MEAN SEA LEVEL (NAVD-1988)
- CONTRACTOR TO INSTALL SILT FENCE WHERE NOTED ON THE PLANS OR AS DIRECTED BY THE ENGINEER, PRIOR TO COMMENCING OTHER WORK IN THE AREA. SILT FENCE IS GENERALLY PLACED 1' INSIDE CONSTRUCTION LIMITS.
- EROSION MATTING TO BE PLACED ON SLOPES GREATER THAN 5% OR WHEN DIRECTED BY THE ENGINEER.
- ALL EARTH AREAS DISTURBED BY THE CONSTRUCTION WILL BE TOPSOILED, OR SODDED AS DIRECTED, SEEDING AND MULCHED, AS SOON AS WORK IN THE AREA IS COMPLETED.
- CONSTRUCTION LIMITS ARE GENERALLY 10' (TYP.) BEYOND TOE OF SLOPE/TOP OF CUT.
- REMOVE EXISTING 6" UNDERDRAIN BETWEEN FB24A AND FB25A

SCALE 1" = 50'

RUNWAY 1-19 110+97.50=
RUNWAY 13-31 27+77.33
N. 374, 655.9056
E. 1,521, 181.3068

RUNWAY 13-31 12+46.80=
T/W 310+00.00
N. 375, 398.83
E. 1,519, 843.18

REPLACE EXISTING FRAME AND GRATE ON DI#108 WITH NEW FRAME AND GRATE CAPABLE OF SUPPORTING AIRCRAFT WITH A GROSS WEIGHT OF 90,000 LBS. USE LEBARON RECTANGULAR AIRPORT CATCH BASIN FRAMES. ADJUST F&G ELEVATION TO 780.5. (ITEM 604.47)

CHANGE ELEVATIONS OF DROP-INLETS DI# 102

EXISTING 48" X 48" ELECTRICAL MH

GRASS

STAT' HANGAR

TERMINAL

GRASS

LEGEND

-  EXISTING DROP INLET
-  NEW DROP INLET #100
-  NEW 6" DIA. UNDERDRAIN
-  EXISTING 6" DIA. UNDERDRAIN
-  EXISTING FLUSHING BASIN
-  NEW FLUSHING BASIN
-  FLOW LINE
-  SILT FENCE
-  LIMIT OF WETLANDS
-  CONSTRUCTION LIMITS
-  EXISTING CONTOURS
-  PROPOSED CONTOURS

RUTLAND STATE AIRPORT
CLARENDON, VERMONT

TAXIWAY IMPROVEMENTS
GRADING AND DRAINAGE PLAN

URS
1 NORTHWAY LN.
LATHAM, NEW YORK

Designed by G.M.D.
Drawn by M.C.M.
Checked by J.K.C.
Approved by G.M.D.

Scale: 1"=50'
Date: FEB., 2003
Sheet 15 OF 40
Sheet No. **15**


PROJECT "B"
A.I.P. 3-50-0015-17

NOTES :


1. ALL ELEVATIONS REFERENCE MEAN SEA LEVEL (NAVD-1988)
2. CONTRACTOR TO INSTALL SILT FENCE WHERE NOTED ON THE PLANS OR AS DIRECTED BY THE ENGINEER, PRIOR TO COMMENCING OTHER WORK IN THE AREA. SILT FENCE IS GENERALLY PLACED 1' INSIDE CONSTRUCTION LIMITS.
3. EROSION MATTING TO BE PLACED ON SLOPES GREATER THAN 5% OR DIRECTED BY THE ENGINEER.
4. ALL EARTH AREAS DISTURBED BY THE CONSTRUCTION WILL BE TOPSOILED, OR SODDED AS DIRECTED, SEEDED AND MULCHED, AS SOON AS WORK IN THE AREA IS COMPLETED.
5. CONSTRUCTION LIMITS ARE GENERALLY 10' (TYP.) BEYOND TOE OF SLOPE/TOP OF CUT.
6. EXISTING TAXIWAY "B" PAVEMENT TO BE REMOVED; AREA TO BE REGRADED, AS DIRECTED; SEEDED, AND MULCHED. PAVEMENT REMOVAL TO BE PAID UNDER ITEM 203.28, EXCAVATION OF SURFACES AND PAVEMENTS.
7. REMOVE EXISTING UNDERDRAIN BETWEEN 114+35 AND D.I. #102.

SCALE 1"=50'-0"
50 0 50


VT STATE PLANE 6810

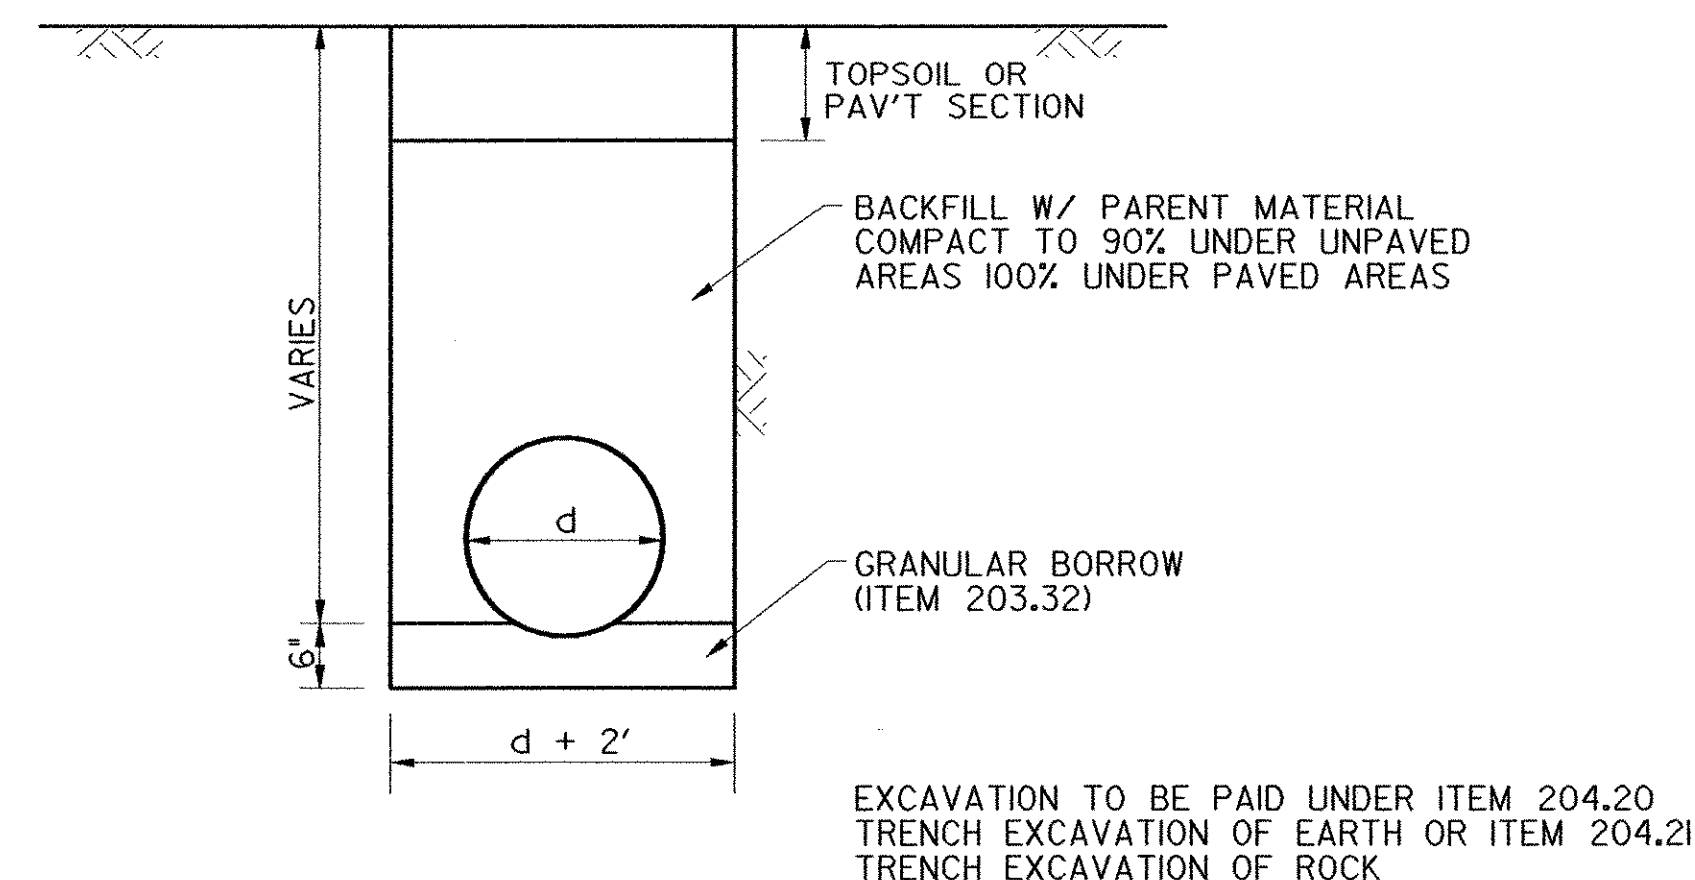


A CULVERT IN TRENCH - TYPICAL
SCALE: NONE

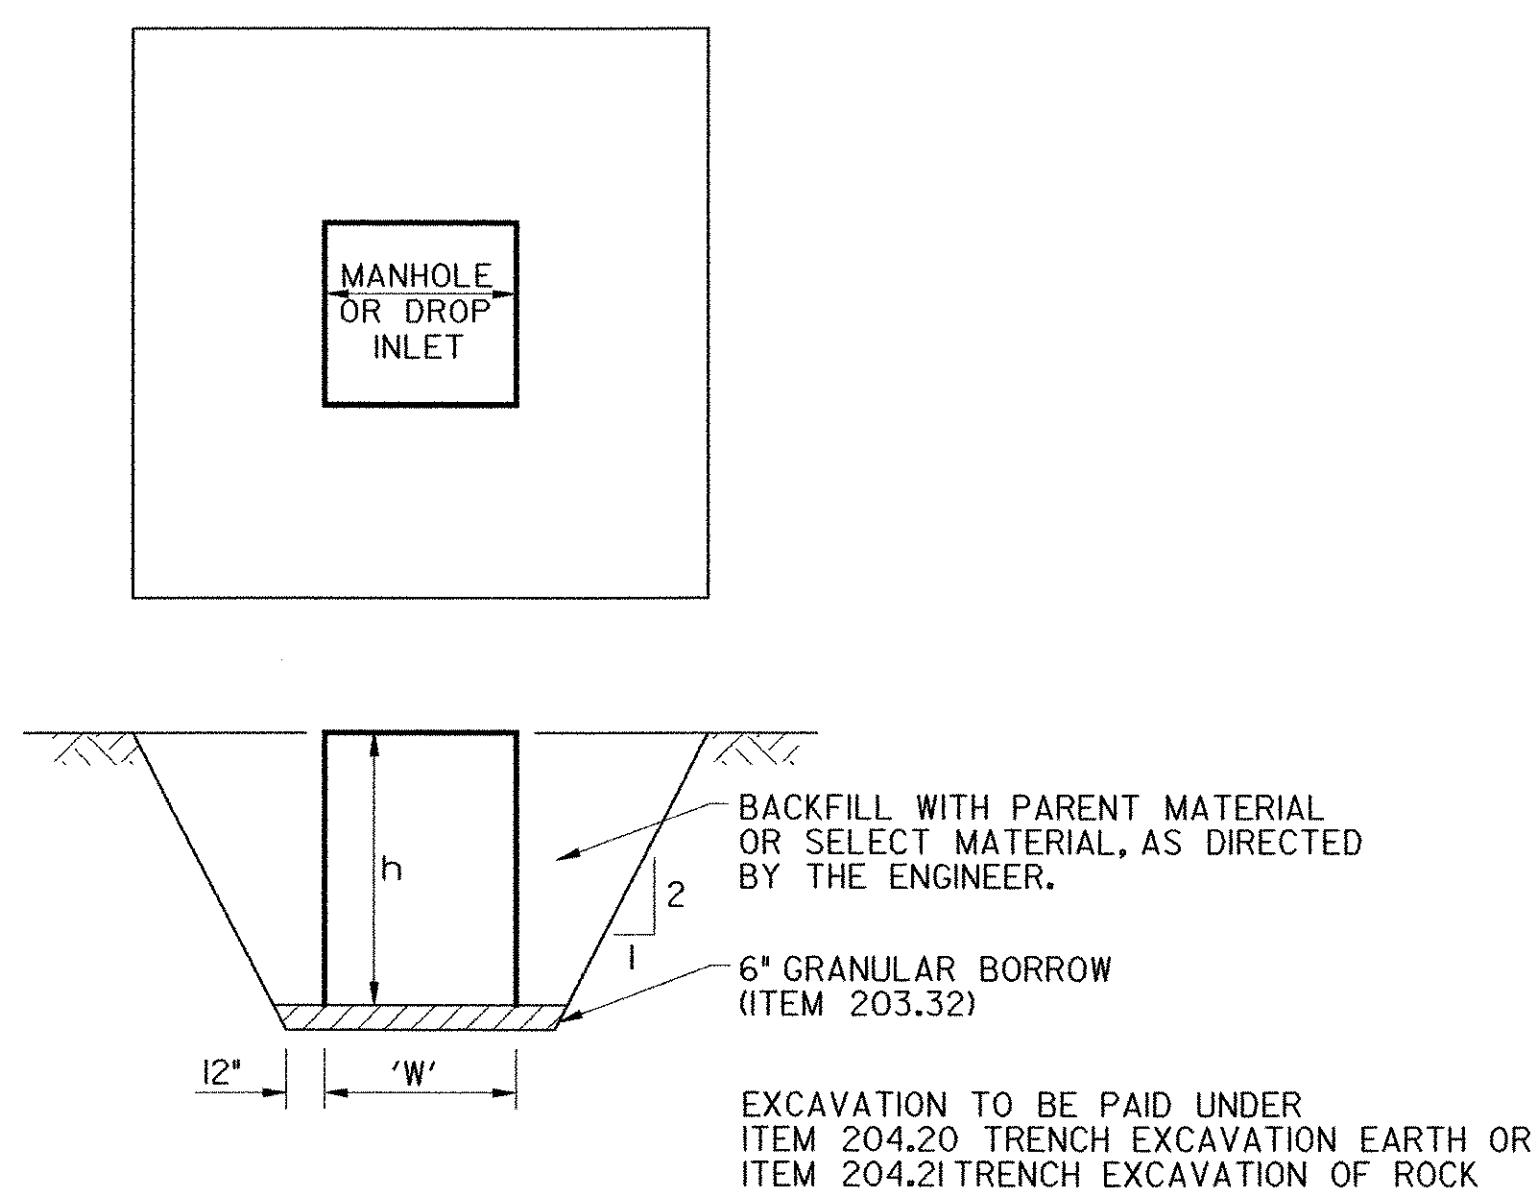


B DROP INLET/MANHOLE PLACEMENT (TYPICAL)
SCALE: NONE

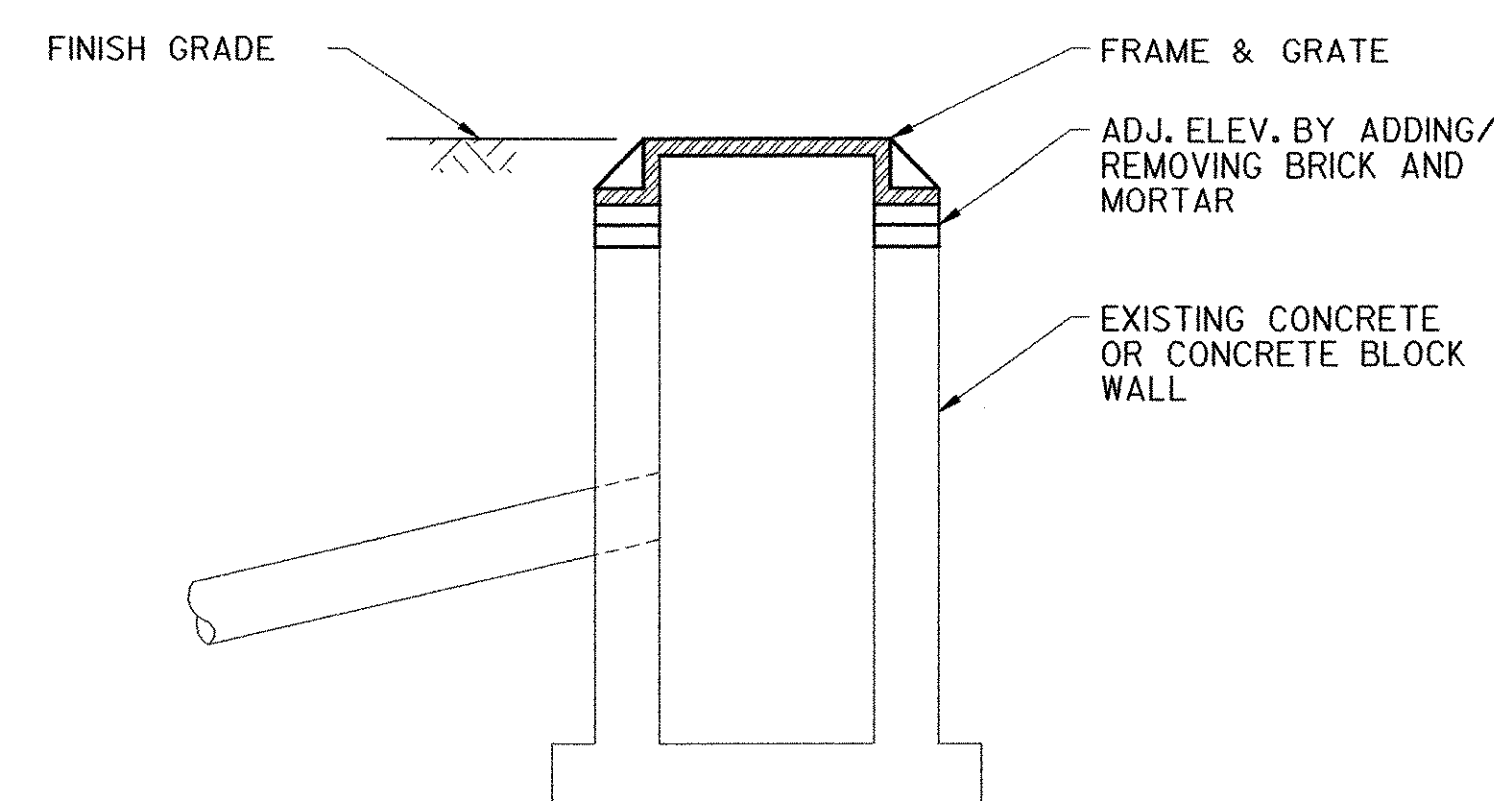

C CHANGING ELEVATIONS OF DROP INLETS, CATCH BASINS OR MANHOLES, ITEM 604.40
SCALE: NONE

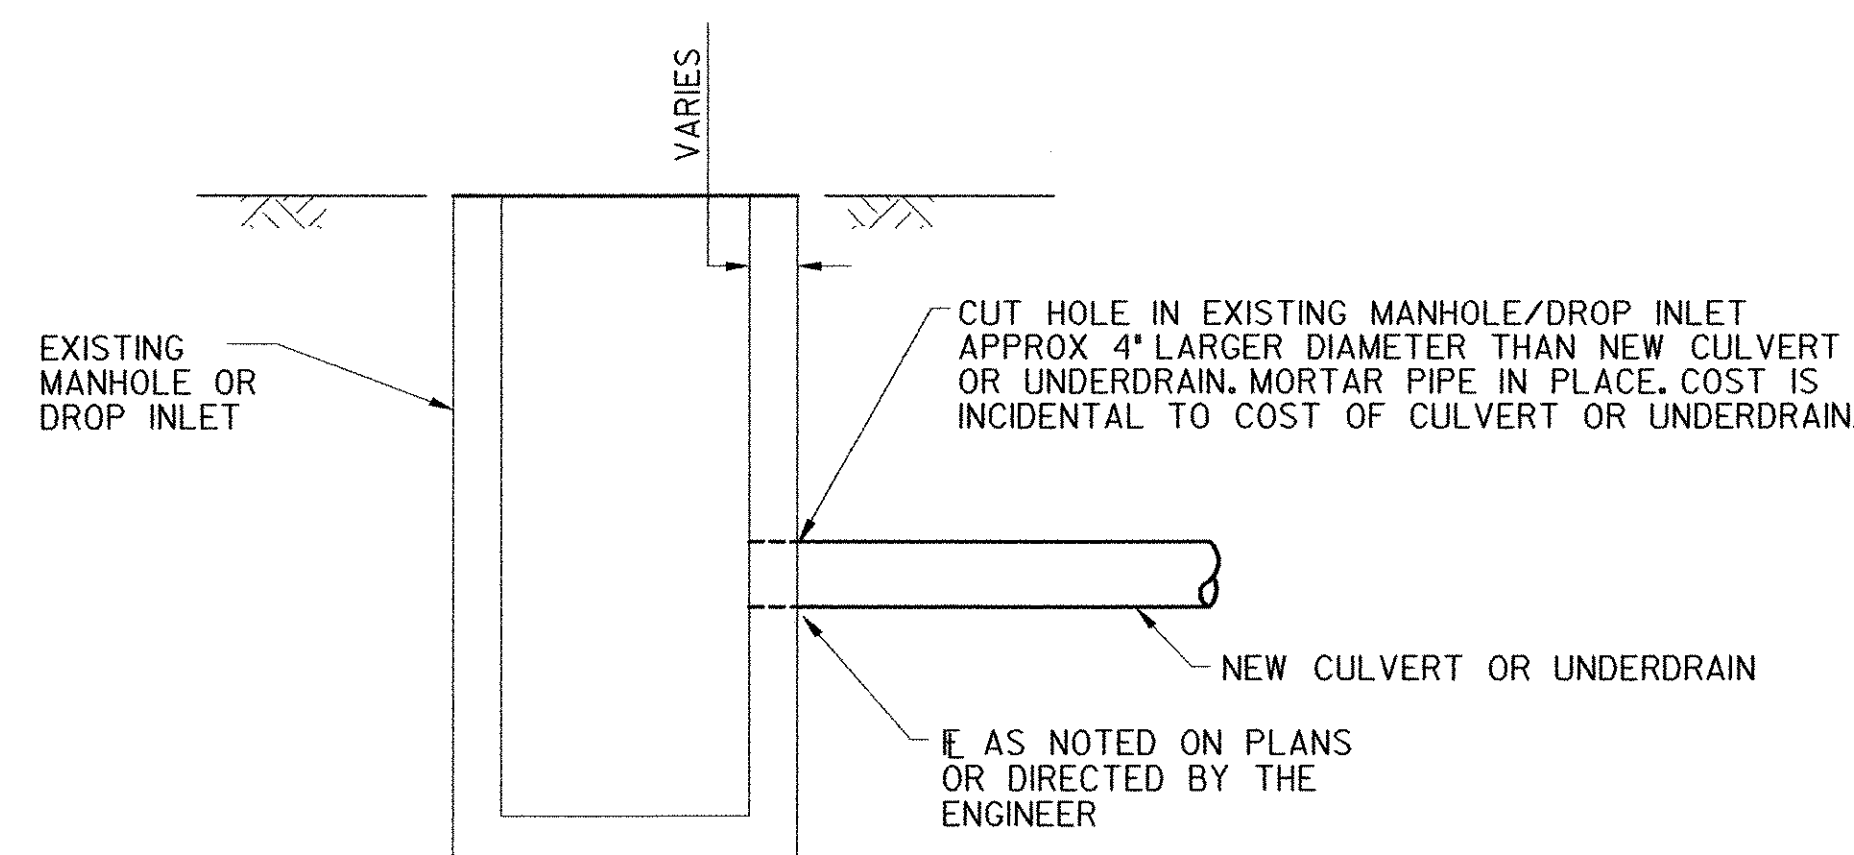


D CULVERT OR UNDERDRAIN INSTALLATION IN EXISTING MANHOLE OR DROP INLET
SCALE: NONE

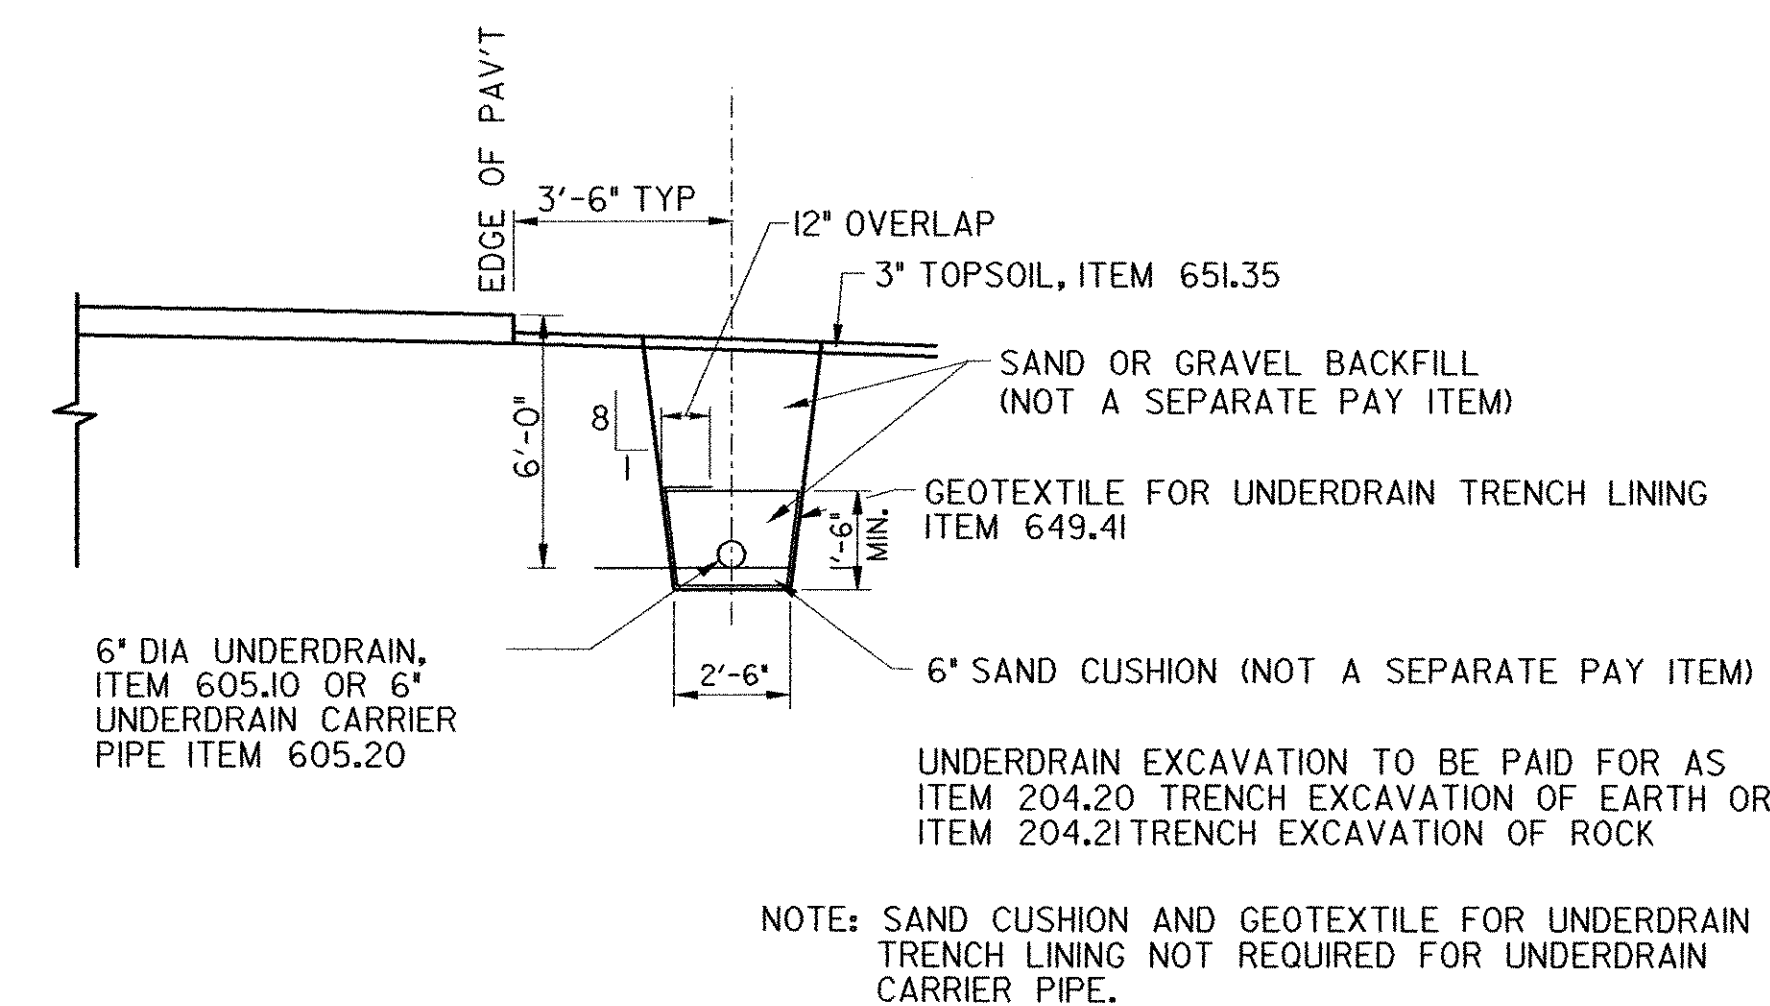

E 6\"/>

NOTE:
ALL NEW FRAMES AND GRATES ON ALL MANHOLES, CATCH BASINS AND DROP INLETS TO BE CAPABLE OF SUPPORTING AIRCRAFT WEIGHING UP TO 90,000 LBS. USE LABARON FOUNDRY (OR EQUAL) RECTANGULAR CATCH BASIN FRAMES, RATED FOR AIRCRAFT LOADING.

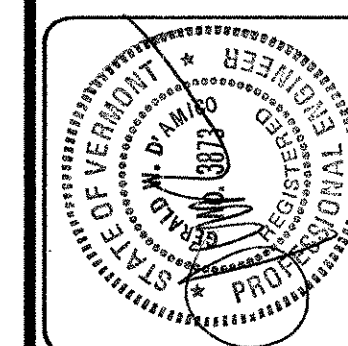

REV.	DATE	DESCRIPTION

File No. F20204600DET

Job No. F20002046.00

RUTLAND STATE AIRPORT
CLARENDON, VERMONT

TAXIWAY IMPROVEMENTS
DRAINAGE DETAILS

URS
1 NORTHWAY LN.
LATHAM, NEW YORK


Designed by G.W.D.
Drawn by M.C.M.
Checked by M.K.C.
Approved by G.W.D.

Scale: AS SHOWN


Date: FEB., 2003

Sheet 17 OF 40

Sheet No
17

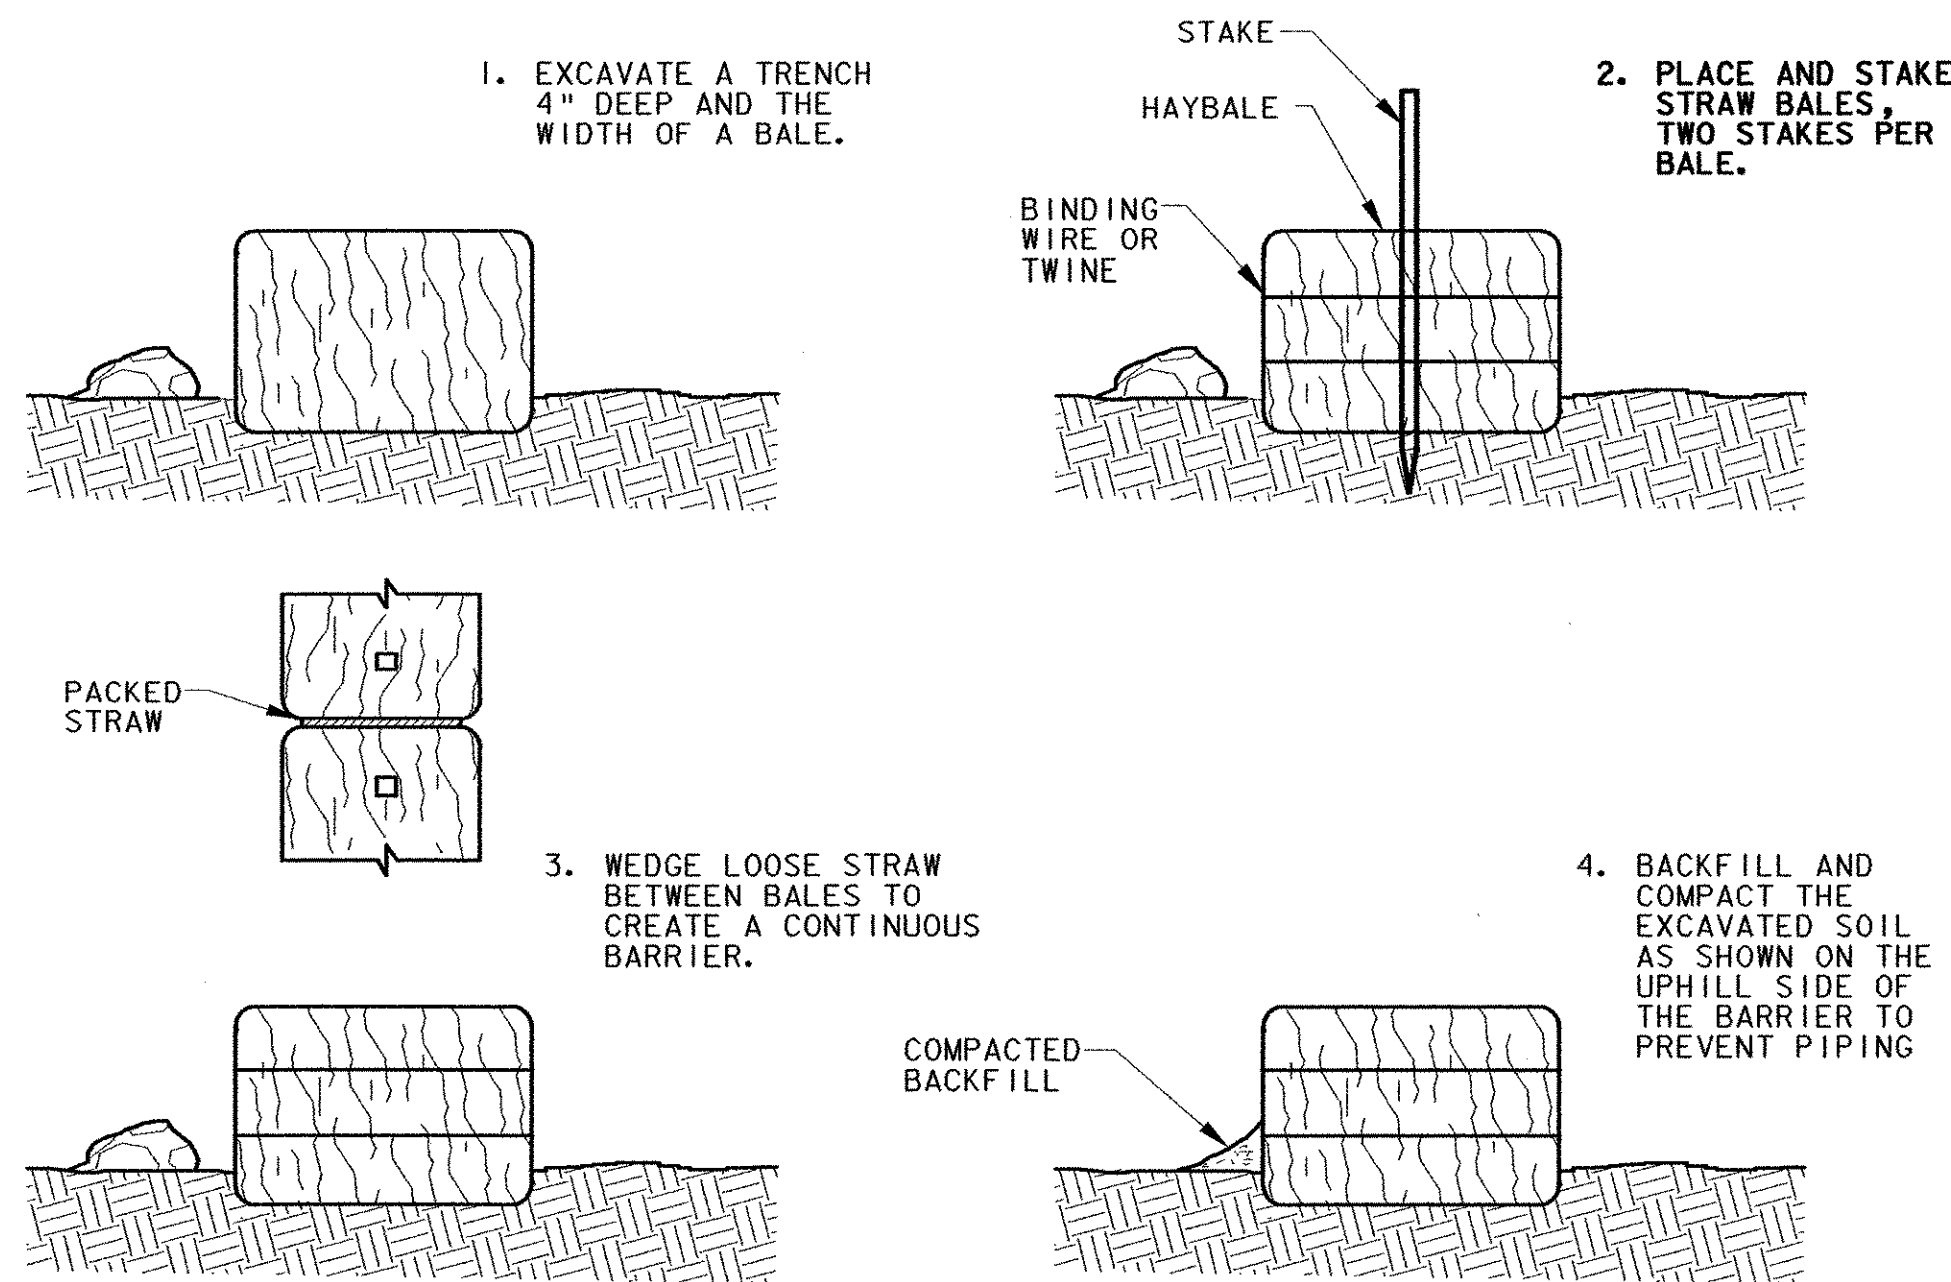


SEDIMENTATION BARRIER - HAYBALE
ITEM 651.26
NOT TO SCALE

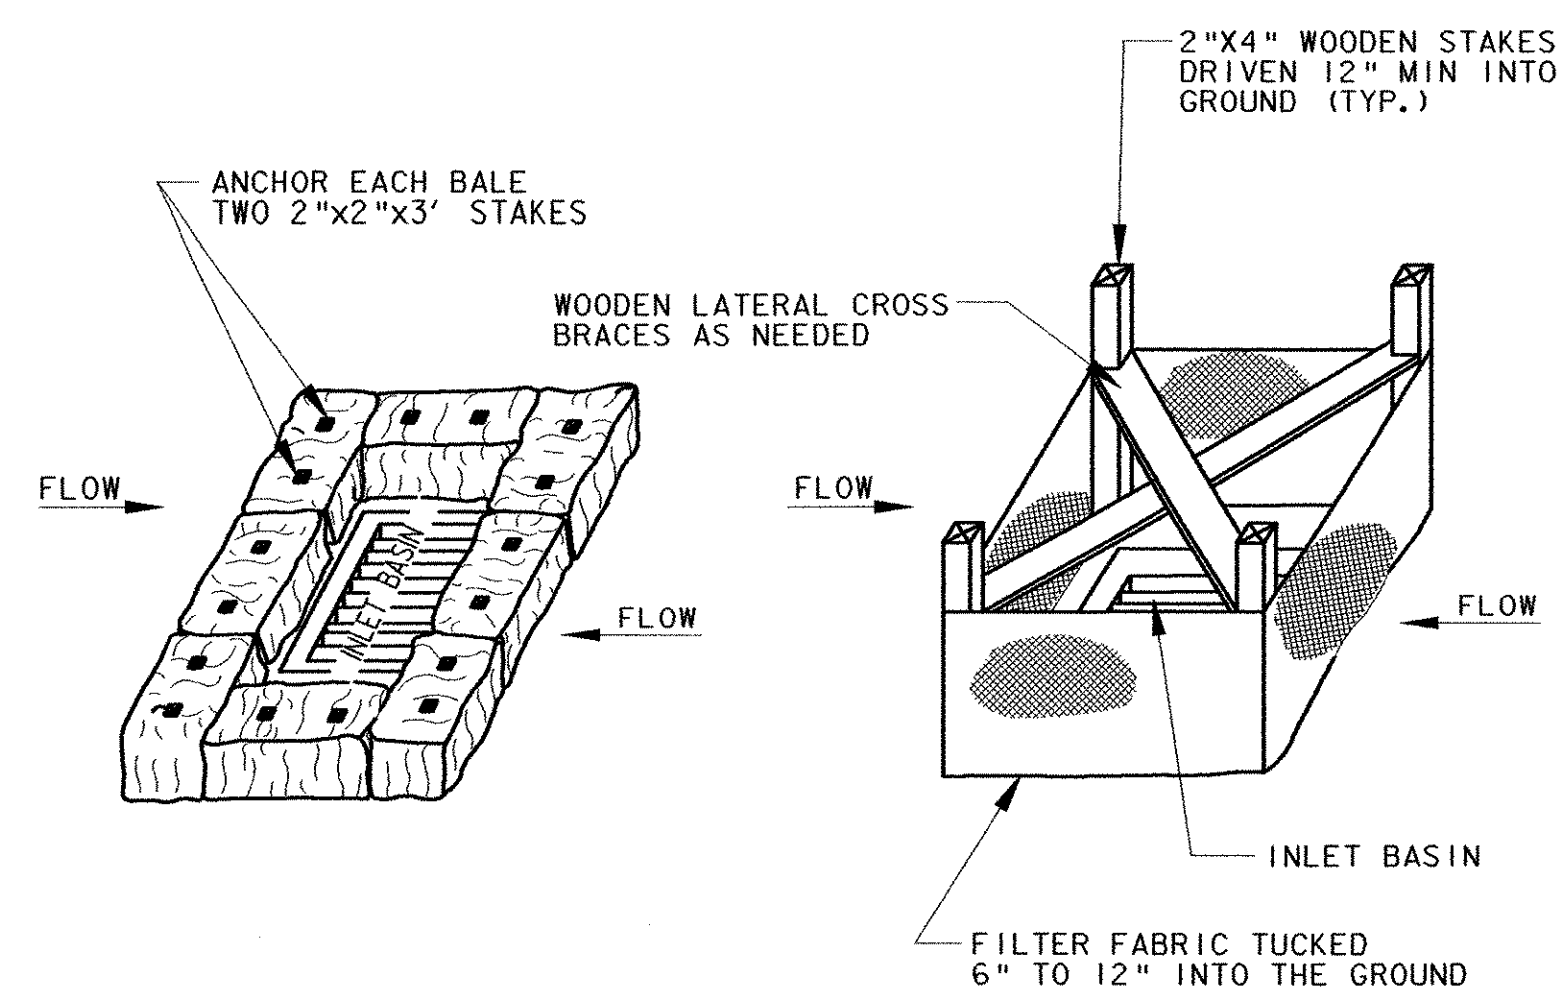

HAY BALE INSTALLATION
ITEM 651.26

SILT FENCE INSTALLATION
ITEM 649.51

SEDIMENTATION CONTROL
INLET PROTECTION
NOT TO SCALE

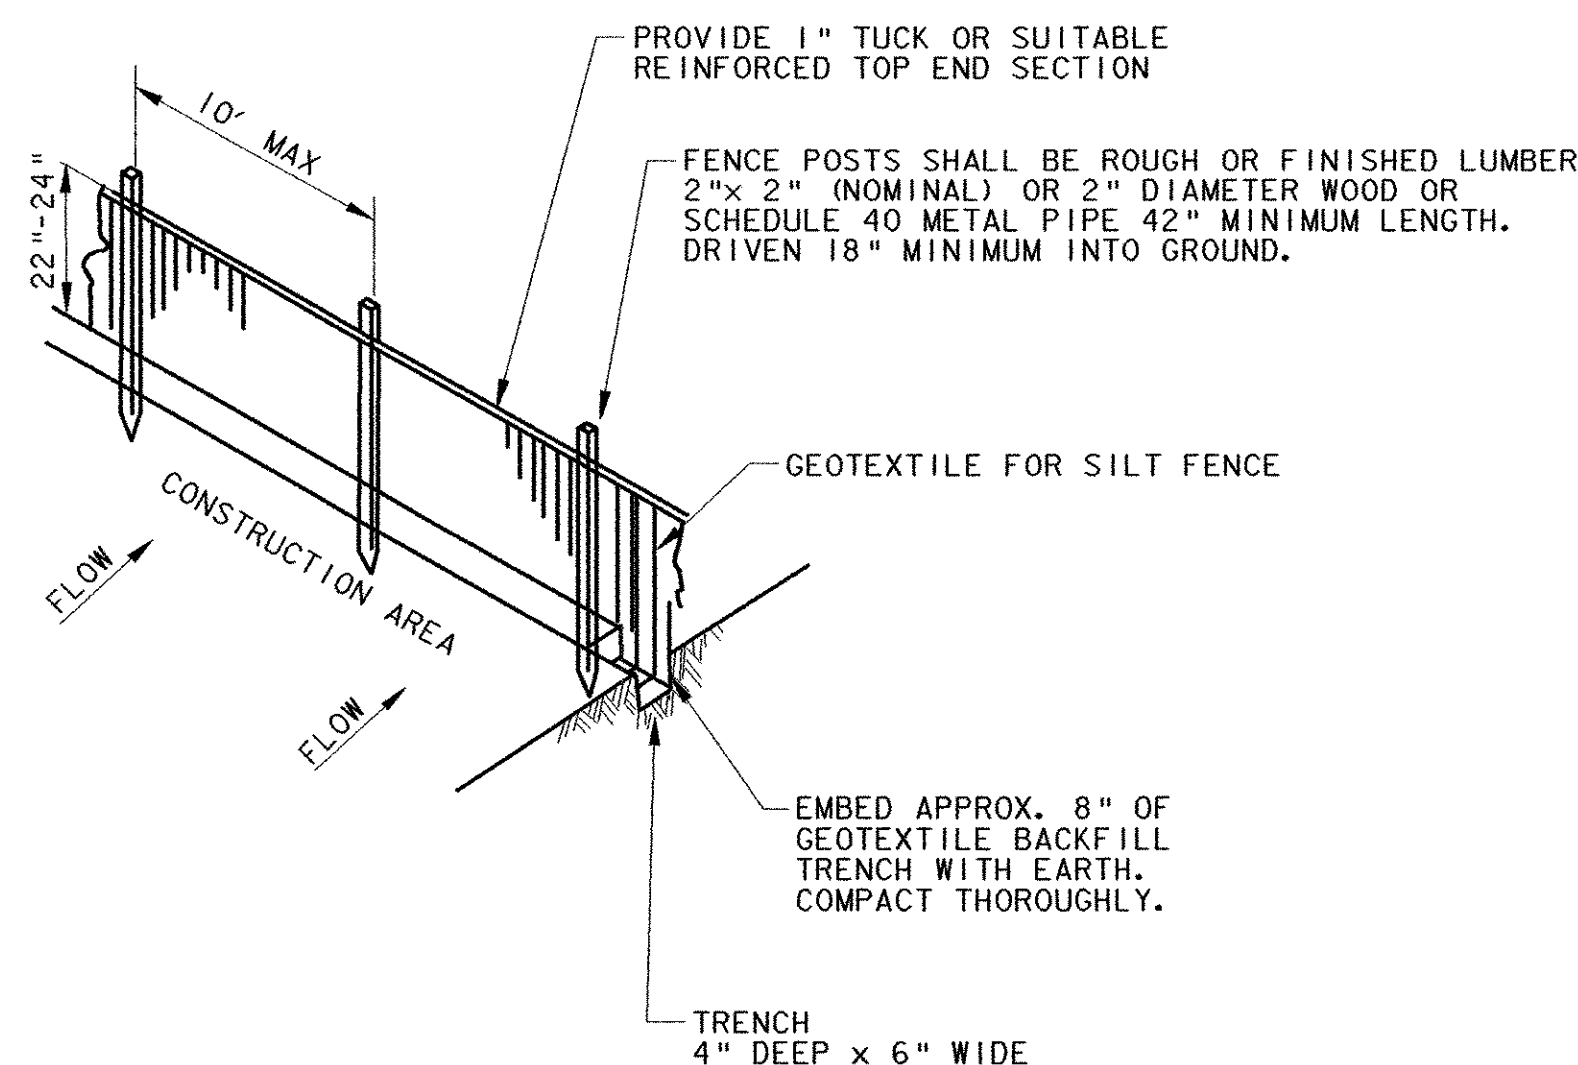


NOTE:

1. GEOTEXTILE FABRIC TO BE FASTENED SECURELY TO FENCE POST BY USE OF WIRE TIES. 3 FASTENERS PER POST.
2. ENDS OF INDIVIDUAL ROLLS OF GEOTEXTILE SHALL BE SECURELY FASTENED TO A COMMON POST OR OVERLAPPED 3' (MIN).
3. TO BE PLACED AT LOCATIONS SHOWN ON PLANS OR AS ORDERED BY THE ENGINEER.

PLAN VIEW SYMBOL

— SF — SF —

SILT FENCE
NOT TO SCALE

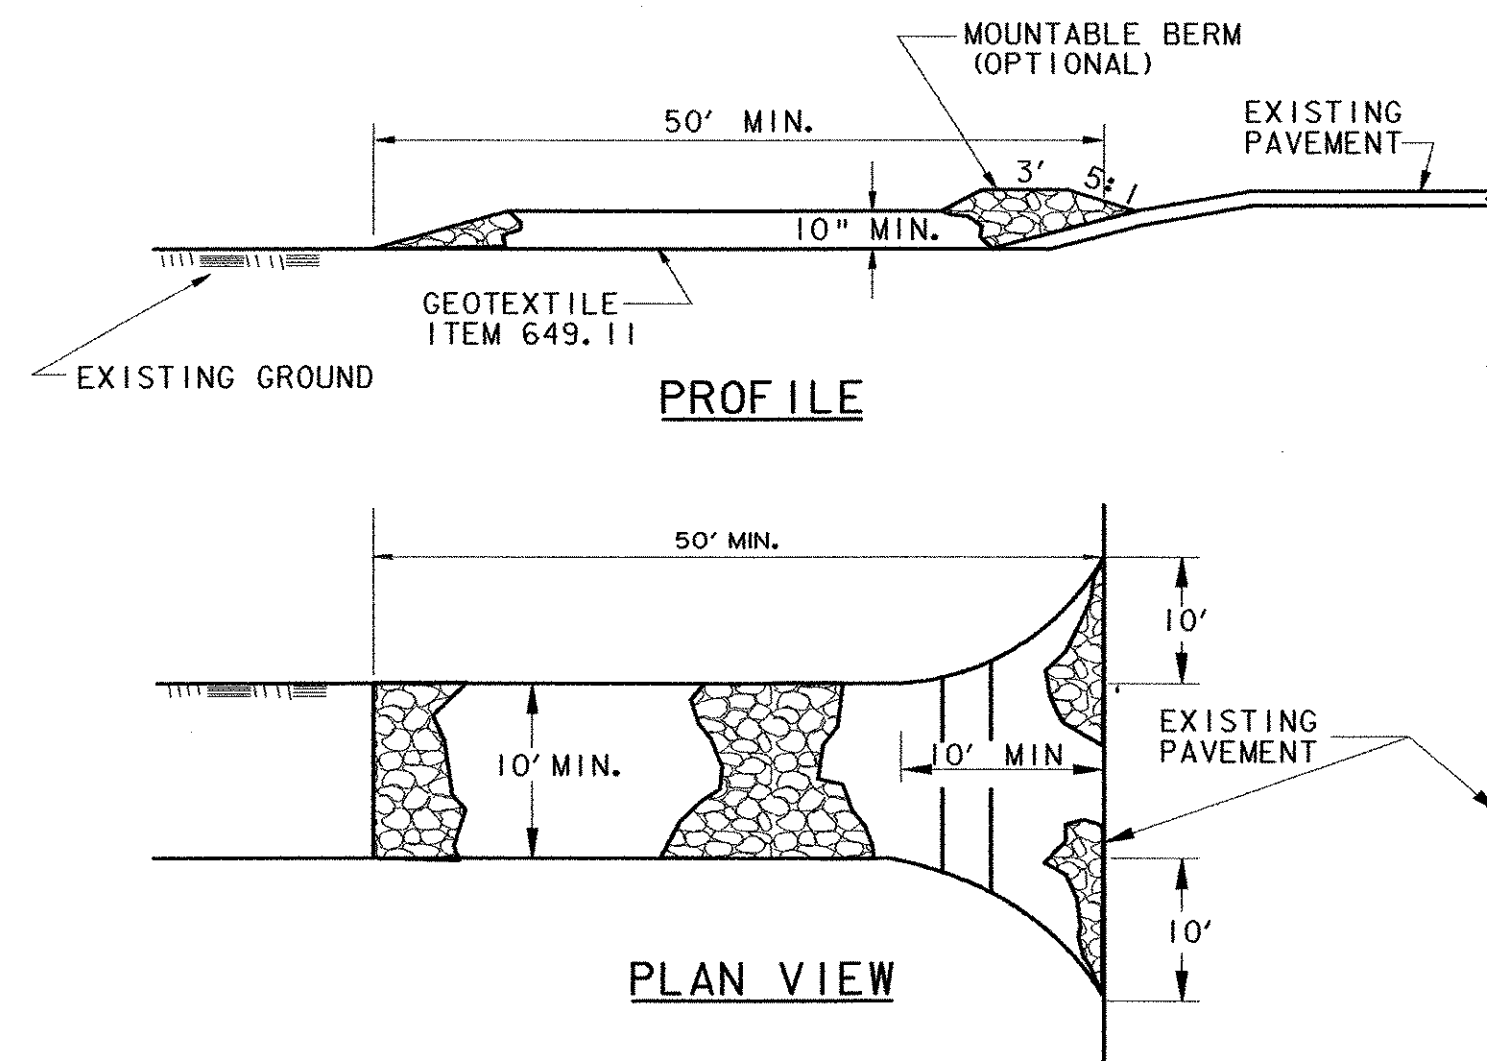

CONSTRUCTION SPECIFICATIONS

1. STONE - SUBBASE OF CRUSHED AGGREGATE, FINE GRADED (704.05) (ITEM 301.26).
2. LENGTH - AS REQUIRED, BUT NOT LESS THAN 50 FEET.
3. THICKNESS - NOT LESS THAN TEN (10) INCHES.
4. WIDTH - TEN (10) FOOT MINIMUM, BUT NOT LESS THAN THE FULL WIDTH AT POINTS WHERE INGRESS OR EGRESS OCCURS.
5. GEOTEXTILE - WILL BE PLACED OVER THE ENTIRE AREA PRIOR TO PLACING OF STONE.
6. SURFACE WATER - ALL SURFACE WATER FLOWING OR DIVERTED TOWARD CONSTRUCTION ENTRANCES SHALL BE PIPED UNDER THE ENTRANCE. IF PIPING IS IMPRACTICAL, A MOUNTABLE BERM WITH 5:1 SLOPES WILL BE PERMITTED.
7. MAINTENANCE - THE ENTRANCE SHALL BE MAINTAINED IN A CONDITION WHICH WILL PREVENT TRACKING OR FLOWING OF SEDIMENT ONTO PUBLIC RIGHTS-OF-WAY. THIS MAY REQUIRE PERIODIC TOP DRESSING WITH ADDITIONAL STONE AS CONDITIONS DEMAND AND REPAIR AND/OR CLEANOUT OF ANY MEASURES USED TO TRAP SEDIMENT. ALL SEDIMENT SPILLED, DROPPED, WASHED OR TRACKED ONTO PUBLIC RIGHTS-OF-WAY MUST BE REMOVED IMMEDIATELY.
8. PERIODIC INSPECTION AND MAINTENANCE SHALL BE PROVIDED AFTER HEAVY USE AND/OR RAIN.
9. THIS ENTRANCE WILL BE CONSTRUCTED AT LOCATIONS SHOWN ON THE PLANS AND/OR WHERE ORDERED BY THE ENGINEER.
10. THE LOCATION AND NUMBERS OF STABILIZED CONSTRUCTION ENTRANCES WILL BE APPROVED BY THE ENGINEER.

STABILIZED CONSTRUCTION ENTRANCE
NOT TO SCALE

EROSION AND SEDIMENT CONTROL NOTES


1. THE CONTRACTOR SHALL CONSTRUCT ALL EROSION AND SEDIMENT CONTROL MEASURES PER THE APPROVED PLAN AND CONSTRUCTION SEQUENCE AND SHALL HAVE THEM INSPECTED BY THE ENGINEER PRIOR TO BEGINNING ANY OTHER LAND DISTURBANCES. MINOR SEDIMENT CONTROL DEVICE LOCATION ADJUSTMENTS MAY BE MADE IN THE FIELD WITH THE APPROVAL OF THE ENGINEER. THE CONTRACTOR SHALL ENSURE THAT ALL RUNOFF FROM DISTURBED AREAS IS DIRECTED TO THE SEDIMENT CONTROL DEVICES, AND SHALL NOT REMOVE ANY EROSION OR SEDIMENT CONTROL MEASURE WITHOUT PRIOR PERMISSION FROM THE ENGINEER. THE CONTRACTOR MUST OBTAIN PRIOR APPROVAL FOR CHANGES TO THE SEDIMENT CONTROL PLAN AND/OR SEQUENCE OF CONSTRUCTION.
2. THE CONTRACTOR SHALL MAINTAIN ALL EROSION AND SEDIMENT CONTROL MEASURES UNTIL THEY ARE REMOVED.
3. THE CONTRACTOR SHALL APPLY SEED AND MULCH, OR OTHER APPROVED STABILIZATION MEASURES TO ALL DISTURBED AREAS AND STOCKPILES WITHIN FOURTEEN (14) CALENDAR DAYS AFTER STRIPPING AND GRADING ACTIVITIES HAVE CEASED IN THE AREA. MAINTENANCE SHALL BE PERFORMED AS NECESSARY TO ENSURE CONTINUED STABILIZATION. PERMANENT SOIL STABILIZATION SHALL BE PROVIDED WITHIN SEVEN (7) DAYS OF ESTABLISHMENT OF FINAL GRADE.
4. THIS EROSION CONTROL PLAN SHALL BE IMPLEMENTED ON ALL DISTURBED AREAS WITHIN THE CONSTRUCTION SITE. ALL MEASURES INVOLVING EROSION CONTROL PRACTICES SHALL BE INSTALLED IN CONFORMANCE WITH "THE VERMONT HANDBOOK FOR SOIL EROSION AND SEDIMENT CONTROL ON CONSTRUCTION SITES" AS PUBLISHED BY THE VT. GEOLOGICAL SURVEY.
5. DURING THE PERIOD OF CONSTRUCTION ACTIVITY, ALL EROSION CONTROL MEASURES SHALL BE MAINTAINED BY THE CONTRACTOR. AT THE COMPLETION OF CONSTRUCTION, THE CONTRACTOR SHALL COORDINATE THE TRANSFER OF MAINTENANCE RESPONSIBILITIES, IF REQUIRED, TO THE VT AGENCY OF TRANSPORTATION.
6. ALL TEMPORARY EROSION AND SEDIMENT CONTROL PRACTICES SHALL BE REMOVED AND DISPOSED OF WITHIN THIRTY (30) DAYS AFTER FINAL SITE STABILIZATION IS ACHIEVED OR AFTER THE TEMPORARY PRACTICES ARE NO LONGER NEEDED. TRAPPED SEDIMENT SHALL BE STABILIZED OR REMOVED TO PREVENT FURTHER EROSION.
7. EROSION CONTROL DEVICES REMOVED DURING GRADING OPERATIONS SHALL BE PUT BACK IN PLACE AT THE END OF THE DAY OR DURING INCLEMENT WEATHER AS DIRECTED BY THE ENGINEER.
8. STREAMS, INCLUDING BED AND BANKS, SHALL BE RESTABILIZED IMMEDIATELY AFTER CHANNEL WORK IS COMPLETED, INTERRUPTED, OR STOPPED.
9. NO SOIL, ROCK, DEBRIS, OR ANY OTHER MATERIAL SHALL BE DUMPED OR PLACED INTO A WATER COURSE OR INTO SUCH PROXIMITY THAT IT MAY READILY SLOUGH, SLIP, OR ERODE INTO A WATER COURSE UNLESS SUCH DUMPING OR PLACING IS AUTHORIZED BY THE ENGINEER AND, WHEN APPLICABLE, THE U.S. ARMY CORPS OF ENGINEERS, FOR SUCH PURPOSES AS, BUT NOT LIMITED TO, CONSTRUCTION OF BRIDGES, CULVERTS, AND EROSION CONTROL STRUCTURES.
10. PERMANENT SEEDING SHALL BE DONE BETWEEN APRIL 30 AND SEPTEMBER 15. IF SEEDING IS DONE AT OTHER TIMES, IT SHALL BE CLASSIFIED AS "TEMPORARY SEEDING." PERMANENT SEED SHALL CONFORM TO THE SEEDING MIXTURE STATED ON SHEET 8. TEMPORARY AND PERMANENT SEEDING SHALL CONSIST OF FERTILIZING, LIMING, MULCHING AND SEEDING PLACED AT RATES IN ACCORDANCE WITH THE SPECIFICATIONS. PERMANENT SEEDING, FERTILIZING, LIMING AND MULCHING SHALL BE PAID FOR UNDER 651.15, 651.18, 651.20 AND 651.25 RESPECTIVELY. TEMPORARY SEED, MULCH AND FERTILIZER FOR EROSION AND SEDIMENT CONTROL SHALL BE PLACED IN ACCORDANCE WITH THE SPECIFICATIONS. NO PAYMENT WILL BE MADE FOR TEMPORARY SEEDING OR MULCHING.
11. SURFACE DRAINAGE FLOWS OVER UNSTABILIZED CUT AND FILL SLOPES SHALL BE CONTROLLED BY EITHER PREVENTING DRAINAGE FLOWS TRAVERSING THE SLOPES OR BY INSTALLING PROTECTIVE DEVICES TO LOWER THE WATER DOWNSLOPE WITHOUT CAUSING EROSION. DIKES SHALL BE INSTALLED AND MAINTAINED AT THE TOP OF CUT OR FILL SLOPES UNTIL THE SLOPE AND DRAINAGE AREA TO IT ARE FULLY STABILIZED, AT WHICH TIME THEY MUST BE REMOVED AND FINAL GRADING DONE TO PROMOTE SHEET FLOW DRAINAGE. PROTECTIVE METHODS MUST BE PROVIDED AT POINTS OF CONCENTRATED FLOW WHERE EROSION IS LIKELY TO OCCUR.
12. ALL POINTS OF CONSTRUCTION INGRESS AND EGRESS IN UNPAVED AREAS SHALL BE STABILIZED AND PROTECTED TO PREVENT TRACKING OF MUD ONTO PUBLIC OR PRIVATE ROADWAYS. (INCIDENTAL TO ITEM 203.15)
13. IF ROADWAYS ACCUMULATE DEBRIS, THE CONTRACTOR SHALL USE A POWER BROOM TO REMOVE THE SEDIMENT TO THE SATISFACTION OF THE ENGINEER (INCIDENTAL TO ITEM 203.15).
14. TOPSOIL (TO BE STOCKPILED ON SITE) WILL BE PLACED ON WELL DRAINED LAND AWAY FROM STREAMS IN ACCORDANCE WITH APPROVED EROSION AND SEDIMENT CONTROL MEASURES. IT SHALL BE PLACED IN NEAT PILES. THE CONTRACTOR WILL PROVIDE AN ADEQUATE QUANTITY OF SILT FENCE TO CONTROL THE PERIMETER OF THE STOCKPILE. THE CONTRACTOR, WITH THE APPROVAL OF THE ENGINEER, MAY CONSTRUCT AN EARTH DIKE IN LIEU OF SILT FENCE.

SITE DATA

PROJECT DESCRIPTION:
AIRPORT DEVELOPMENT TO INCLUDE PAVING, CLEARING AND GRUBBING, EARTHWORK, STORM DRAINAGE, AND UTILITIES.

TOTAL SITE AREA:
AREA WITHIN LIMITS OF WORK APPROX. 6 ACRES.

EXISTING SOIL TYPES:
-BROWN SILTY LOAM, UDORTHENTS
-INFORMATION OBTAINED FROM HISTORICAL BORINGS & SOIL CONSERVATION SERVICE DATA SHEETS.
-APPROXIMATELY 3" OF TOPSOIL

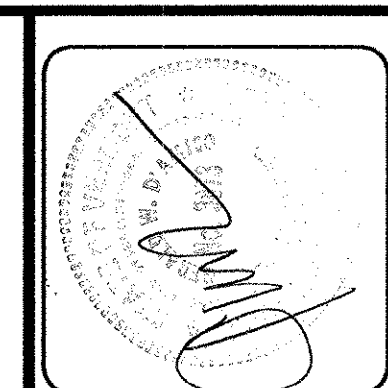

REV.	DATE	DESCRIPTION

Job No. F20002046.00
File No. F202046000E18

RUTLAND STATE AIRPORT
CLARENDON, VERMONT

TAXIWAY IMPROVEMENTS
SEDIMENTATION / EROSION
CONTROL DETAILS

URS
1 NORTHWAY LN.
LATHAM, NEW YORK

Designed by G.W.D.
Drawn by M.C.M.
Checked by M.C.C.
Approved by G.W.D.

Scale:
Date: FEB., 2003
Sheet 18 OF 40
Sheet No
18



REV.	DATE	DESCRIPTION

Job No. F200002046.00
File No. F200002046.00

RUTLAND STATE AIRPORT
CLARENDON, VERMONT

TAXIWAY IMPROVEMENTS

MARKING PLAN-TAXIWAY "F" WEST



URS

1 NORTHWAY LN.
LATHAM, NEW YORK

Designed by: C.M.D.
Drawn by: M.C.M.
Checked by: M.A.C.
Approved by: G.W.D.

Scale: 1"=50'
Date: FEB., 2003
Sheet 19 OF 40
Sheet No.

19

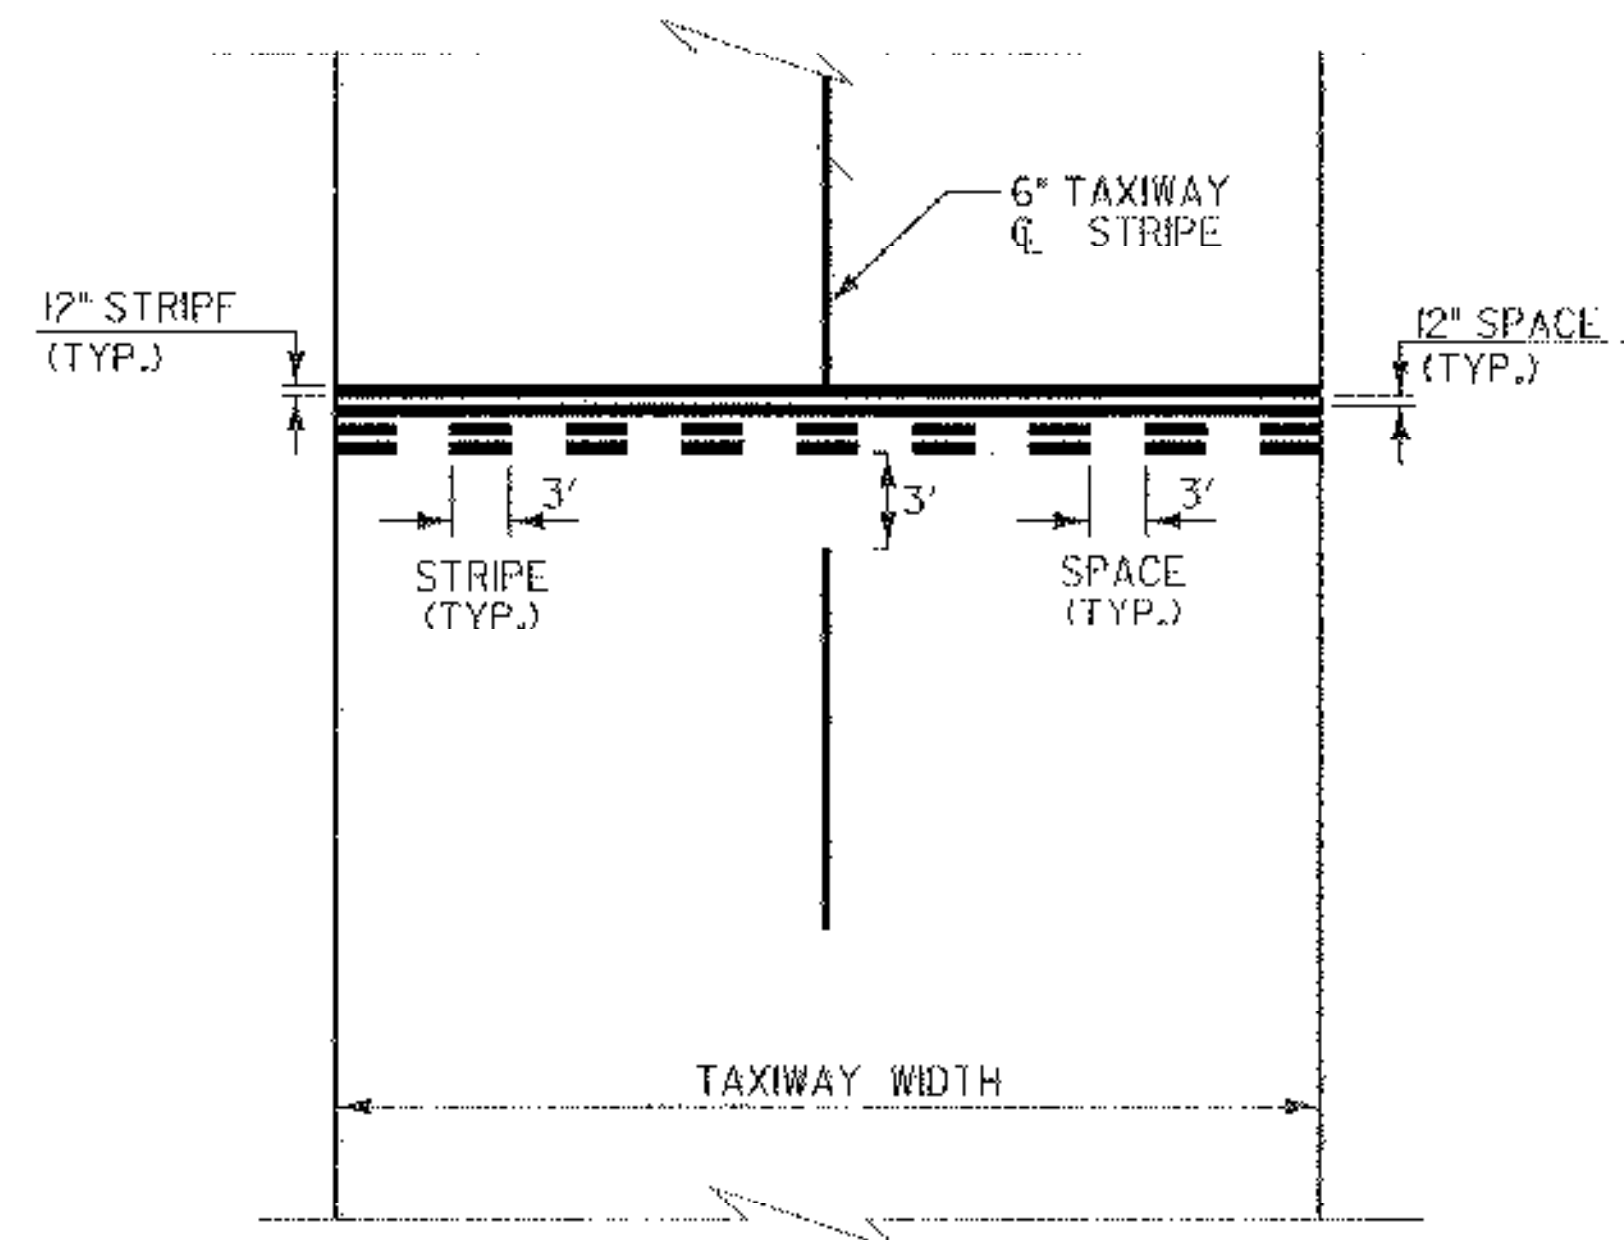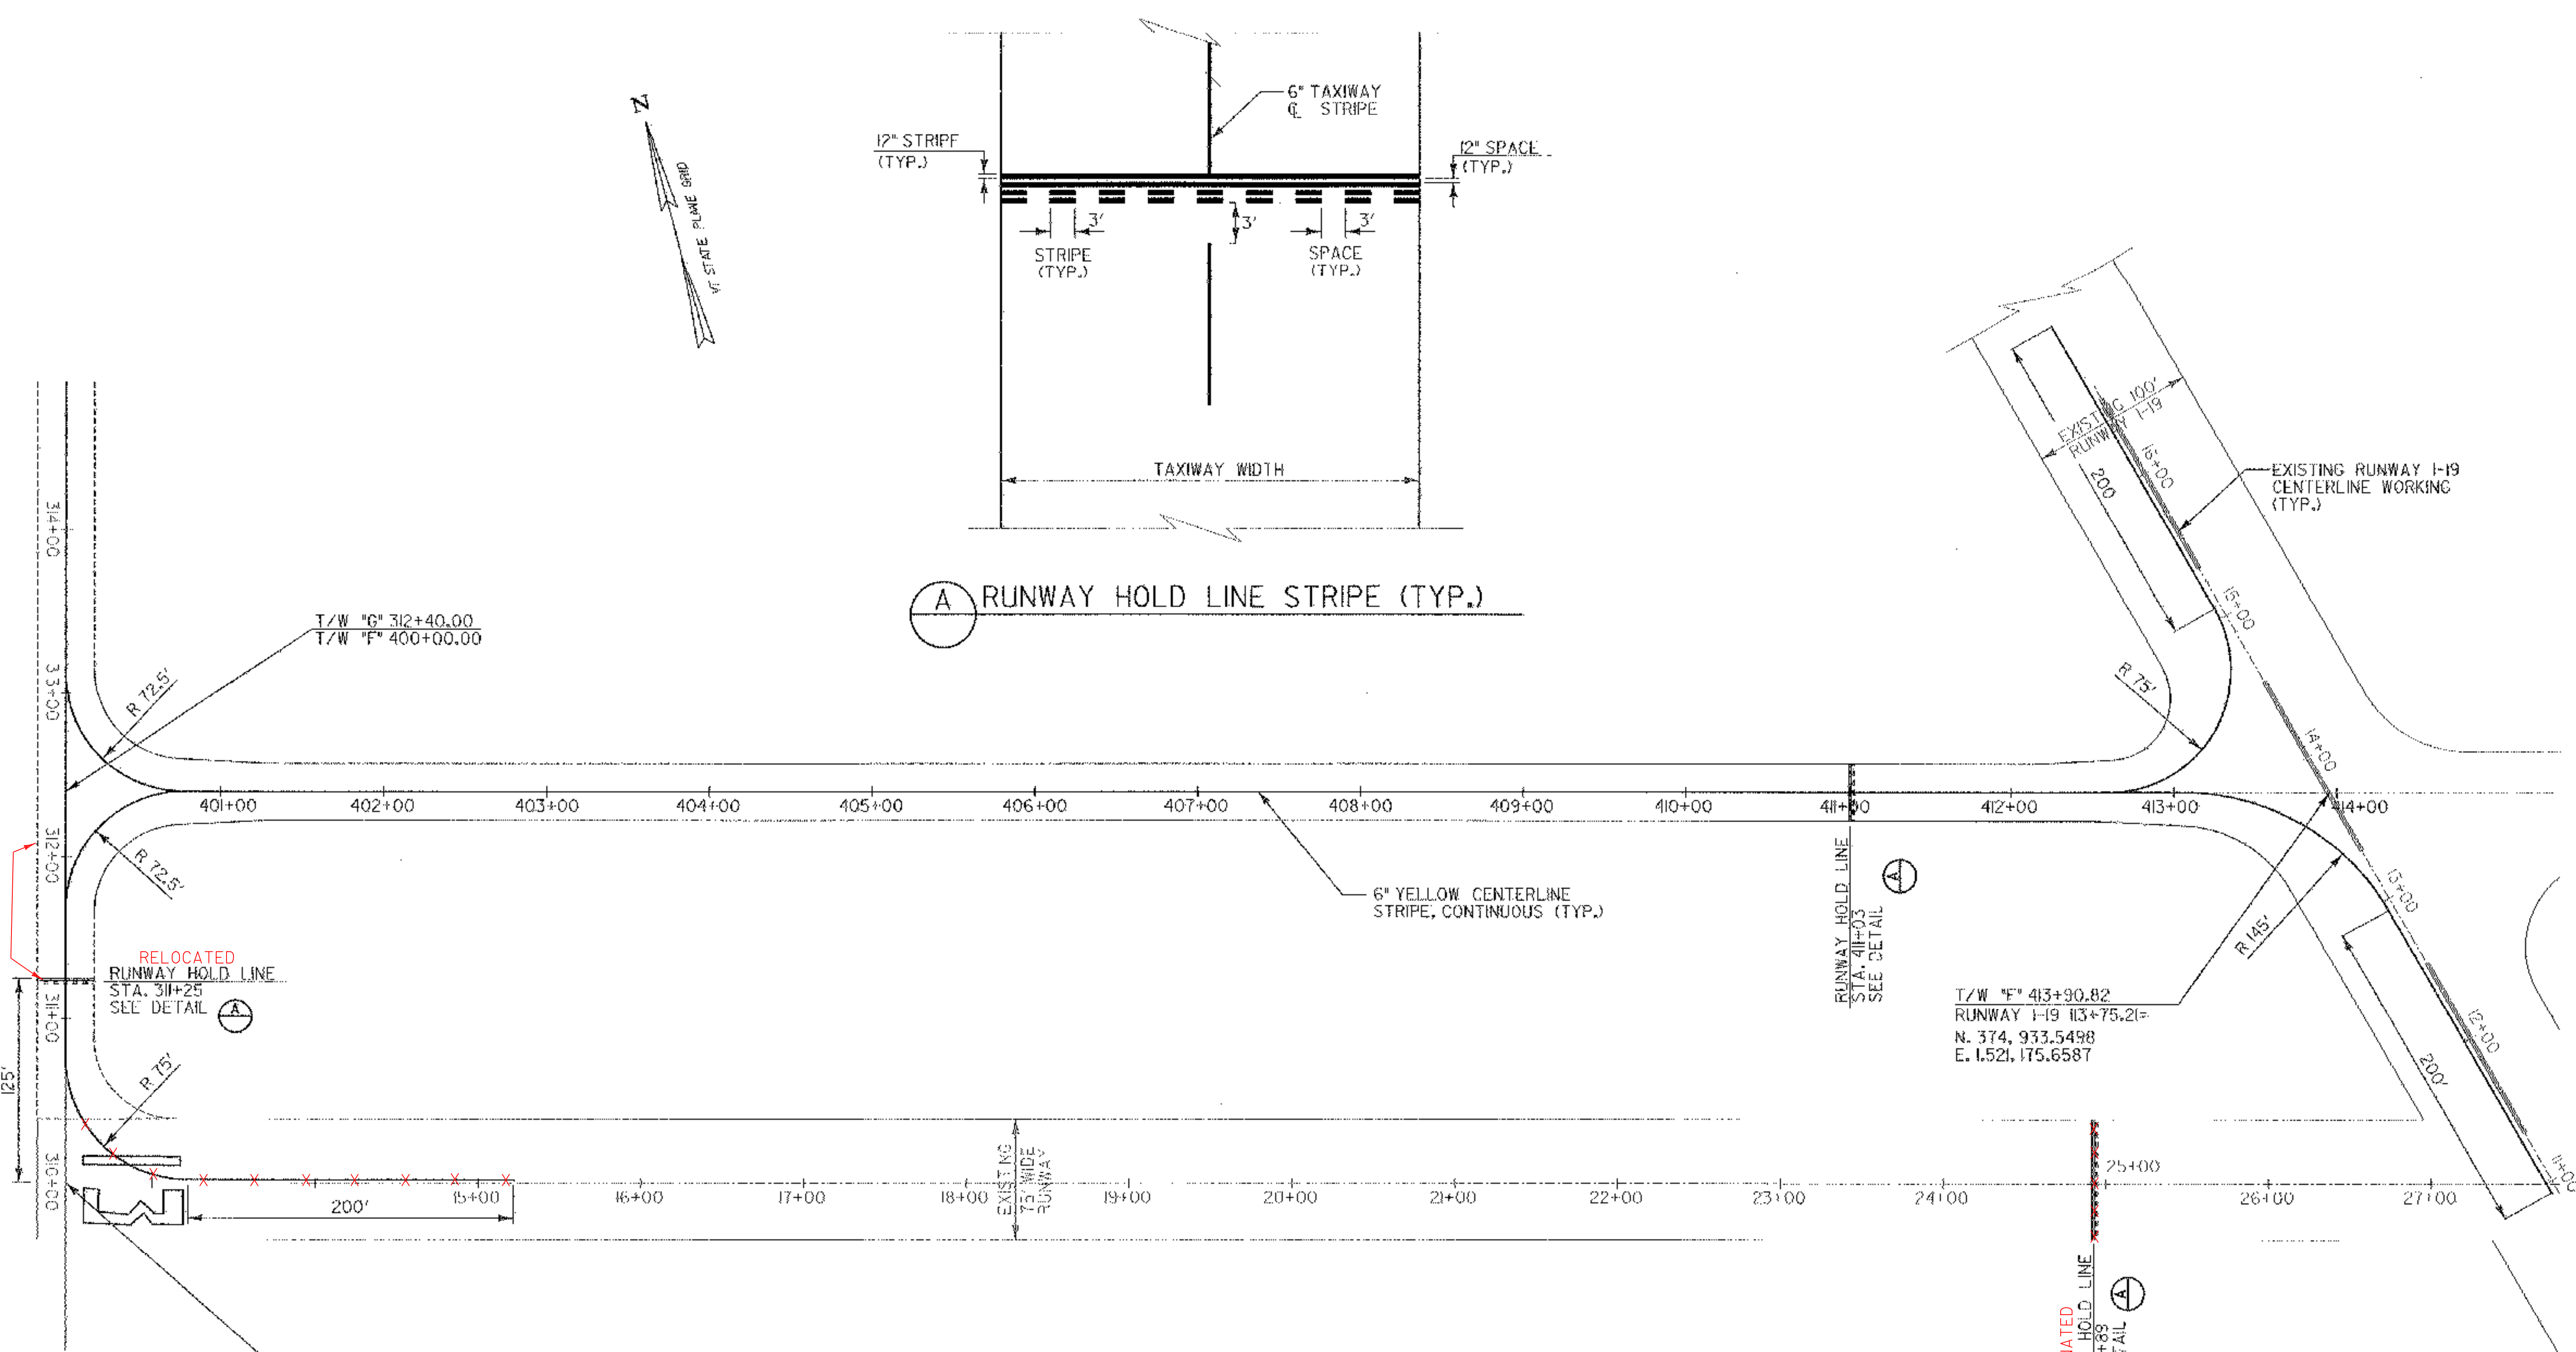

T/W "G" 312+40.00
T/W "F" 400+00.00

RELOCATED
RUNWAY HOLD LINE
STA. 311+25
SEE DETAIL

6" YELLOW CENTERLINE
STRIPE, CONTINUOUS (TYP.)

RUNWAY HOLD LINE
STA. 411+03
SEE DETAIL

T/W "F" 413+90.82
RUNWAY 1-19 113+75.21=
N. 374, 933.5498
E. 1,521, 175.6587

ELIMINATED
RUNWAY HOLD LINE
STA. 24+83
SEE DETAIL


RUNWAY 13-31 12+46.80=
T/W 310+00.00
N. 375, 398.83
E. 1,519, 843.18

NOTES

1. REFER TO VT STANDARD DRAWING, AP-11, TAXIWAY MARKING DETAILS FOR ADDITIONAL INFORMATION
2. TAXIWAY MARKINGS TO CONFORM TO A.C. 150/5340-1H STANDARDS FOR AIRPORT MARKING
3. ALL TAXIWAY MARKINGS TO BE YELLOW REFLECTIVE USING GLASS BEADS.
4. CONTRACTOR TO MARK ALL RUNWAY HOLD LINES ON AIRPORT TO NEW DETAIL A/18 AS DIRECTED BY THE ENGINEER, INCLUDING HOLD LINES ON RUNWAYS 1-19 AND 13-31, TAXIWAY "C", "D", AND "E". EXISTING MARKINGS NOT CONFORMING TO DETAIL ARE TO BE REMOVED, ITEM. 646.82

SCALE 1"=50'
50 0 50

PROJECT "A"
A.I.P. 3-50-0015-17

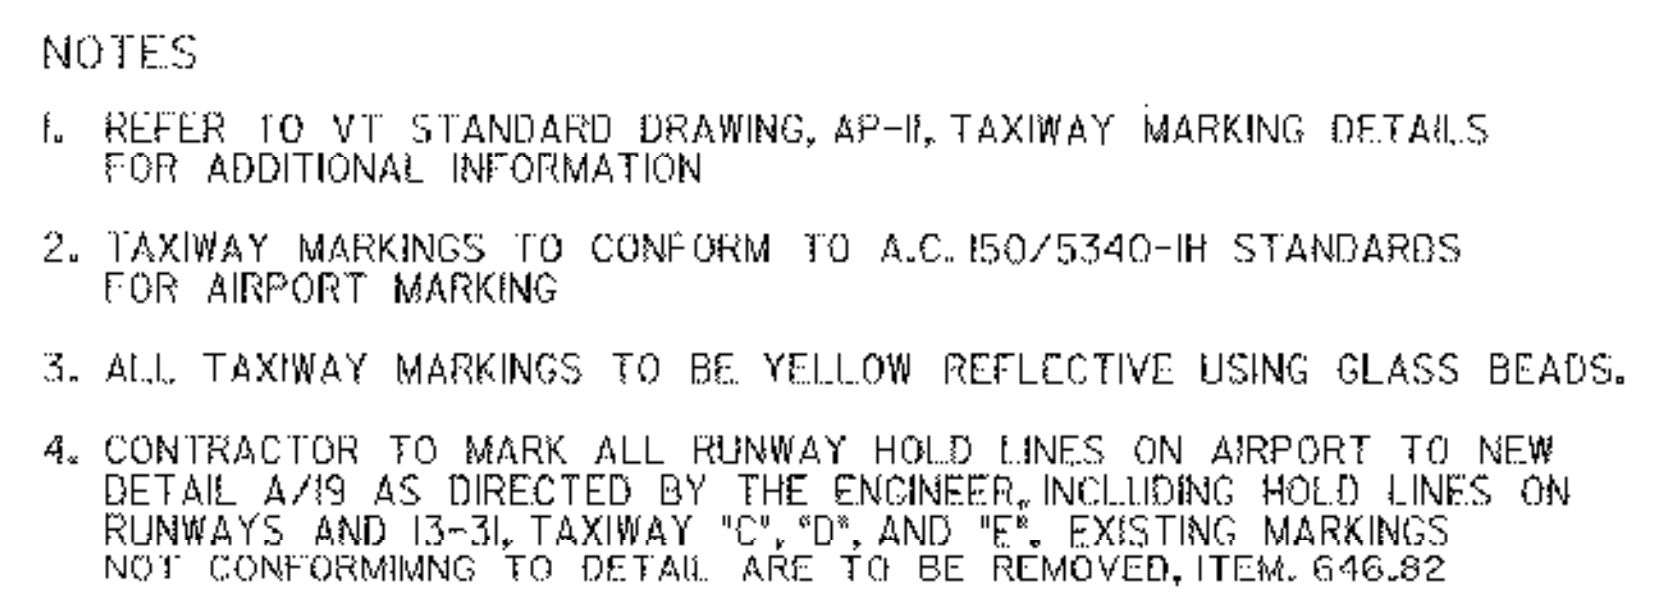

Scale: F=50'

Date: FEB., 2003

Sheet 20 OF 40

Sheet No
20



REV.	DATE	DESCRIPTION

Job No. F200002046.00
File No. F200046000E21


RUTLAND STATE AIRPORT
CLARENDON, VERMONT

TAXIWAY IMPROVEMENTS
TAXIWAY LIGHTING LAYOUT

URS
1 NORTHWAY LN.
LATHAM, NEW YORK

Designed by: G.W.D.
Drawn by: M.C.M.
Checked by: L.M.J.
Approved by: G.W.D.

Scale: 1"=50'
Date: FEB., 2003
Sheet 21 OF 40
Sheet No. **21**

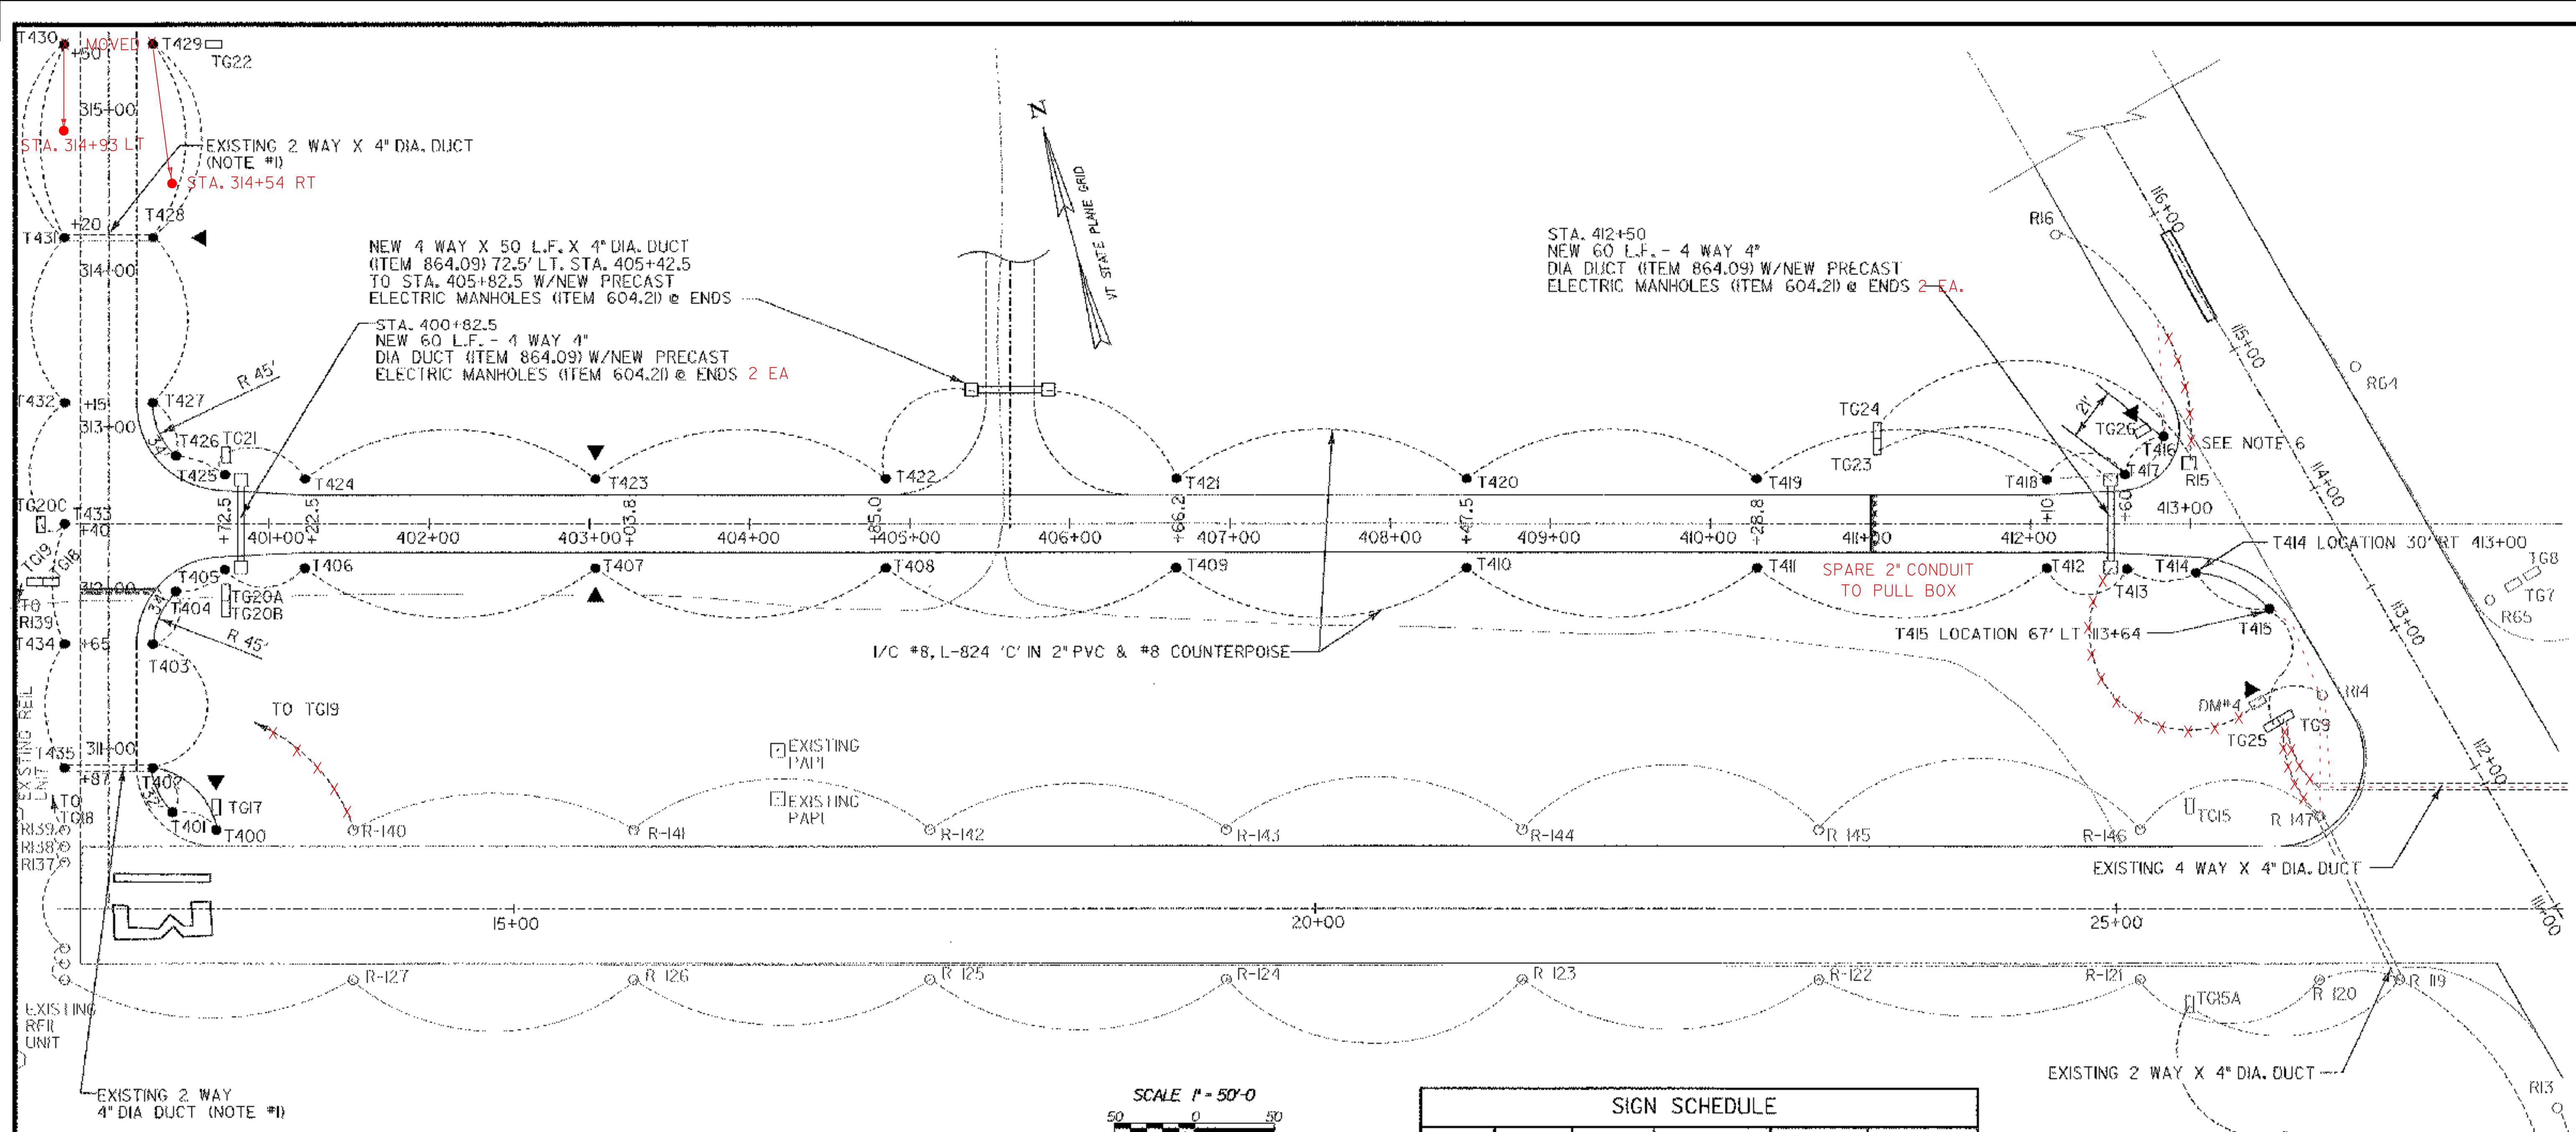

- NOTES
- REFER TO PLANS FOR APRON DEVELOPMENT, PHASE I BY McFARLAND - JOHNSON, INC. DATED JANUARY, 2001.
 - TAXIWAY LIGHTING (MITLS) TO BE 6.6 AMP SERIES CIRCUIT, 3 STEP MEDIUM INTENSITY. W/ INCANDESCENT LAMPS (BLUE FILTERS).
 - NEW CABLES TO BE PLACED IN THE SAME CONDUIT AND TRENCH WHEN POSSIBLE. NEW MITLS TO BE PLACED 10' OFF EDGE OF PAVEMENT. NEW CABLES AND CABLE TRENCH TO BE PLACED 10' OFF EDGE OF PAVEMENT.
 - RUNWAY 1-I9 LIGHTING MUST BE OPERATIONAL, WHENEVER INSTRUMENT FLYING RULES OR LOW VISIBILITY (NIGHTTIME) CONDITIONS ARE IN EFFECT. CONTRACTOR TO PLAN HIS WORK TO ENSURE THAT THESE LIGHTS ARE OPERATIONAL WHEN REQUIRED.
 - ALL TAXIWAY GUIDANCE SIGNS (TG-) TO BE PLACED 20' OFF EDGE OF PAVEMENT.

- REPLACE EXISTING BASE MOUNTED MRL, R15, WITH NEW IN PAVEMENT MRL, L-850-C (ITEM 864.10). USE MRLS SIMILAR TO EXISTING (HUGHEY & PHILLIPS) LOW PROFILE, OR APPROVED EQUAL.
- NEW PRECAST ELECTRICAL MANHOLES TO BE CAPABLE OF SUPPORTING A 90,000# AIRCRAFT. USE HEAVY DUTY ELECTRICAL MANHOLE COVER, LB 328, AS MANUFACTURED BY LABARON FOUNDRY OR EQUAL.

EXISTING WIRING CIRCUITS	PROPOSED WIRING CIRCUITS
RUNWAY 1-I9	RUNWAY 1-I9
... R12-R13-TG15A-TG15-R14-DM*4-R15 ...	... R14-DM4-TG23-TG24-R15-R16 ...
RUNWAY 13-31	RUNWAY 13-31
... R18*-TG4*-TG3-R19-R120 ...	... R141-R140-TG19-TG18-R139 ...
... R140-R139-R138 ...	
... R146-R147-TG9-TG7*-R148* ...	TAXIWAY "F"
* = EAST OF RUNWAY 1-I9	HOME RUN → TG25-T415-T414-T413-T412 ...
	... T418-T417-T416-TG26 → HOME RUN
	... T403-T402-T401-T400-T435-T434 ...
	... T431-T430-T429-T428-TG22-T427 ...

LEGEND	
○ R-146	EXISTING RUNWAY LIGHTING (MRLS) BASE MOUNTED, ELEVATED.
□ R-15	NEW RUNWAY LIGHT (MRL) FLUSH MOUNTED IN PAVEMENT. SPLIT LENS AMBER/WHITE
○ T-301	EXISTING TAXIWAY LIGHTING (MITLS)
● T-409	NEW TAXIWAY LIGHTS (MITLS)
○ T-316R	RELOCATED TAXIWAY LIGHTS BASE MOUNTED, ELEVATED.
□ TG-21	NEW TAXIWAY GUIDANCE SIGN
□ TG-8	EXISTING TAXIWAY GUIDANCE SIGN (TYPICAL)
▲	NEW 5/8" dia. X 8' COPPER CLAD GROUND ROD

SIGN SCHEDULE					
SIGN	LEGEND	COLOR	TYPE	LOCATION	REMARKS
DM*4		(W/R) (BLANK)	MANDATORY	85' LT. 113+00	TO REMAIN
TG9		(W/R) (BLANK)	MANDATORY	70' LT. 112+86	TO REMAIN
TG15		(BLANK) (W/R)	MANDATORY	57.5' LT. 25+46	TO REMAIN
TG15A		(BLANK) (W/R)	MANDATORY	57.5' RT. 25+46	TO REMAIN
TG17		(B/Y) (BLANK)	DIRECTION	57.5 LT. 13+14.3	NEW
TG18		(W/R) (Y/B)	MANDATORY LOCATION	37.5' RT. 312+00	NEW
TG19		(Y/B) (B/Y)	LOCATION DIRECTION	42.5' LT. 312+00	NEW
TG20A		(B/Y) (B/Y)	DIRECTION DIRECTION	40' RT. 400+72.5	NEW
TG20B		(Y/B) (Y/B)	LOCATION LOCATION	45' RT. 400+72.5	NEW
TG20C		(BLANK) (Y/B)	DIRECTION	20' RT. 312+40	NEW
TG21		(B/Y) (BLANK)	DIRECTION	40' LT. 410+72.5	NEW
TG22		(Y/B) (Y/B)	LOCATION LOCATION	37.5' RT. 315+50	NEW

SIGN SCHEDULE					
SIGN	LEGEND	COLOR	TYPE	LOCATION	REMARKS
TG23		(BLANK) (W/R)	MANDATORY	37.5' RT. 411+00	NEW
TG24		(Y/B) (Y/B)	LOCATION LOCATION	42.5' LT. 411+00	NEW
TG25		(BLANK) (B/Y)	DIRECTION	75' LT. 112+86	NEW
TG26		(B/Y) (BLANK)	DIRECTION	70' LT. 114+88	NEW

NOTES:


- ALL SIGNS TO BE L-858, SIZE 108" PANEL WITH 12" LEGEND, STYLE 2, CLASS 2.
- COLORS
W/R = WHITE LEGEND ON RED BACKGROUND
Y/B = YELLOW LEGEND ON BLACK BACKGROUND
B/Y = BLACK LEGEND ON YELLOW BACKGROUND

PROJECT "A"
A.I.P. 3-50-0015-17

NOTES

1. TAXIWAY LIGHTING (MITLS) TO BE 6.6 A SERIES CIRCUIT, 3 STEP/ MEDIUM INTENSITY, W/ INCANDESCENT LAMPS (BLUE FILTERS).
2. NEW CABLES TO BE PLACED IN THE SAME TRENCH WHEN POSSIBLE. NEW MITLS TO BE PLACED 10' OFF EDGE OF PAVEMENT. NEW CABLES AND CABLE TRENCH TO BE PLACED 10' OFF EDGE OF PAVEMENT.
3. RUNWAY I-19 LIGHTING MUST BE OPERATIONAL, WHENEVER INSTRUMENT FLYING RULES OR LOW VISIBILITY (NIGHTTIME) CONDITIONS ARE IN EFFECT. CONTRACTOR TO PLAN HIS WORK TO ENSURE THAT THESE LIGHTS ARE OPERATIONAL WHEN REQUIRED.
4. ALL TAXIWAY GUIDANCE SIGNS (TG-) TO BE PLACED 20' OFF EDGE OF PAVEMENT.
5. EXISTING WIND CONE TO REMAIN, SEGMENTED CIRCLE TO BE REMOVED AND DISPOSED AS DIRECTED BY THE ENGINEER. PAYMENT TO BE INCIDENTAL TO INSTALLATION OF SEGMENTED CIRCLE, ITEM 680.70
6. REMOVAL OF EXISTING TAXIWAY & RUNWAY LIGHTS TO BE INCIDENTAL TO ITEM 864.11
7. RELOCATION OF EXISTING ELECTRICAL MANHOLES IS NOT A SEPARATE PAY ITEM, BUT IS INCIDENTAL TO ITEM, 864.09.
8. NEW PRECAST ELECTRICAL MANHOLES TO BE CAPABLE OF SUPPORTING A 90,000# AIRCRAFT, USE HEAVYDUTY ELECTRICAL MANHOLE COVER, LB 328, AS MANUFACTURED BY LABARON FOUNDRY OR EQUAL.
9. THE CONTRACTOR WILL BE RESPONSIBLE FOR ACQUIRING AN ELECTRICAL PERMIT FOR NEW VAULT WIRING. VERMONT DEPARTMENT OF LABOR AND INDUSTRY REQUIRES THAT WORKING ELECTRICIANS HOLD APPROPRIATE LICENSES.
10. REMOVE EXISTING MRL 65. REPLACE WITH NEW FLUSH MOUNTED IN-PAVEMENT MRL (ITEM 864.10)
11. REMOVE EXISTING IN PAVEMENT MRL 66A. REPLACE WITH ELEVATED MRL FIXTURE 65. (NOT A SEPARATE PAY ITEM.)

LEGEND	
○ R 126	EXISTING RUNWAY LIGHTING (MRLS) BASE MOUNTED ELEVATED.
□ R-66A	EXISTING RUNWAY LIGHTS (MRLS) FLUSH MOUNTED IN PAVEMENT.
○ T-301	EXISTING TAXIWAY LIGHTING (MITLS)
● T-409	NEW TAXIWAY LIGHTS (MITLS)
○ T-316R	RELOCATED TAXIWAY LIGHTS BASE MOUNTED, ELEVATED.
□ TG-21	NEW TAXIWAY GUIDANCE SIGN
□ TG-8	EXISTING TAXIWAY GUIDANCE SIGN
□ TG-8R	RELOCATED TAXIWAY GUIDANCE SIGN
▲	NEW 5/8" d x 8' COPPER CLAD GROUND ROD

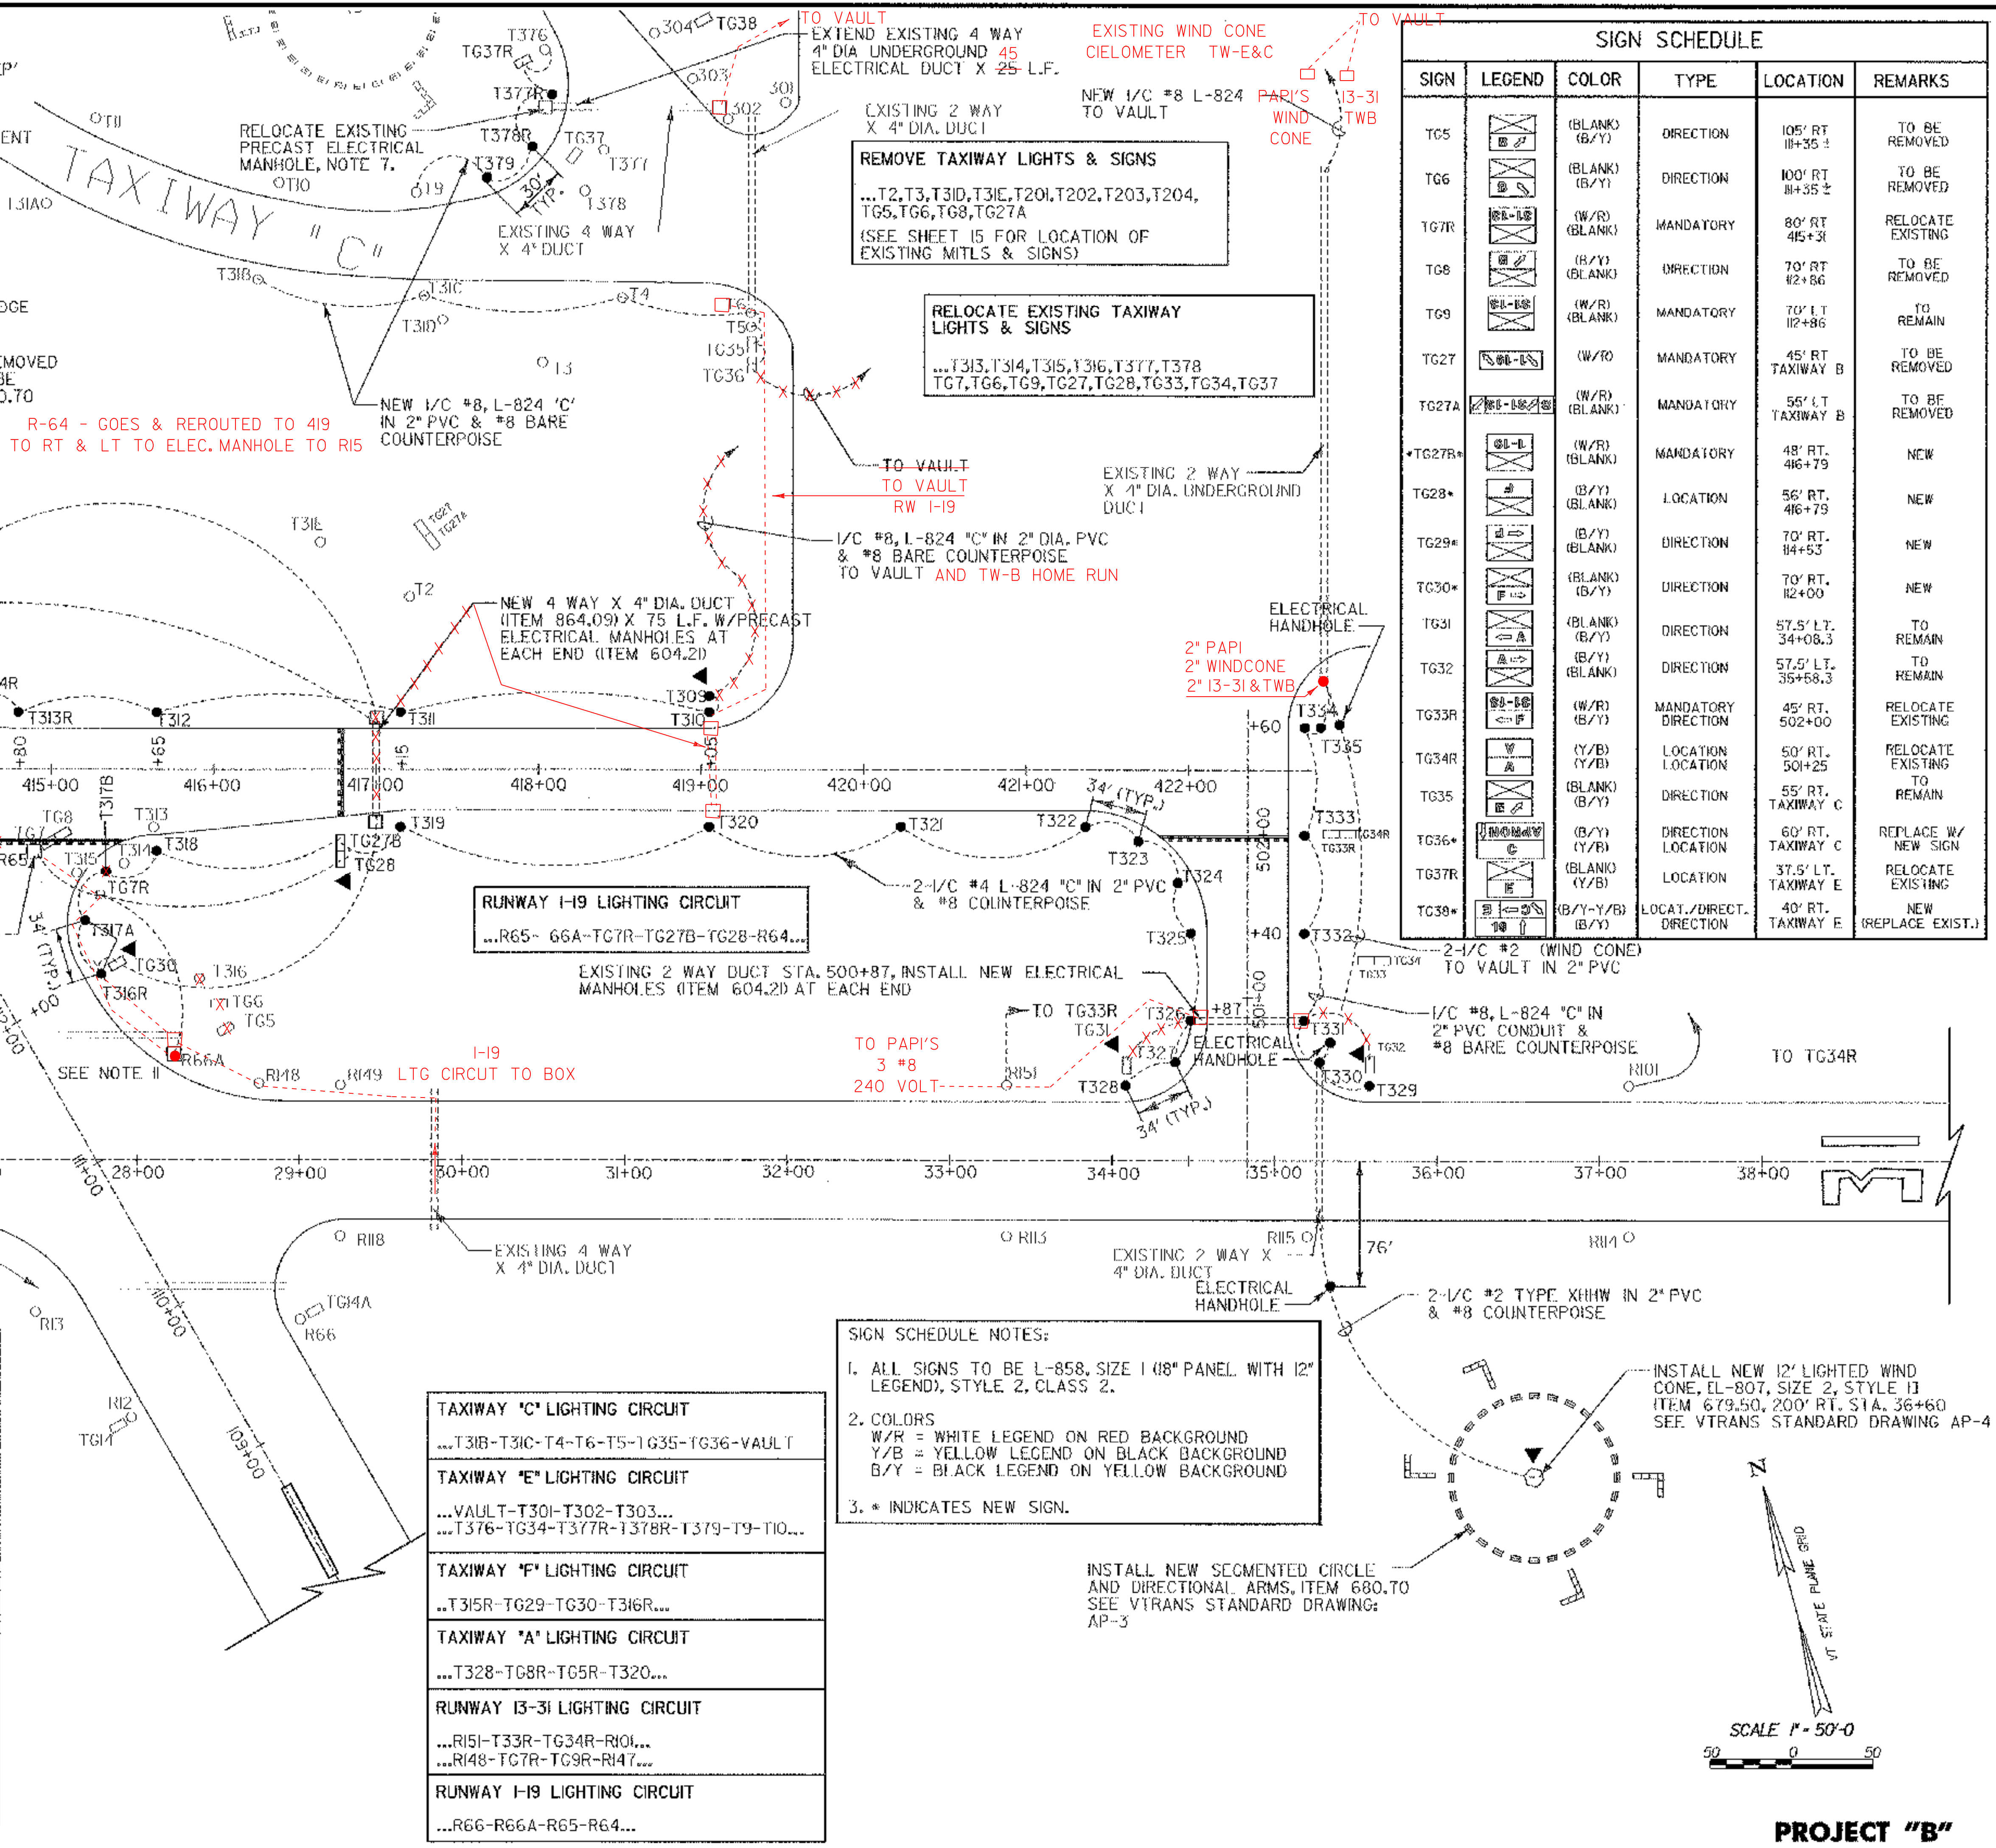


SIGN SCHEDULE					
SIGN	LEGEND	COLOR	TYPE	LOCATION	REMARKS
TG5	[Symbol]	(BLANK) (B/Y)	DIRECTION	105' RT 11+35 ±	TO BE REMOVED
TG6	[Symbol]	(BLANK) (B/Y)	DIRECTION	100' RT 11+35 ±	TO BE REMOVED
TG7R	[Symbol]	(W/R) (BLANK)	MANDATORY	80' RT 45+31	RELOCATE EXISTING
TG8	[Symbol]	(B/Y) (BLANK)	DIRECTION	70' RT 42+86	TO BE REMOVED
TG9	[Symbol]	(W/R) (BLANK)	MANDATORY	70' LT 112+86	TO REMAIN
TG27	[Symbol]	(W/R)	MANDATORY	45' RT TAXIWAY B	TO BE REMOVED
TG27A	[Symbol]	(W/R) (BLANK)	MANDATORY	55' LT TAXIWAY B	TO BE REMOVED
TG27B	[Symbol]	(W/R) (BLANK)	MANDATORY	48' RT. 46+79	NEW
TG28	[Symbol]	(B/Y) (BLANK)	LOCATION	56' RT. 46+79	NEW
TG29	[Symbol]	(B/Y) (BLANK)	DIRECTION	70' RT. 114+53	NEW
TG30	[Symbol]	(BLANK) (B/Y)	DIRECTION	70' RT. 112+00	NEW
TG31	[Symbol]	(BLANK) (B/Y)	DIRECTION	57.5' LT. 34+08.3	TO REMAIN
TG32	[Symbol]	(B/Y) (BLANK)	DIRECTION	57.5' LT. 35+58.3	TO REMAIN
TG33R	[Symbol]	(W/R) (B/Y)	MANDATORY DIRECTION	45' RT. 502+00	RELOCATE EXISTING
TG34R	[Symbol]	(Y/B) (A)	LOCATION LOCATION	50' RT. 501+25	RELOCATE EXISTING
TG35	[Symbol]	(BLANK) (B/Y)	DIRECTION	55' RT. TAXIWAY C	TO REMAIN
TG36	[Symbol]	(B/Y) (Y/B)	DIRECTION LOCATION	60' RT. TAXIWAY C	REPLACE W/ NEW SIGN
TG37R	[Symbol]	(BLANK) (Y/B)	LOCATION	37.5' LT. TAXIWAY E	RELOCATE EXISTING
TG38	[Symbol]	(B/Y-Y/B) (B/Y)	LOCAT./DIRECT. DIRECTION	40' RT. TAXIWAY E	NEW (REPLACE EXIST.)

SIGN SCHEDULE NOTES:

1. ALL SIGNS TO BE L-858, SIZE 1 (18" PANEL WITH 12" LEGEND), STYLE 2, CLASS 2.
2. COLORS
W/R = WHITE LEGEND ON RED BACKGROUND
Y/B = YELLOW LEGEND ON BLACK BACKGROUND
B/Y = BLACK LEGEND ON YELLOW BACKGROUND
3. * INDICATES NEW SIGN.

TAXIWAY 'C' LIGHTING CIRCUIT ...T31B-T31C-T4-T6-T5-TG35-TG36-VAULT
TAXIWAY 'E' LIGHTING CIRCUIT ...VAULT-T301-T302-T303... ...T376-TG34-T377R-T378R-T379-T9-T10...
TAXIWAY 'F' LIGHTING CIRCUIT ...T315R-TG29-TG30-T316R...
TAXIWAY 'A' LIGHTING CIRCUIT ...T328-TG8R-TG5R-T320...
RUNWAY I3-31 LIGHTING CIRCUIT ...R151-T33R-TG34R-R101... ...R148-TG7R-TG9R-R147...
RUNWAY I-19 LIGHTING CIRCUIT ...R66-R66A-R65-R64...

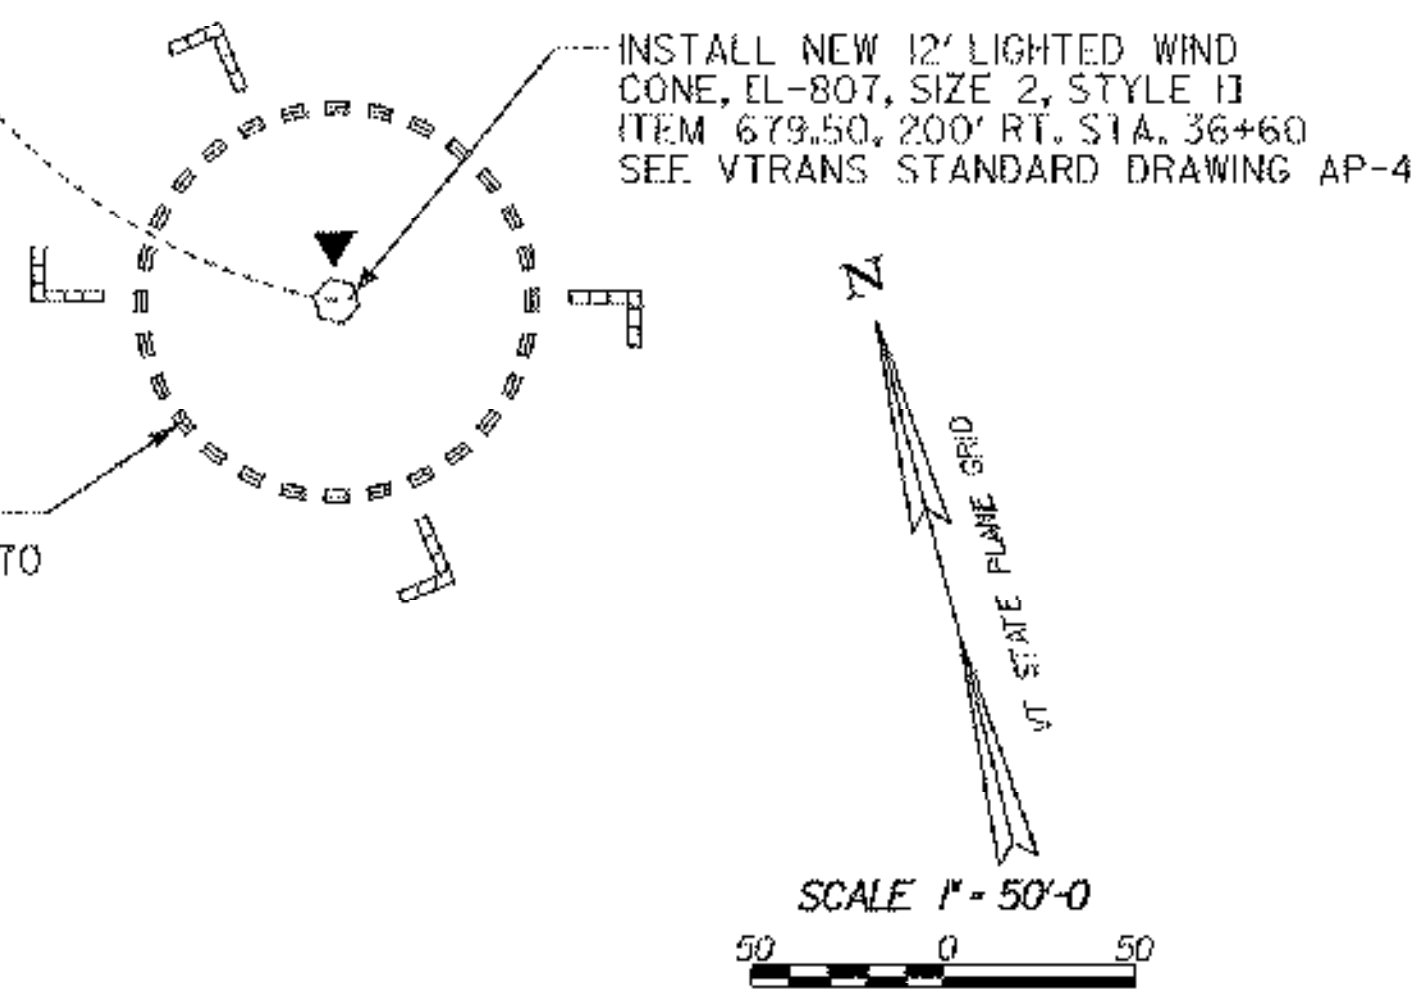

SCALE 1" = 50'-0"

PROJECT "B"
A.I.P. 3-50-0015-17

URS
1 NORTHWAY LN.
LATHAM, NEW YORK

Designed by G.W.D.
Drawn by M.C.M.
Checked by L.M.M.
Approved by G.W.D.

Scale: 1"=50'

Date: FEB, 2003


Sheet 22 OF 40

Sheet No
22


RUTLAND STATE AIRPORT
CLARENDON, VERMONT

TAXIWAY IMPROVEMENTS
TAXIWAY LIGHTING LAYOUT

DESCRIPTION
REV. DATE
FILE NO. F20204600222
JOB NO. F2020460045.00

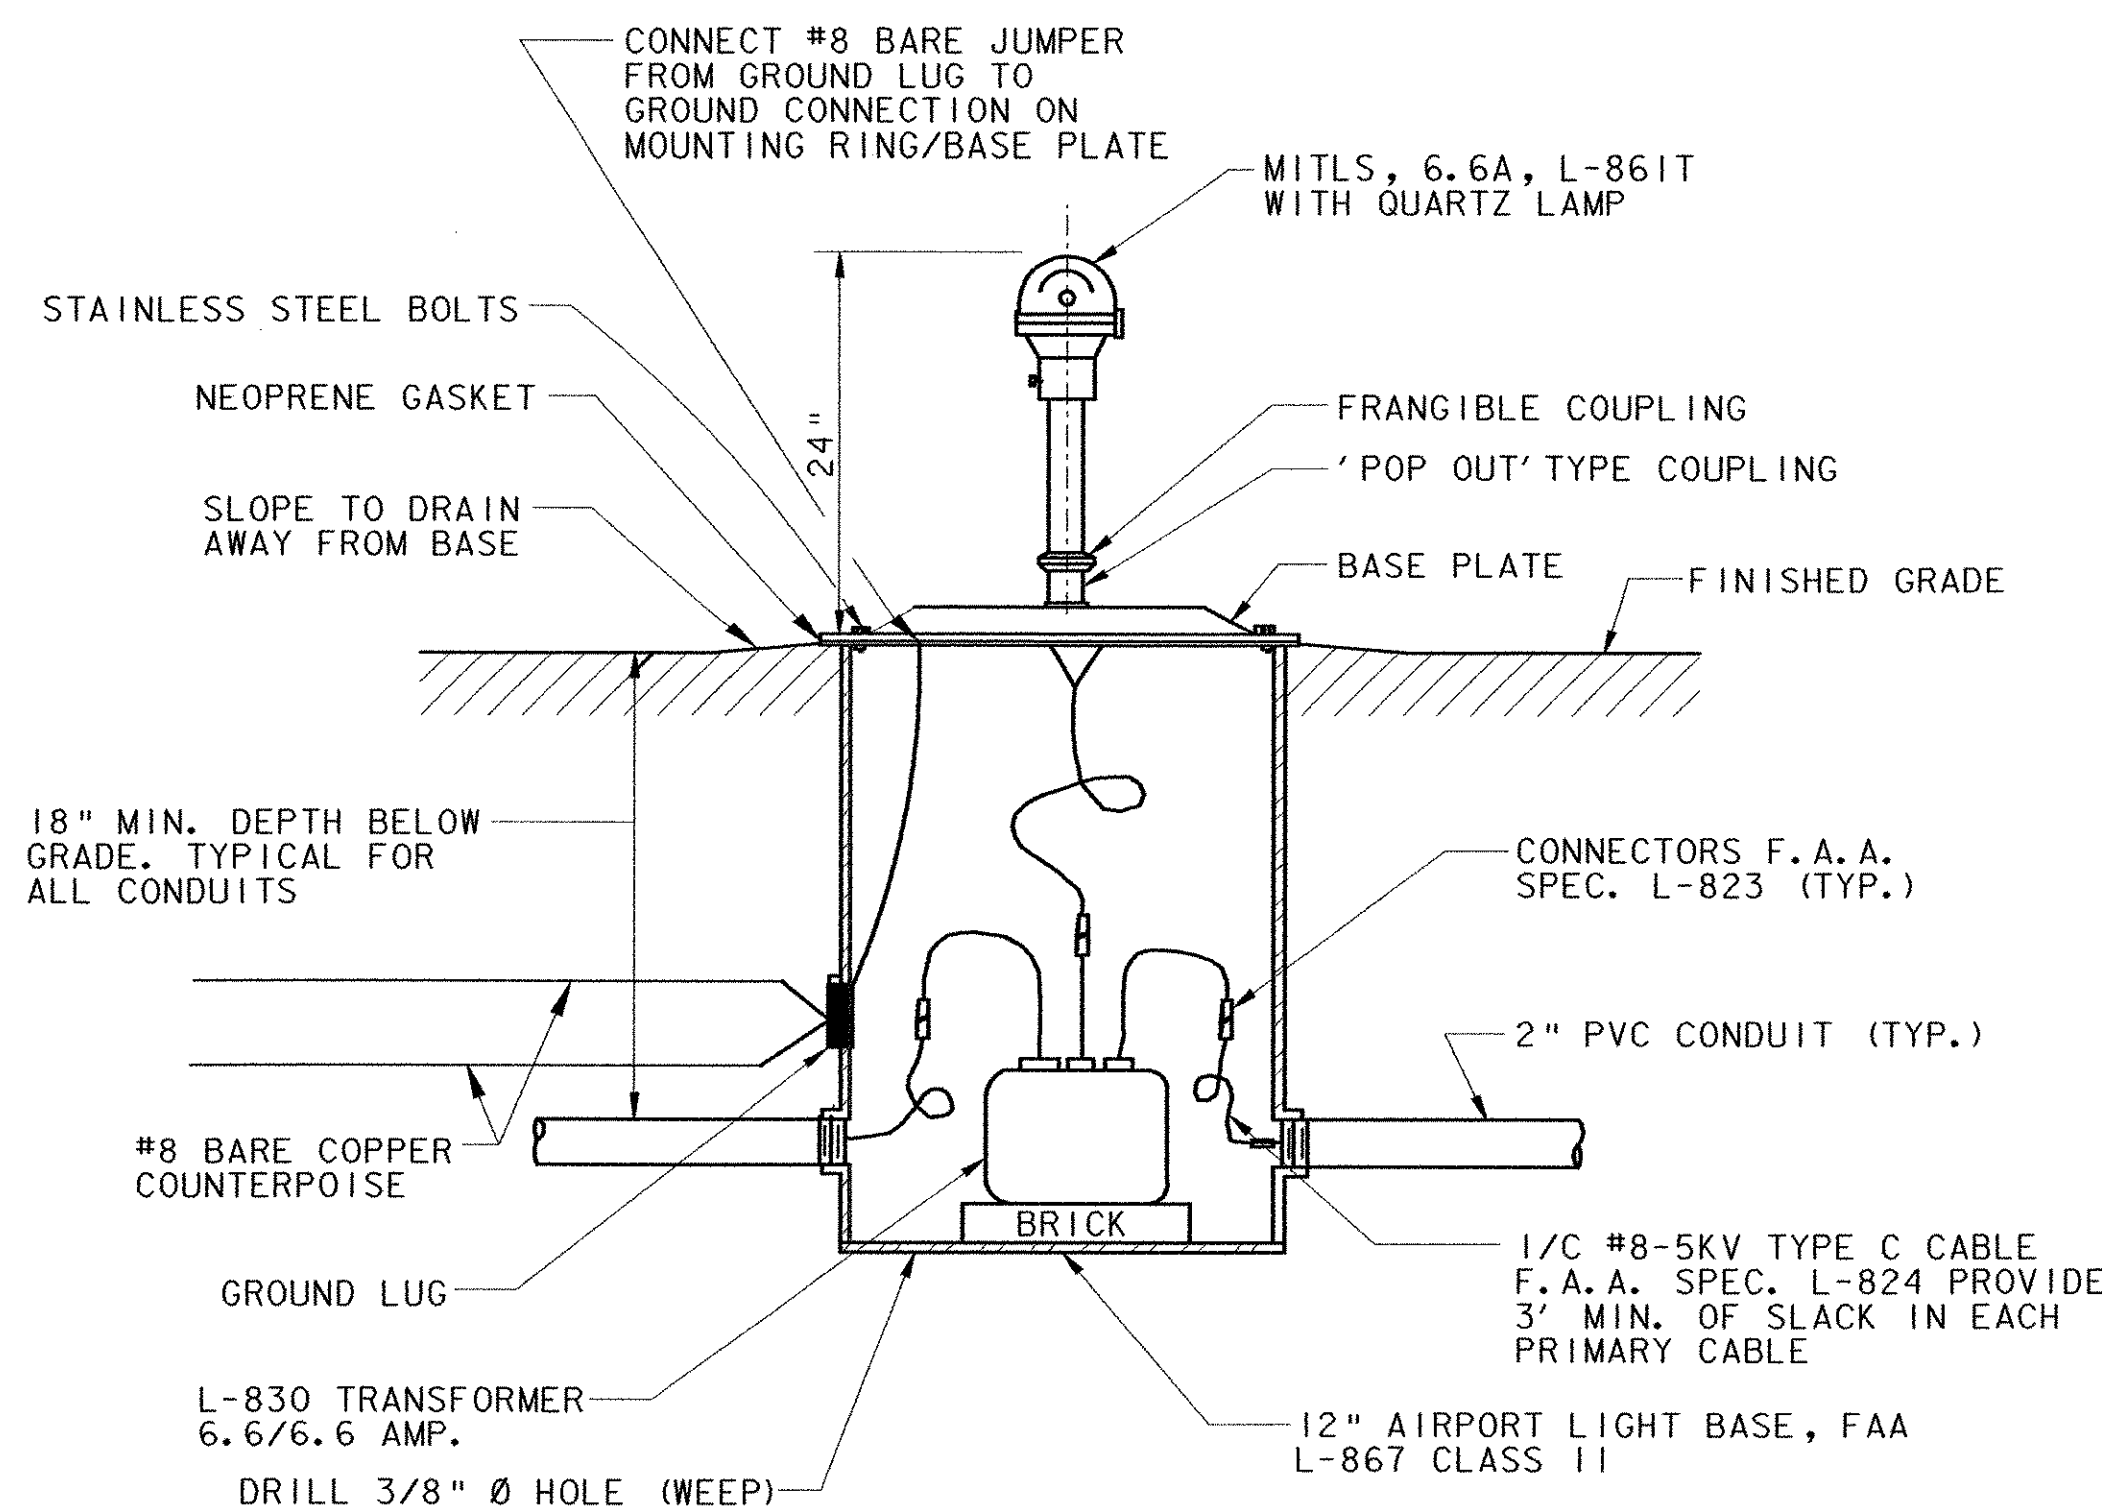


TYPICAL ELEVATED EDGE LIGHT (L-861T)
NOT TO SCALE

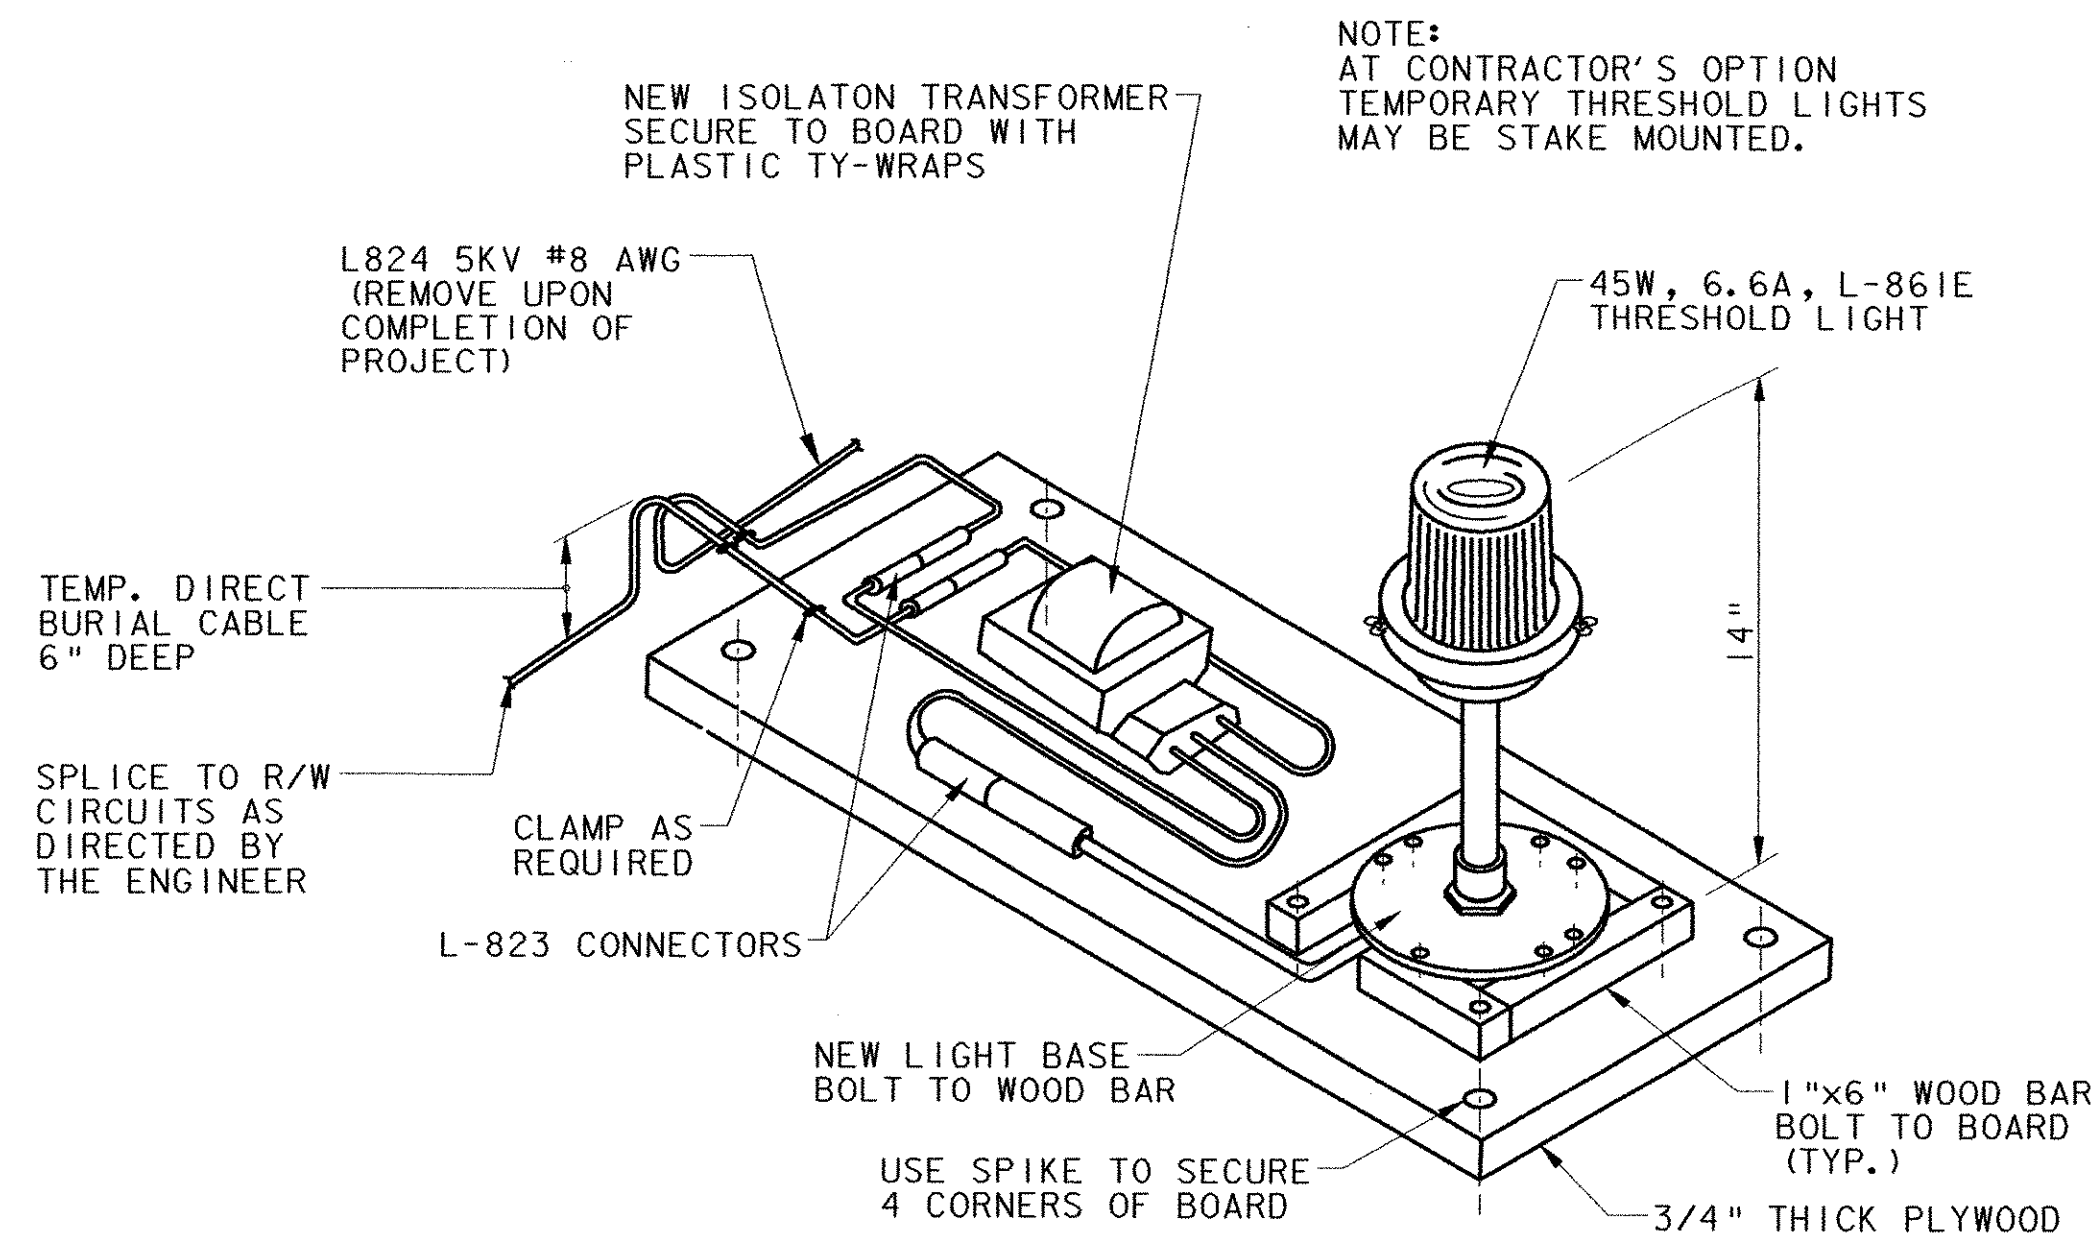


TEMPORARY THRESHOLD LIGHT
NOT TO SCALE


TO BE USED IN CONJUNCTION WITH ITEM L-100 TEMPORARY THRESHOLD, WHEN DIRECTED BY THE ENGINEER.

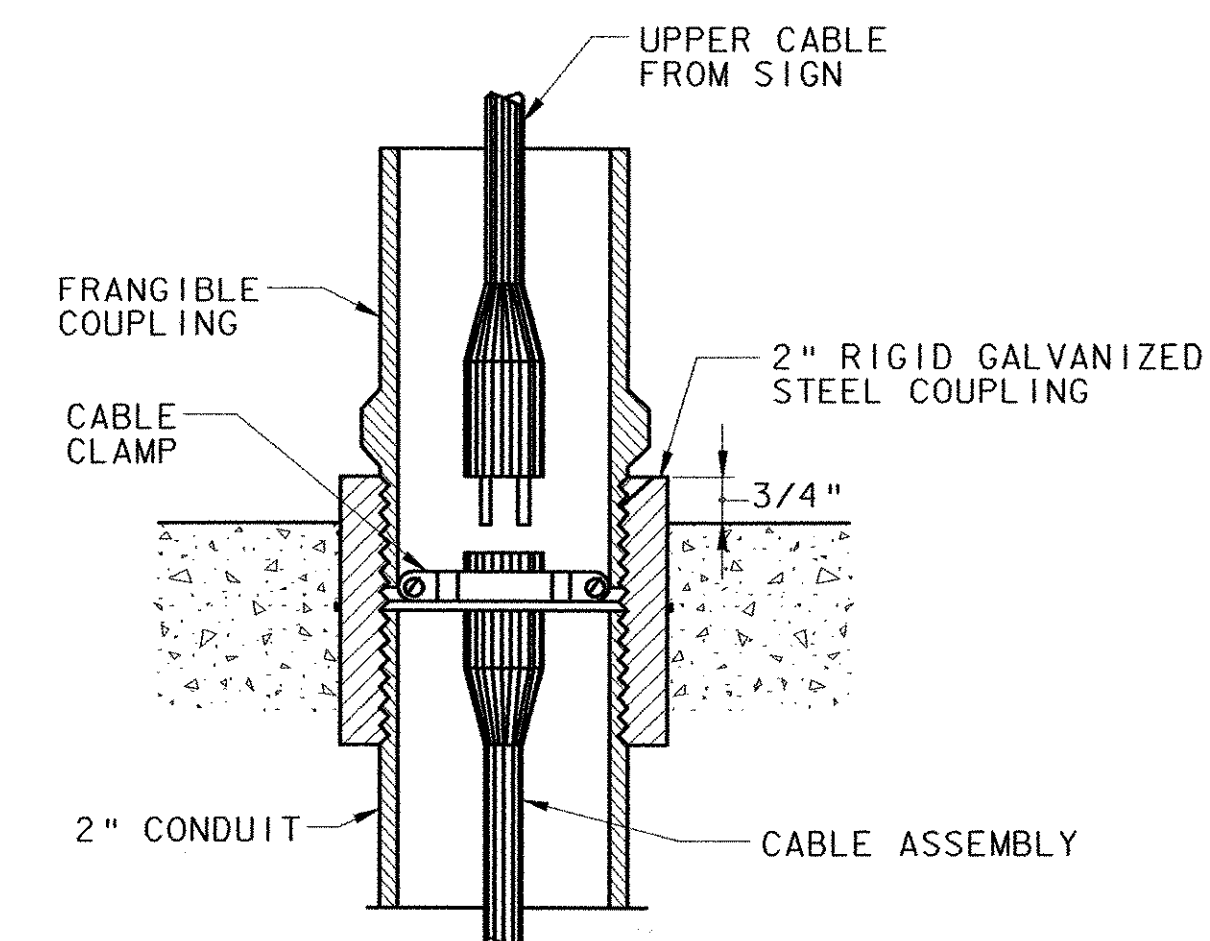


FRANGIBLE COUPLING CONNECTION DETAIL
NOT TO SCALE

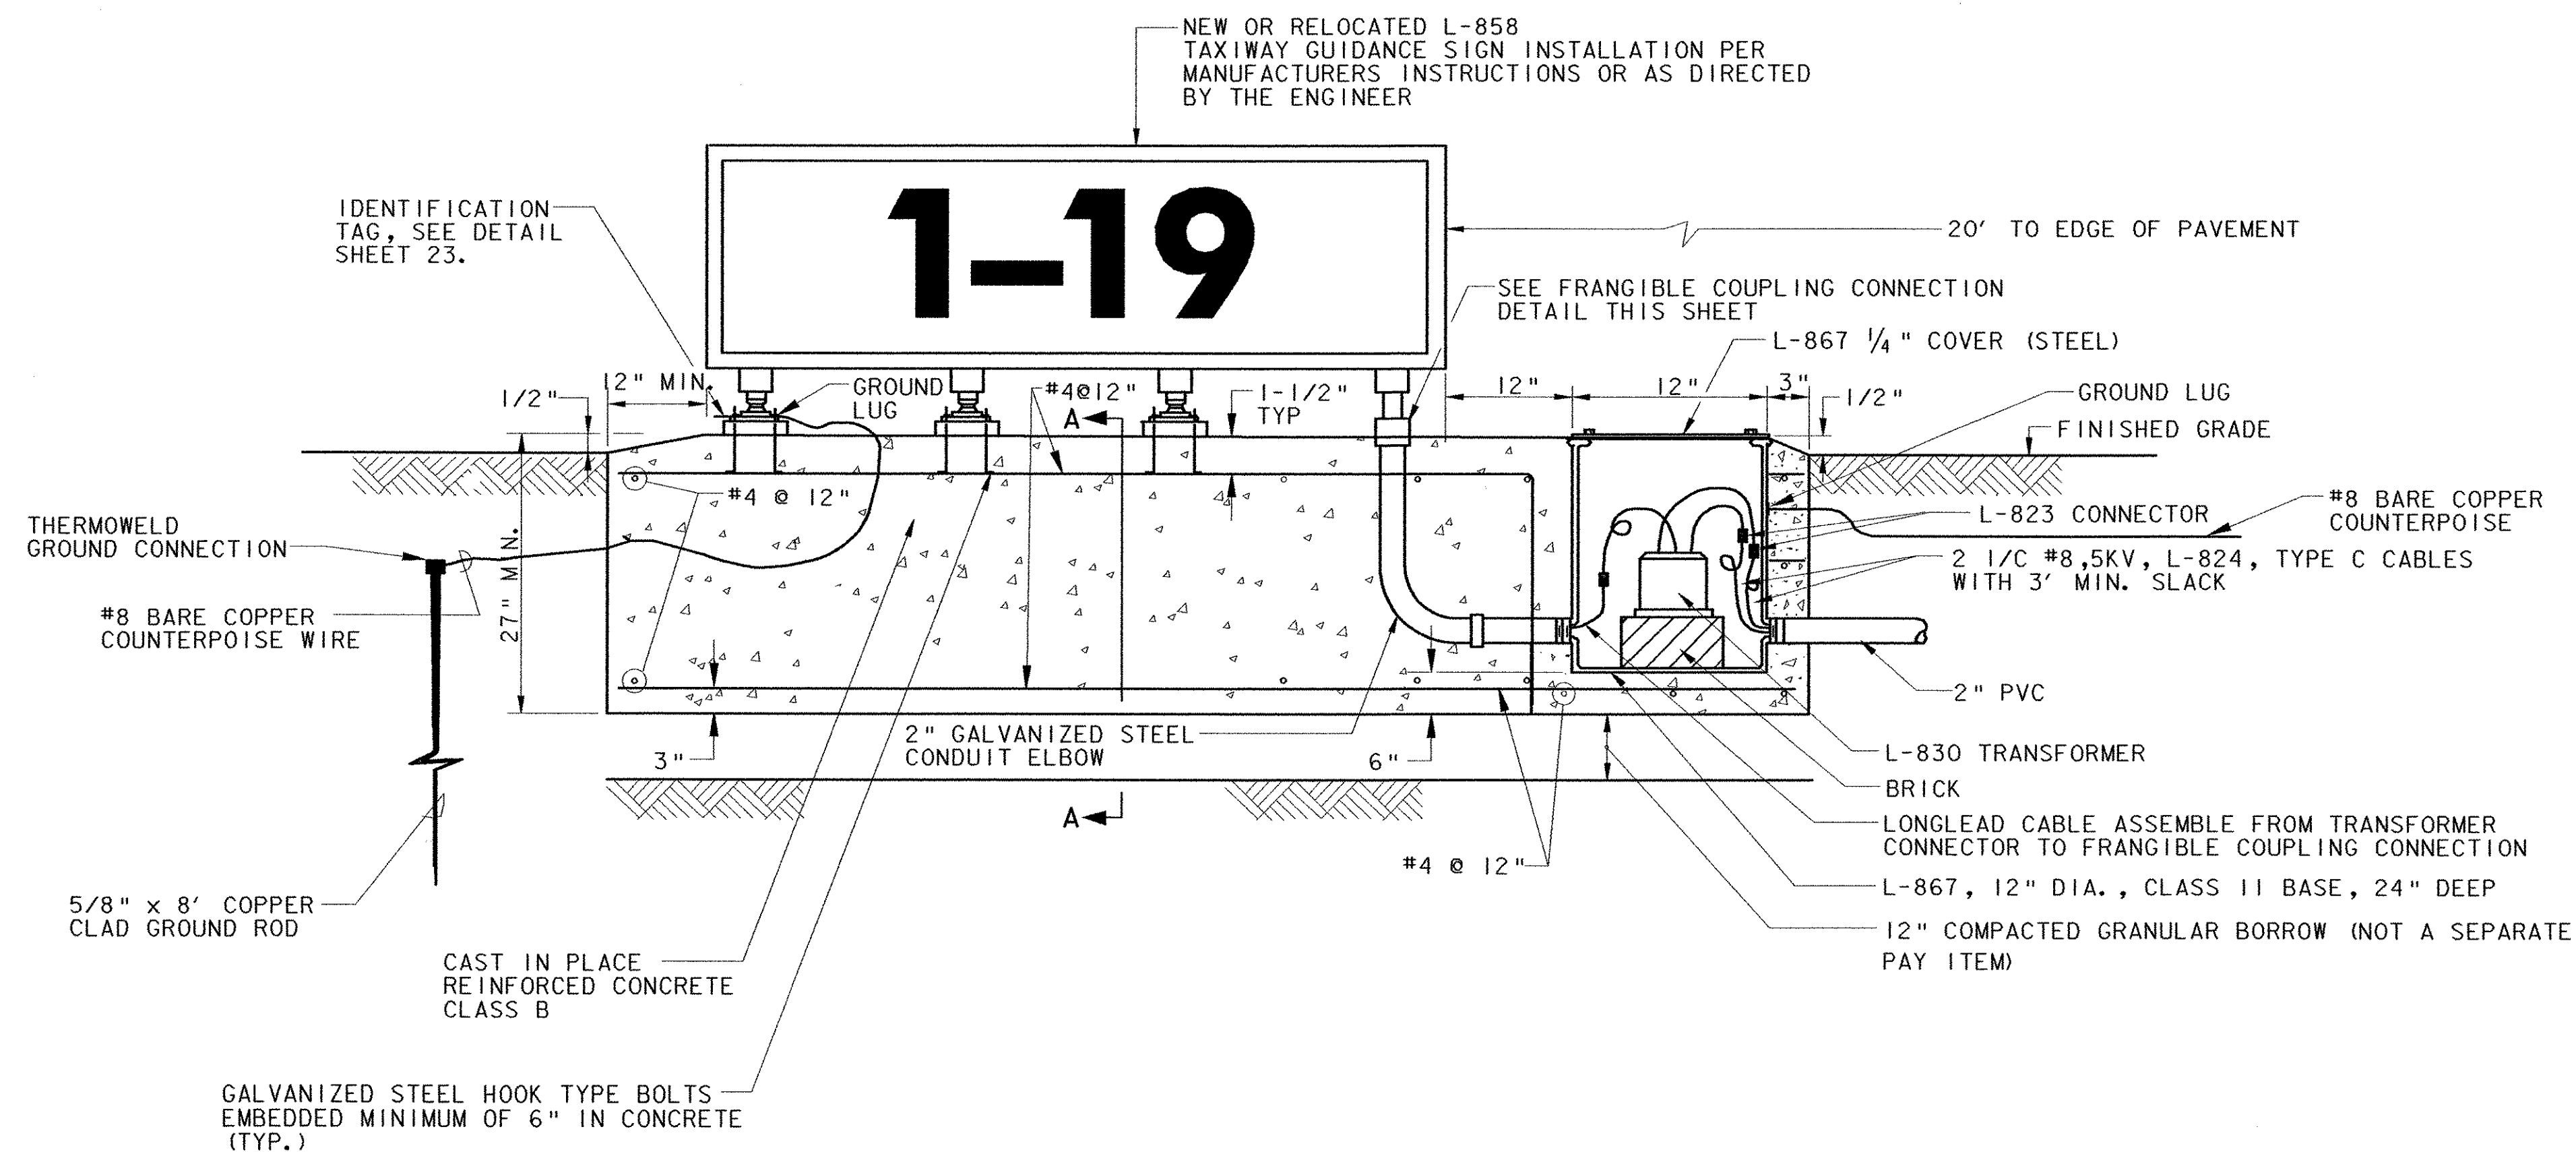

L-858 TAXIWAY GUIDANCE SIGN
NOT TO SCALE

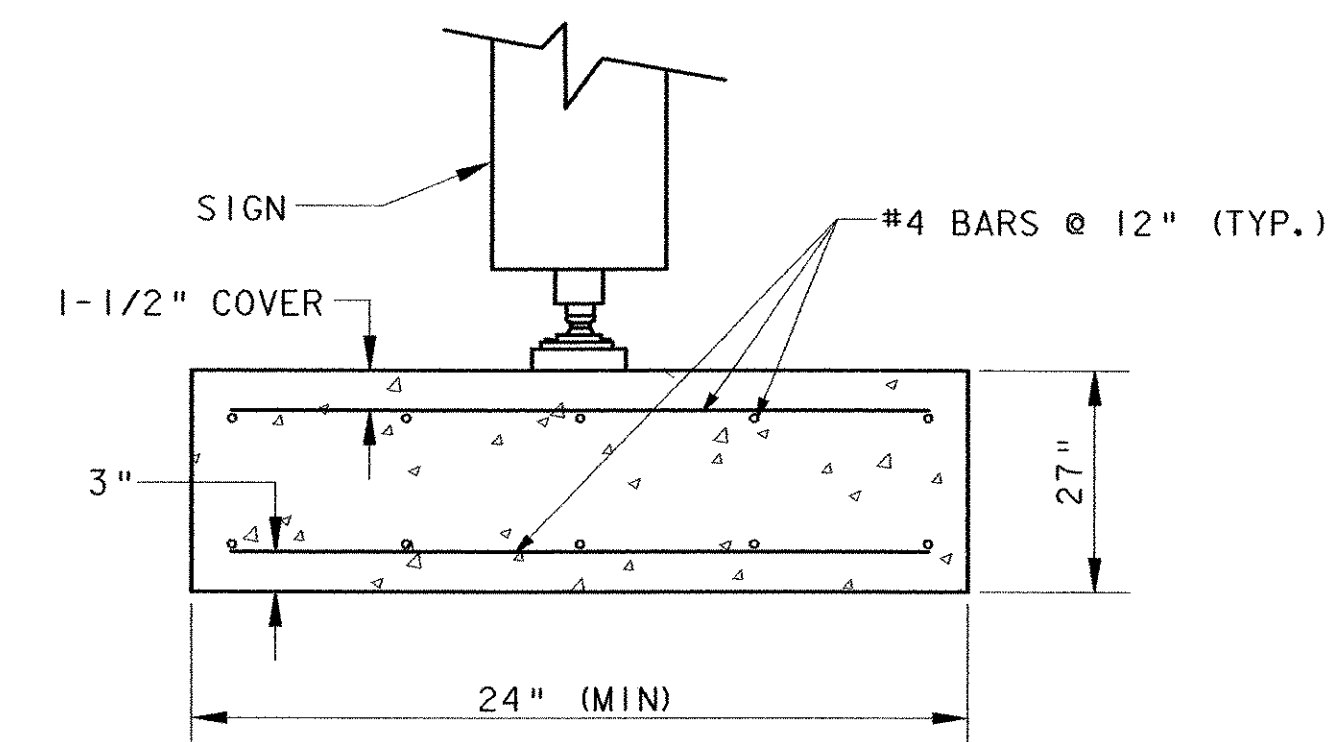

TAXIWAY GUIDANCE SIGN SECTION A-A
NOT TO SCALE

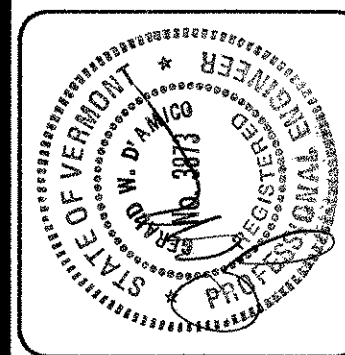

REV.	DATE	DESCRIPTION

Job No. F20204600023
File No. F20204600023

RUTLAND STATE AIRPORT
CLARENDON, VERMONT

TAXIWAY IMPROVEMENTS
AIRFIELD LIGHTING DETAILS

URS
1 NORTHWAY LN.
LATHAM, NEW YORK


Designed by: G.W.D.
Drawn by: M.C.M.
Checked by: L.M.M.
Approved by: G.W.D.

Scales: NTS

Date: FEB., 2003

Sheet 23 OF 40


Sheet No
23

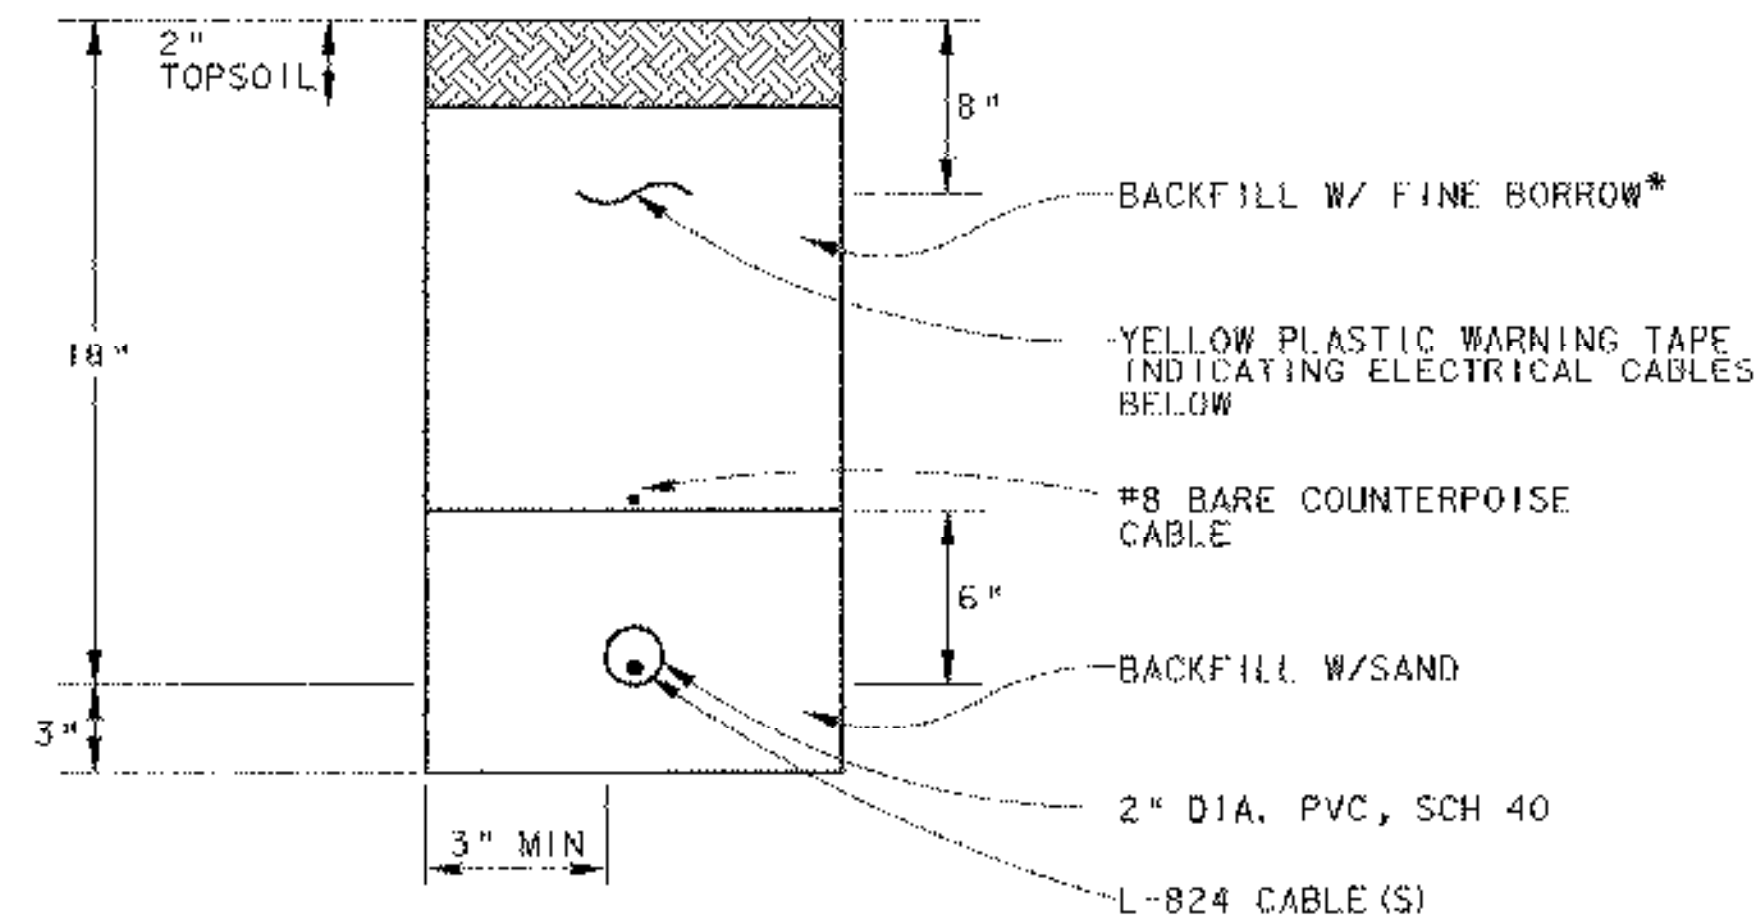


NOTE:
ADDITIONAL CONDUITS MAY BE
PLACED IN SAME TRENCH @ 3"
SPACING. MAX. NUMBER OF
CABLES / CONDUIT PER N.E.C.

* FINE BORROW MATERIAL REASONABLY FREE
FROM LOAM, CLAY OR ORGANIC MATERIAL,
MAXIMUM SIZE = 1/2"


A CONDUIT TRENCH DETAIL (TYP)
SCALE: NONE L-108

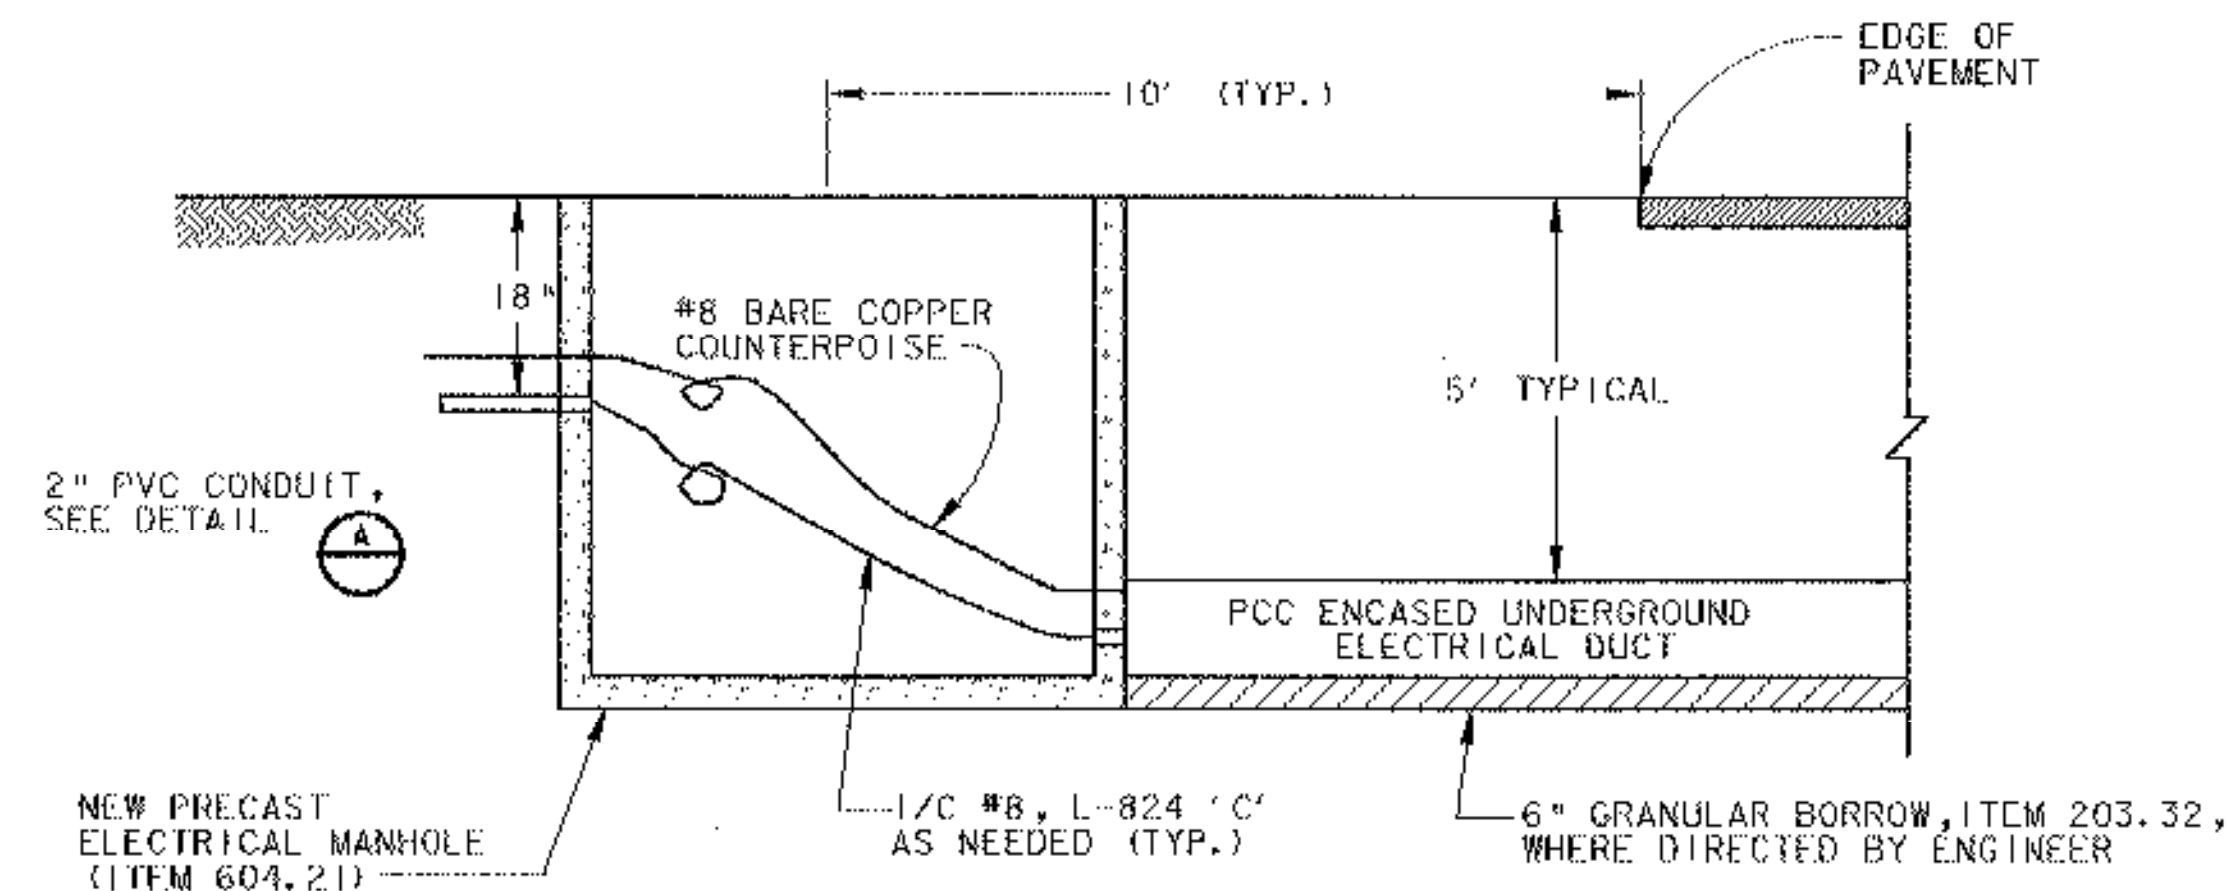

B CONDUIT DUCT DETAIL (TYP)
SCALE: NONE

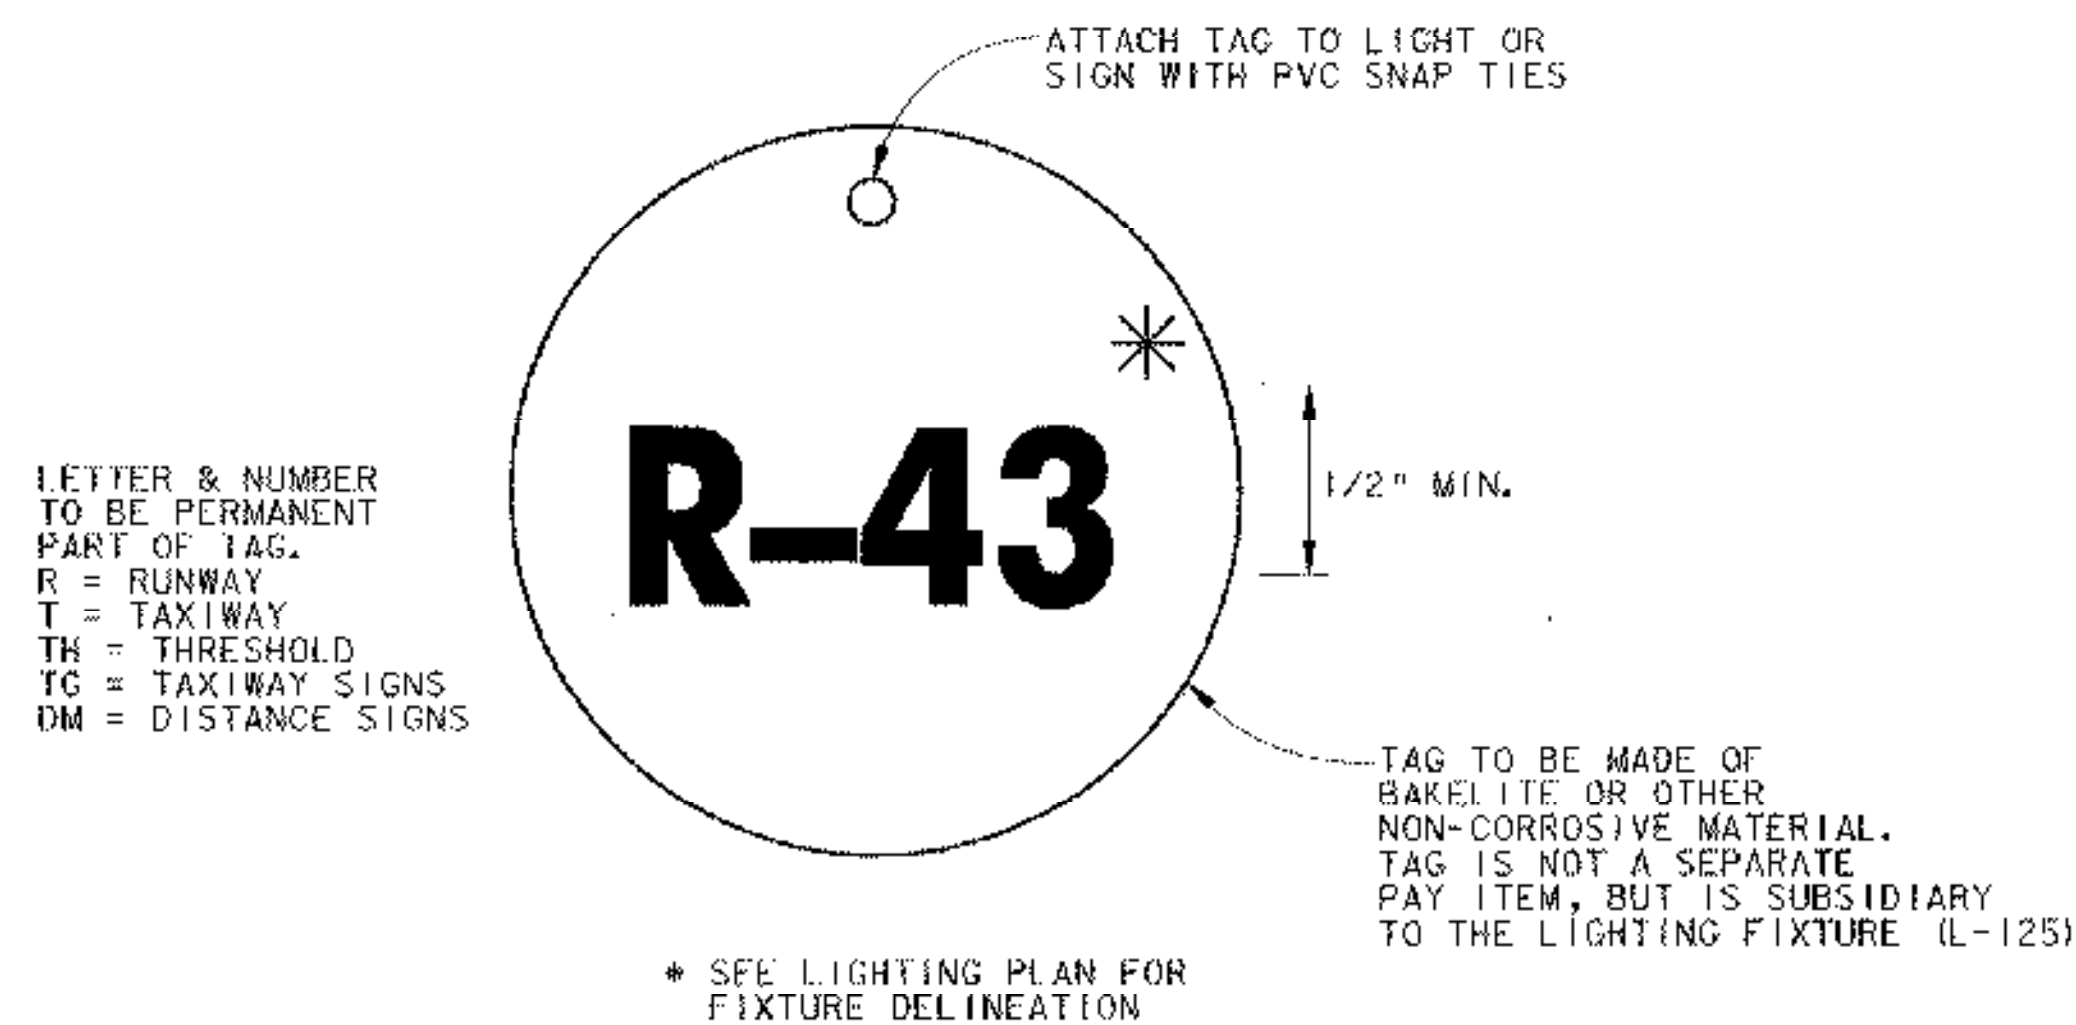

C FIXTURE IDENTIFICATION TAG (TYP)
SCALE: NONE

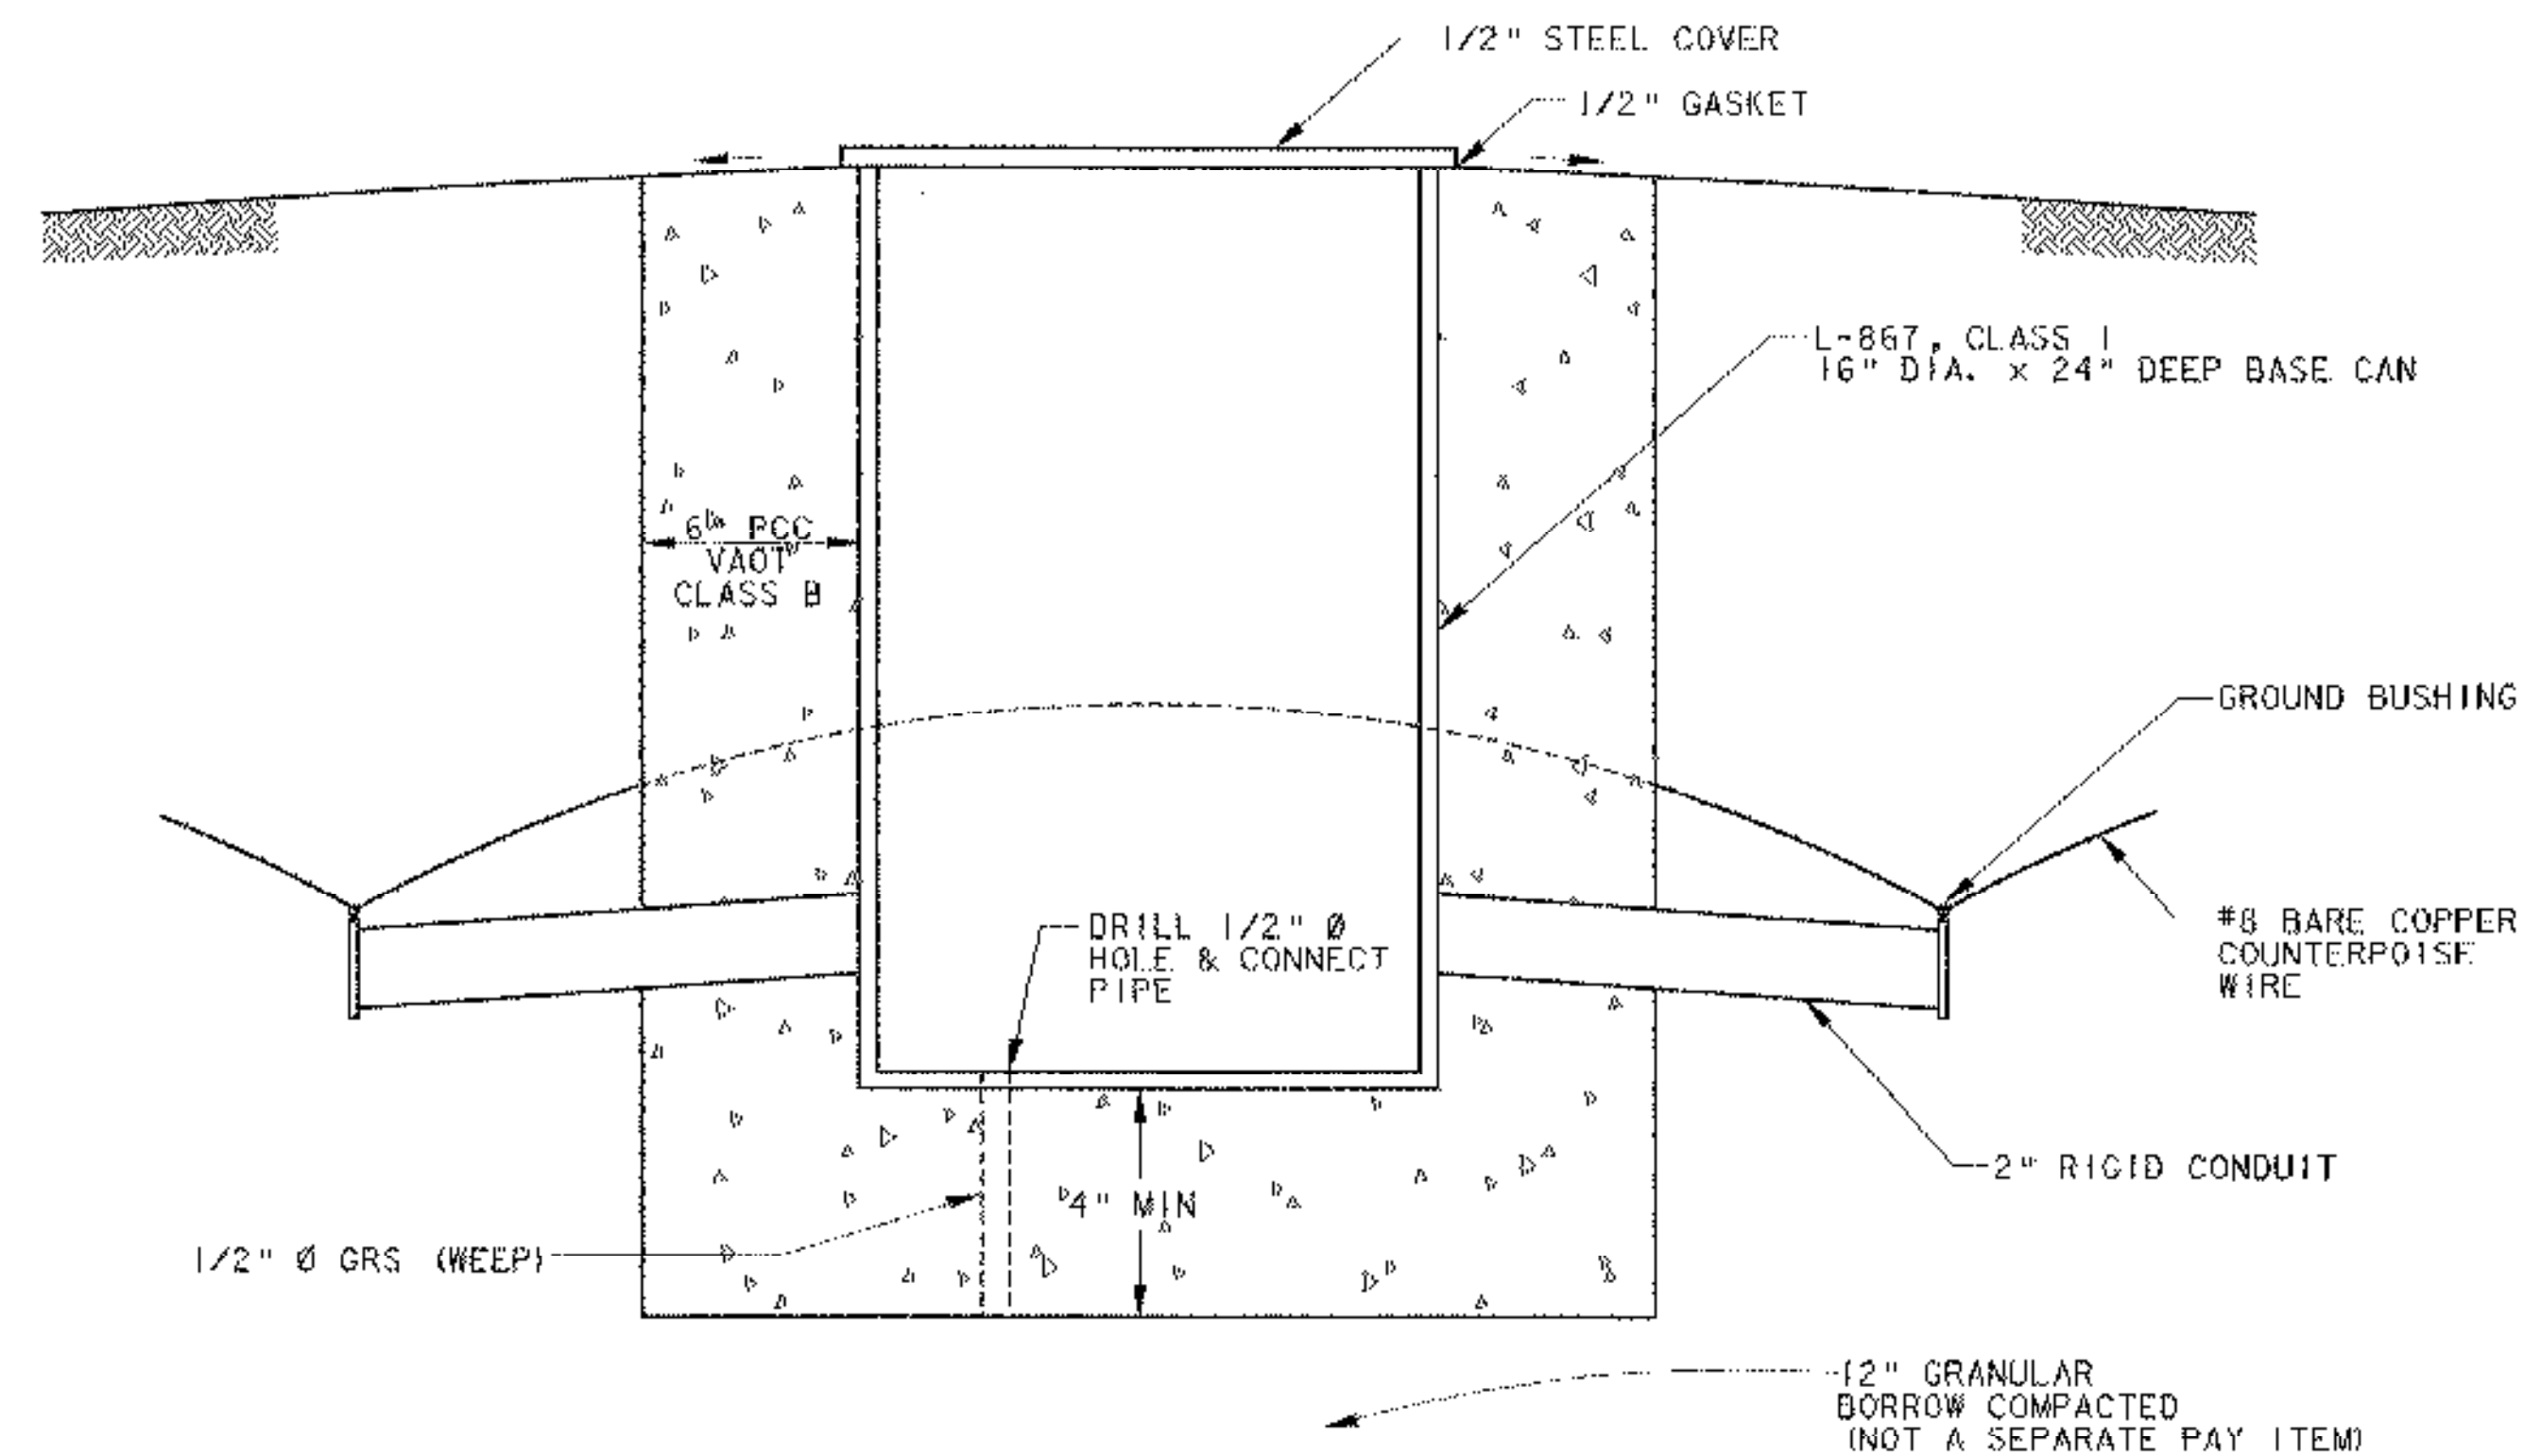

D CONCRETE MANHOLE WITH CAST IRON COVER (TYP)
SCALE: NONE ITEM 604.11

NOTES:

1. WHERE NECESSARY, HAND EXCAVATE AROUND EXISTING DUCT. EXISTING CABLES MAY BE DIRECT BURIAL.
2. SEE VTRANS STANDARD DRAWING AP-3 FOR ELECTRICAL DUCT DETAIL.
3. SEE VTRANS STANDARD DRAWING D-15 FOR PRE-CAST ELECTRICAL MANHOLE DETAILS.

URS
1 NORTHWAY LN.
LATHAM, NEW YORK

RUTLAND STATE AIRPORT
CLARENDON, VERMONT

TAXIWAY IMPROVEMENTS
AIRFIELD LIGHTING DETAILS


Designed by: G.W.D.
Drawn by: M.G.M.
Checked by: L.M.M.
Approved by: G.W.D.

Scale: NTS


Date: FEB., 2003

Sheet 24 OF 40


Sheet No
24

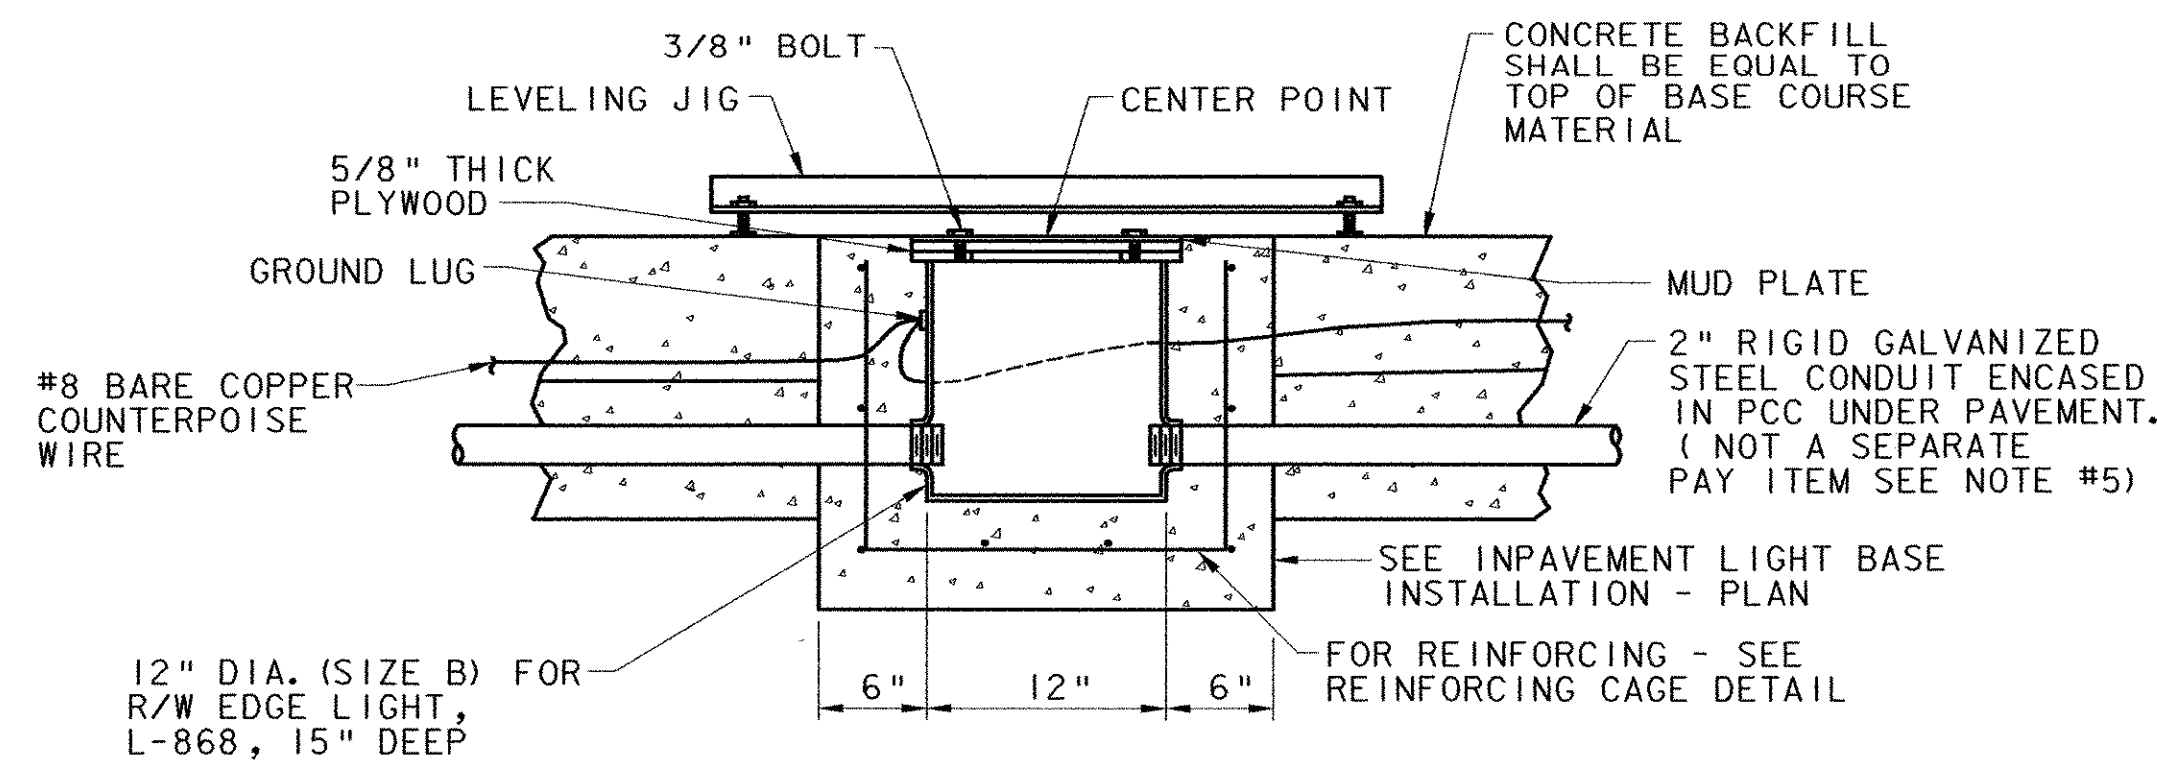

STEP 1
SCALE: NONE

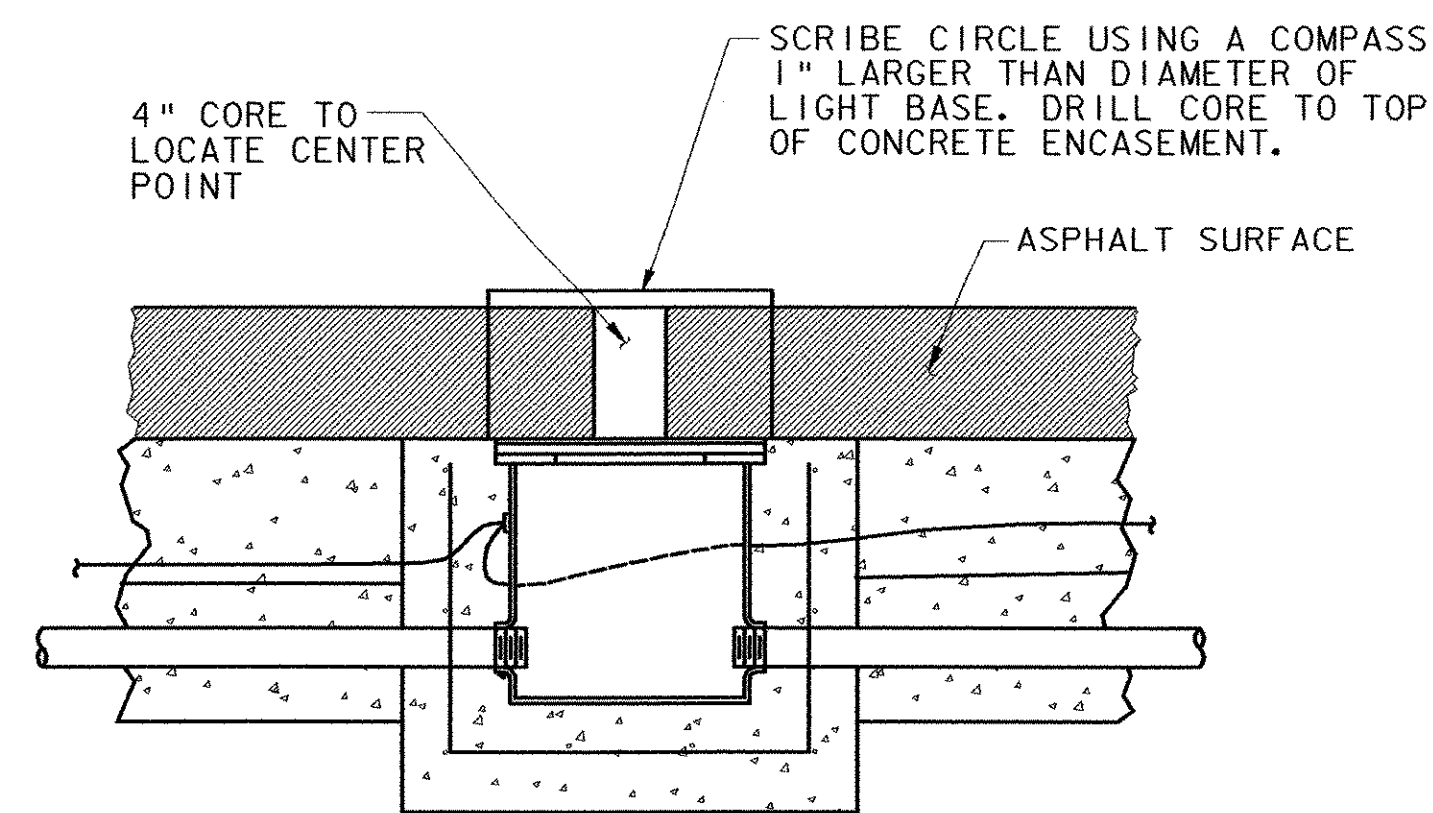


STEP 2
SCALE: NONE

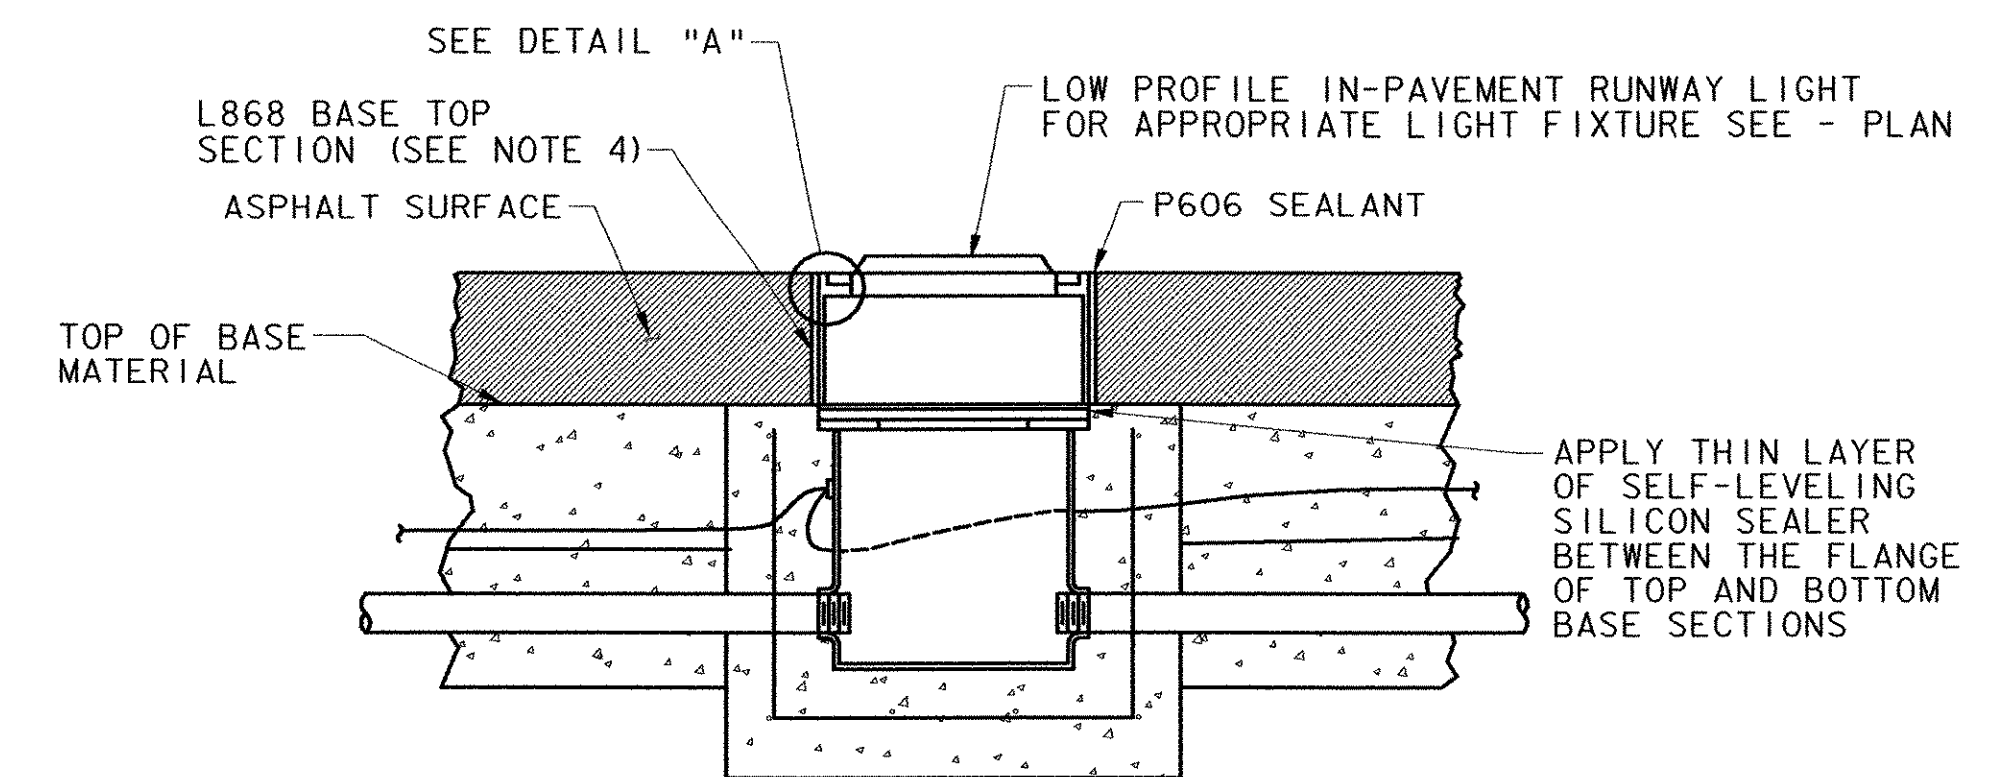


STEP 3
SCALE: NONE

GENERAL NOTES:


1. CONCRETE TO CONFORM TO VAOT SPECIFICATIONS SECTION 501, CLASS B, 3/4" MAX SIZE AGGREGATE.
2. PRIOR TO ASPHALT PAVING, COVER MUD PLATE WITH A SHINGLE OR ANOTHER THIN ARTICLE WHEN TACK COAT IS APPLIED PRIOR TO PAVING. BEFORE PAVING COMMENCES, REMOVE SHINGLE AND LIGHTLY WIPE DOWN MUD PLATE WITH VEGETABLE OIL.
3. TIGHTEN ALL BOLTS TO THE TORQUE SPECIFIED BY THE MANUFACTURER. DO NOT REUSE SHIPPING BOLTS TO INSTALL COVERS.
4. RUNWAY EDGE IN PAVEMENT LIGHTS TO CONFORM TO L-850 C, LOW PROFILE LIGHTS, AS MANUFACTURED BY HUGHEY & PHILIPS, WITH STAINLESS STEEL ADJUSTABLE RING.
5. THE COST OF THE 2" RIGID CONDUIT ENCASED IN CONCRETE TO BE INCLUDED IN THE BID PRICE FOR MIRLS (ITEM 864.10), BASE MOUNTED, IN PAVEMENT.

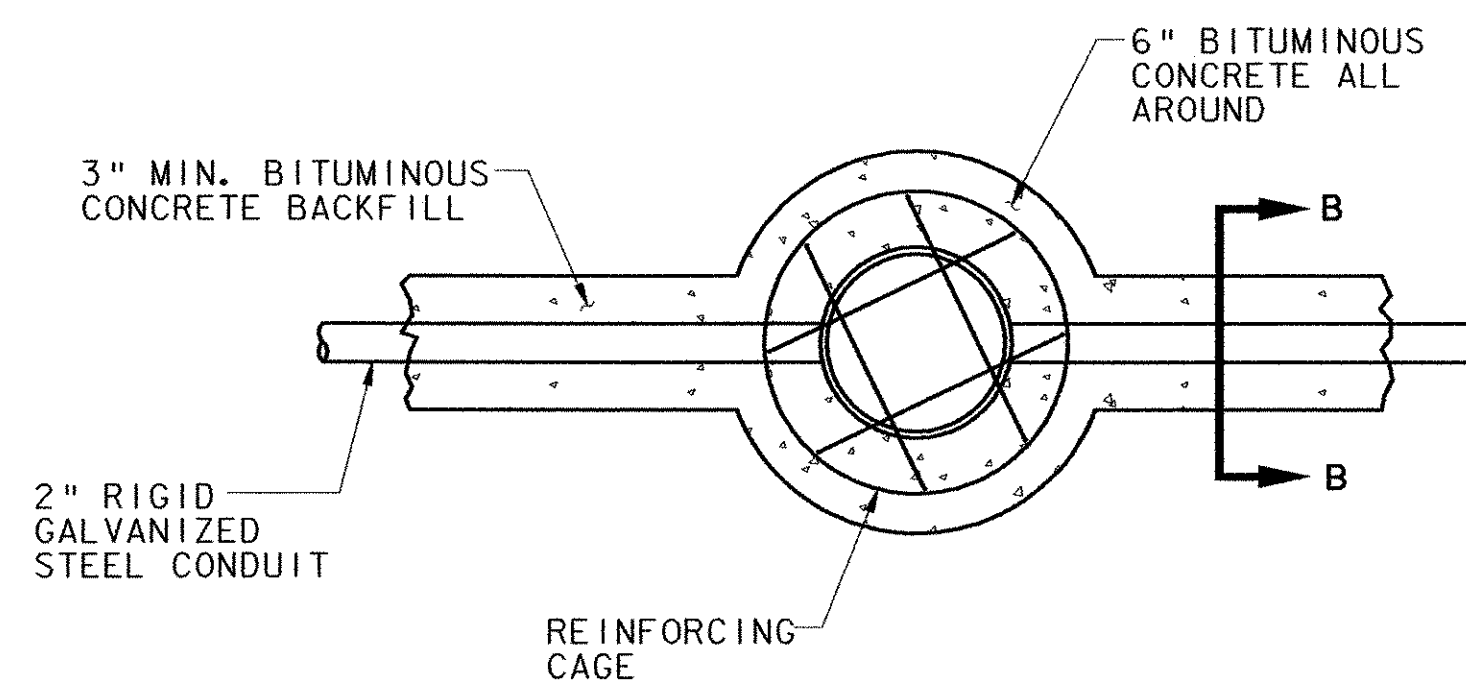


**IN-PAVEMENT LIGHT BASE
INSTALLATION - PLAN**
SCALE: NONE

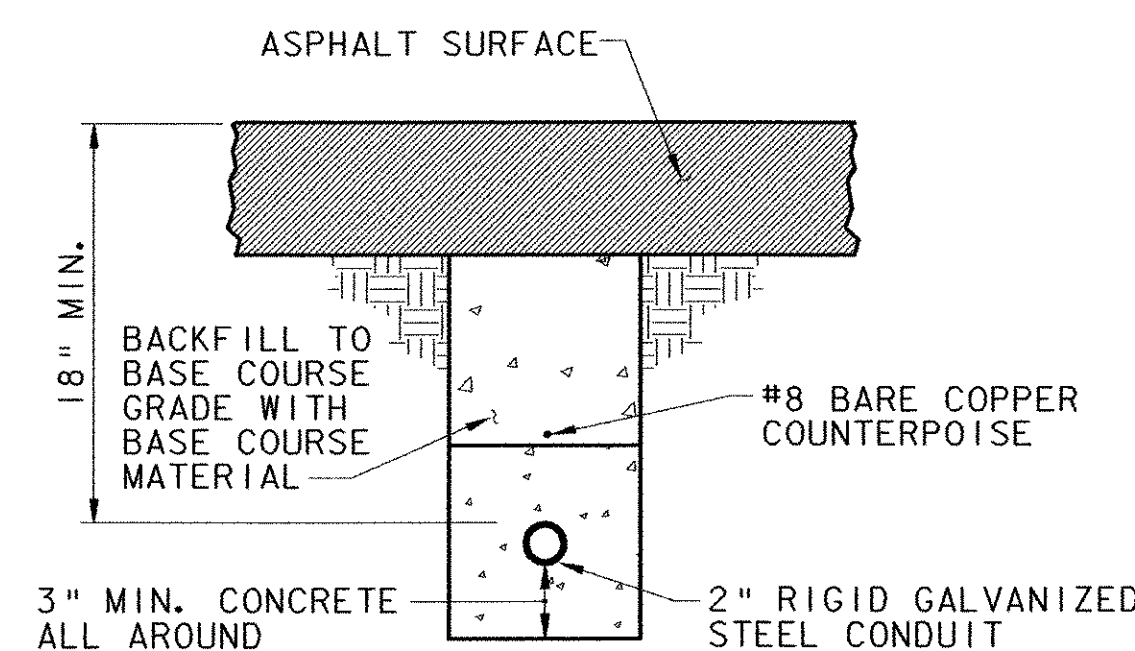

SECTION B-B
SCALE: NONE

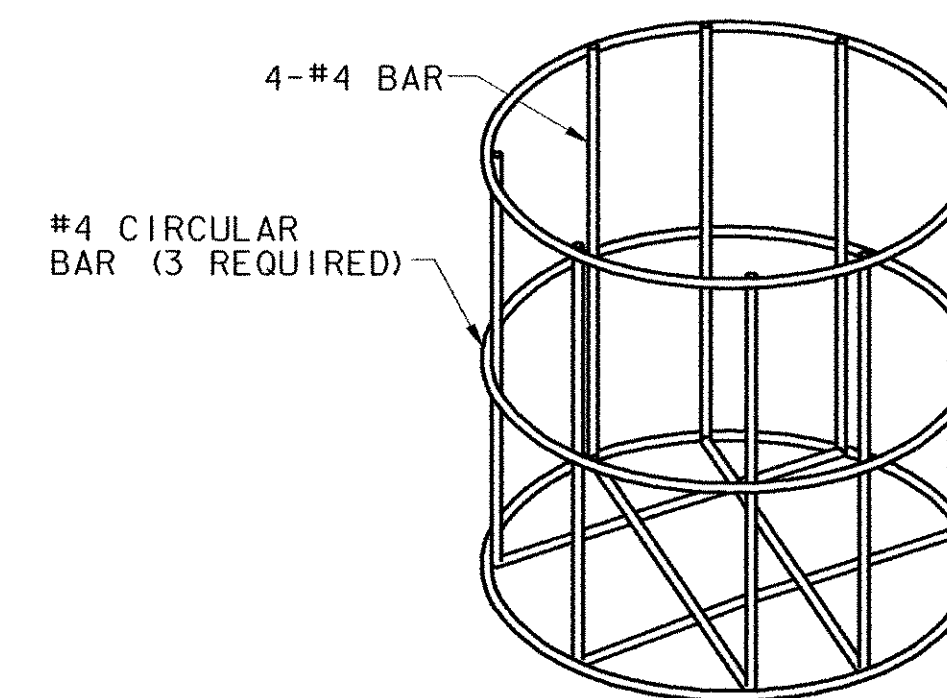


REINFORCING CAGE DETAIL
SCALE: NONE

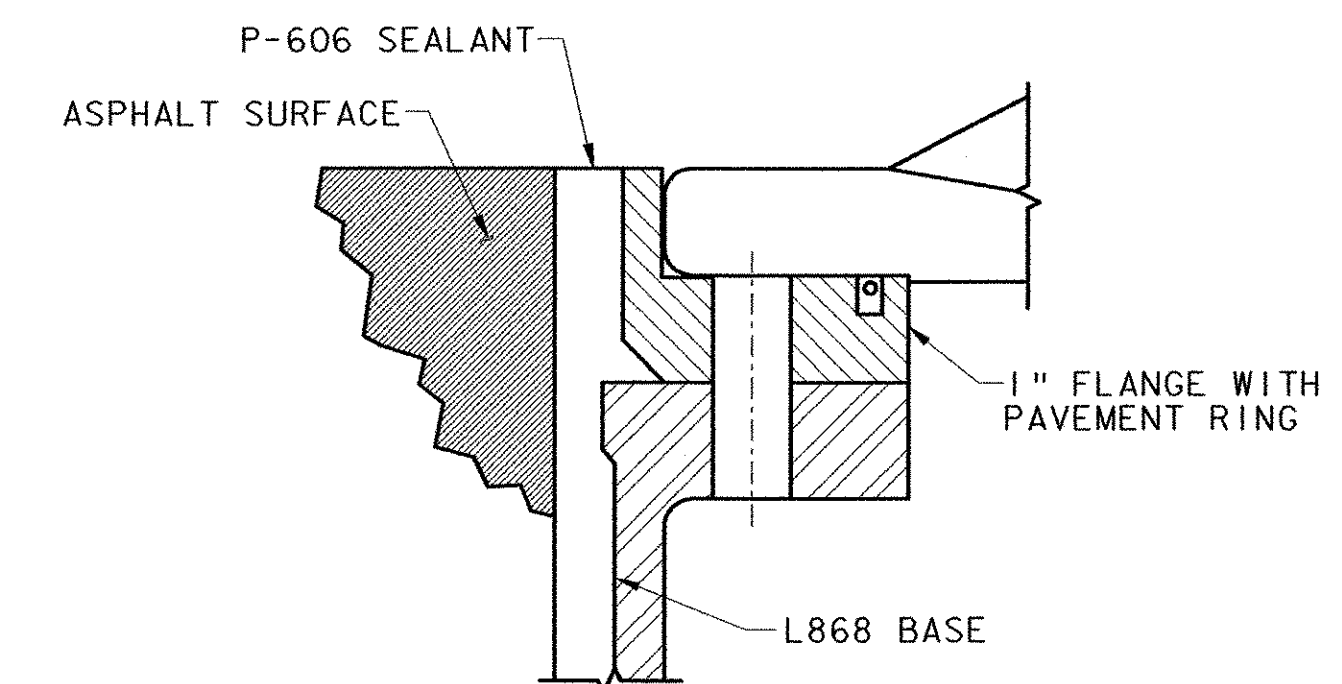

DETAIL "A"
SCALE: NONE

**INSTALLATION OF IN-PAVEMENT LIGHT IN NEW PAVEMENT
LOW PROFILE - L850 C**

ITEM 864.10

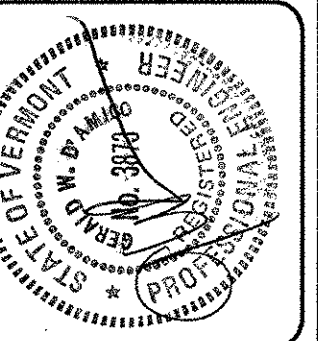

REV.	DATE	DESCRIPTION

RUTLAND STATE AIRPORT
CLARENDON, VERMONT

TAXIWAY IMPROVEMENTS
AIRFIELD LIGHTING DETAILS

URS
1 NORTHWAY LN.
LATHAM, NEW YORK

Designed by: G.M.D.
Drawn by: M.C.M.
Checked by: L.M.M.
Approved by: G.W.D.


Scales: NTS

Date: FEB., 2003


Sheet 25 OF 40

Sheet No
25

A.I.P. 3-50-0015-17

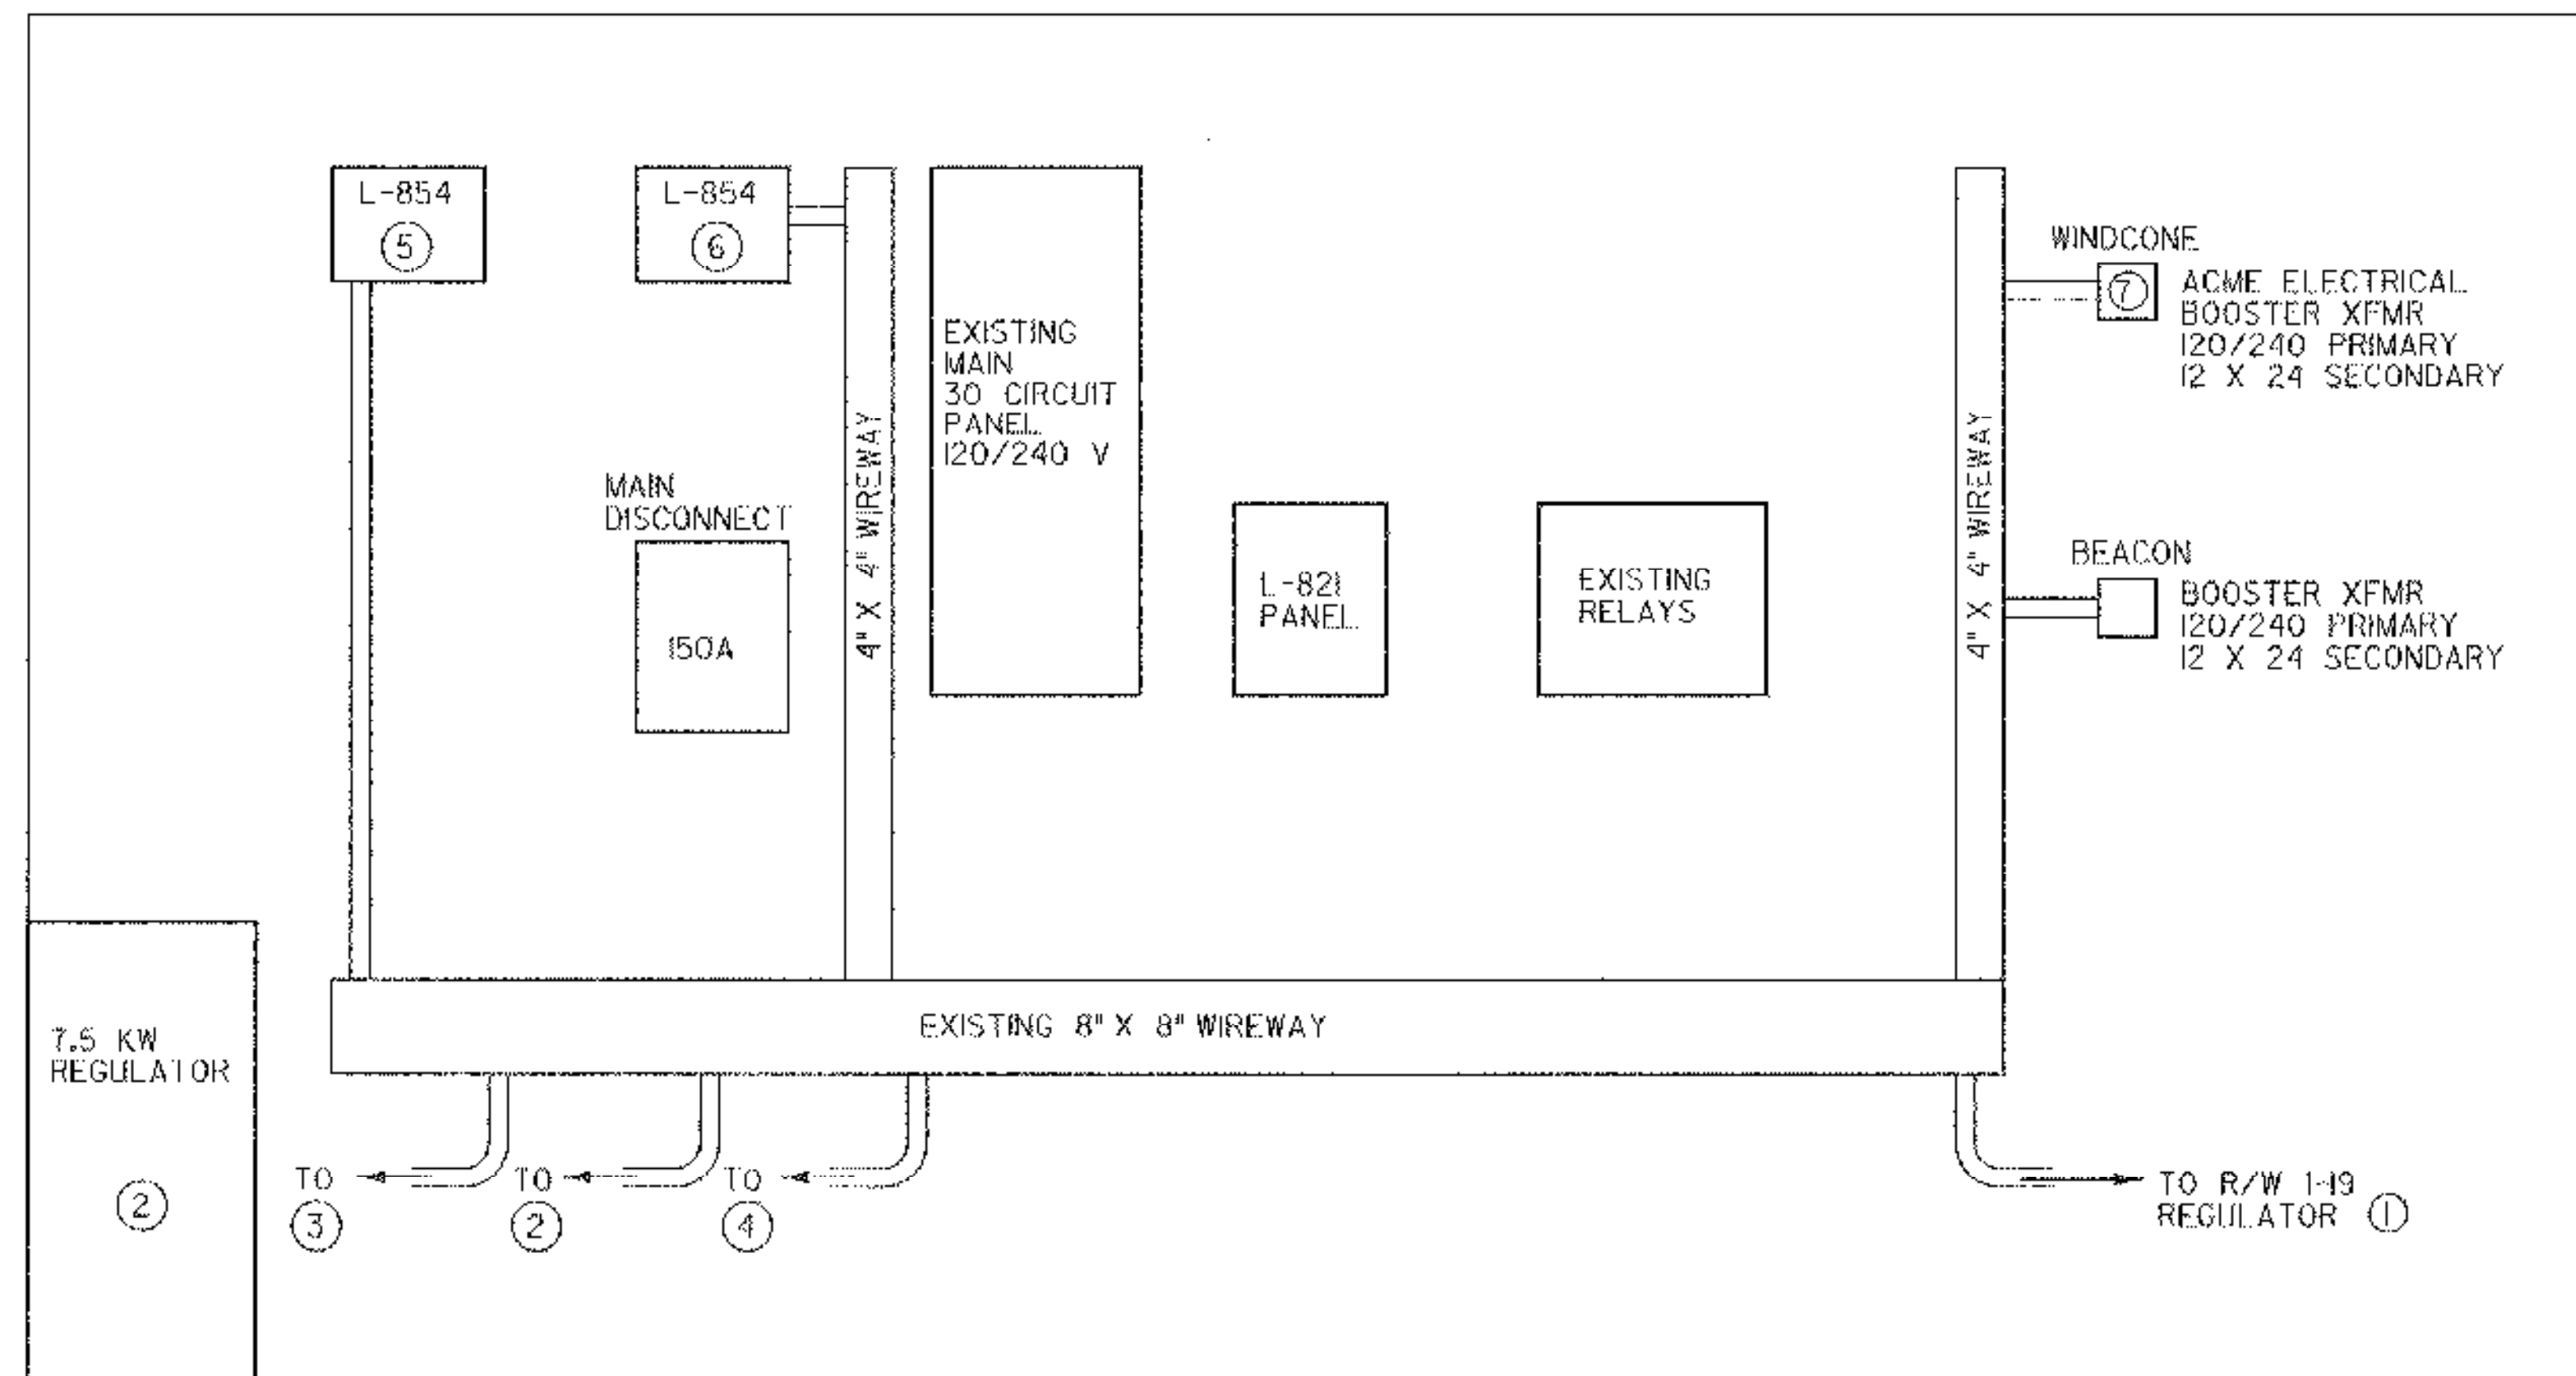


SECTION C-C EXISTING VAULT WALL ELEVATION
N.T.S.

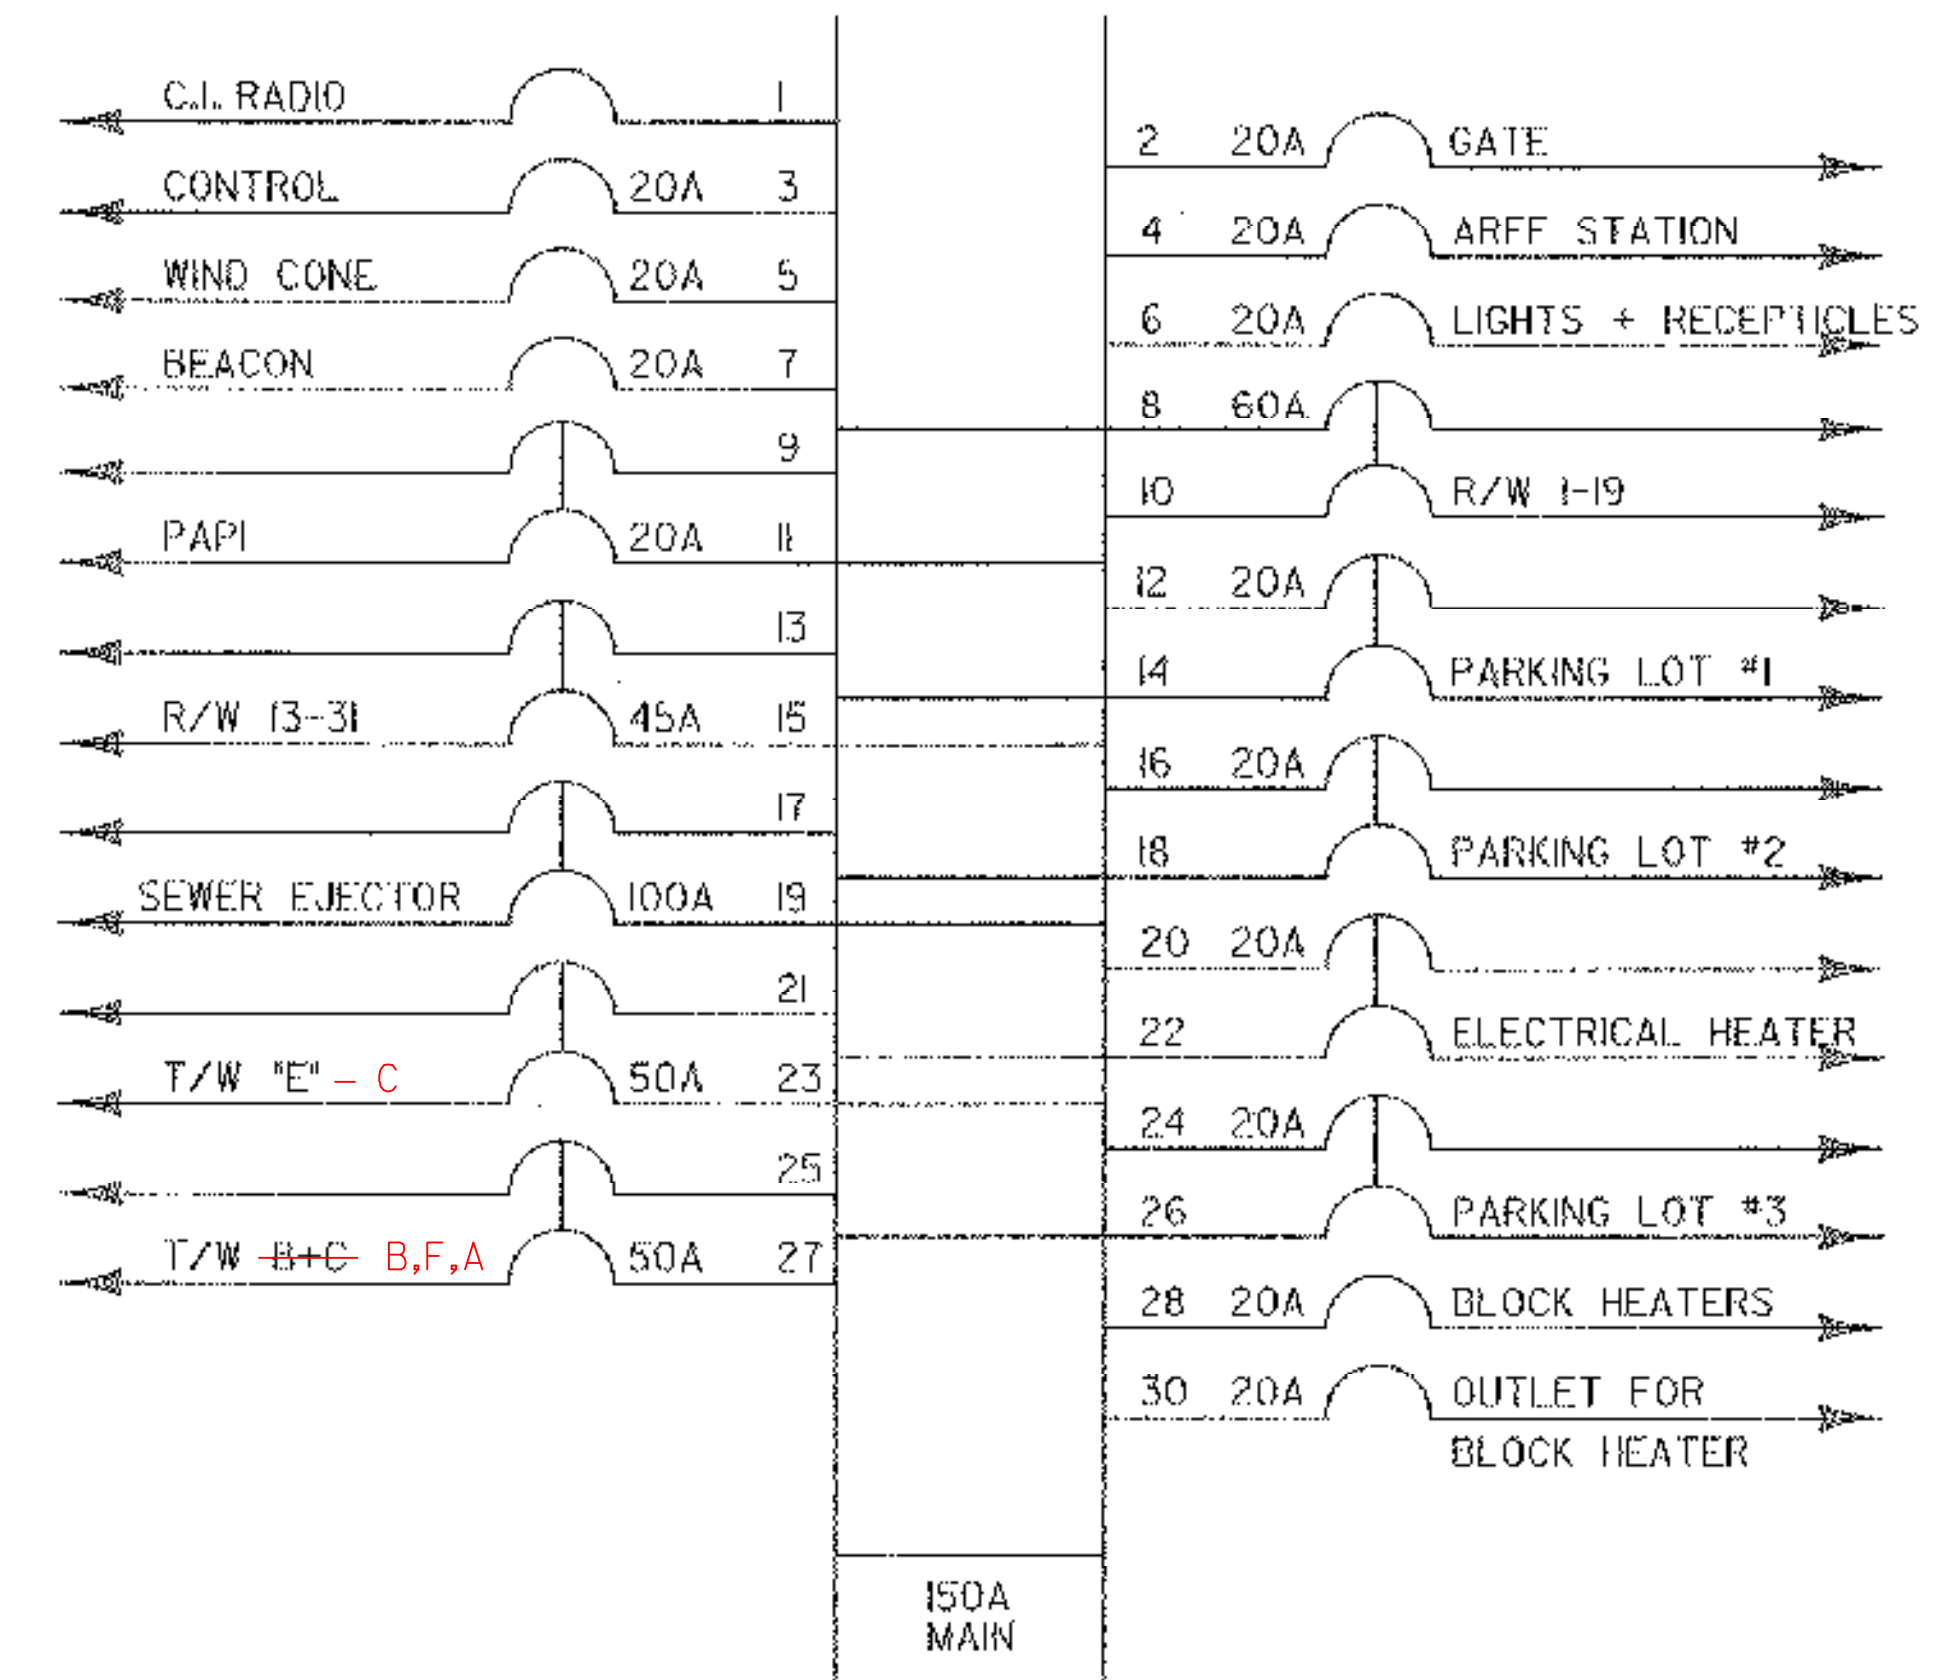


EXISTING MAIN PANEL
N.T.S.

EQUIPMENT SCHEDULE


- ① L-828, 10KW, 6.6 AMP (240V) REGULATOR MANAIRO (RUNWAY 1-19); EXISTING TO REMAIN
- ② L-828 7.5 KV, 6.6 AMP (240 V) HEVY DUTY REGULATOR (RUNWAY 13-31); EXISTING TO REMAIN
- ③ L-828, 7.5 KV, 6.6 AMP (240 V) ADB-ALNACO REGULATOR (TAXIWAY "E"); EXISTING TO REMAIN
- ④ L-828, 7.5 KV, 6.6 AMP (240 V) ADB-ALNACO REGULATOR (TAXIWAYS B+C) REMOVE EXISTING, REPLACE WITH NEW L-828, 7.5 KW REGULATOR FOR TAXIWAYS A & F
- ⑤ L-854, RADIO CONTROLLER [RUNWAY 1-19 ONLY - CONTROL INDUSTRIES] EXISTING TO REMAIN
- ⑥ L-854 RADIO CONTROLLER [GODFREY ENGINEERING RUNWAY 13-31 & TAXIWAY] EXISTING TO REMAIN
- ⑦ EXISTING BOOSTER TRANSFORMER TO BE REMOVED

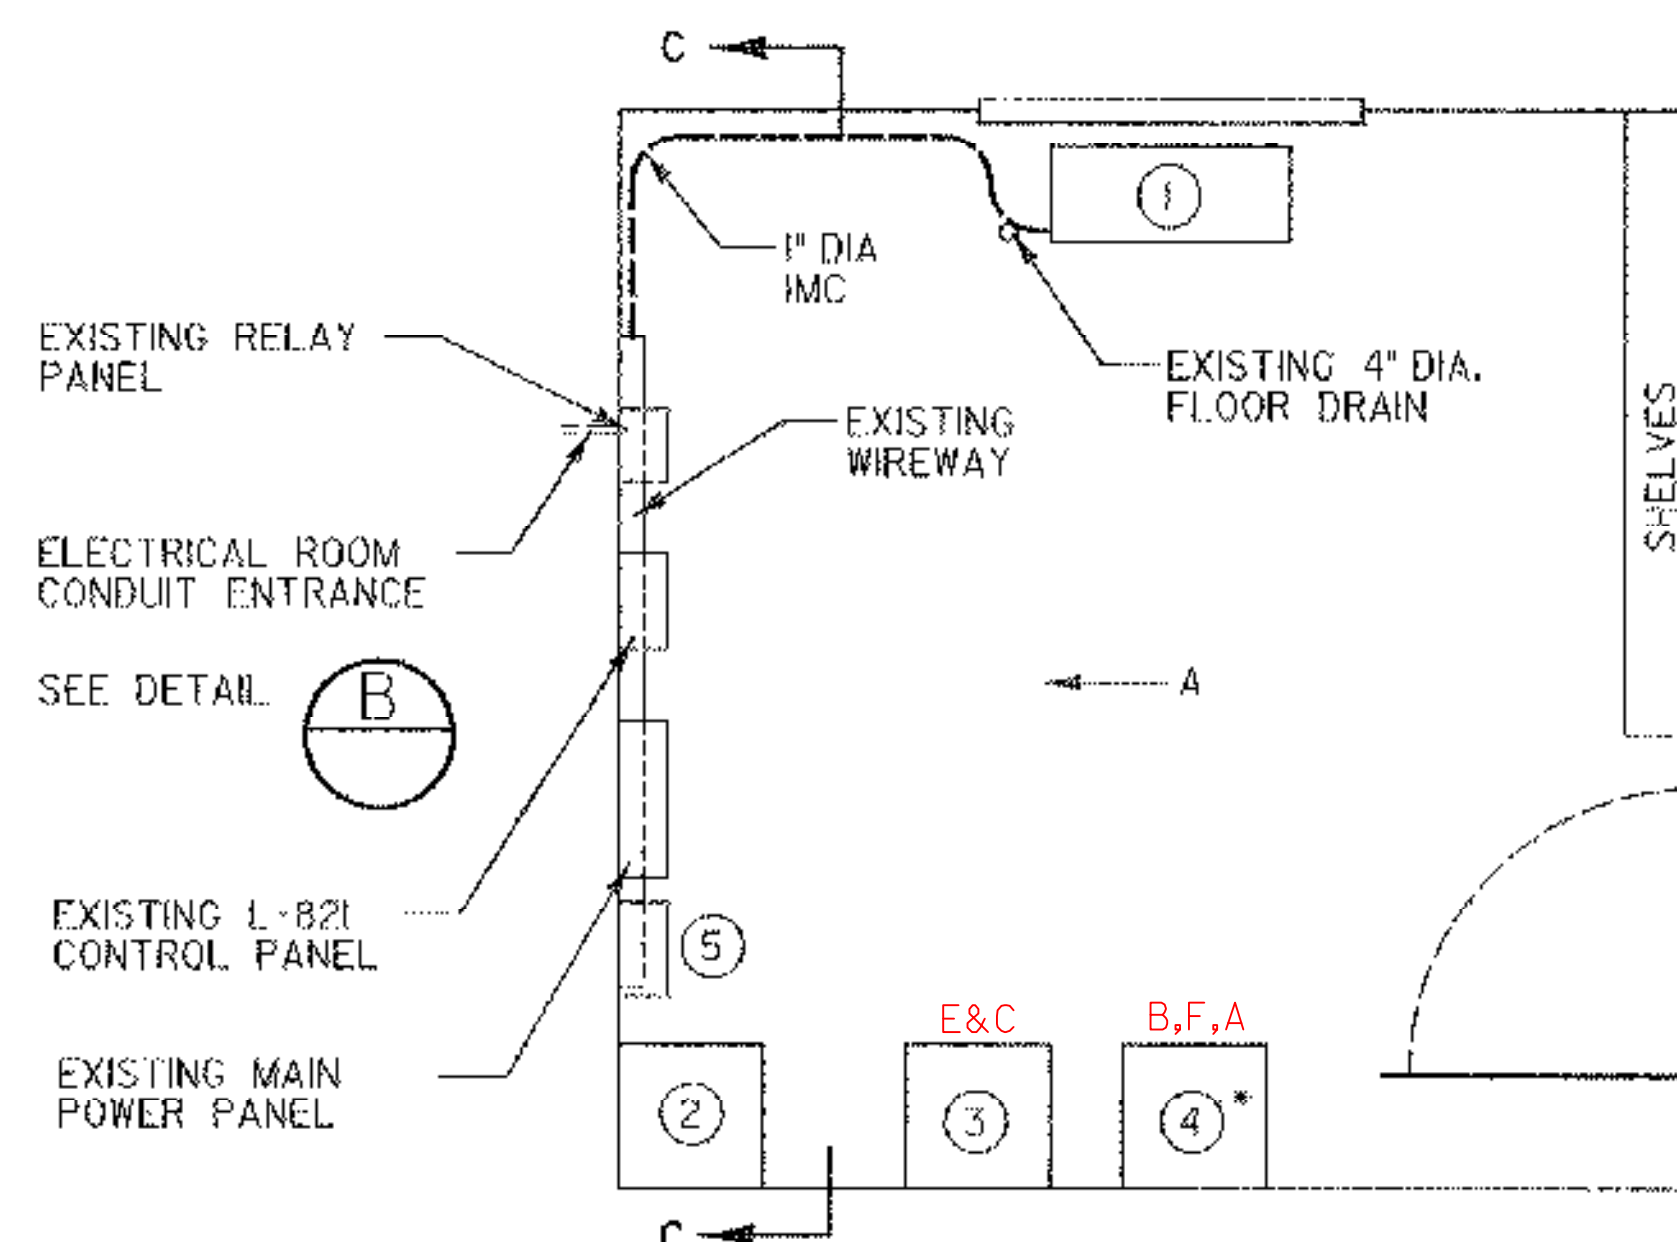

A ELECTRICAL VAULT LAYOUT
N.T.S.

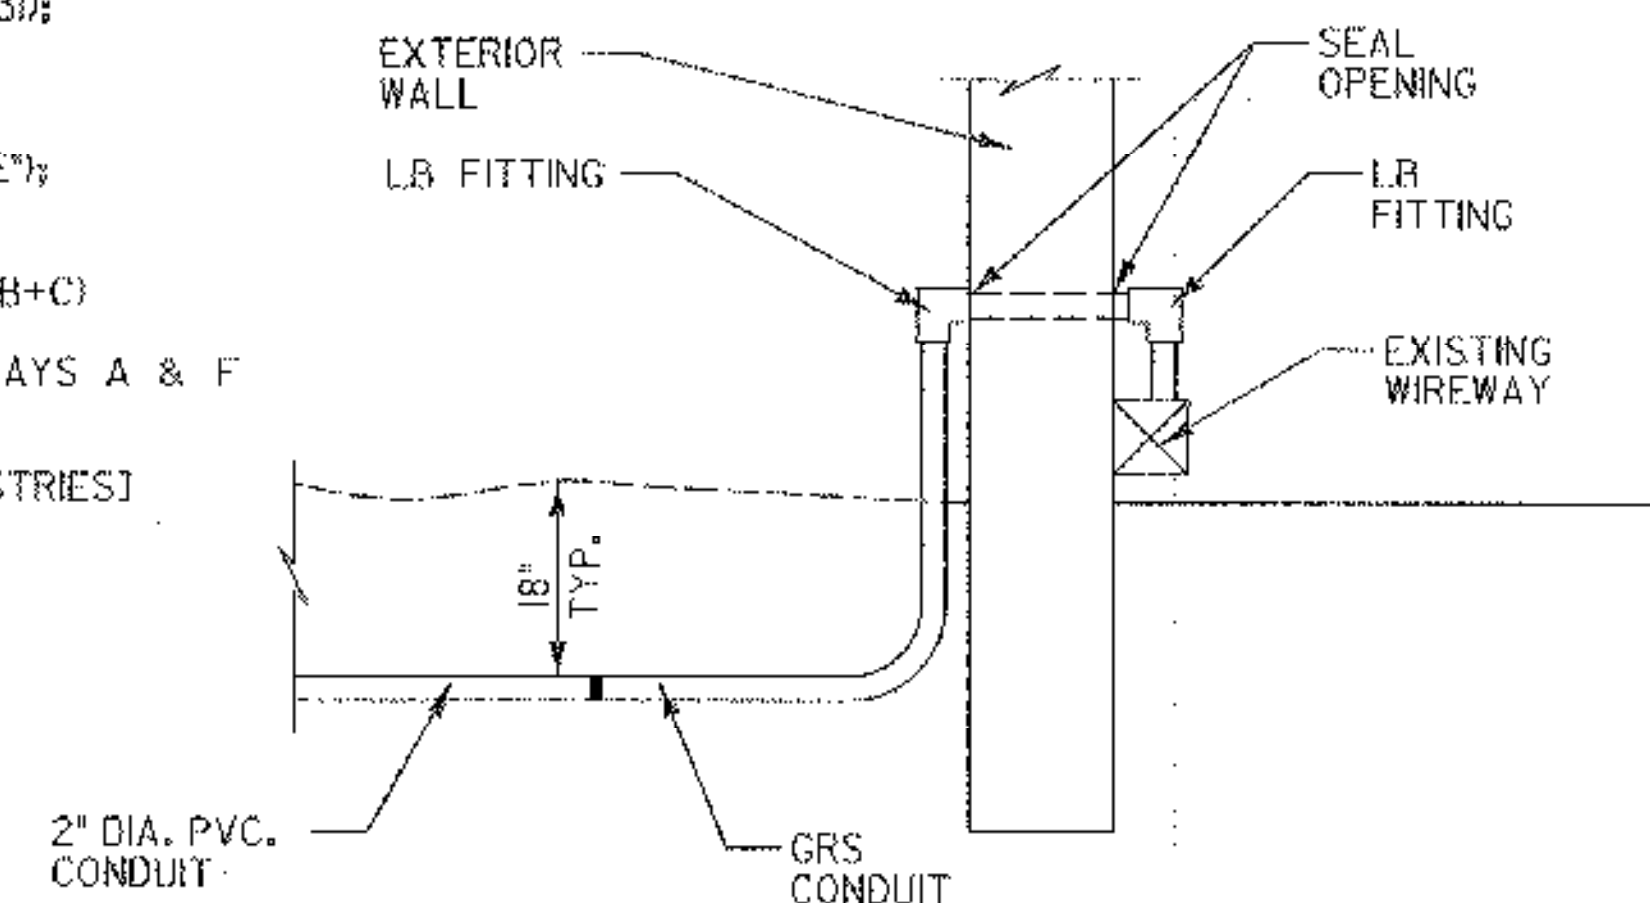

B EXISTING ELECTRICAL ROOM CONDUIT ENTRANCE
N.T.S.

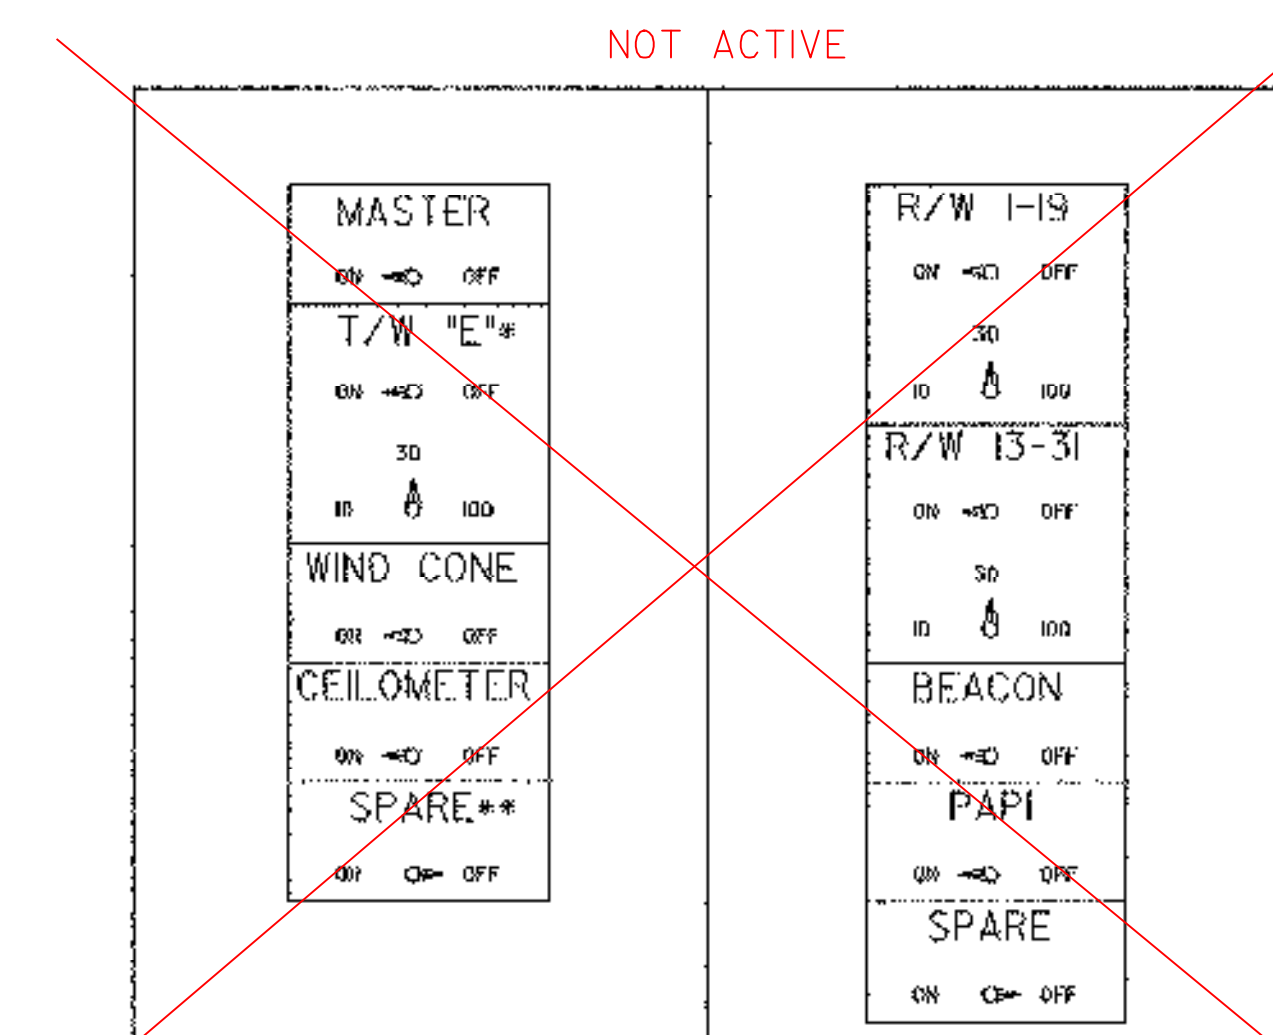

*REVISE BAKELITE LABEL TO READ: T/W "E" AND T/W "C"
**INSTALL NEW BAKELITE LABEL TO READ T/W "A" AND T/W "F"

EXISTING L-821 PANEL
N.T.S.



REV.	DATE	DESCRIPTION

Job No. F200002046.00
File No. F200016000227

RUTLAND STATE AIRPORT
CLARENDON, VERMONT


TAXIWAY IMPROVEMENTS
VAULT WIRING DETAILS

URS
1 NORTHWAY LN.
LATHAM, NEW YORK


Designed by: G.M.D.
Drawn by: M.C.M.
Checked by: L.J.M.
Approved by: G.M.D.

Scale: NONE
Date: FEB., 2003
Sheet 21 OF 40
Sheet No. **27**


B-3
T/W G 311+60+/-
CL

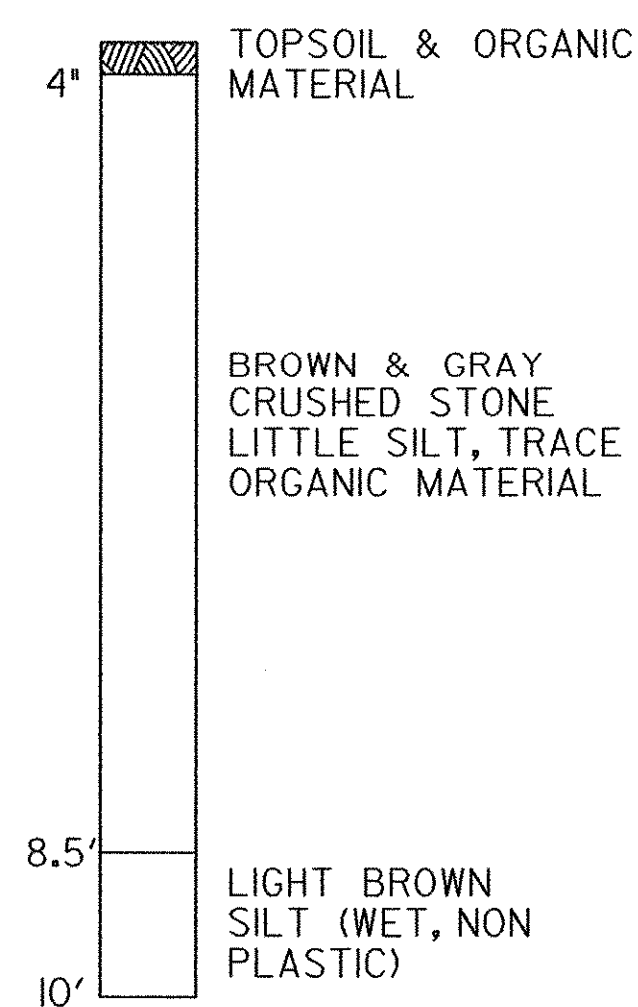


B-4
T/W G 312+60+/-
CL

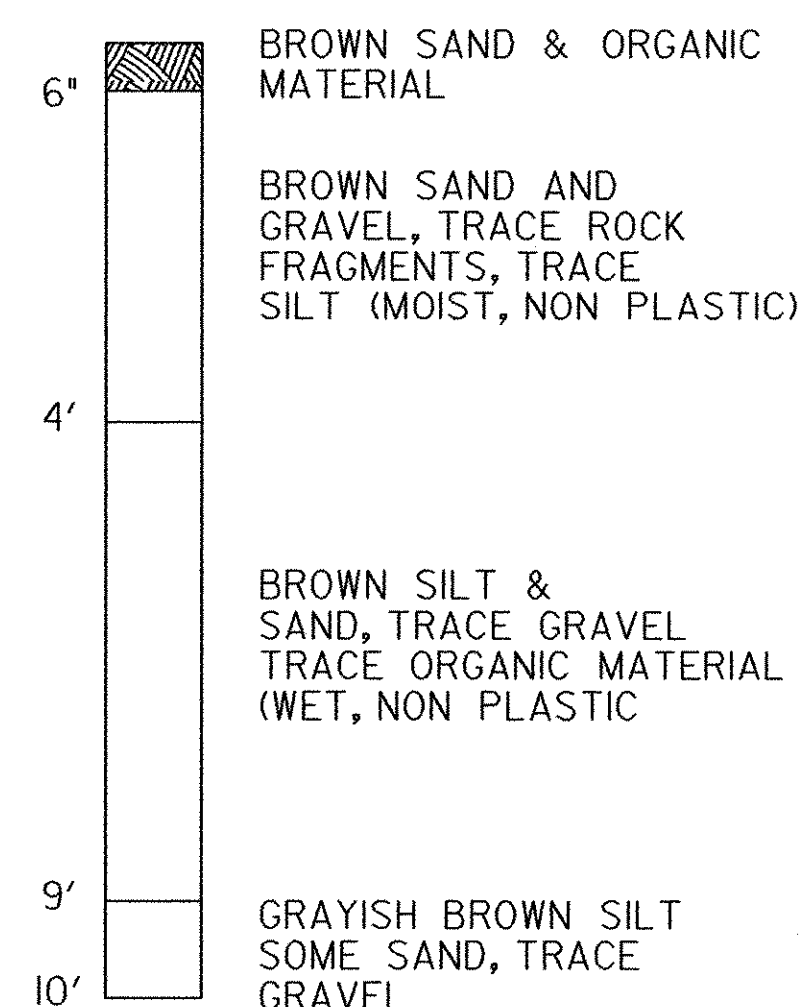


B-6
35+00
CL

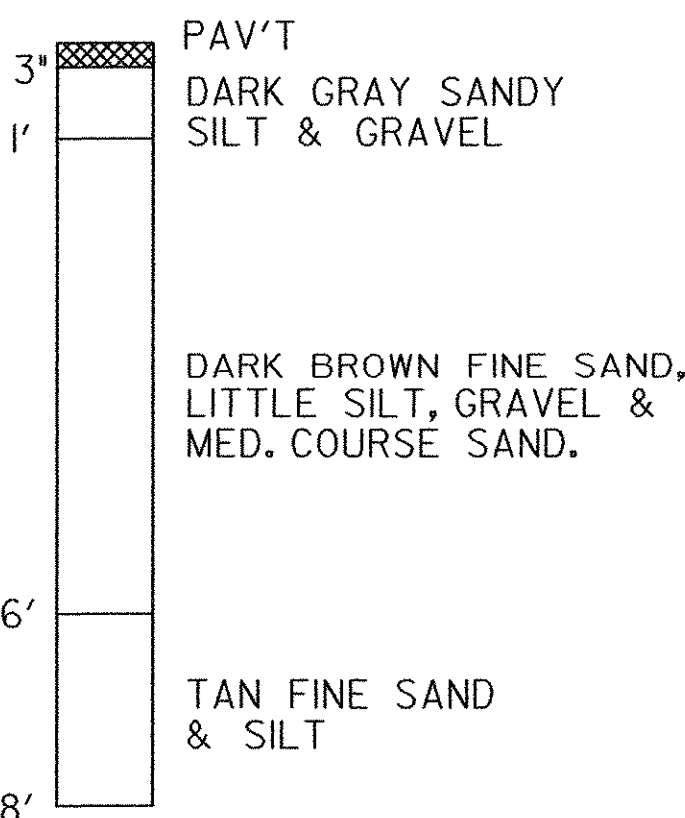


B-9
25' LT.
25+00

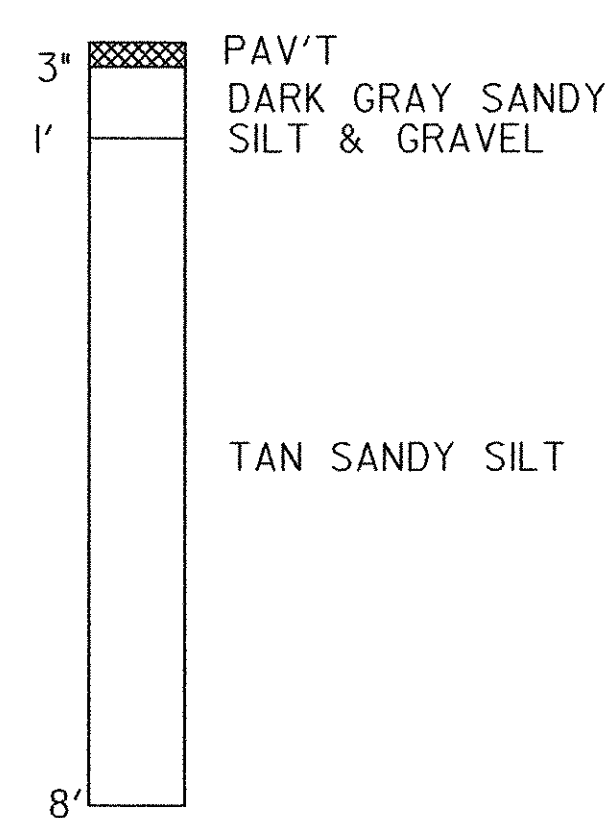


B-12
20' LT.
17+00

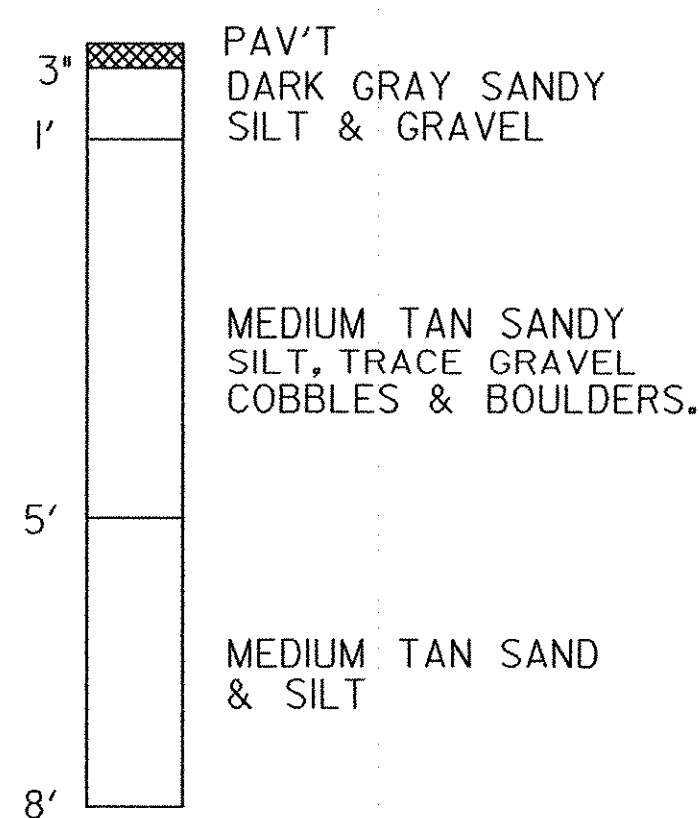


B-40
30' LT.
114+00

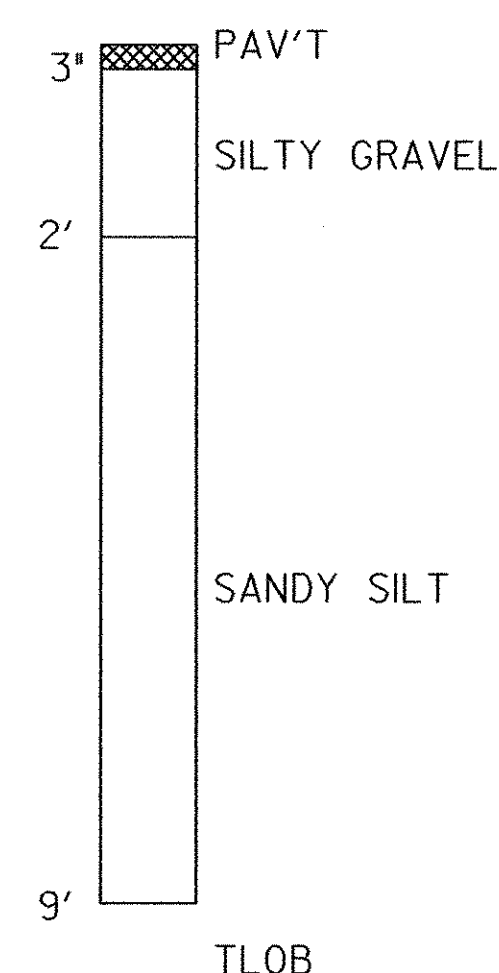

B-60A
100' +/- LT.
417+00

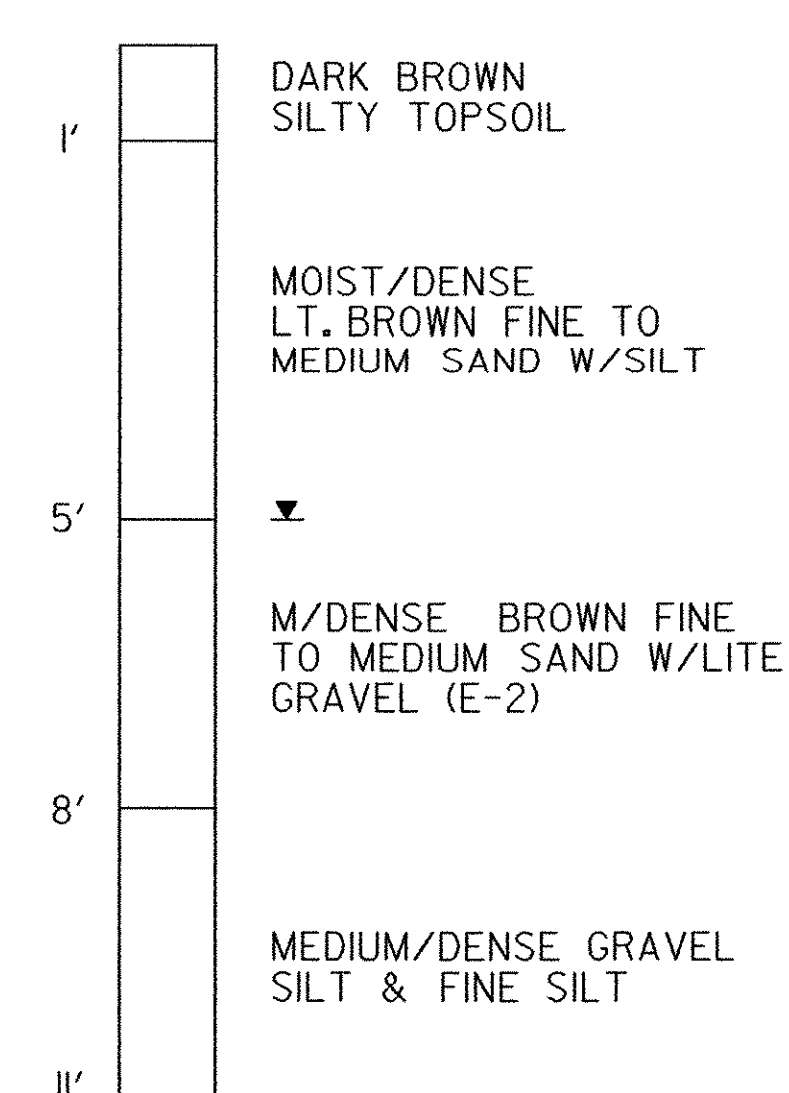

B-70
95' LT.
418+80 +/-

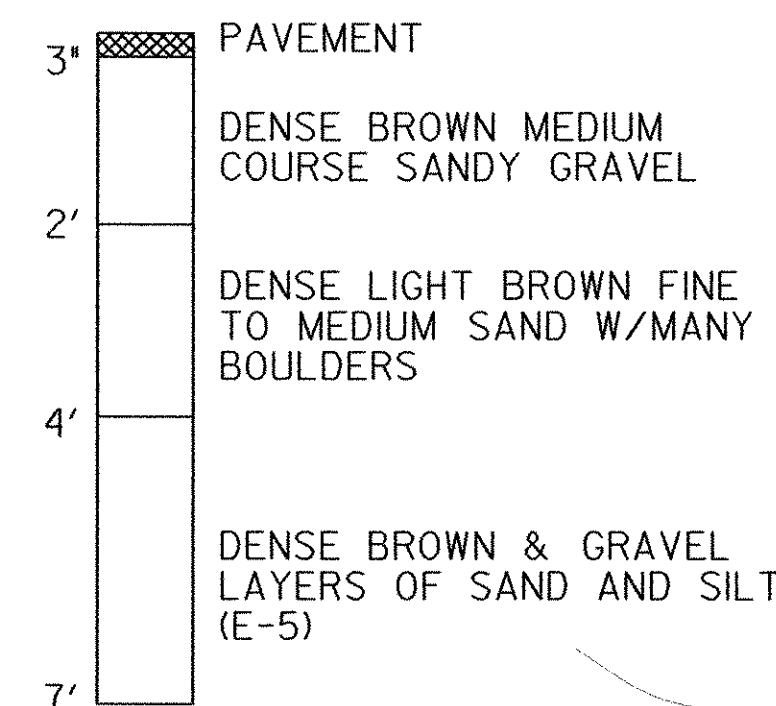


LEGEND:


D	N	V	
			PAVEMENT AND SOIL DESCRIPTION

- N - BLOWS PER 6-INCH INCREMENTS OF PENETRATION OF SAMPLING SPOON OR PENETRATION IN INCHES FOR THE INDICATED BLOWS OF A 140 LB. HAMMER FALLING 30".
- V - SYMBOLS INDICATE EXTENT OF SOIL LAYERS
- D - DEPTHS

B-10
220' RT.
G' 315+55

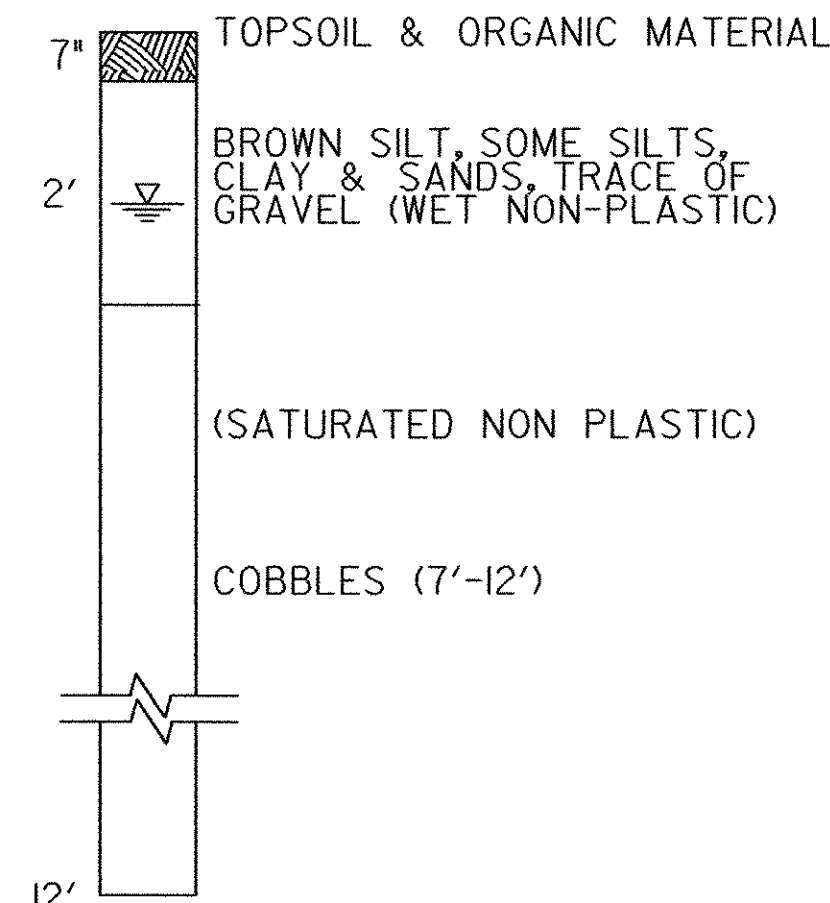


B-11
380' RT.
G' 316+10

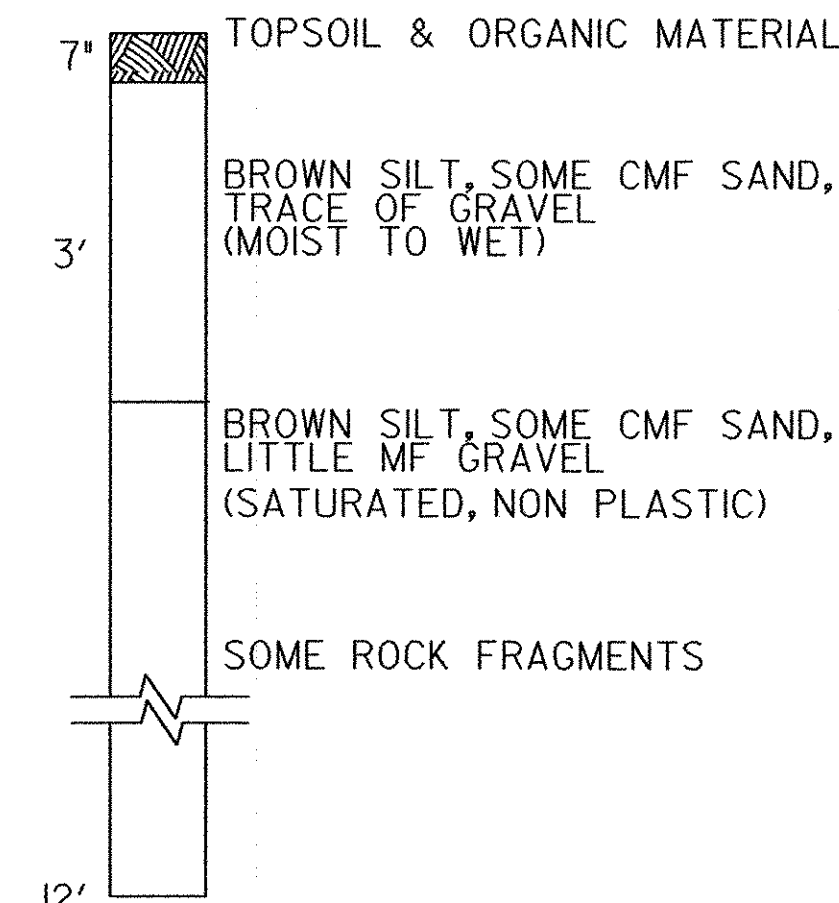

NOTES:


- BORINGS #B-3, #B-4, #B10 & #B11 WERE REPORTED ON PLANS FOR PROPOSED IMPROVEMENTS, BY McFARLAND-JOHNSON, DATED JANUARY, 2001.
- BORINGS #B-6, B-9, B-12 WERE REPORTED ON PLANS FOR AIP 3-50-0015-04, BY DUFRESNE-HENRY, Inc., DATED JULY, 1985.
- BORING #B-40 WAS REPORTED ON PLANS FOR ADAP 8-50-0015-03 BY DUFRESNE-HENRY, Inc., DATED AUGUST, 1973.
- BORINGS #B-60 & B-70 WERE REPORTED ON PLANS FOR ADAP 6-50-0015-06 BY DUFRESNE-HENRY, Inc., DATED SEPTEMBER, 1977.
- BORINGS #B-60 & B-70 WERE REPORTED ON PLANS FOR ADAP 6-50-0015-06 BY DUFRESNE-HENRY, Inc., DATED SEPTEMBER, 1977.

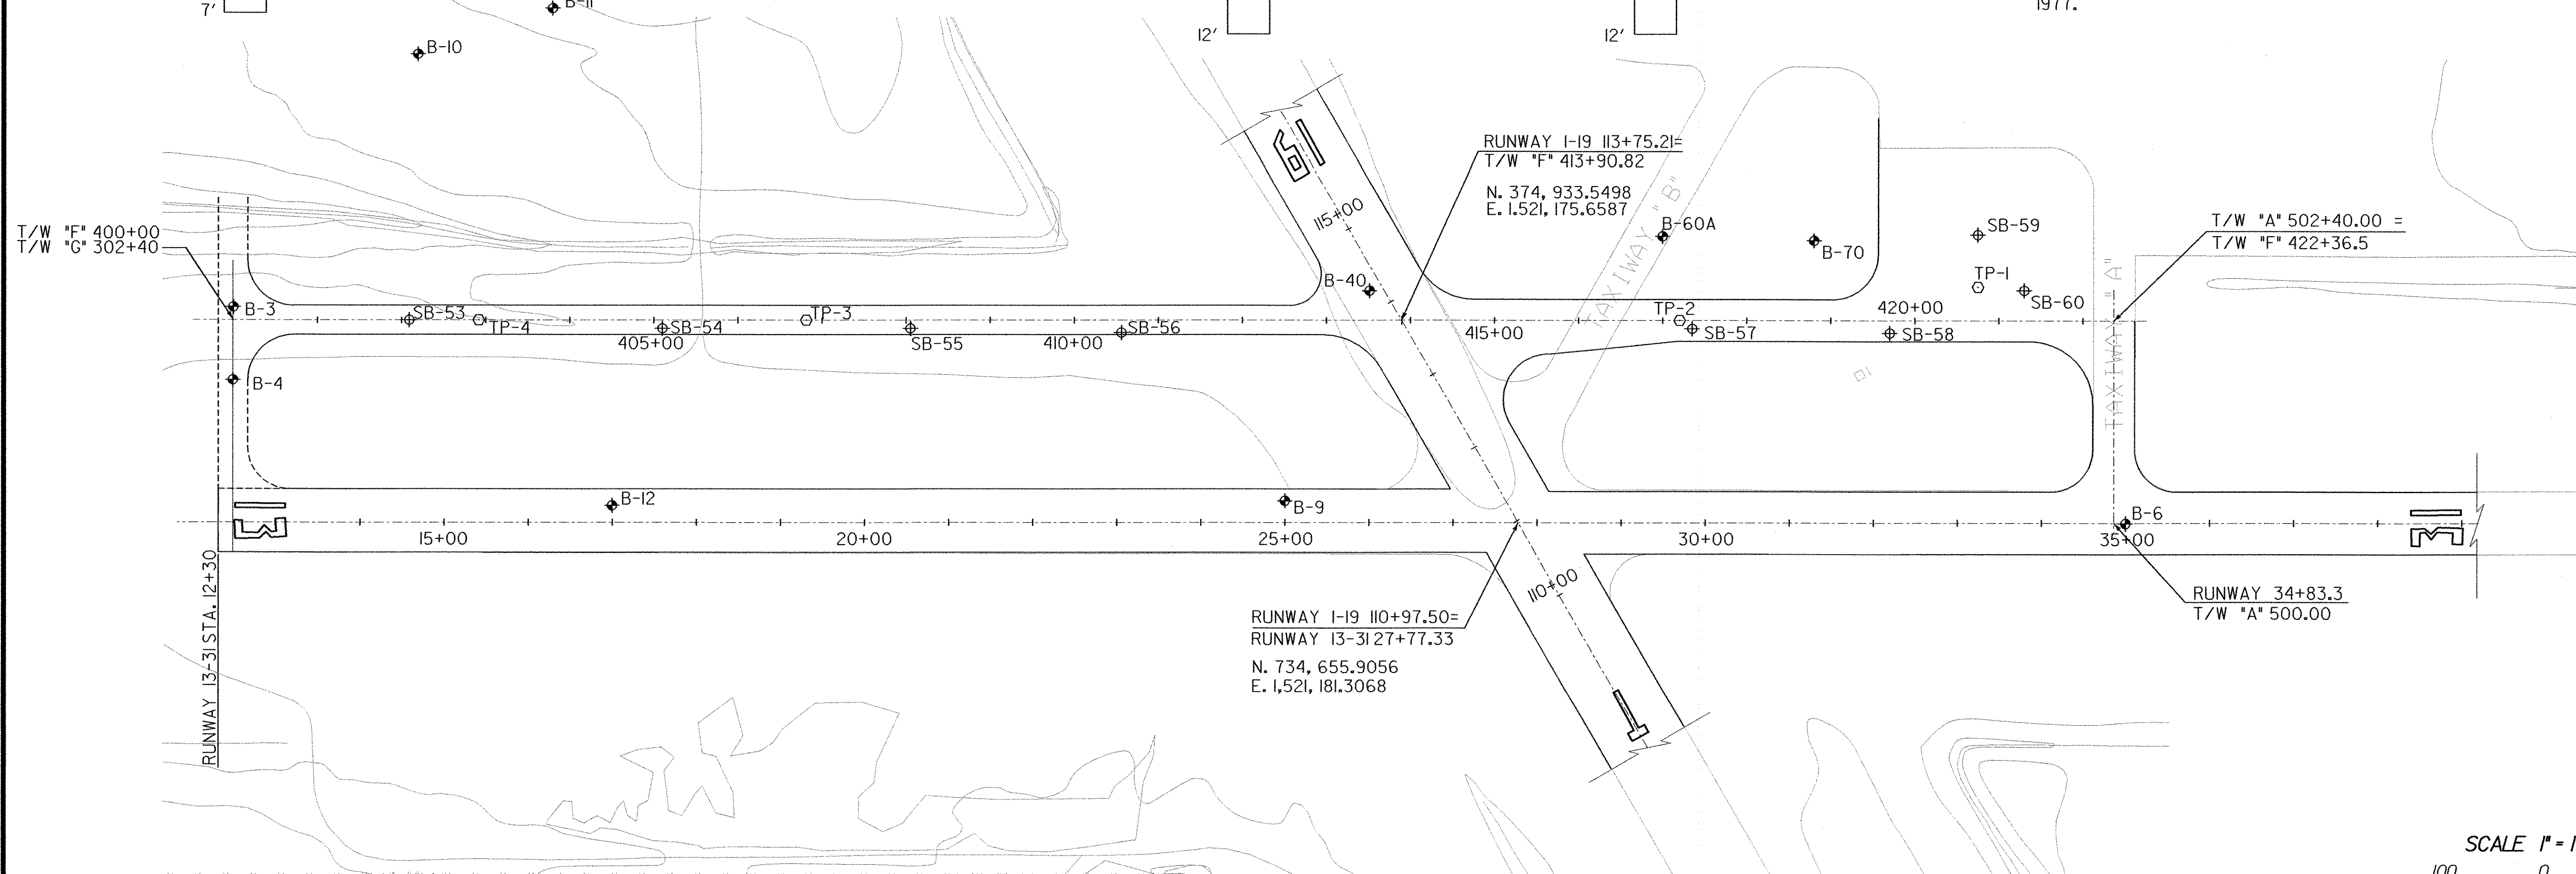

SCALE 1" = 100'

100 0 100

A.I.P. 3-50-0015-17

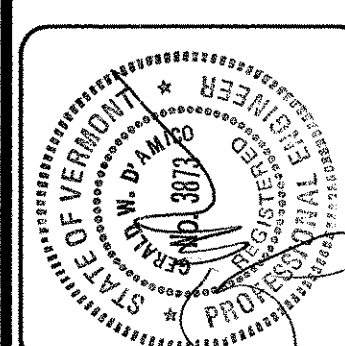

REV.	DATE	DESCRIPTION

RUTLAND STATE AIRPORT
CLARENDON, VERMONT

TAXIWAY IMPROVEMENTS
BORING LOGS

URS
1 NORTHWAY LN.
LATHAM, NEW YORK


Designed by: G.M.D.
Drawn by: M.C.M.
Checked by: G.M.D.
Approved by: F.J.A.

Scale: 1"=100'

Date: FEB., 2003



Sheet 28 OF 40

Sheet No
28

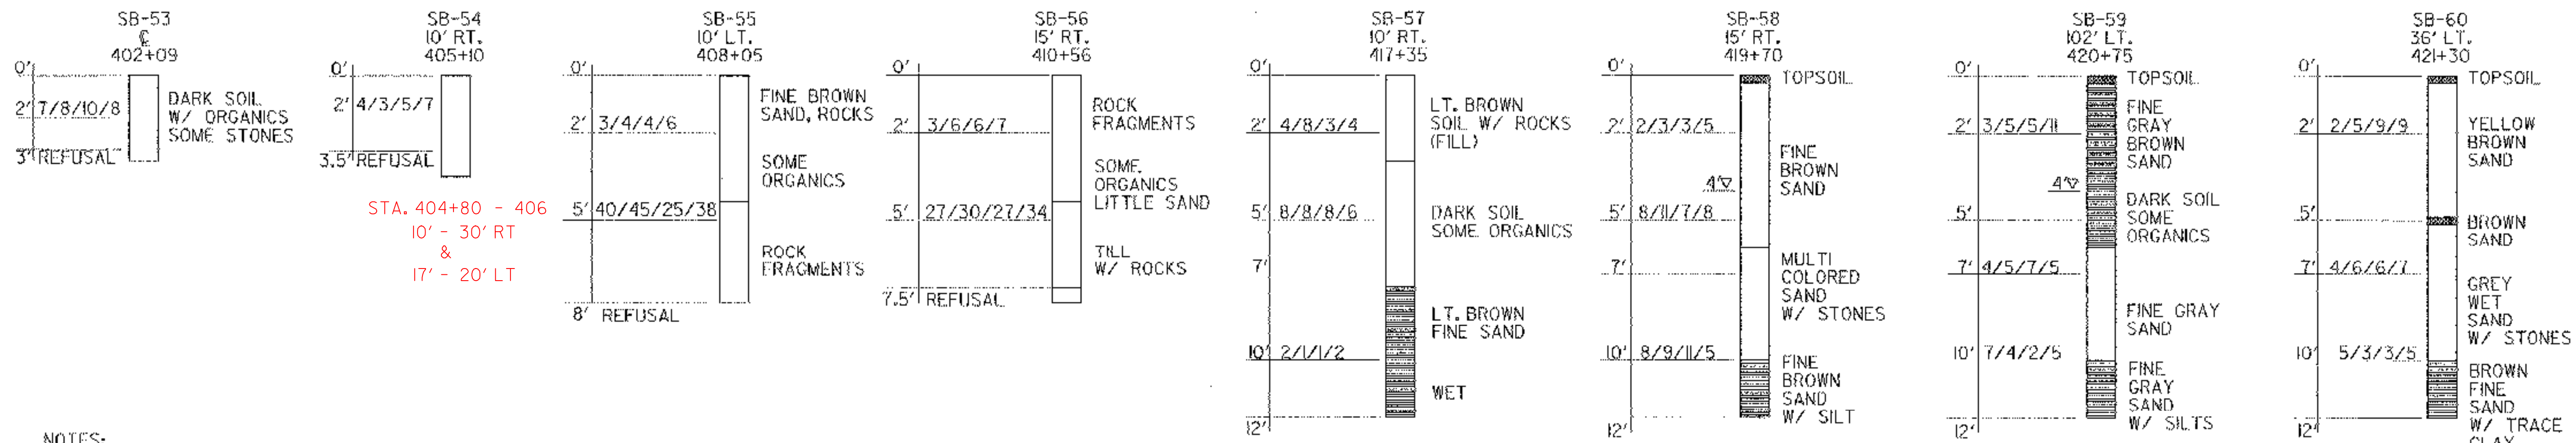


NOTES:

1. BORINGS SB-53, 54, 55, 56, 57, 58, 59 & 60 WERE TAKEN 23, APRIL 2001 BY GREEN MOUNTAIN BORINGS. TEST PITS #1, #2, #3, & #4 WERE SAMPLED 23, APRIL 2001, BY ATC.

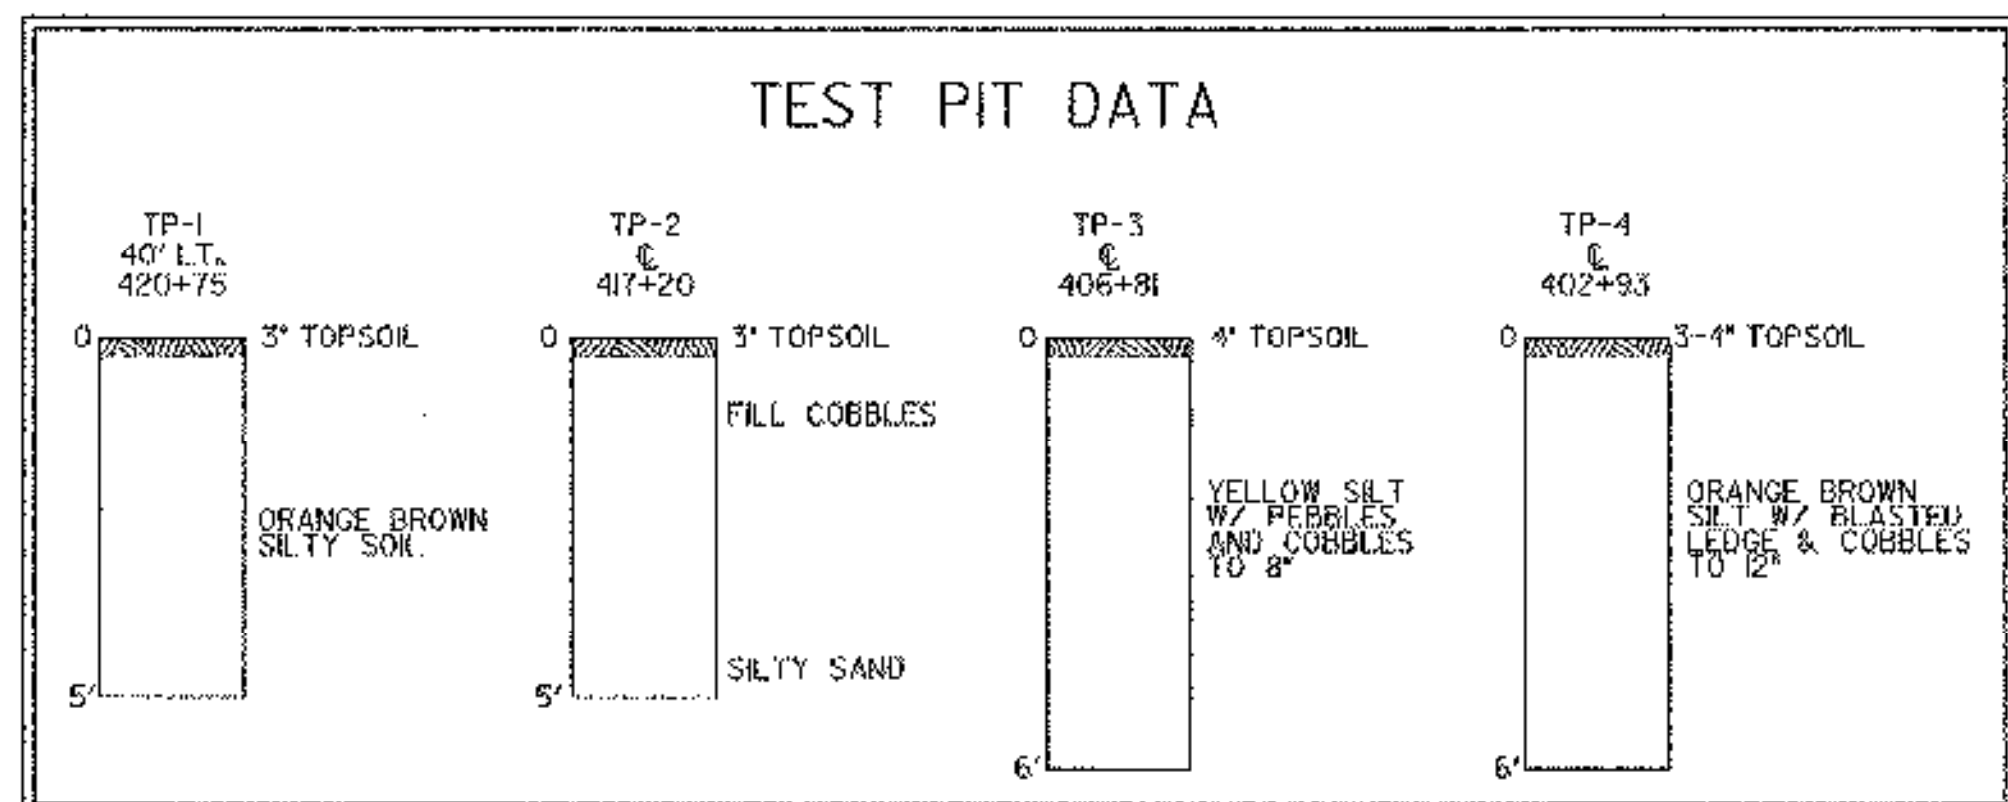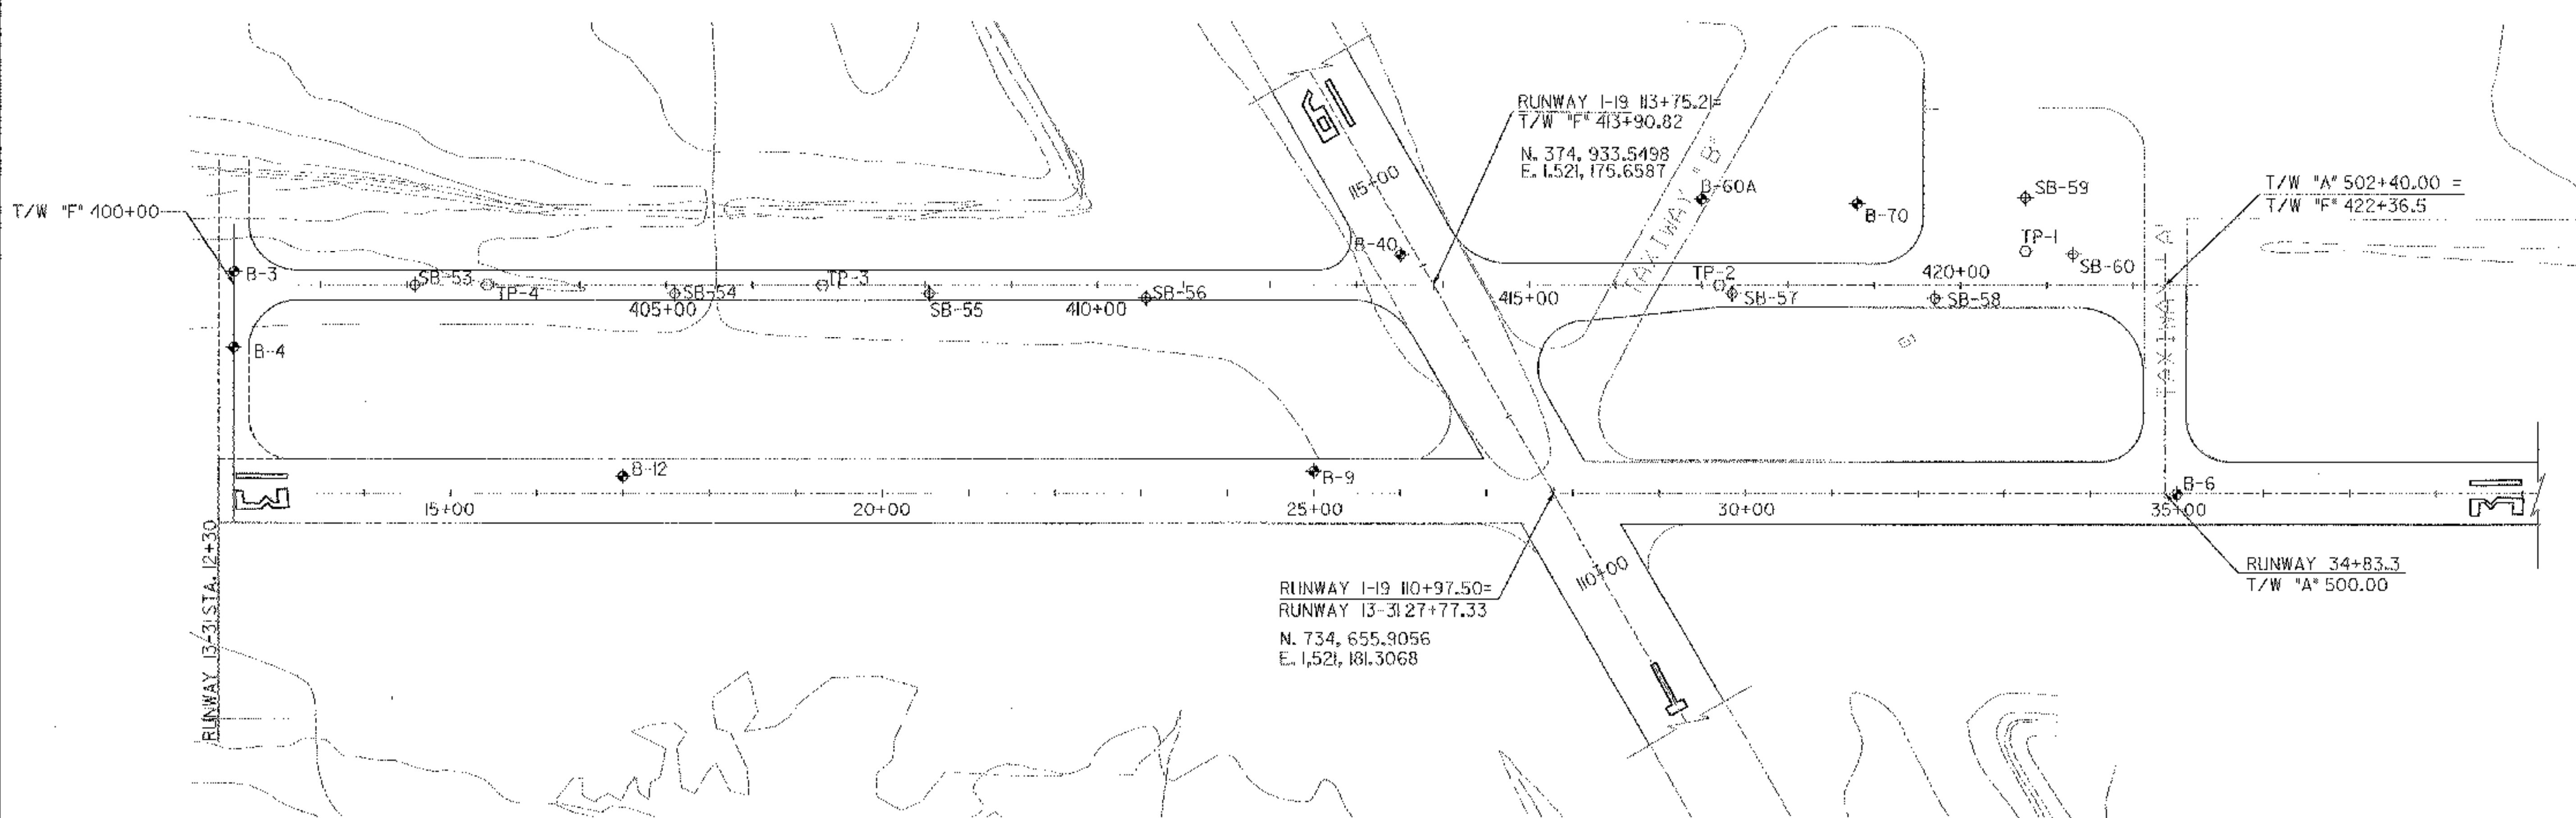

LEGEND:

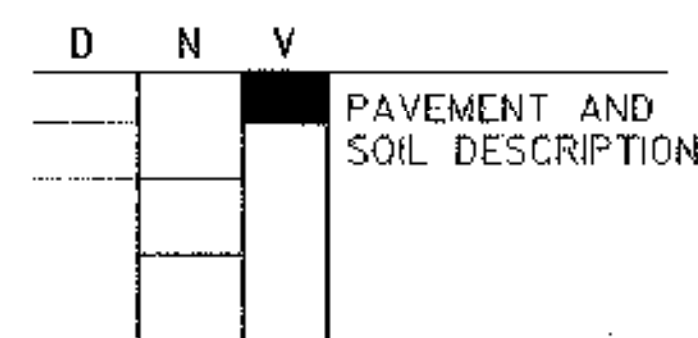

N - BLOWS PER 6-INCH INCREMENTS OF PENETRATION OF SAMPLING SPOON OR PENETRATION IN INCHES FOR THE INDICATED BLOWS OF A 140 LB. HAMMER FALLING 30".

V - SYMBOLS INDICATE EXTENT OF SOIL LAYERS

D - DEPTHS



URS
1 NORTHWAY LN.
LATHAM, NEW YORK

Designed by: G.W.D.

Drawn by: M.C.M.

Checked by: G.W.D.

Approved by: F.J.A.

Scale: 1"=100'

Date: FEB., 2003

Sheet 29 OF 40

Sheet No. **29**

RUTLAND STATE AIRPORT
CLARENDON, VERMONT










TAXIWAY IMPROVEMENTS
BORING LOGS

REV. DATE


DESCRIPTION

File No. F20030400039

Job No. F200002046.00

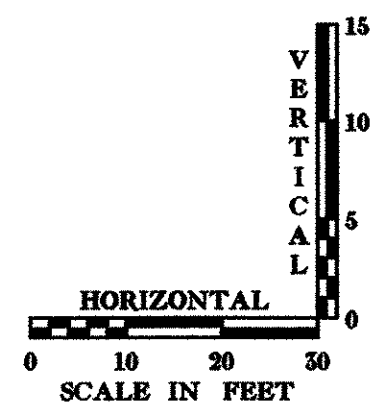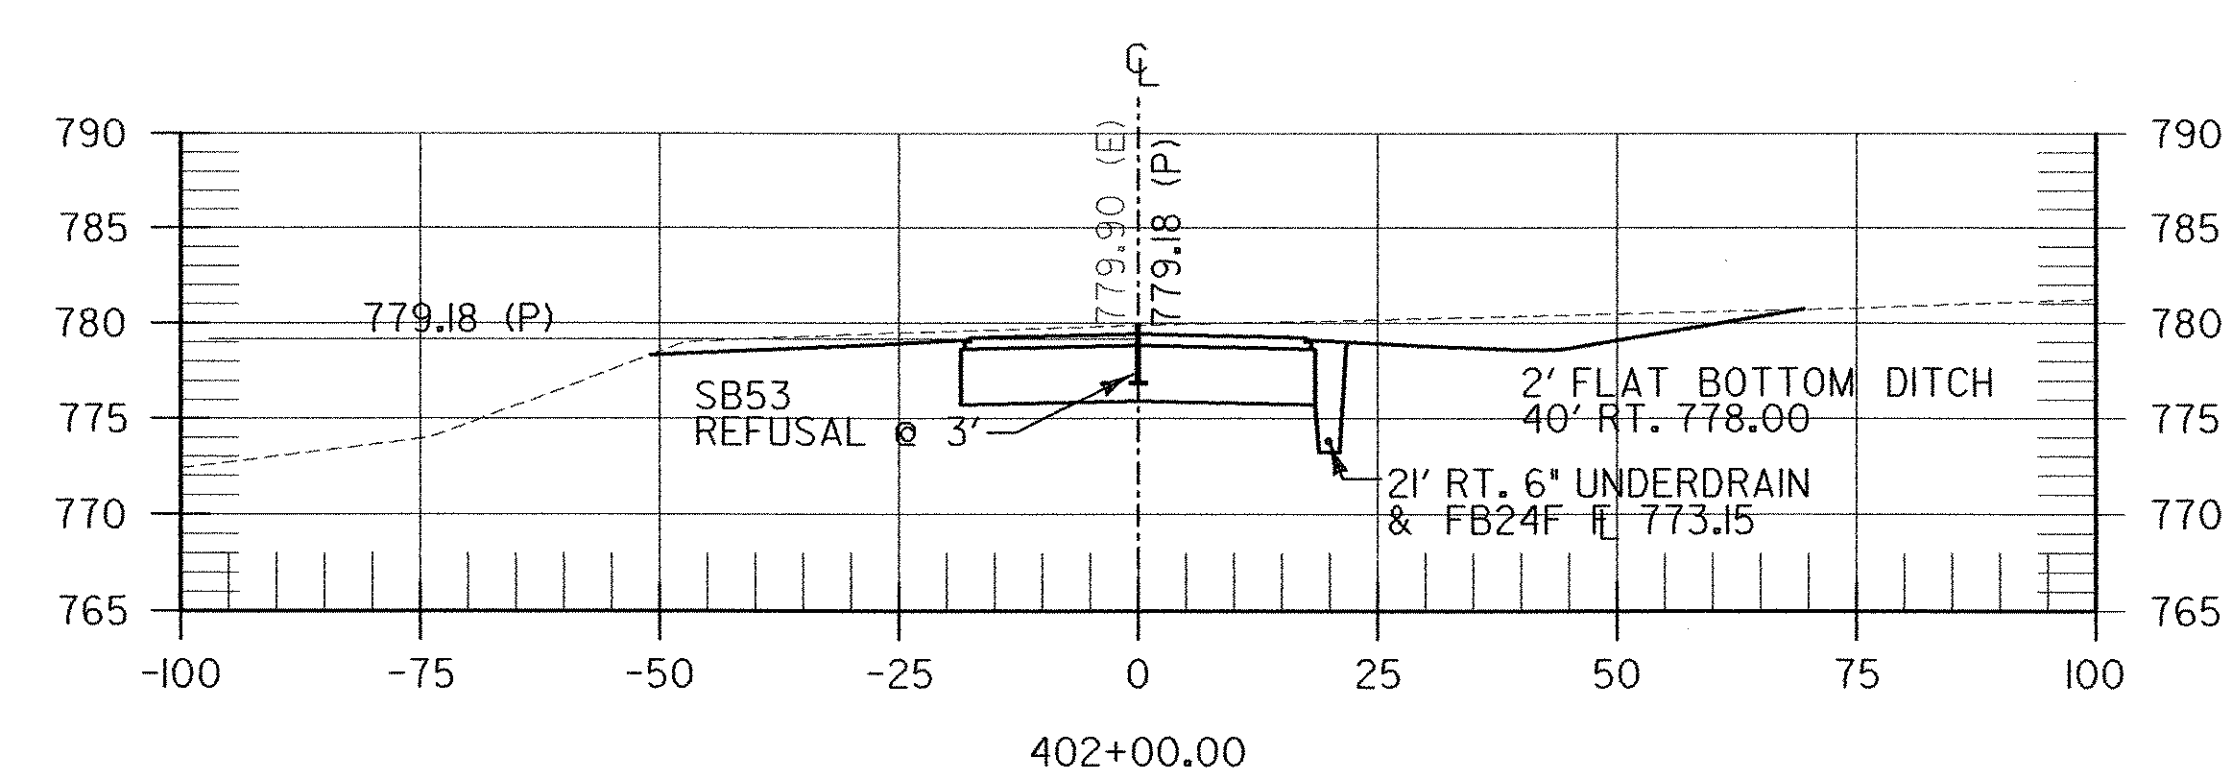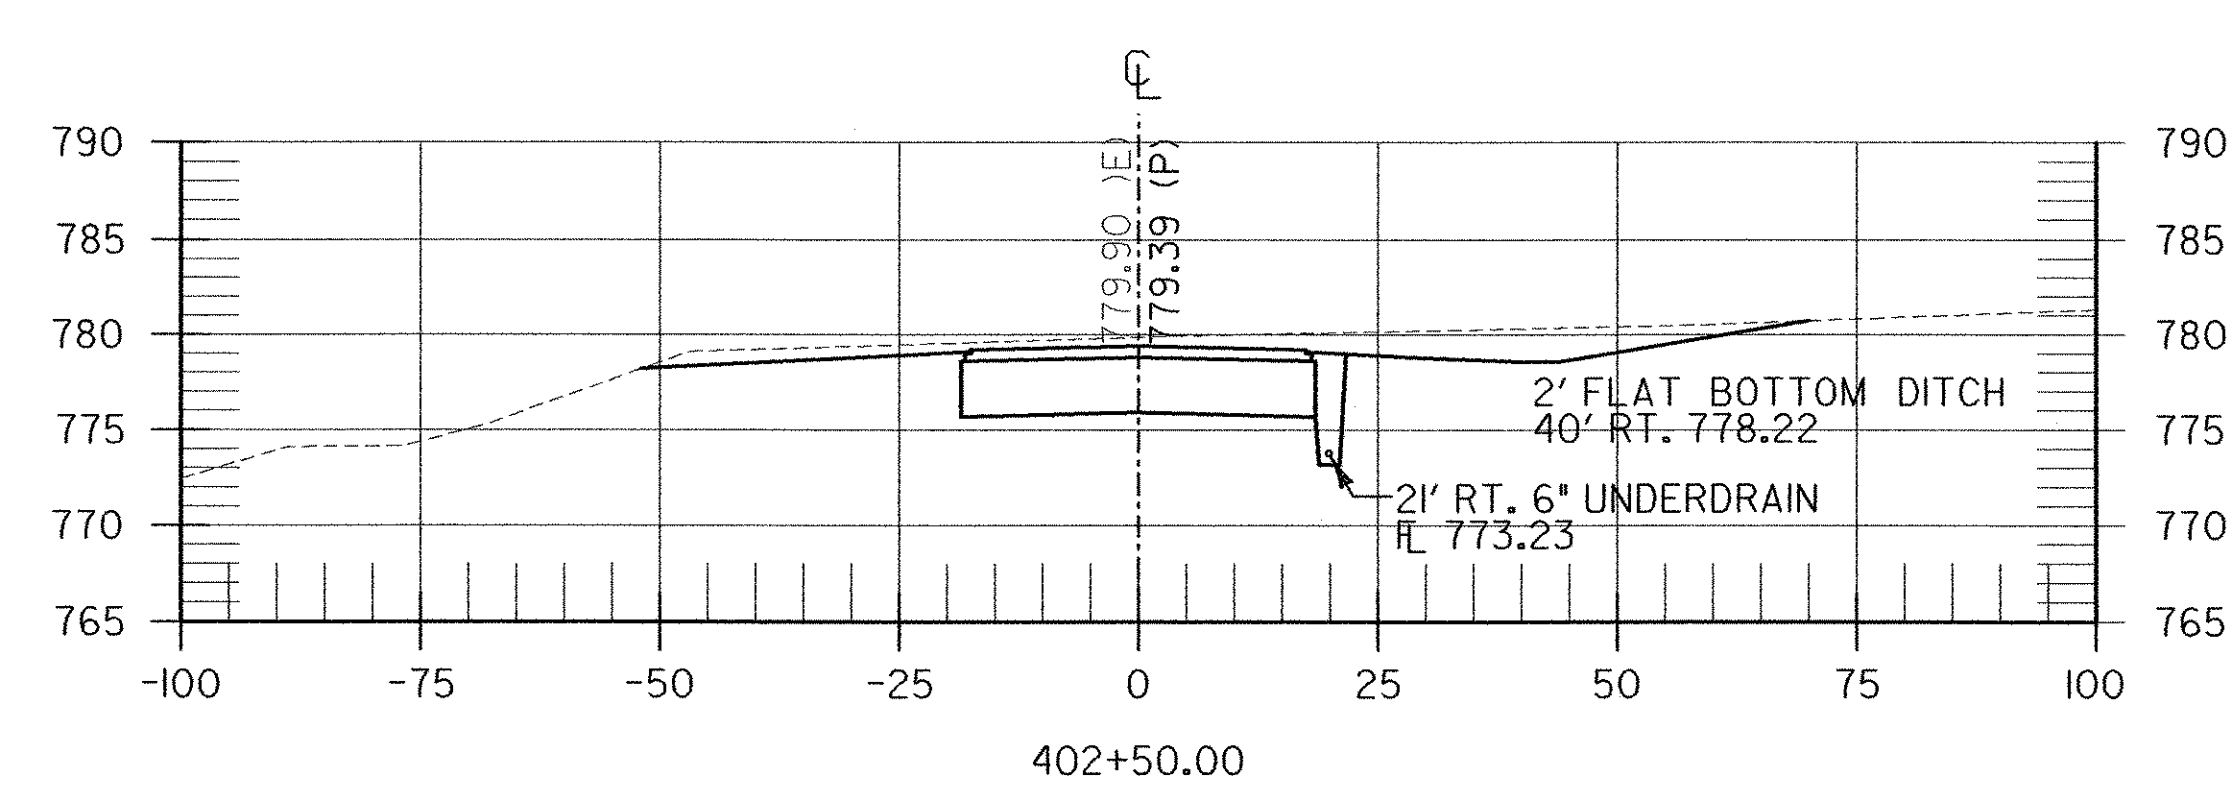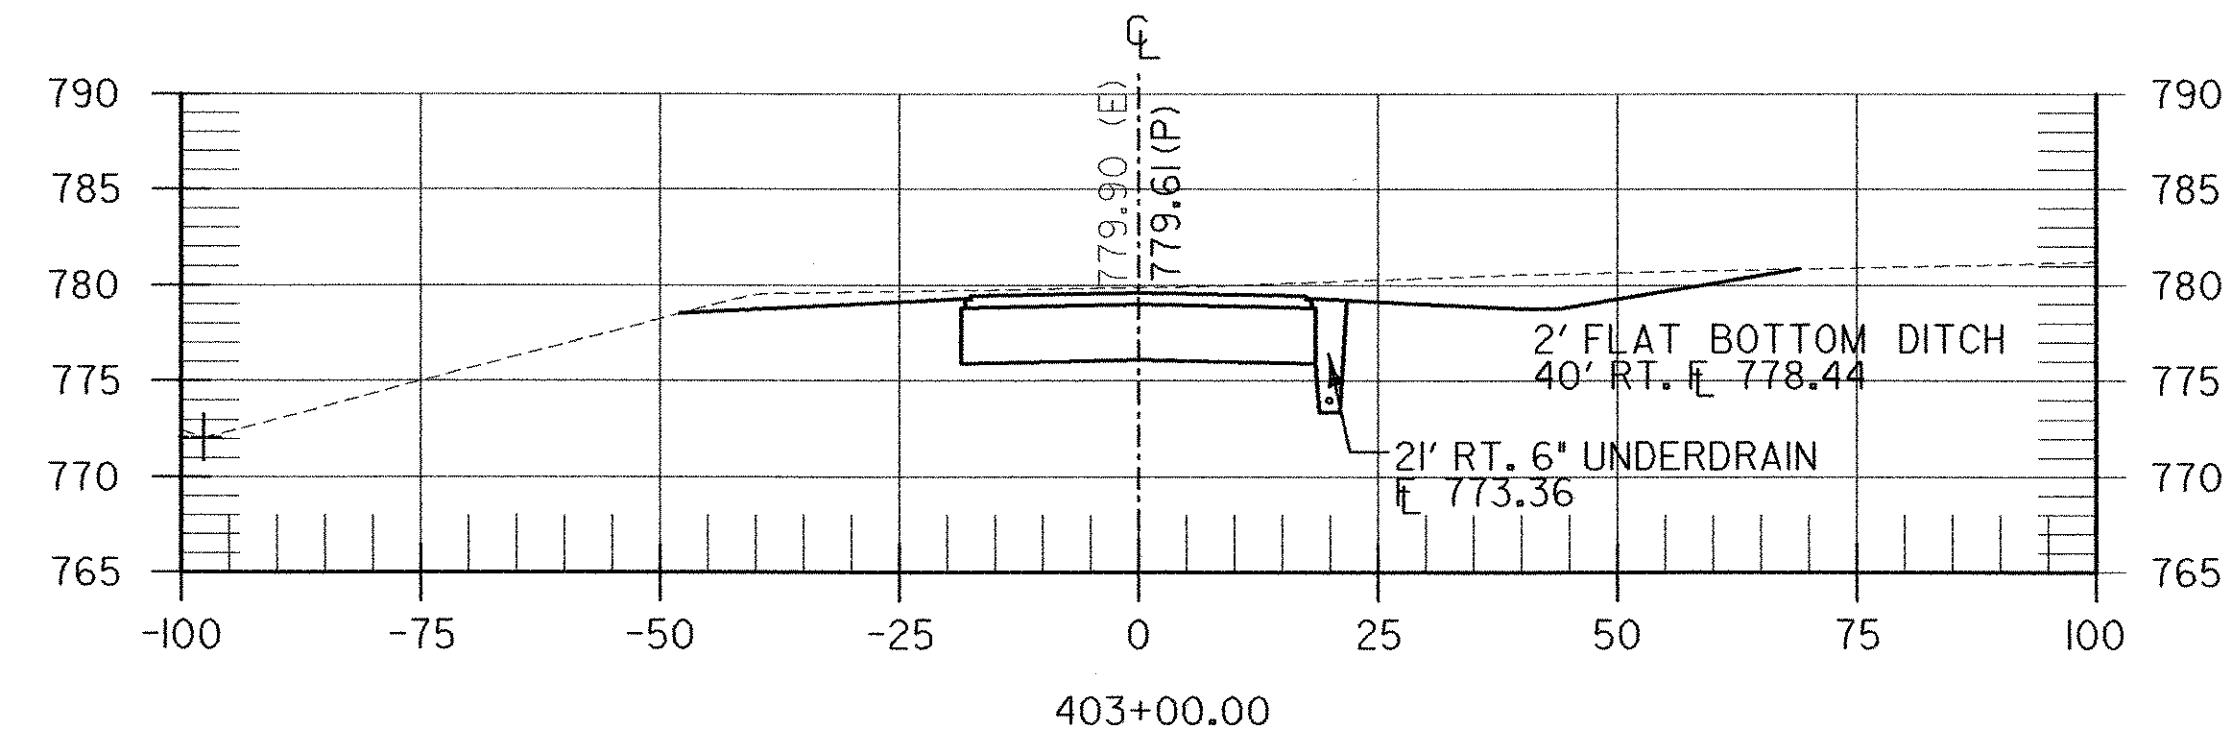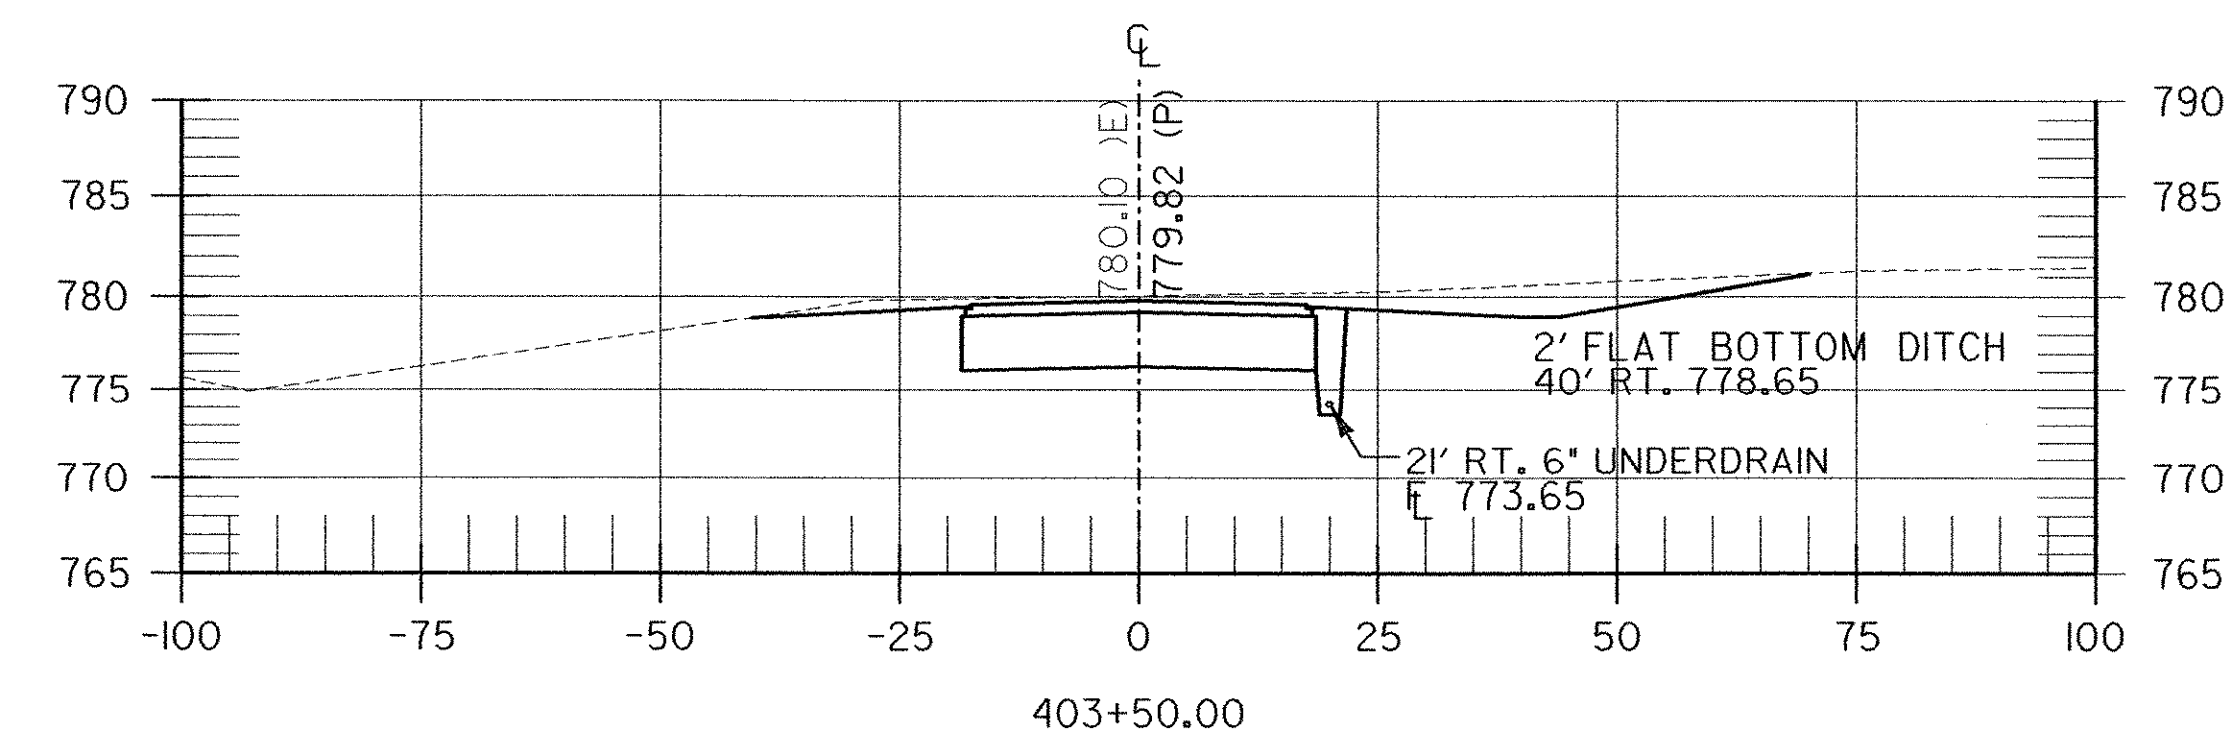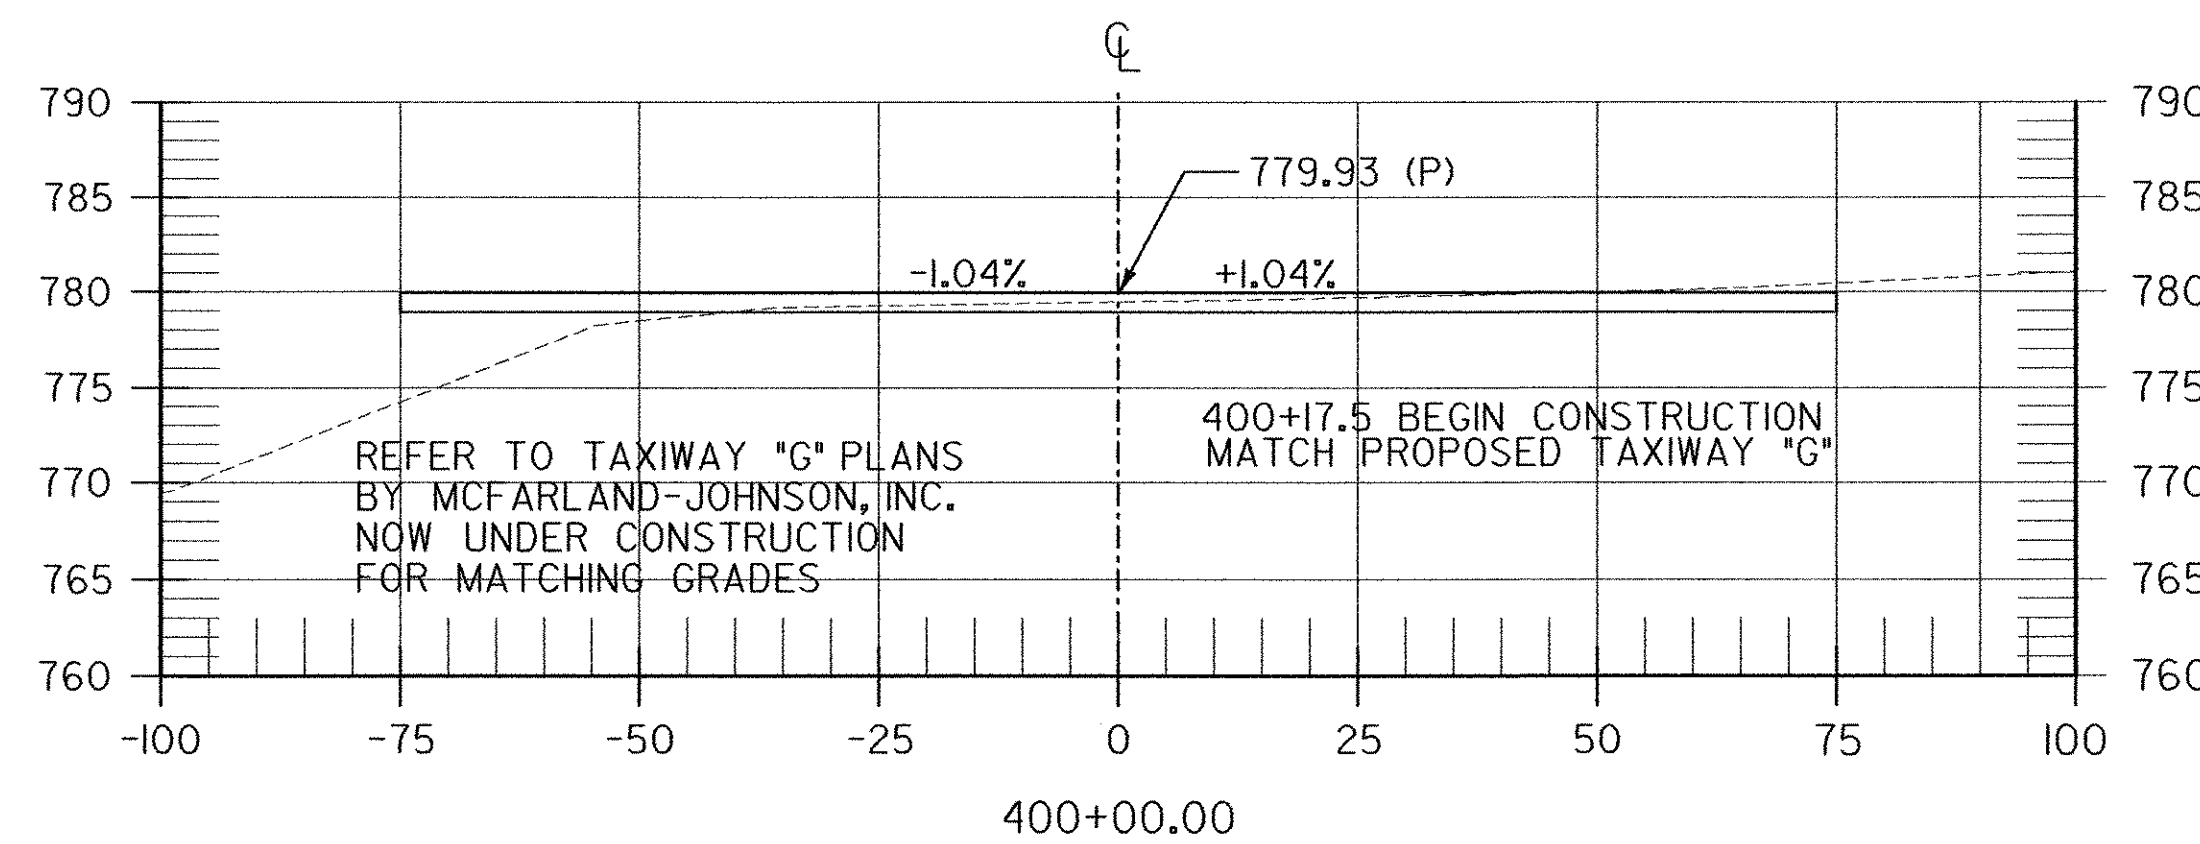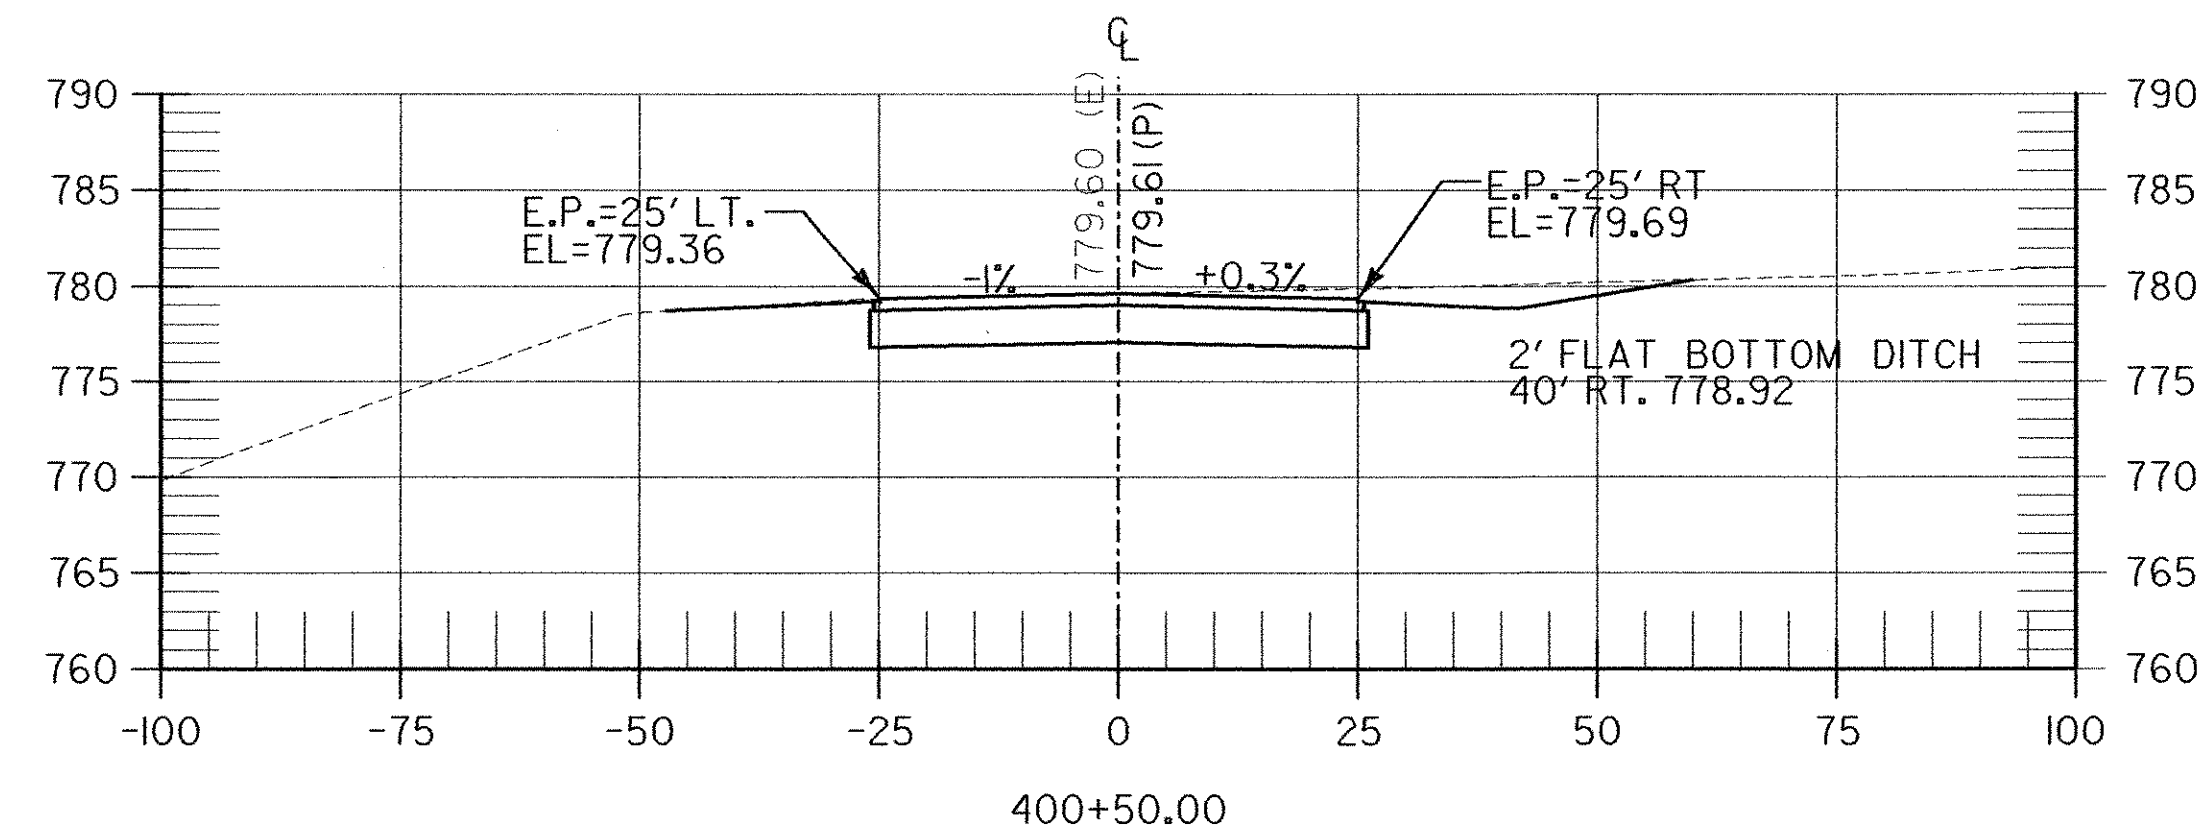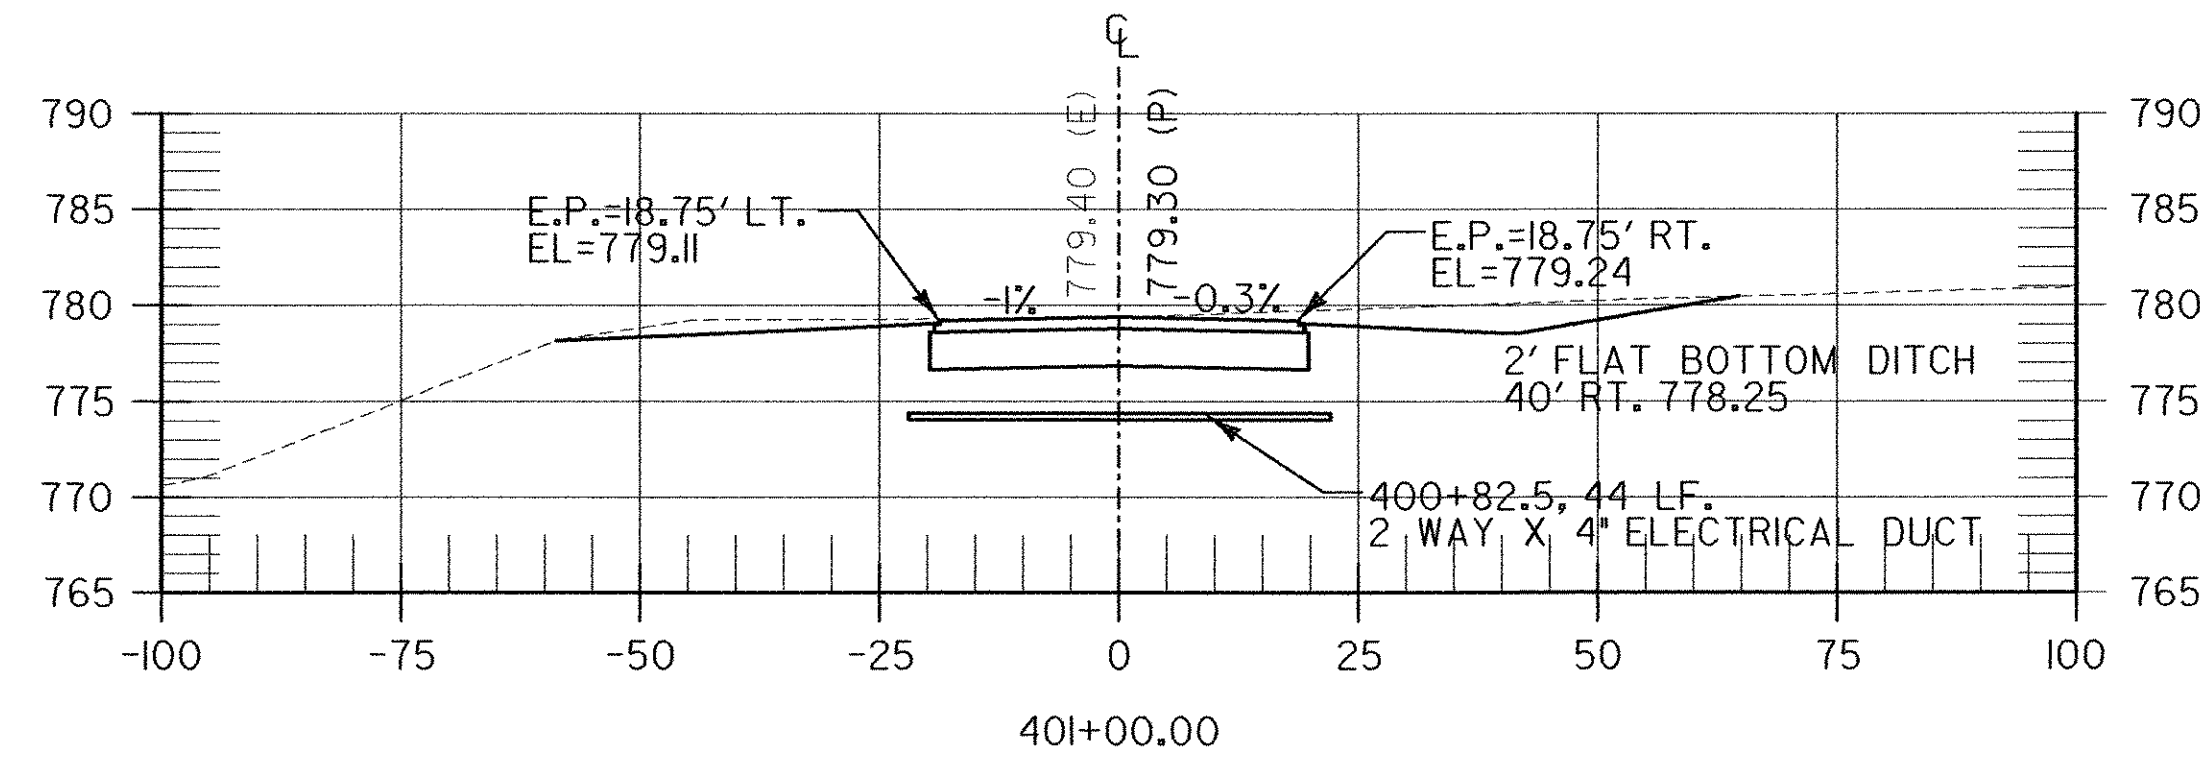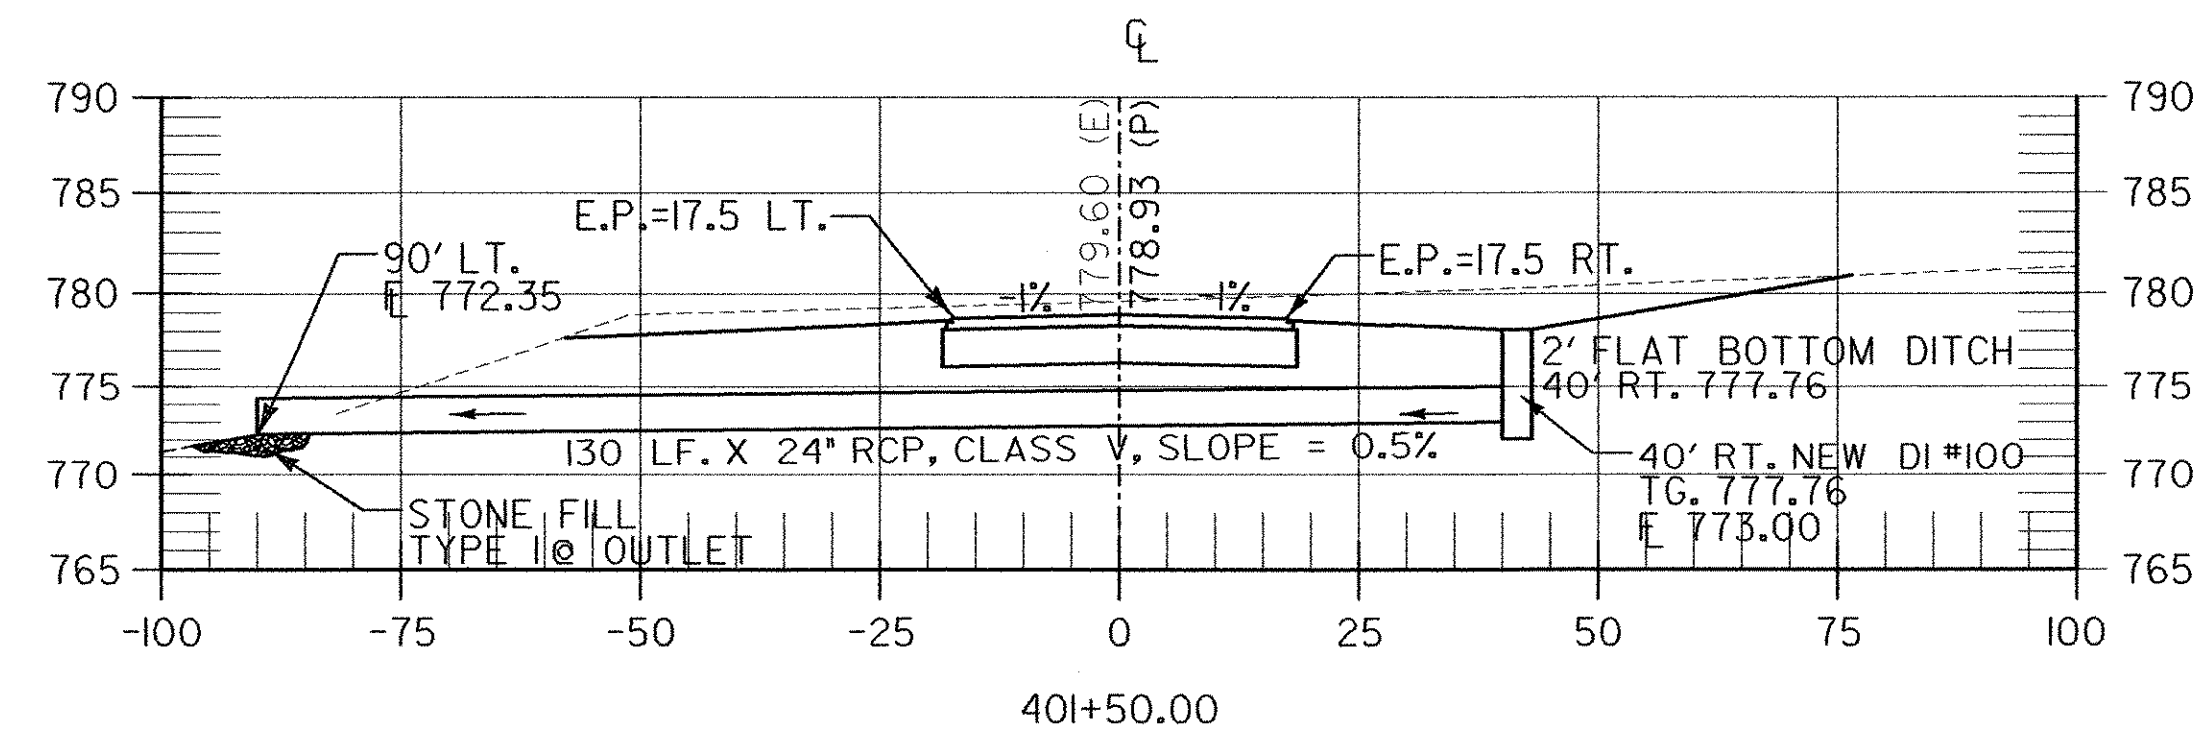

PROJECT "A"
A.I.P. 3-50-0015-17

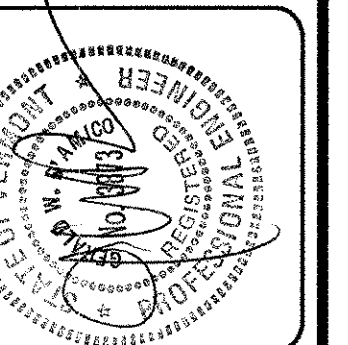

REV.	DATE	DESCRIPTION

RUTLAND STATE AIRPORT
CLARENDON, VERMONT

CROSS SECTIONS
TAXIWAY "F"

URS
1 NORTHWAY LN.
LATHAM, NEW YORK












Designed by: G.W.D.
Drawn by: M.C.M.
Checked by: M.C.C.
Approved by: G.W.D.

Scales AS SHOWN


Date: FEB., 2003

Sheet 30 OF 40

Sheet No
30

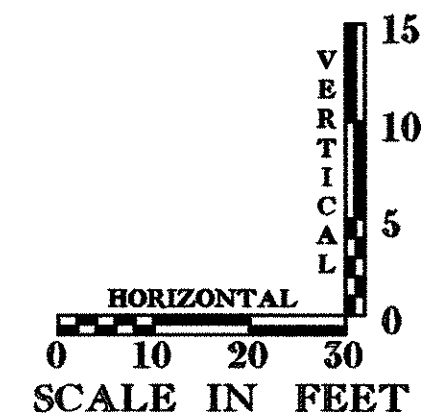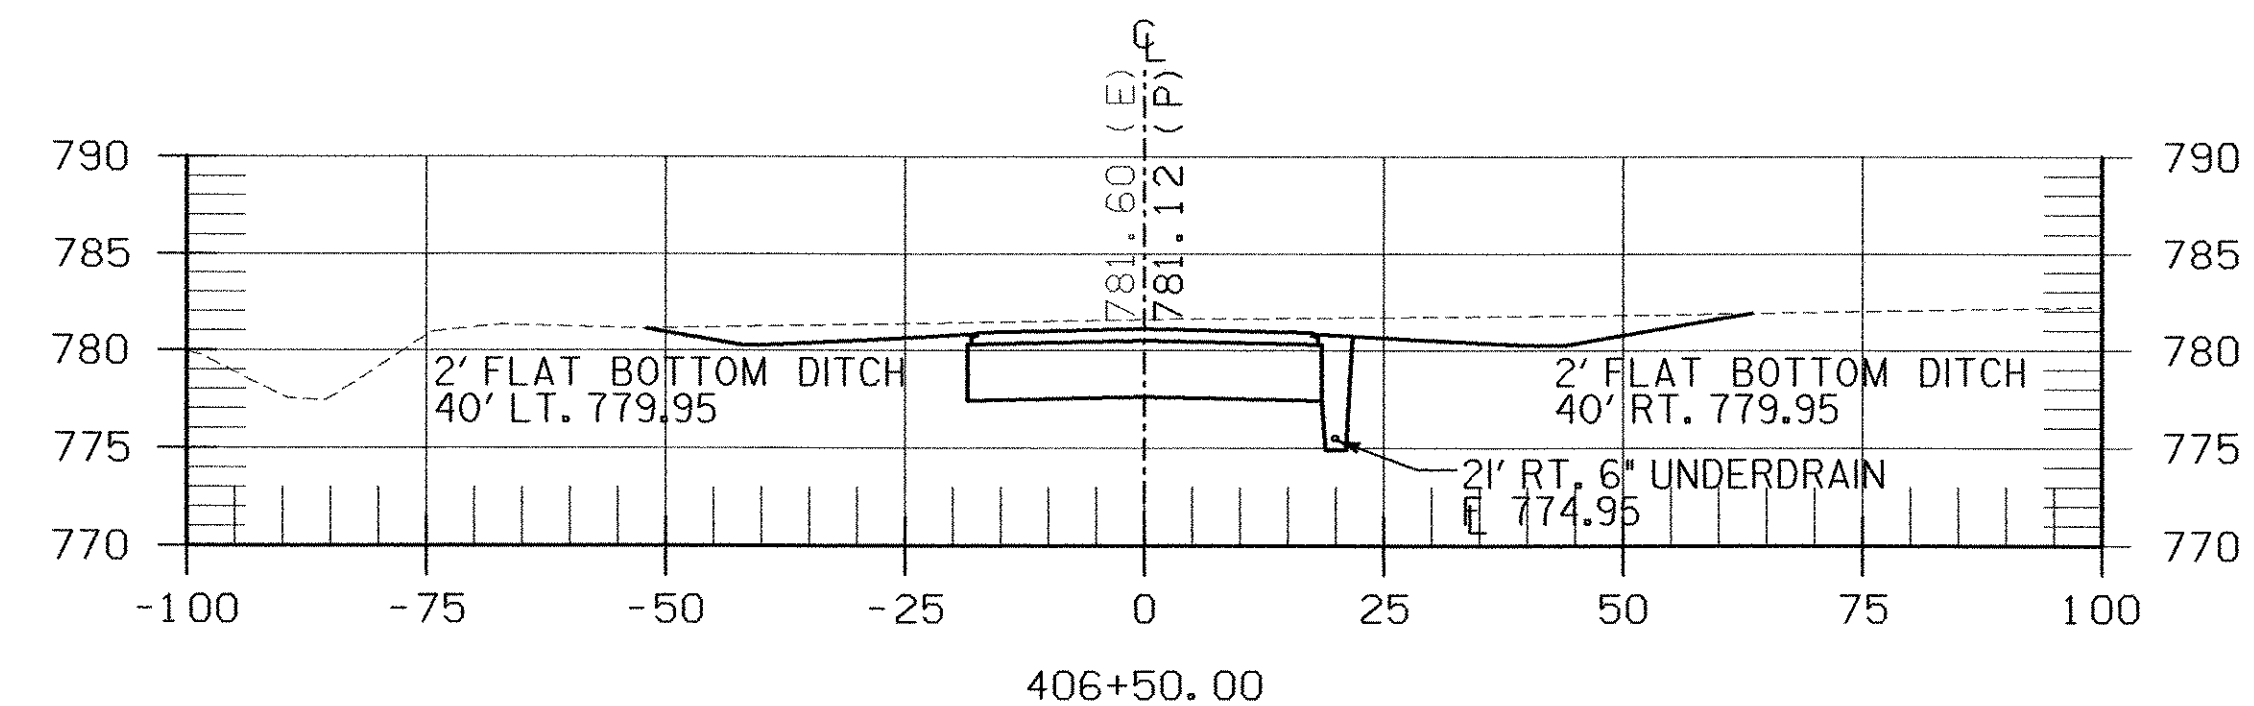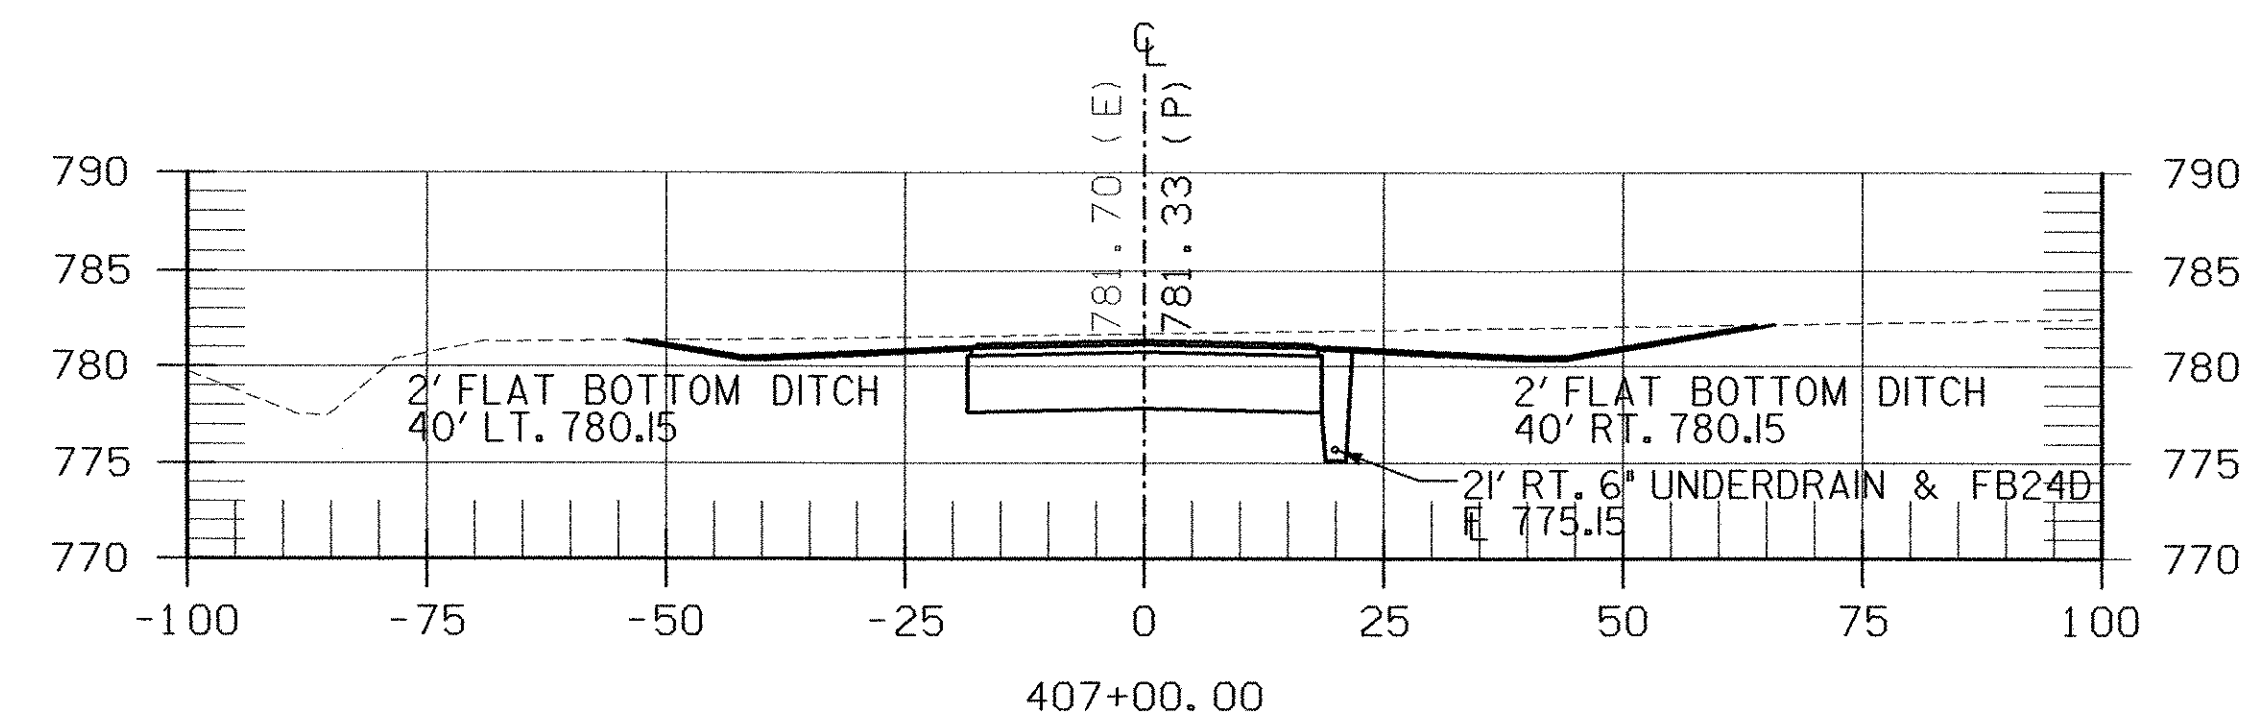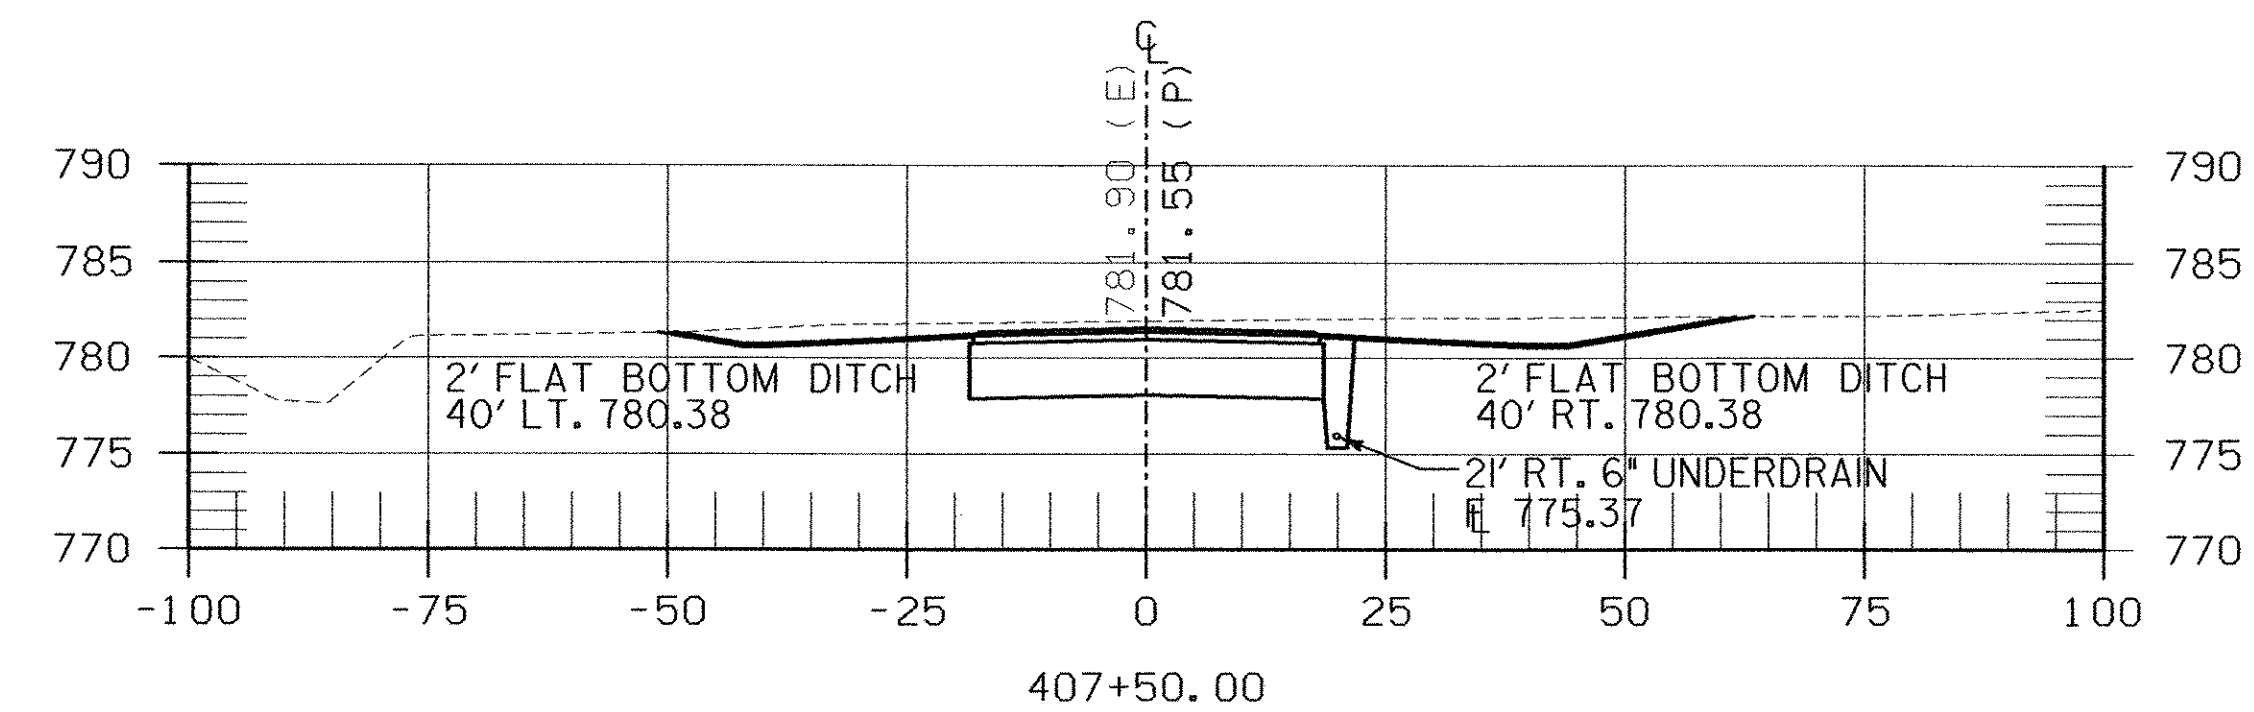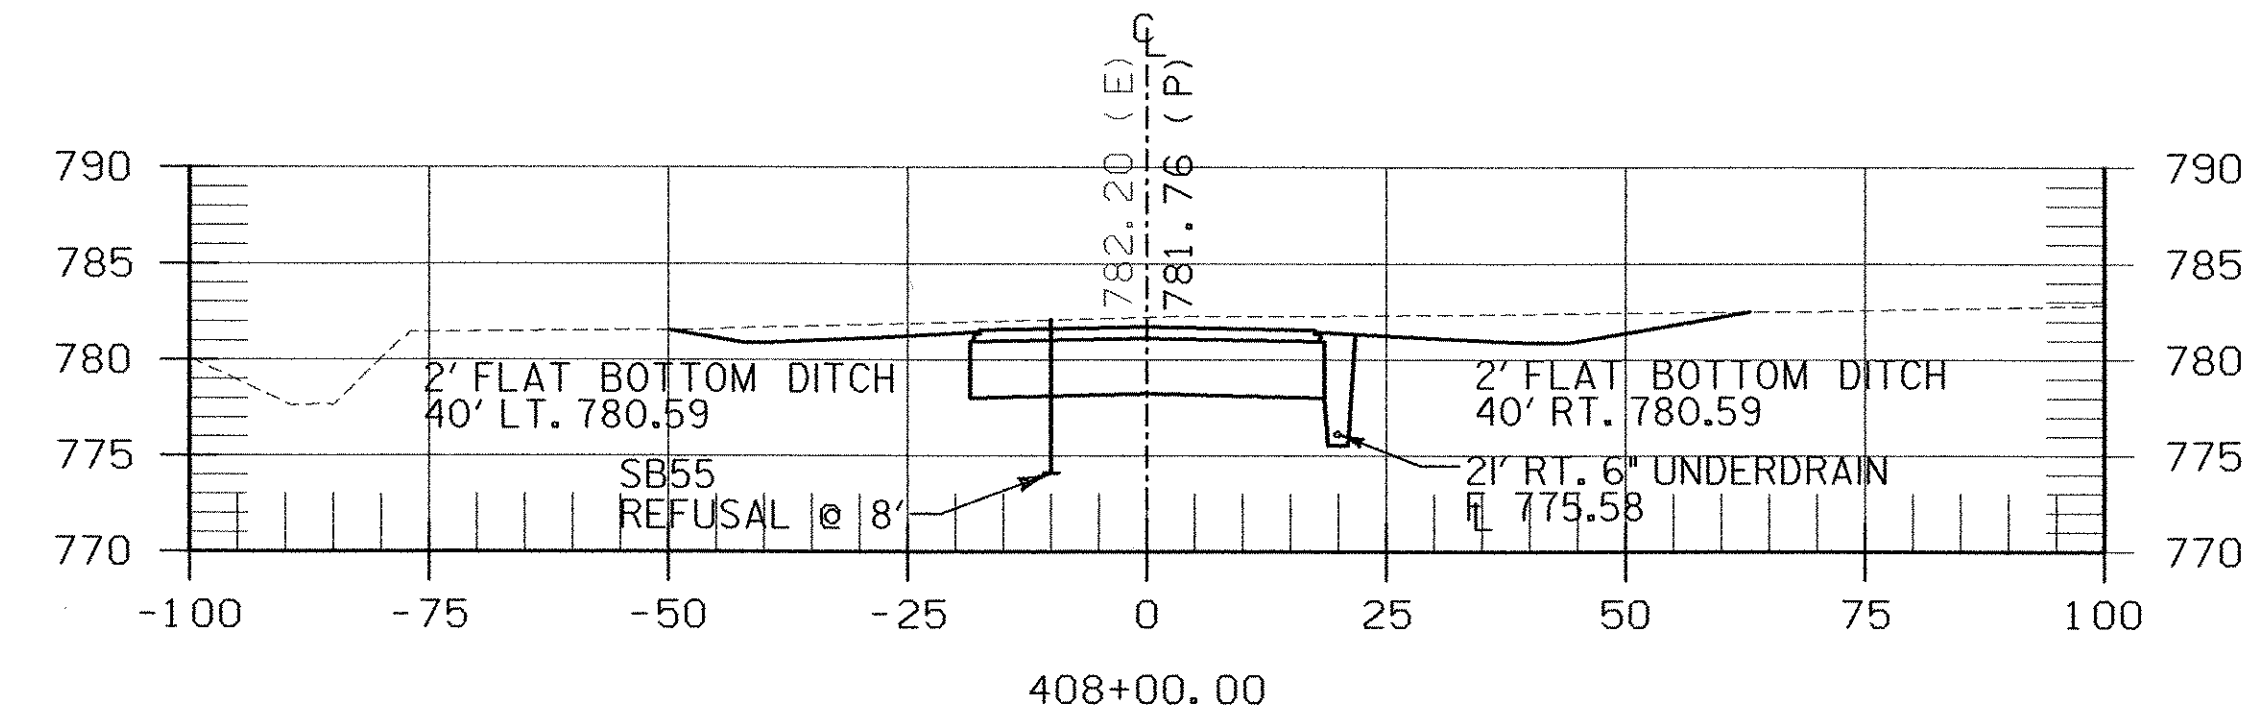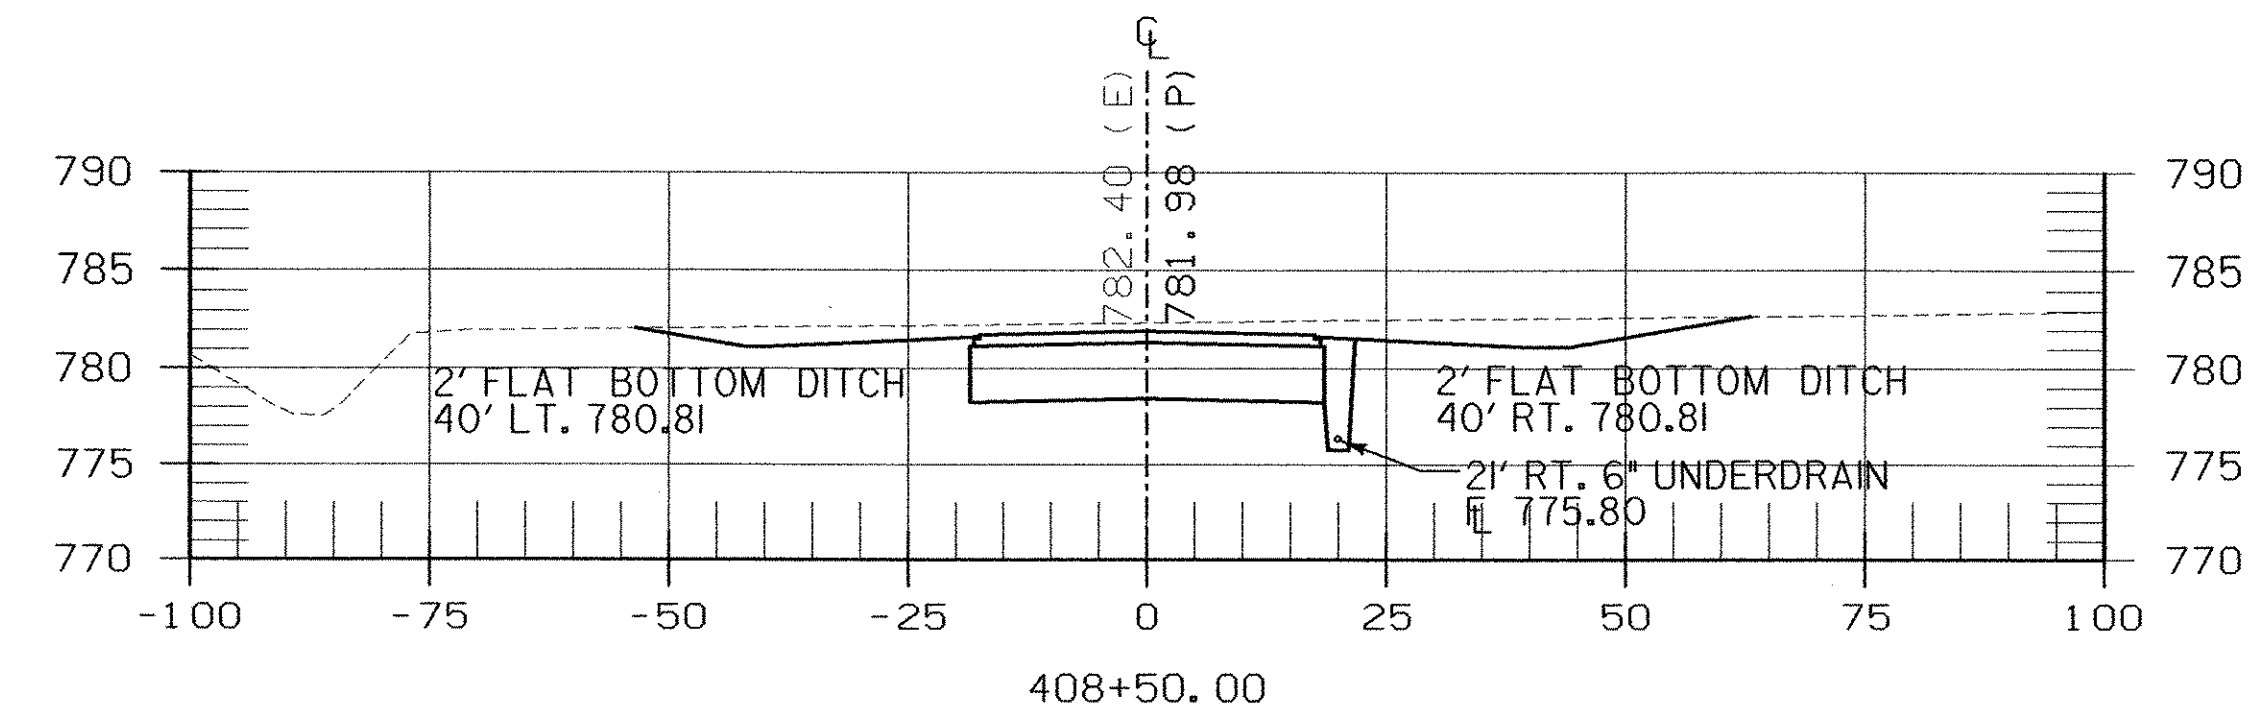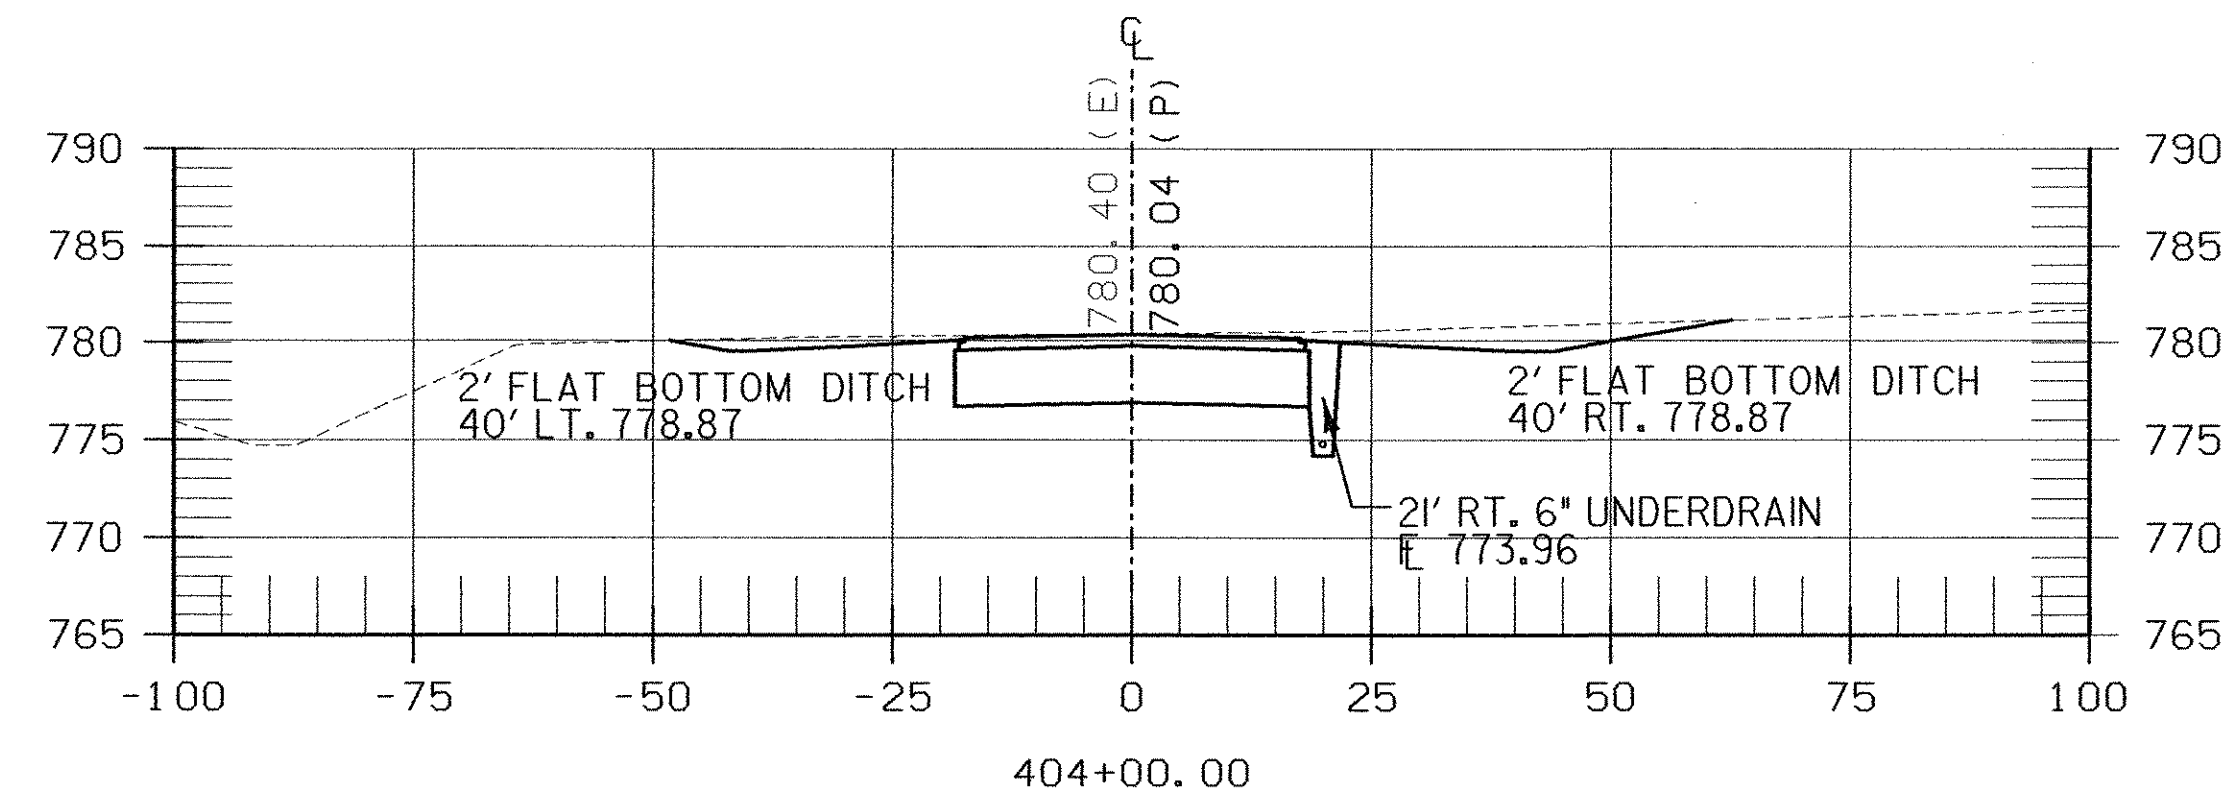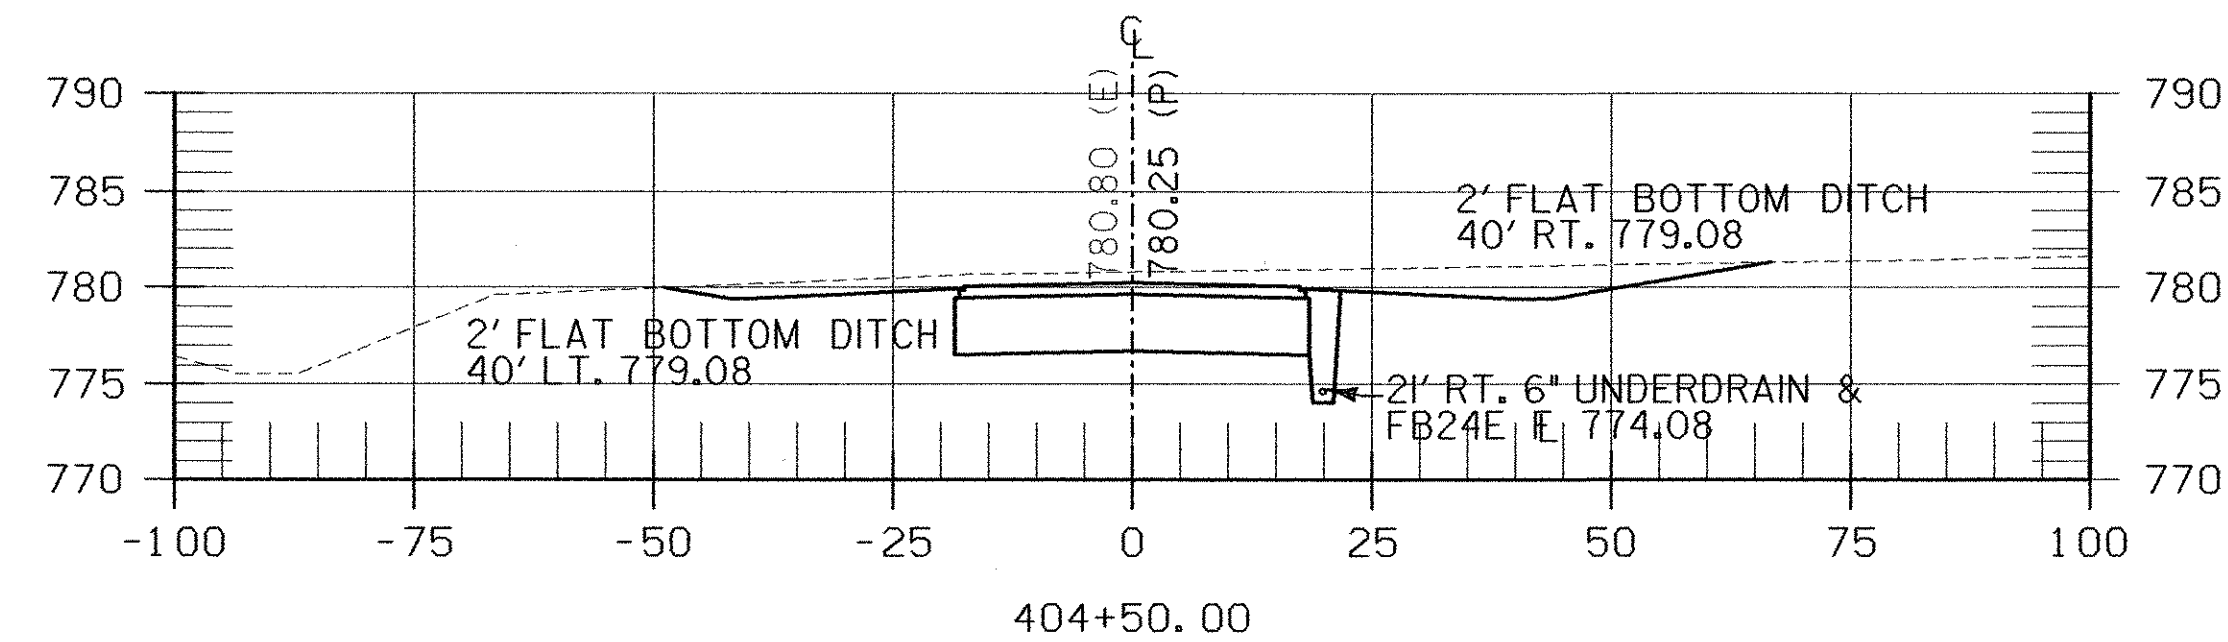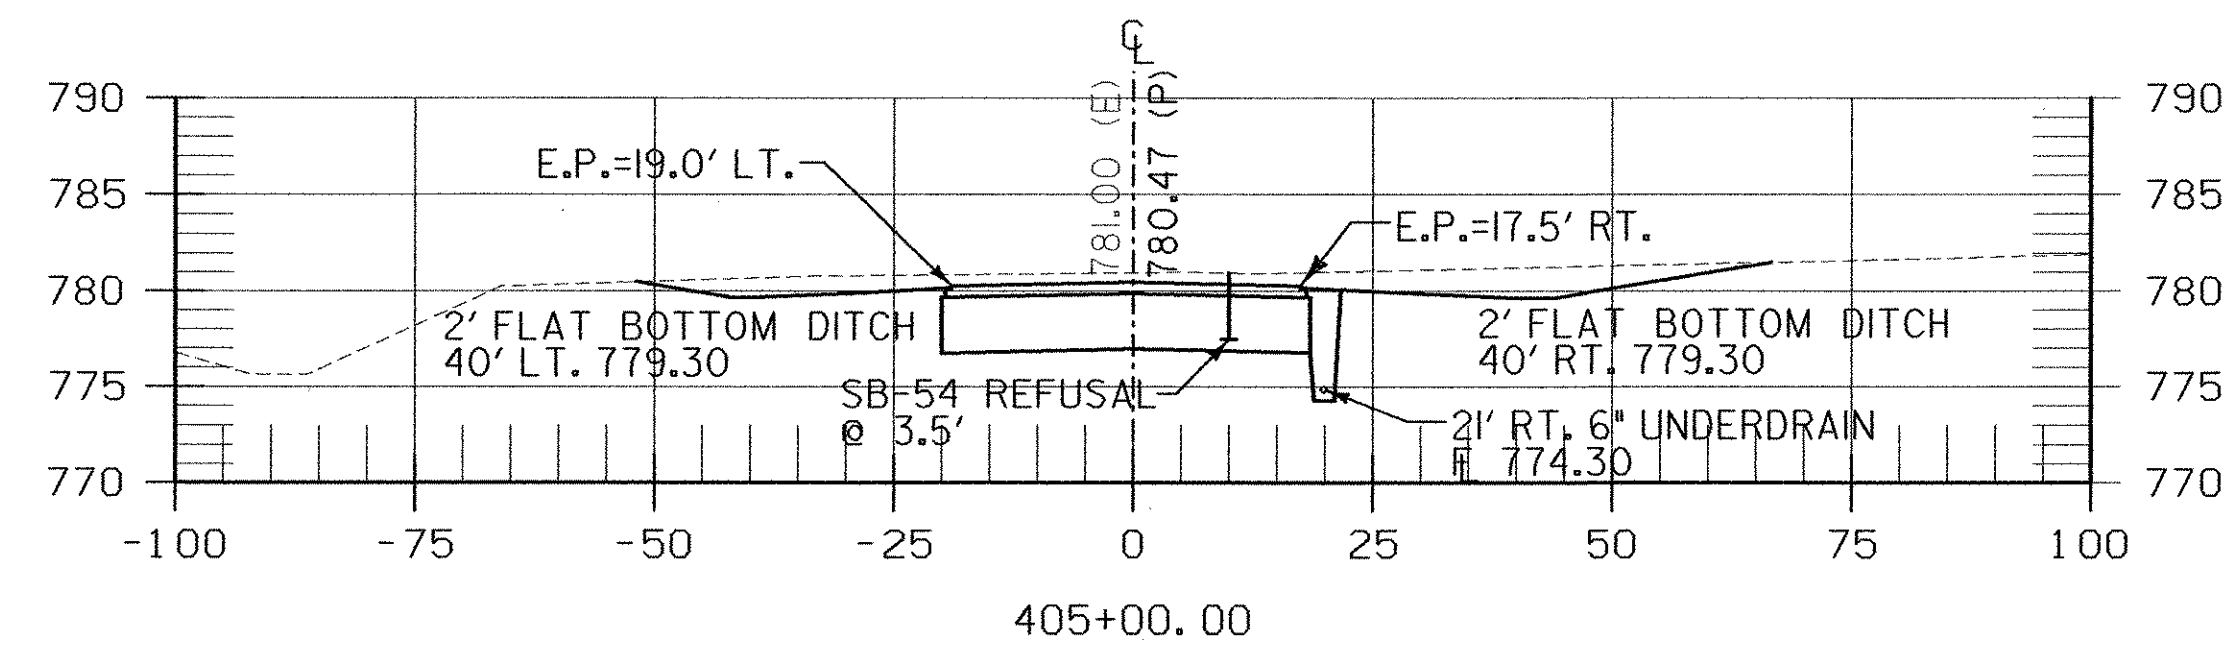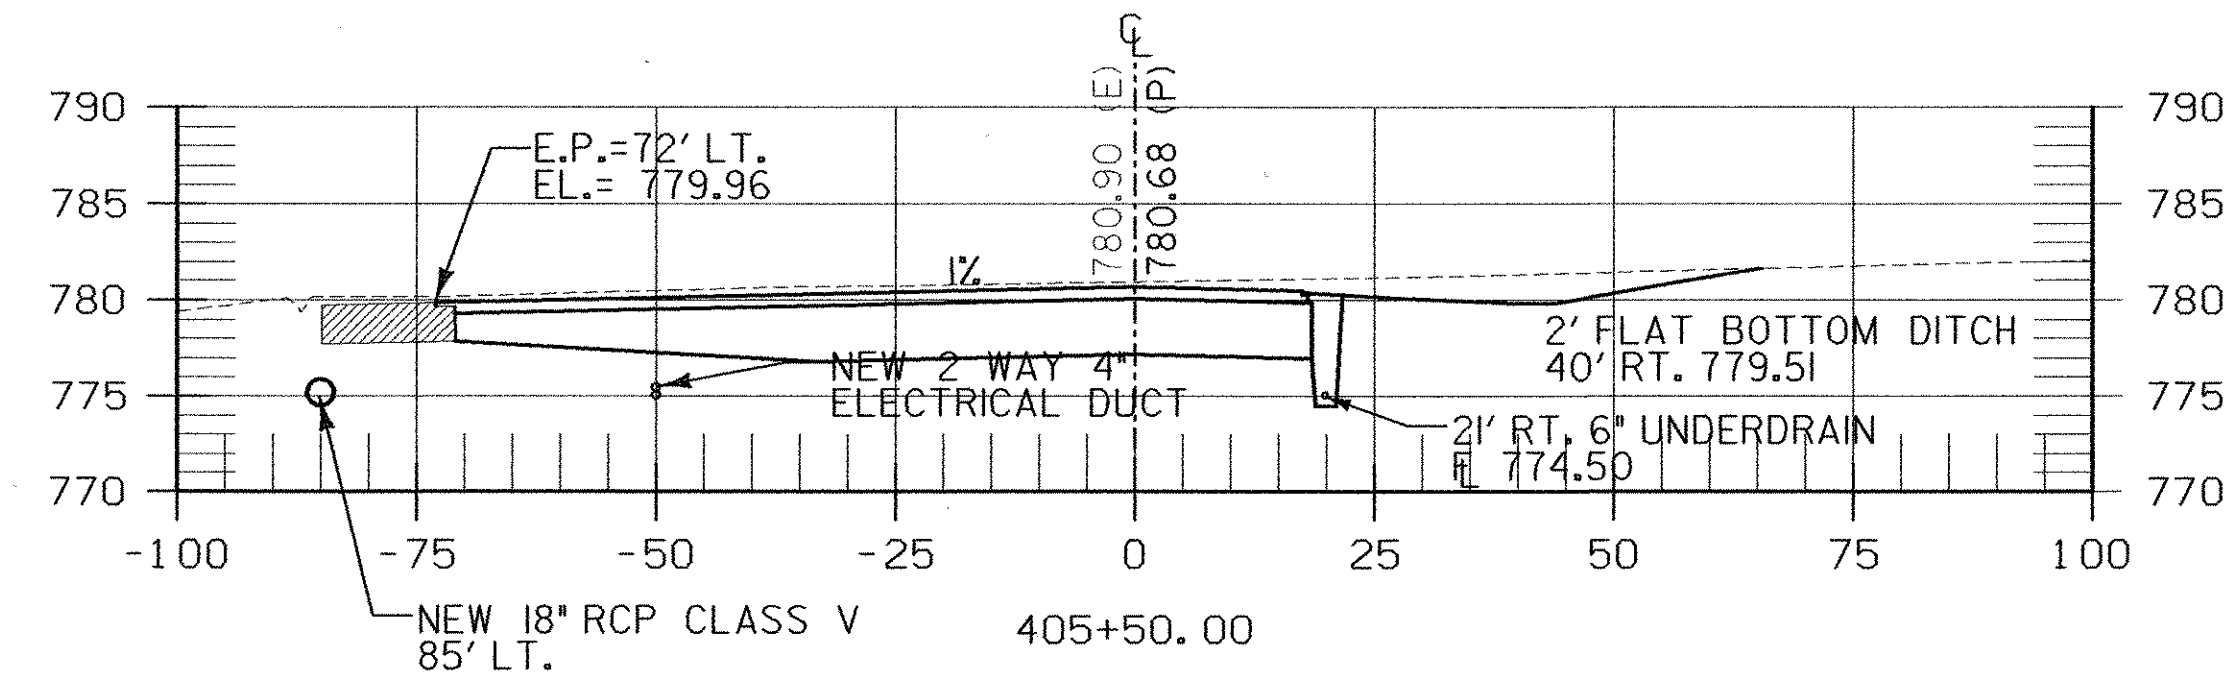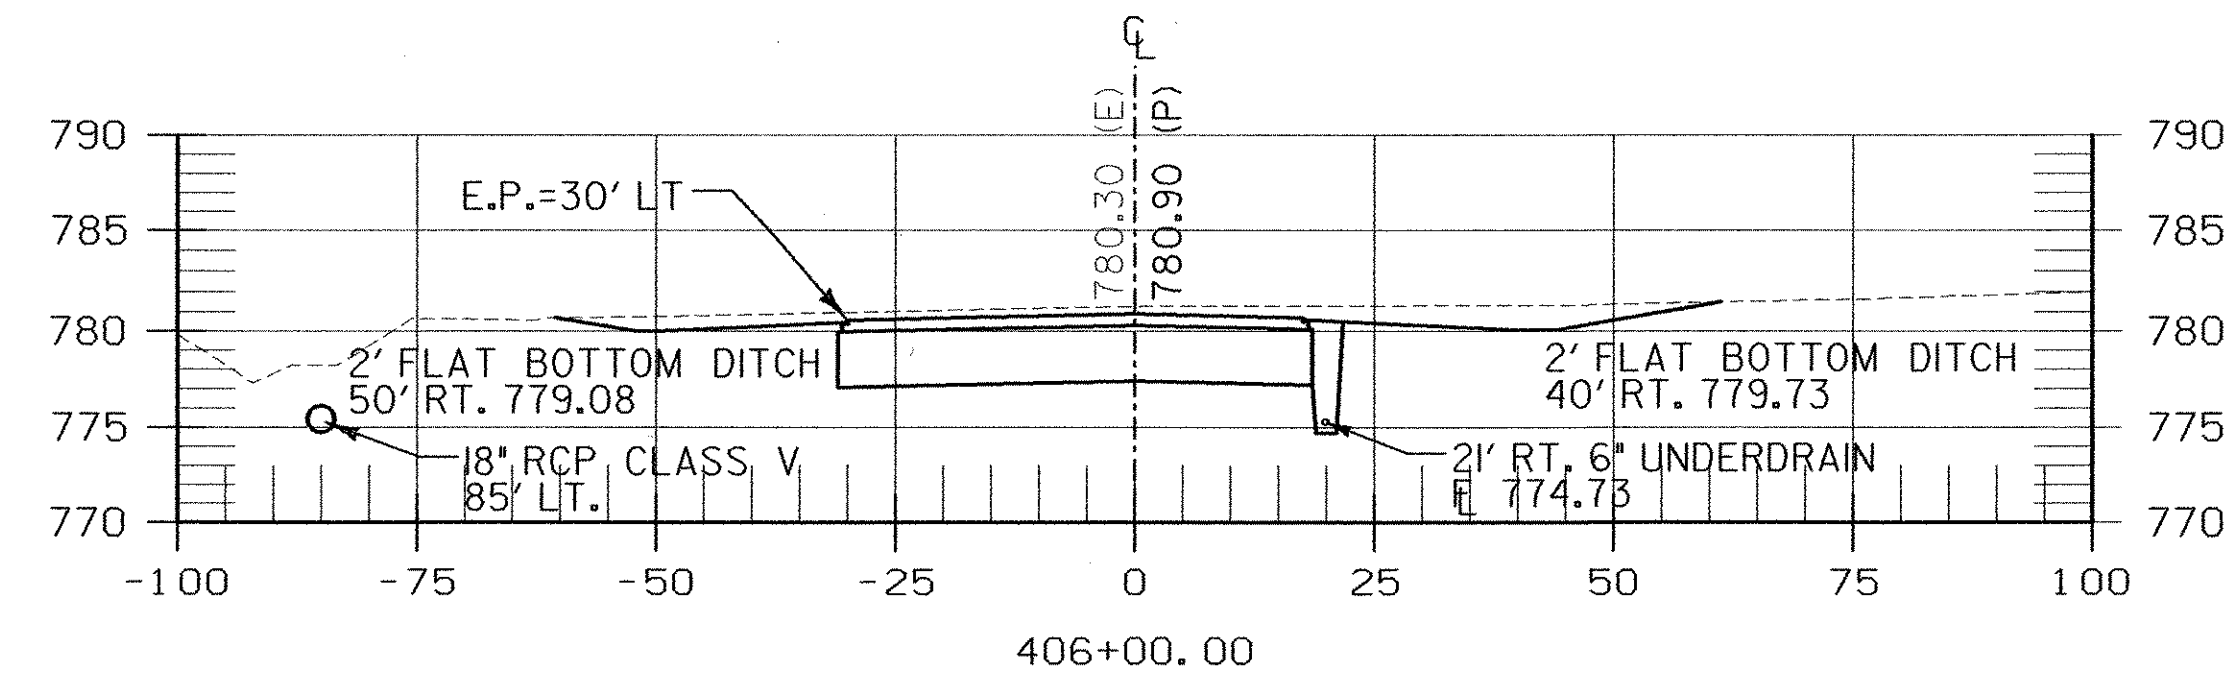

PROJECT "A"
A.I.P. 3-50-0015-17

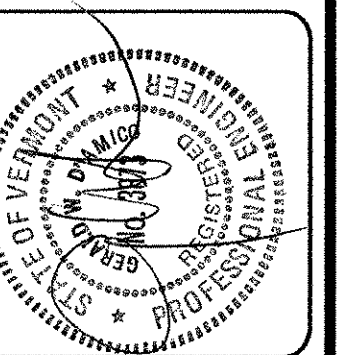

REV.	DATE	DESCRIPTION

Job No. F200002046.00
File No. F2020460da31

RUTLAND STATE AIRPORT
CLARENDON, VERMONT

CROSS SECTIONS
TAXIWAY "F"

URS
1 NORTHWAY LN.
LATHAM, NEW YORK

Designed by G.W.D.
Drawn by M.C.M.
Checked by M.K.C.
Approved by G.W.D.


Scale: AS SHOWN

Date: FEB., 2003

Sheet 31 OF 40

Sheet No
31

\\FAC\IT\Sheet\0012002\F2020460da31.dgn

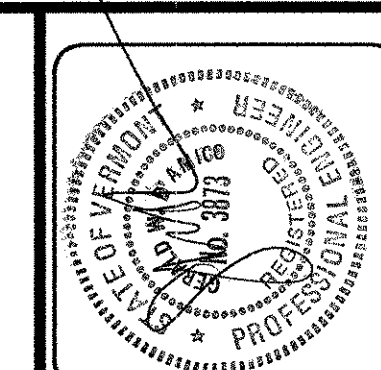

REV.	DATE	DESCRIPTION

Job No. F200002046.00
File No. F2020460d32

RUTLAND STATE AIRPORT
CLARENDON, VERMONT

CROSS SECTIONS
TAXIWAY "F"

URS
1 NORTHWAY LN.
LATHAM, NEW YORK












Designed by G.W.D.
Drawn by M.C.M.
Checked by M.C.C.
Approved by G.W.D.

Scale: AS SHOWN

Date: FEB., 2003


Sheet 32 OF 40

Sheet No
32

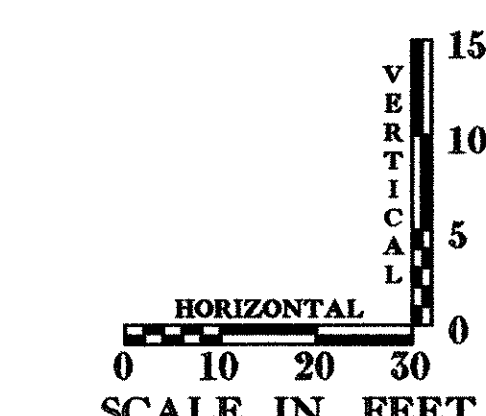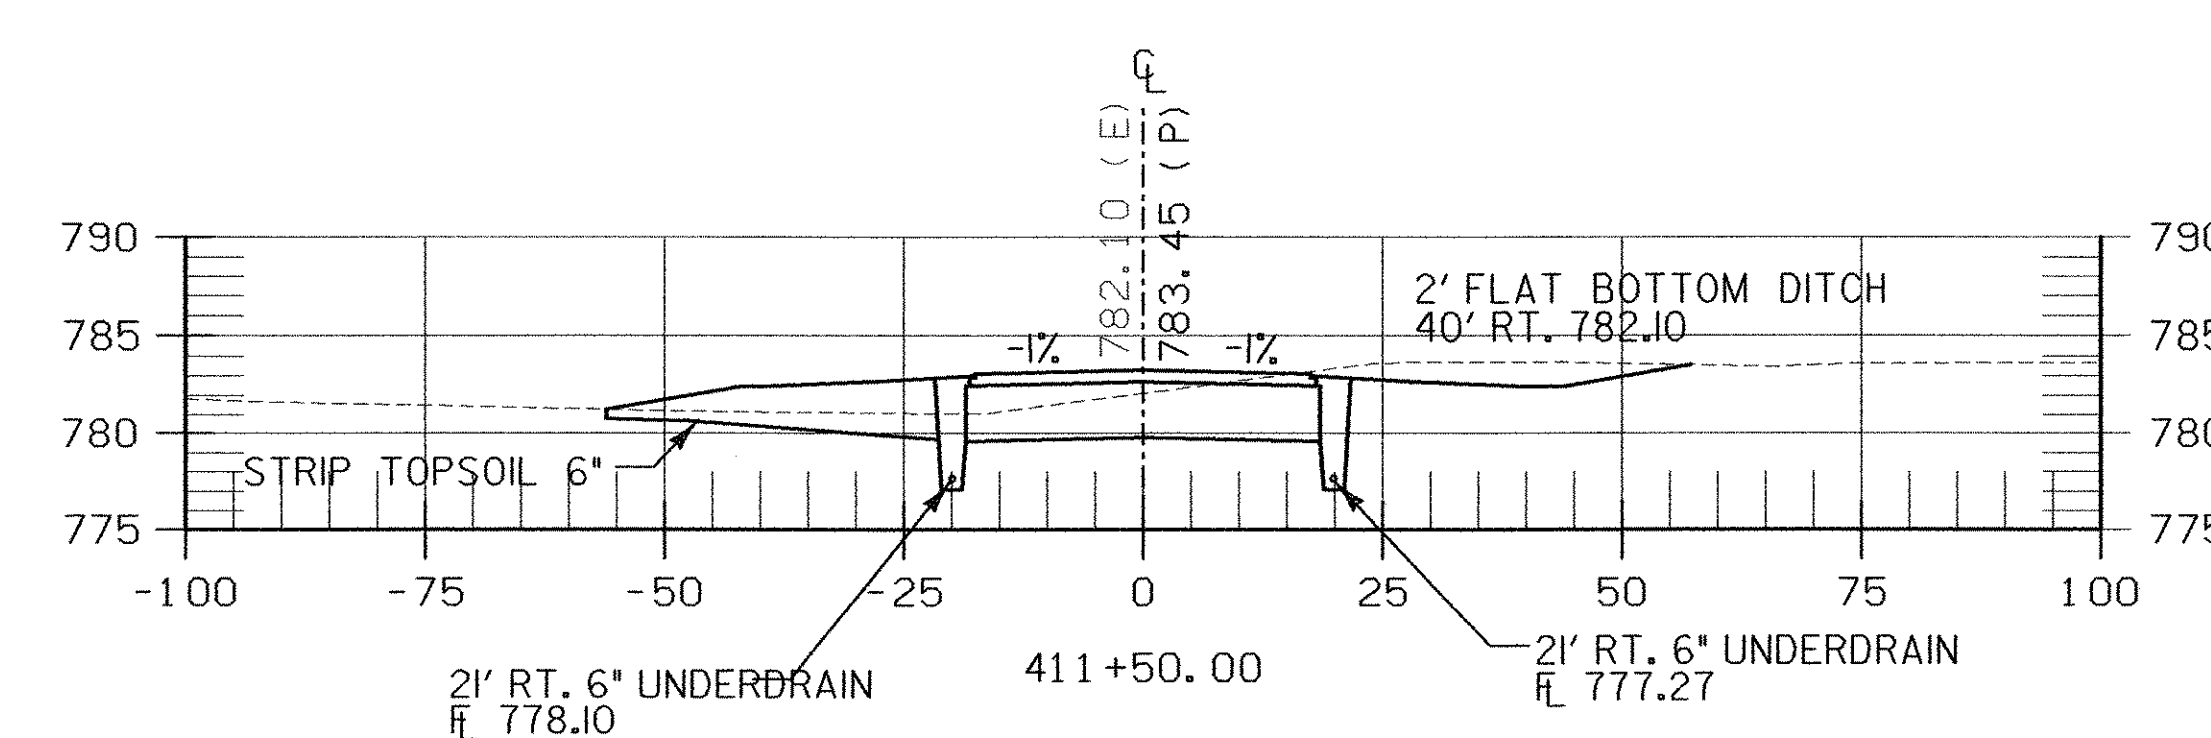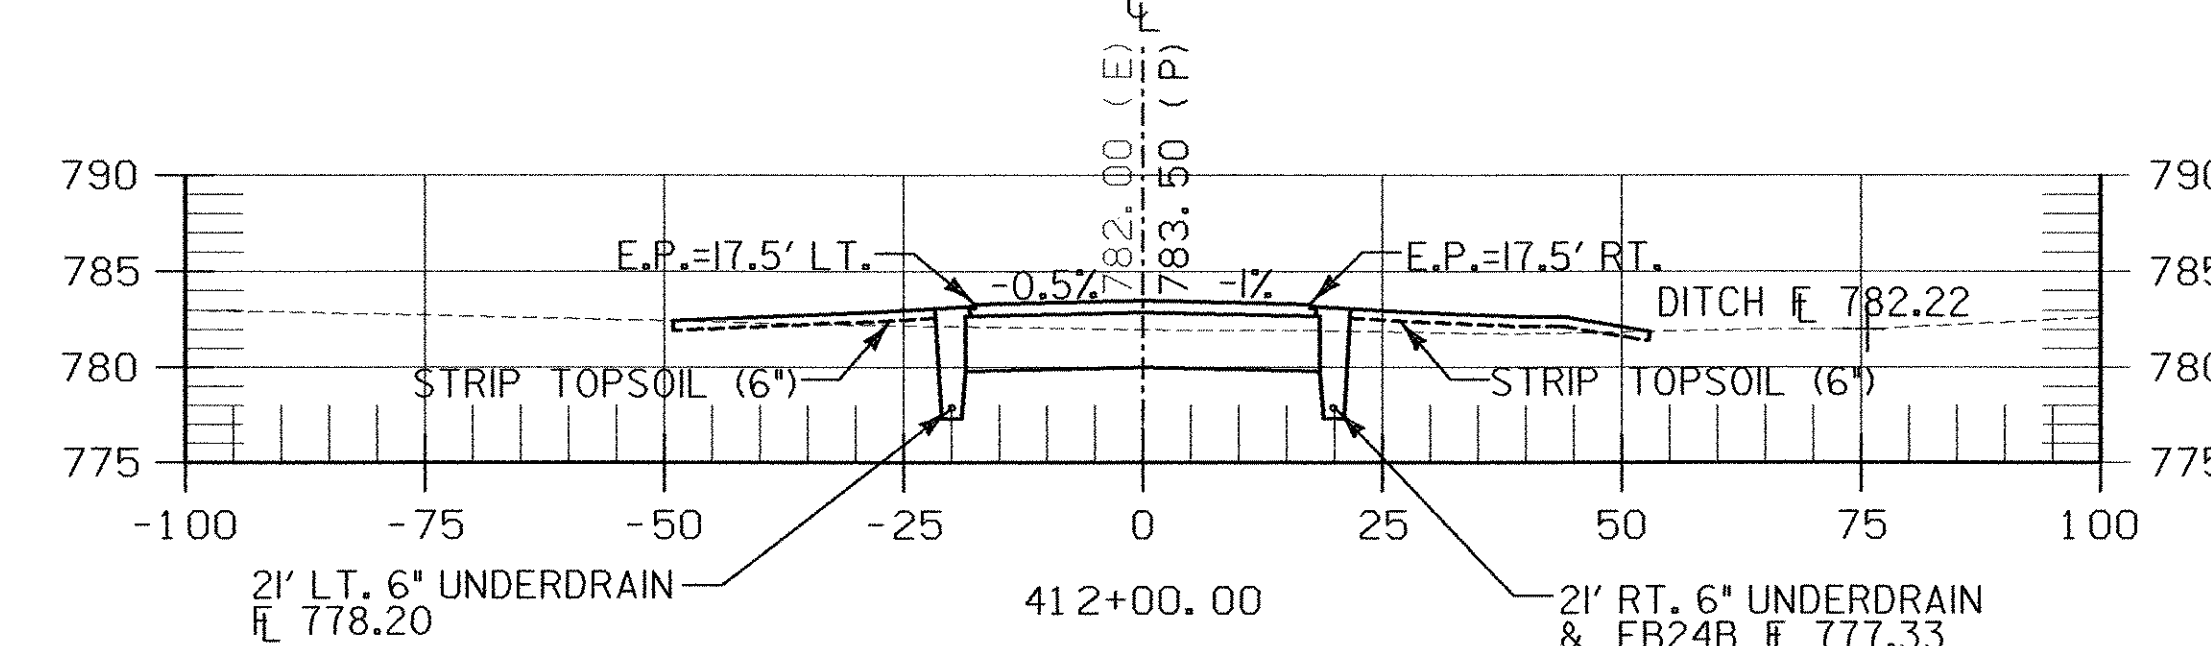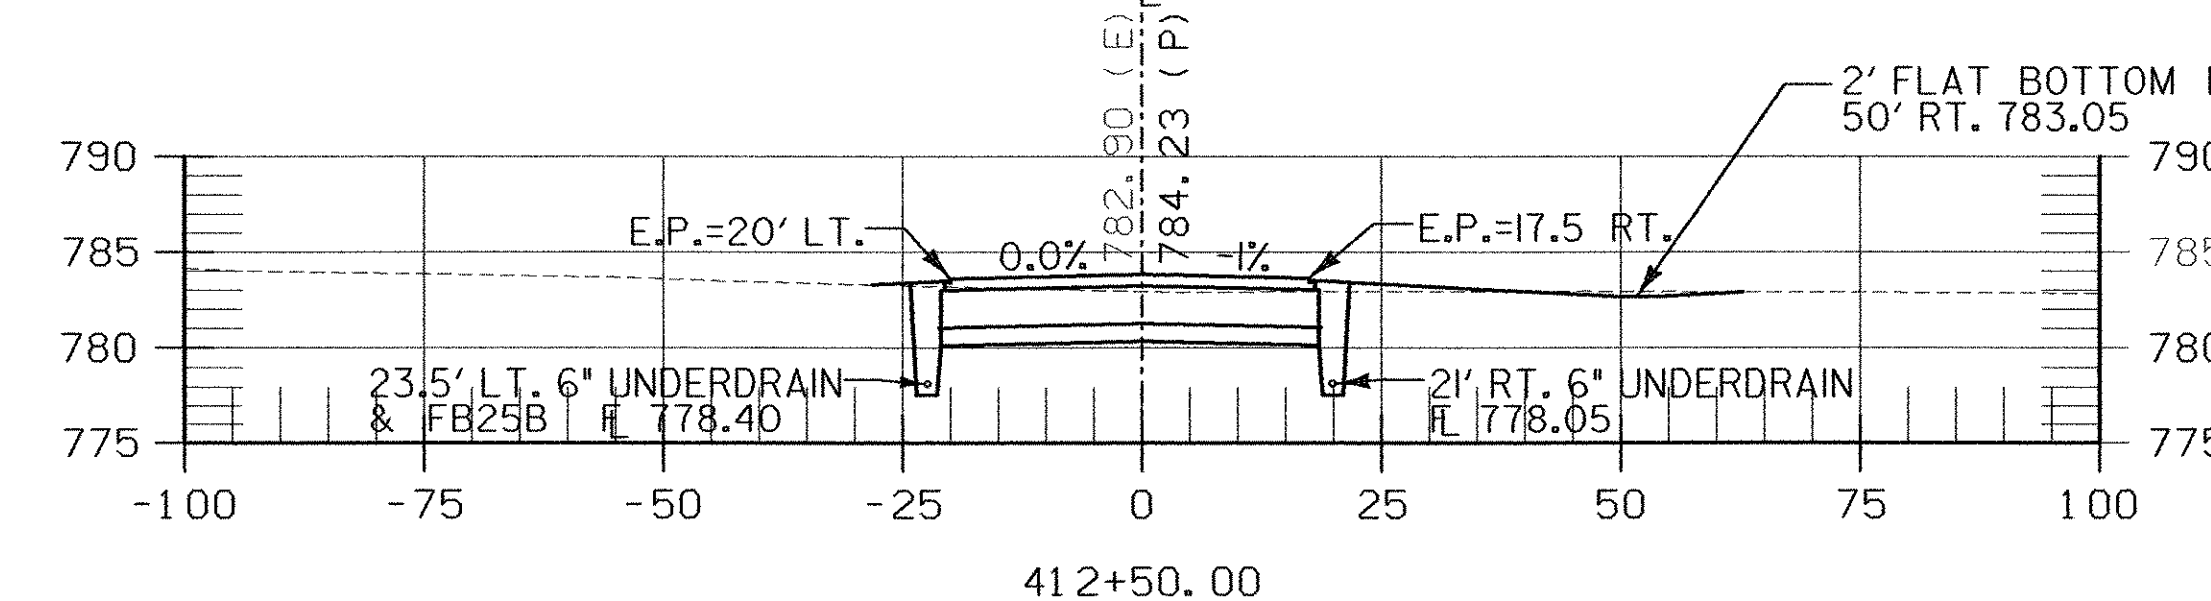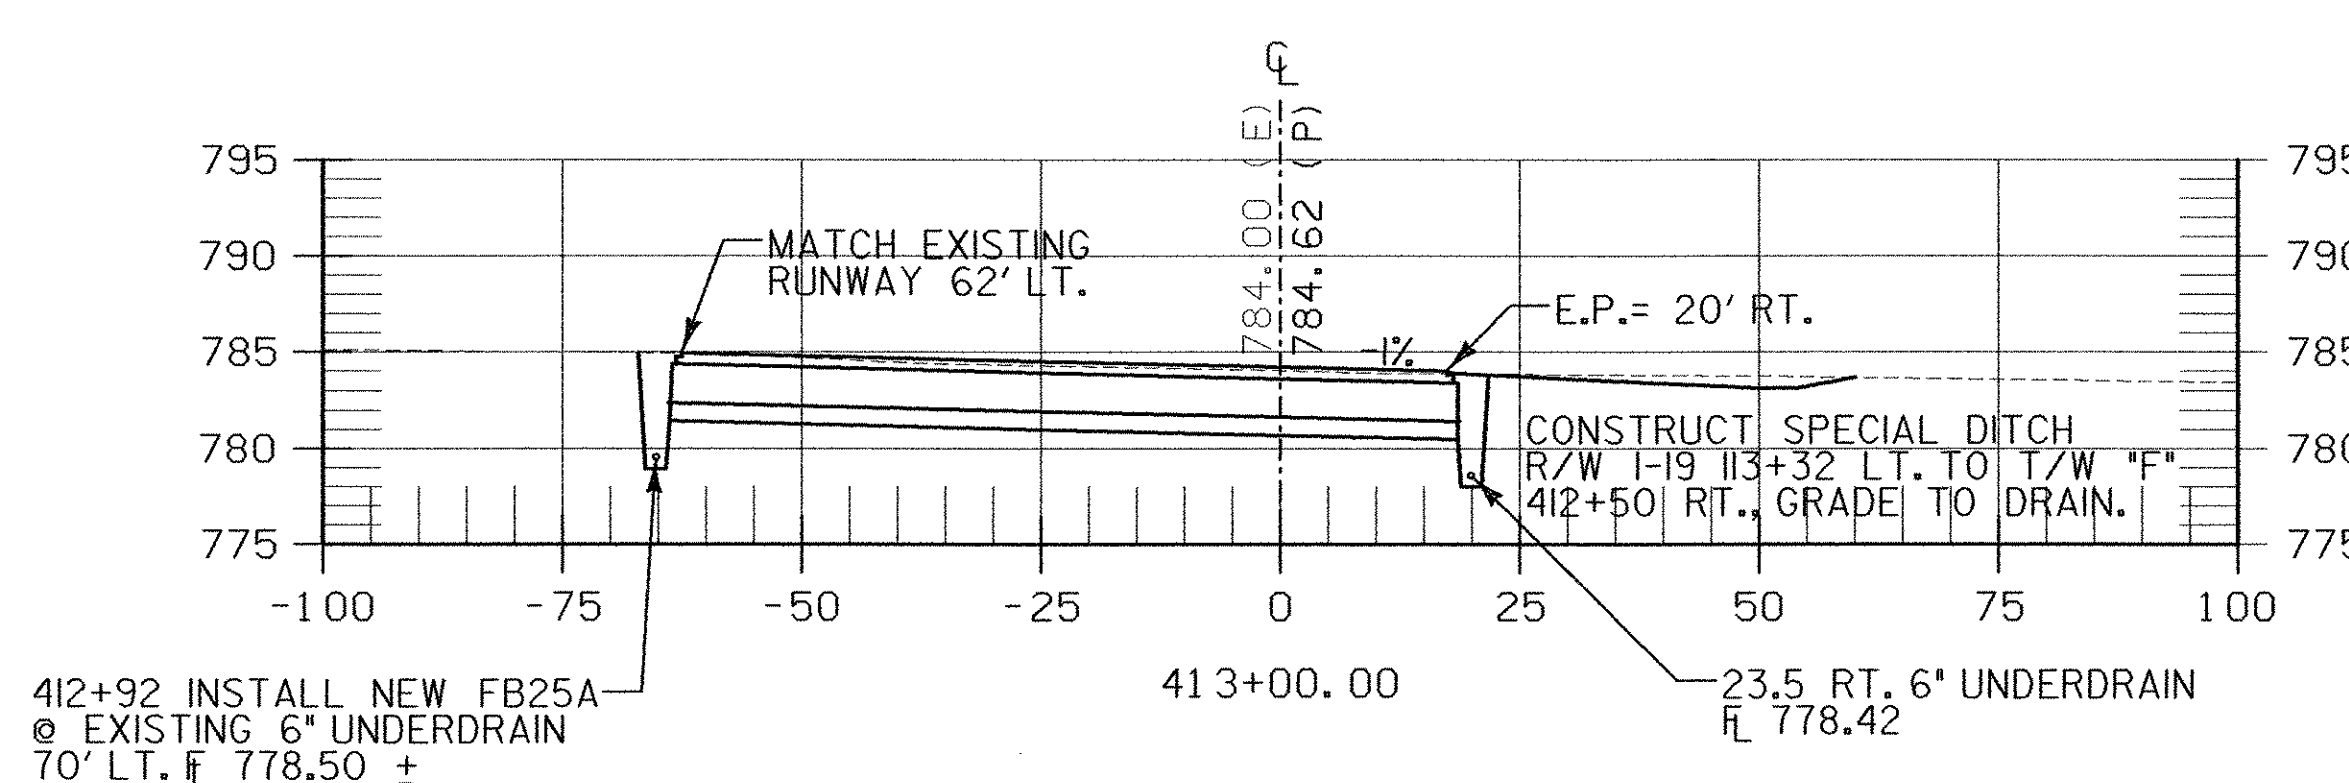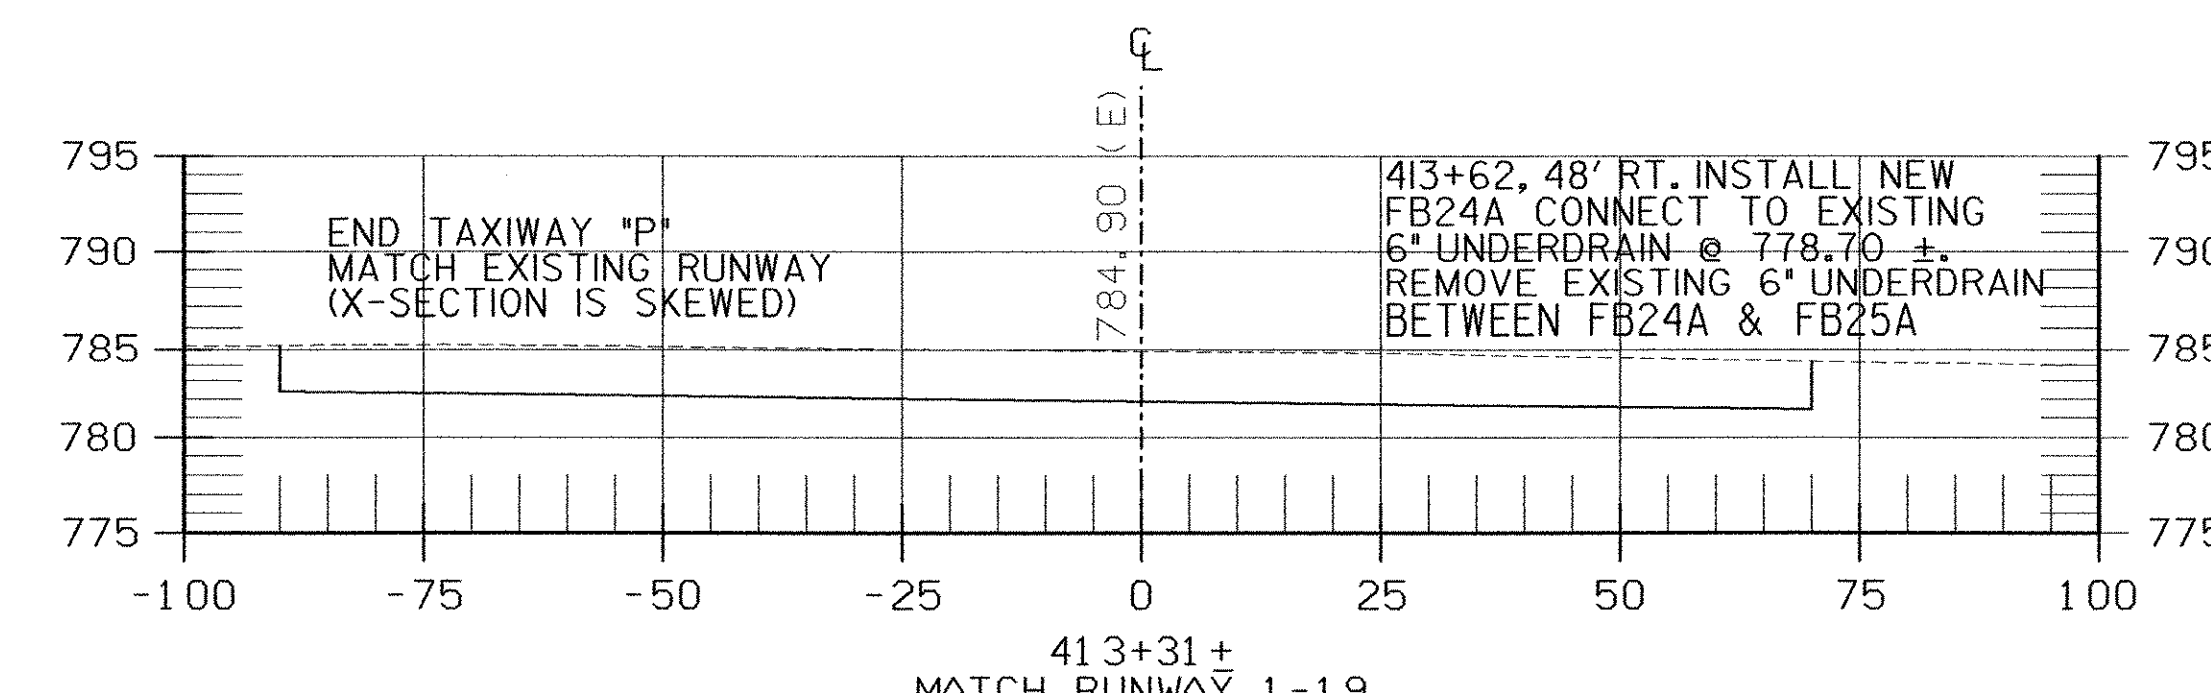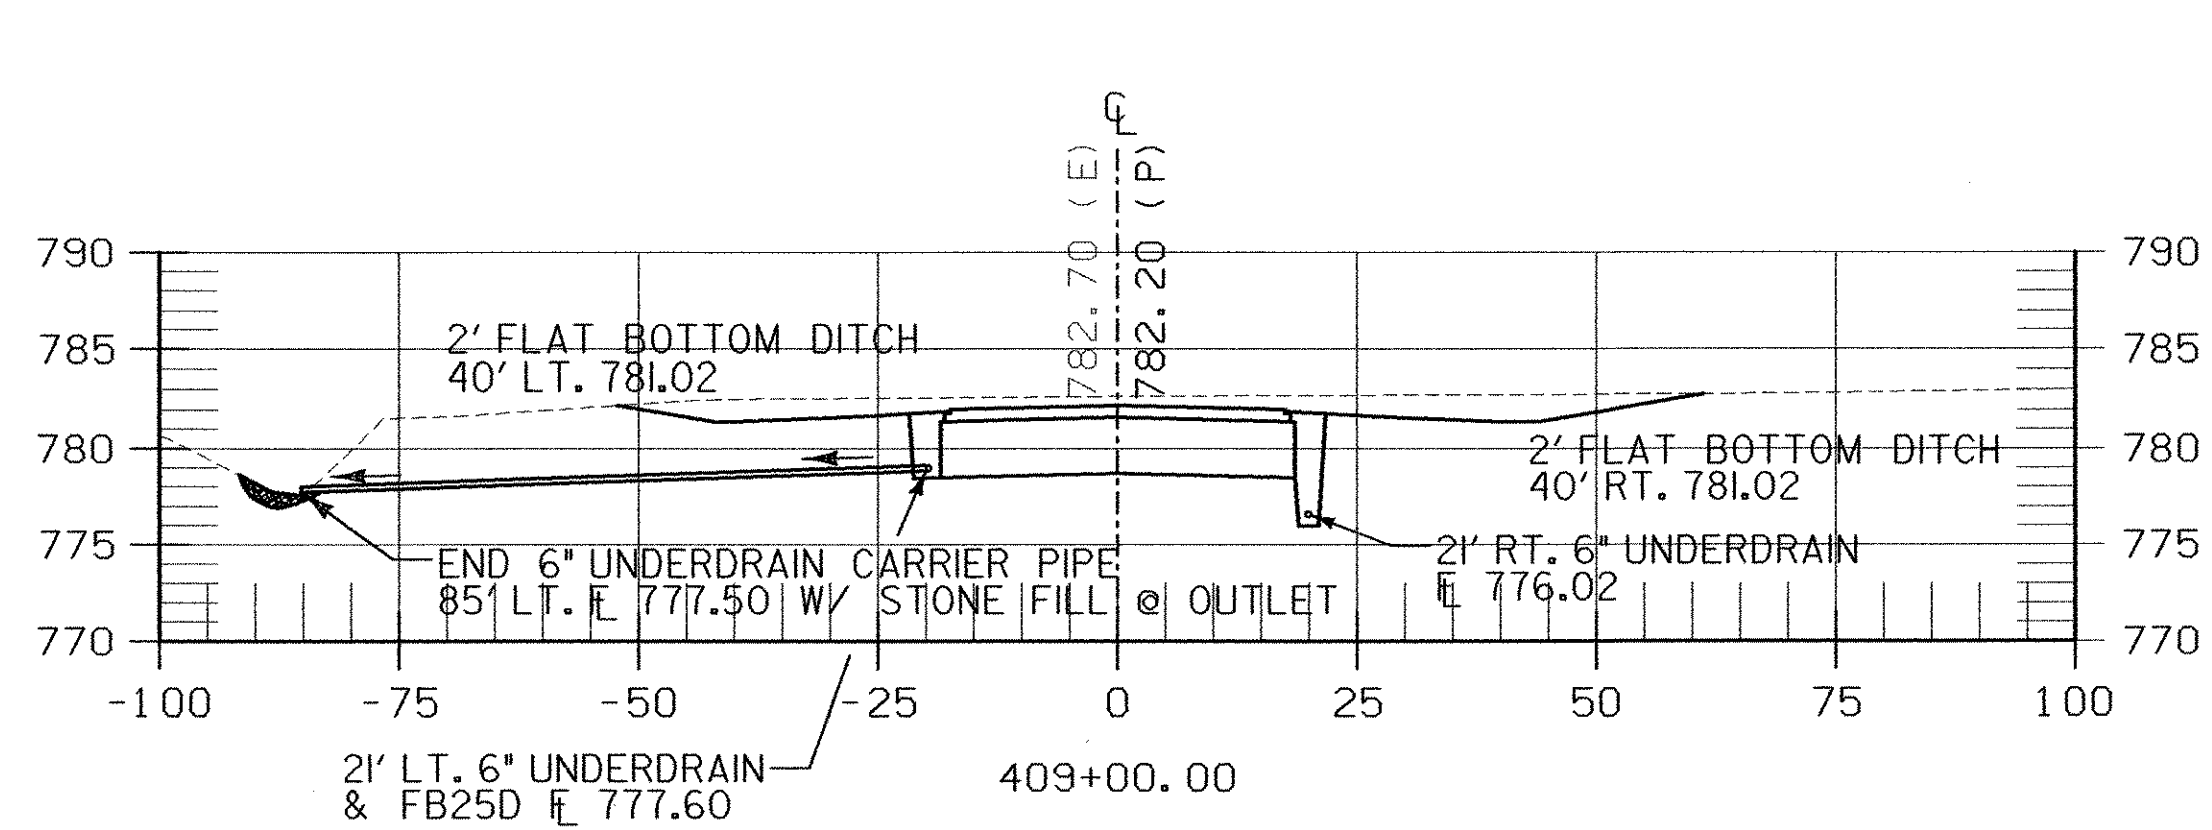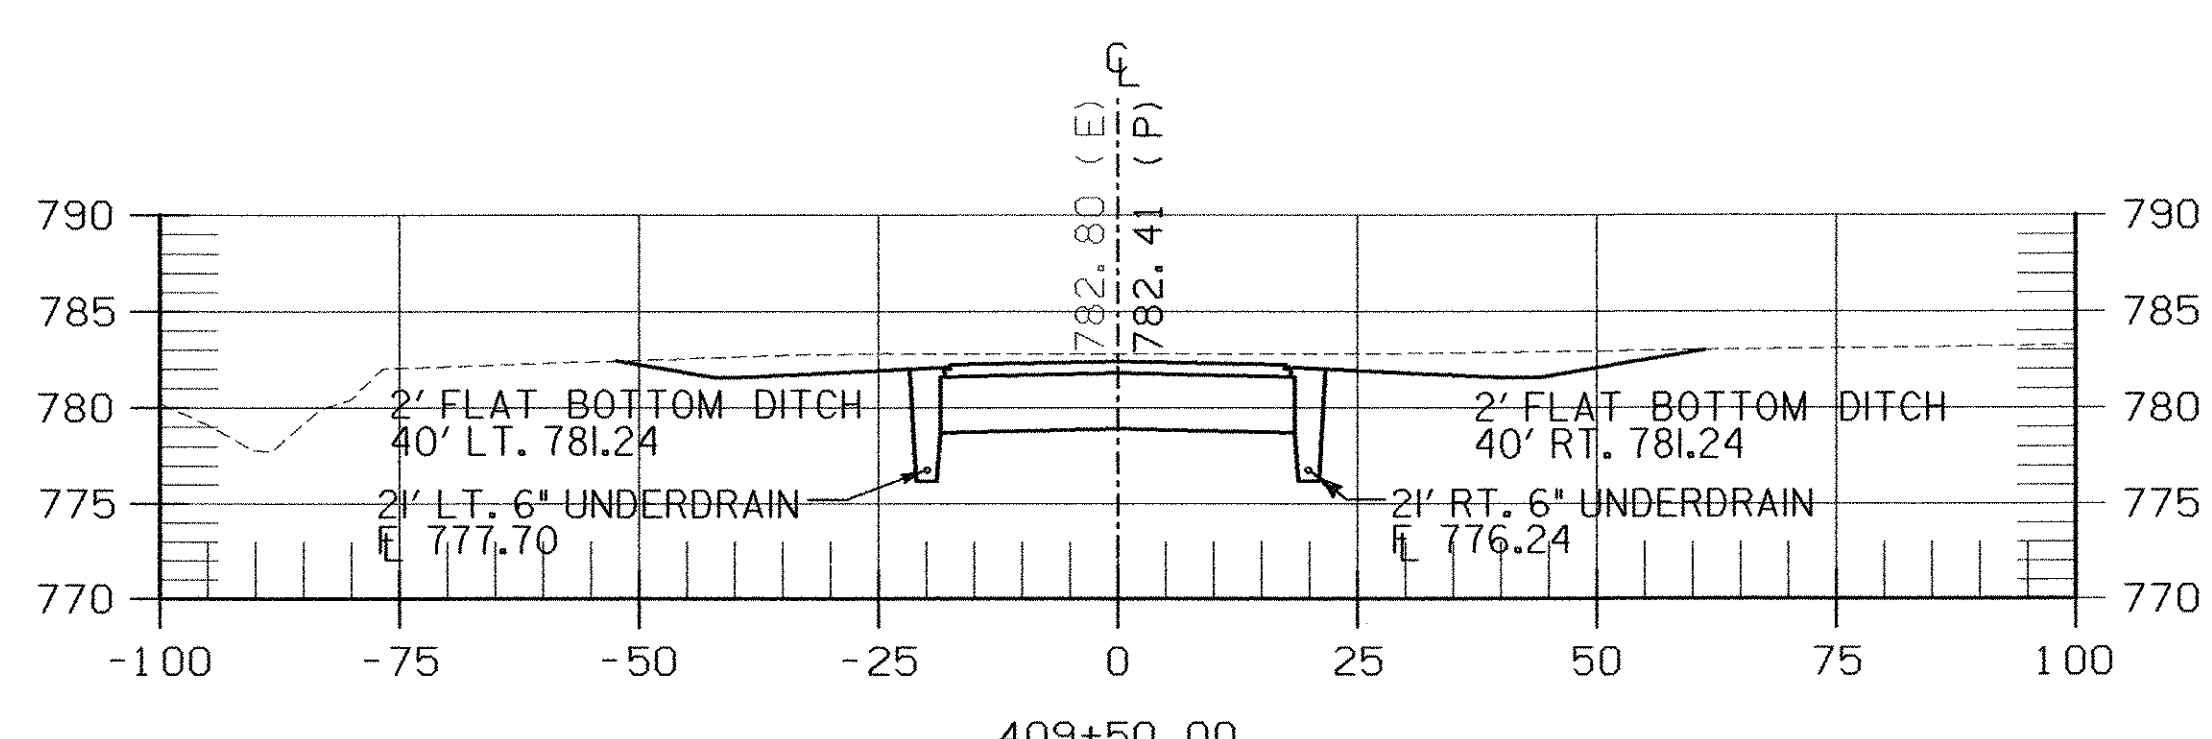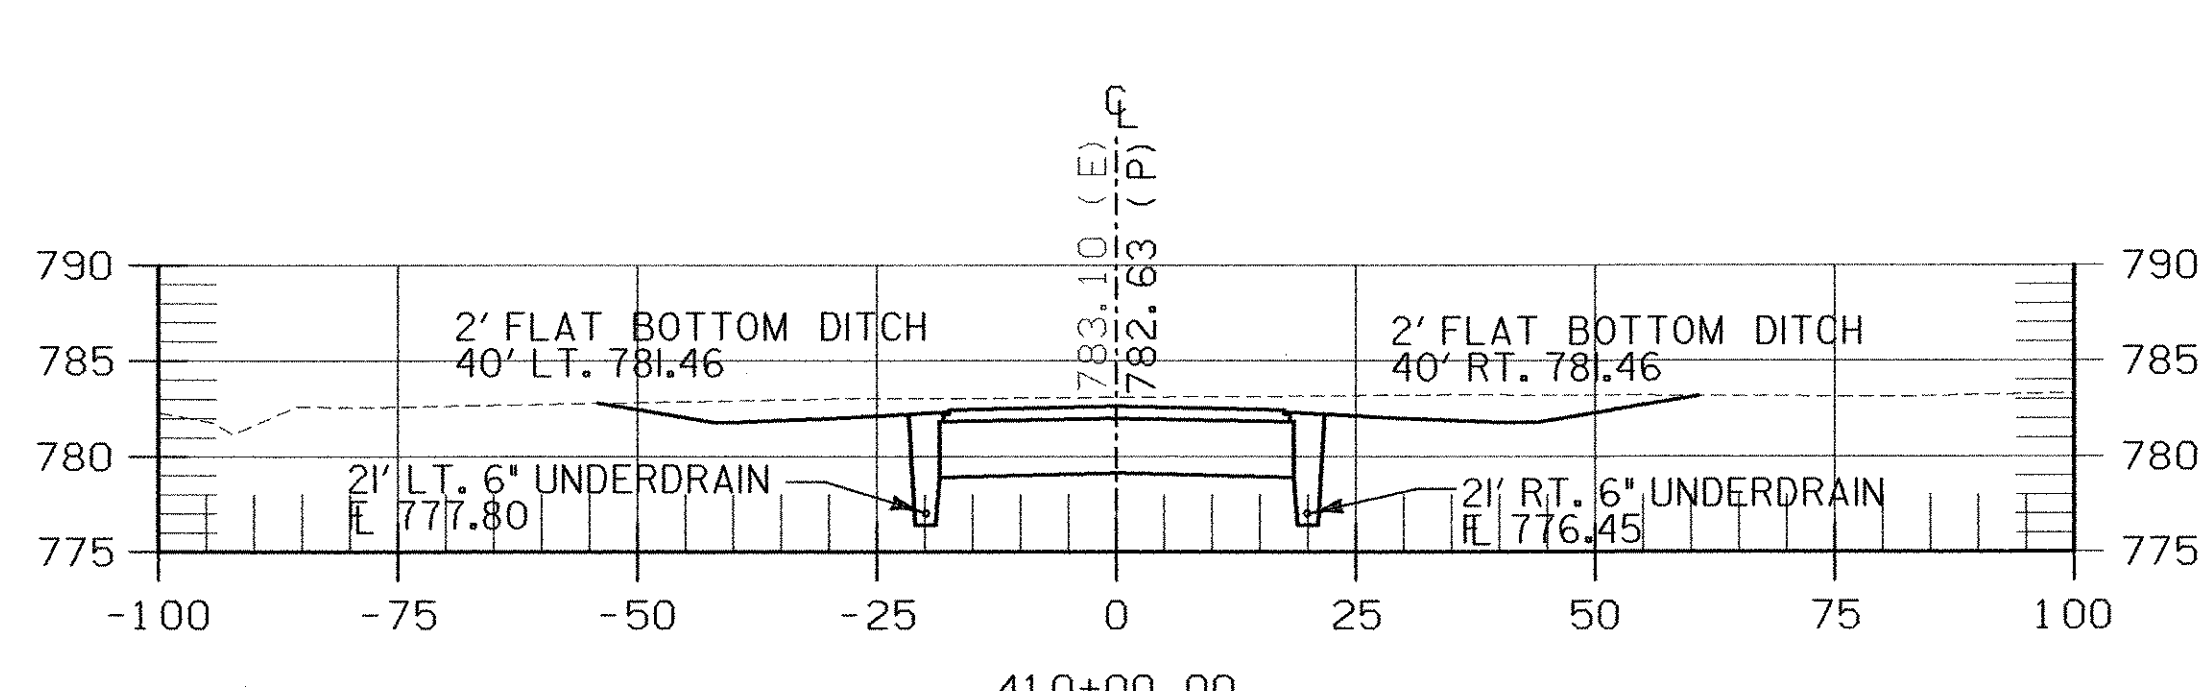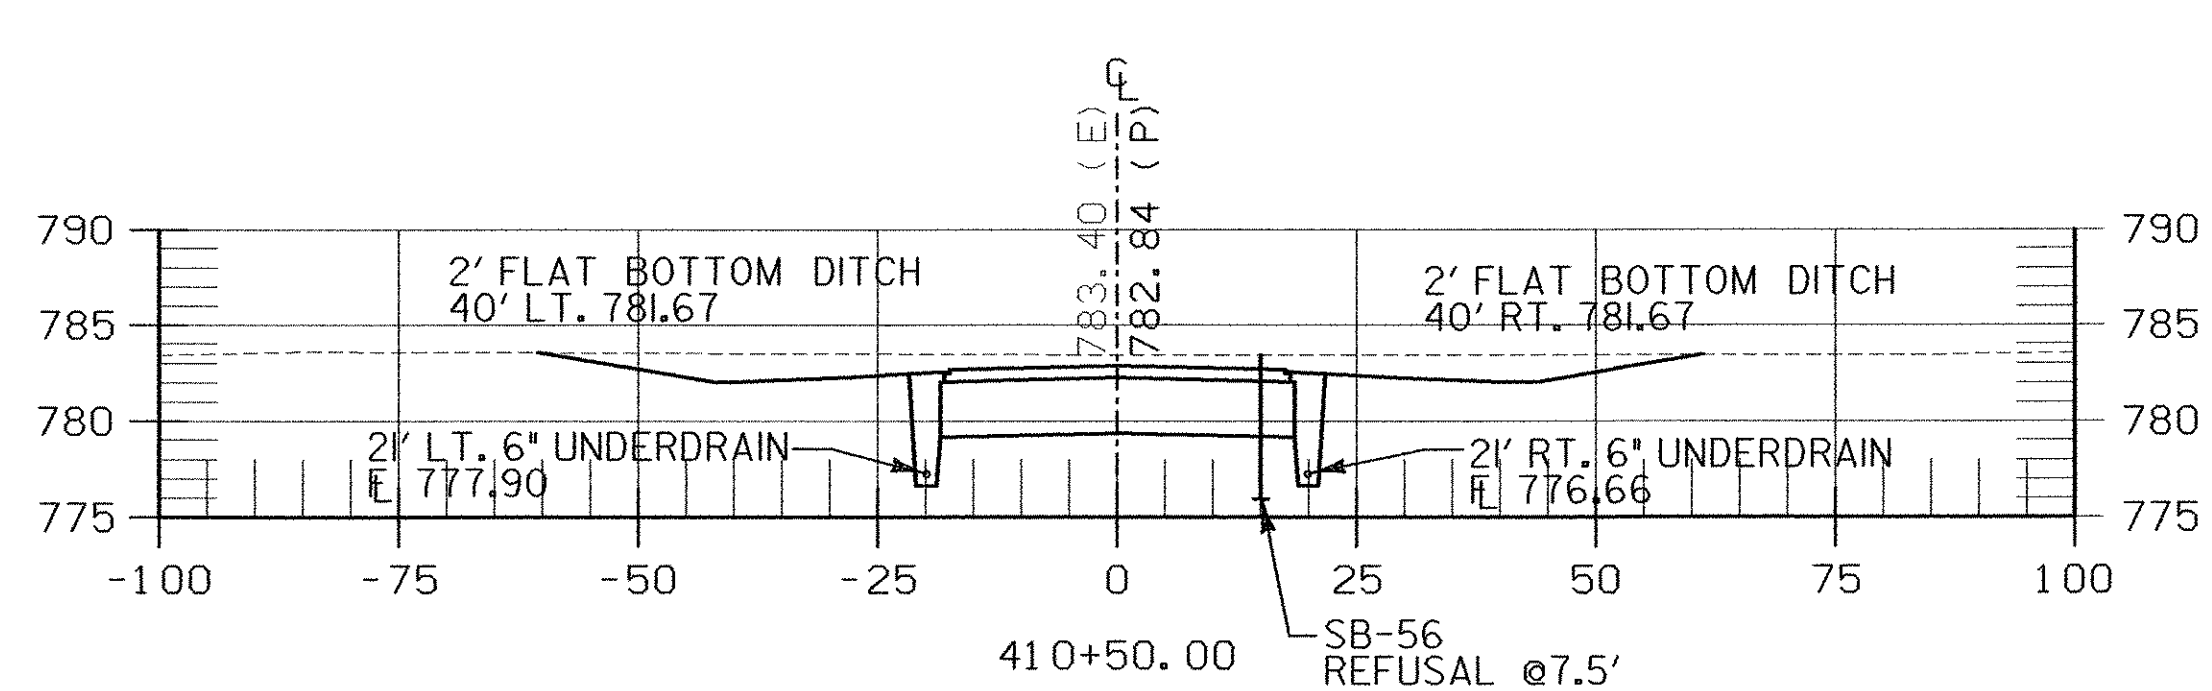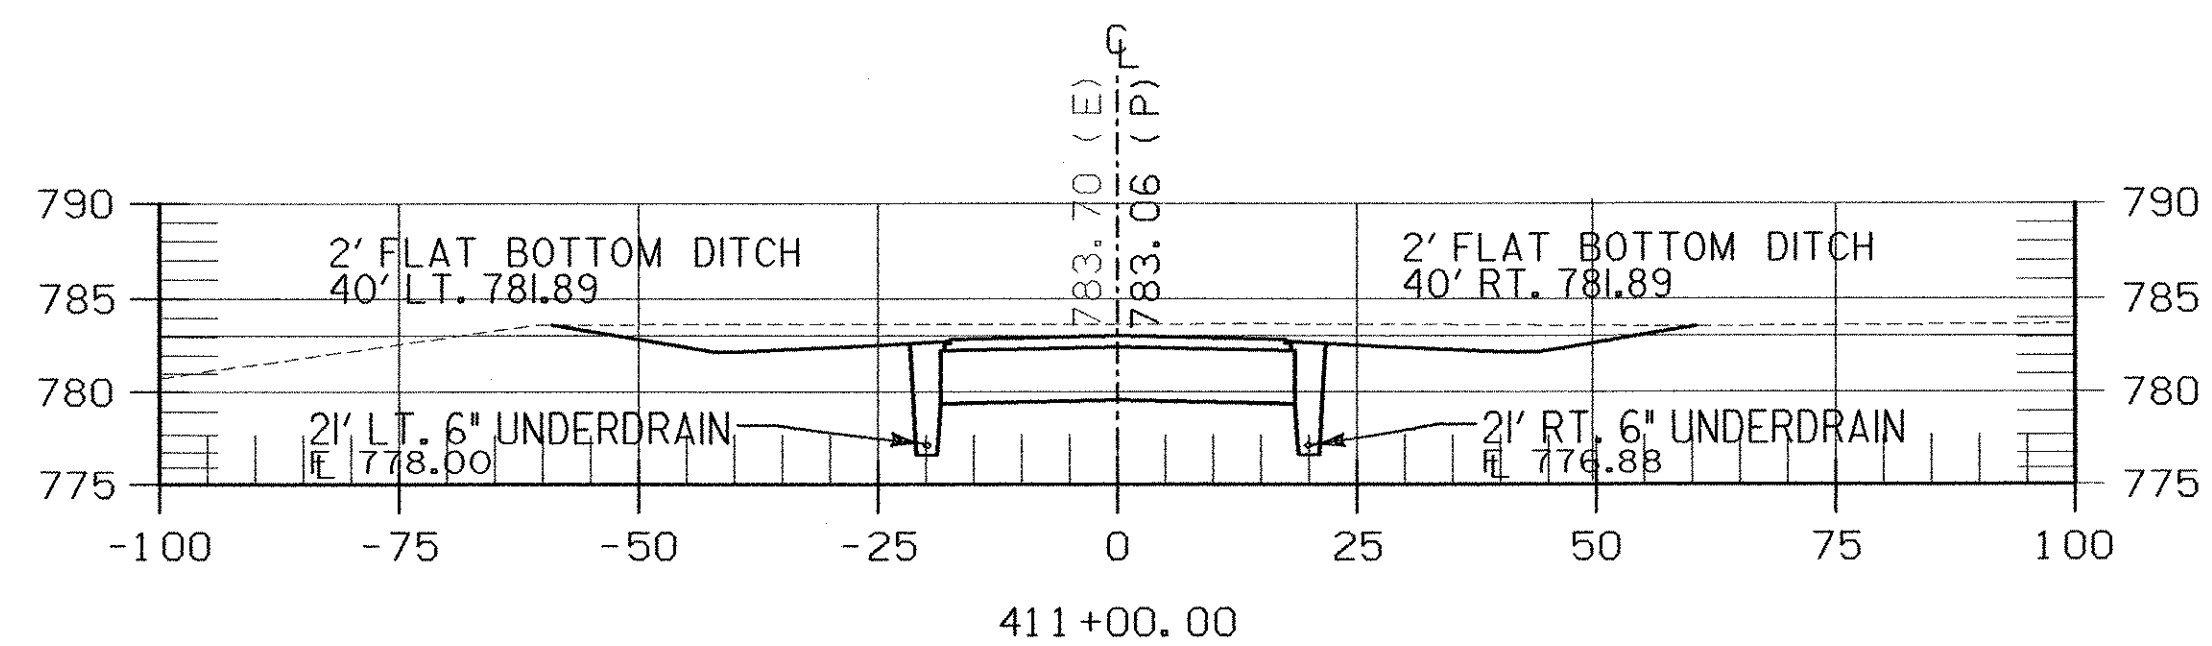

PROJECT "A"
A.I.P. 3-50-0015-17

P:\CIVIL\Sheet\0072002\F2020460d32.dgn

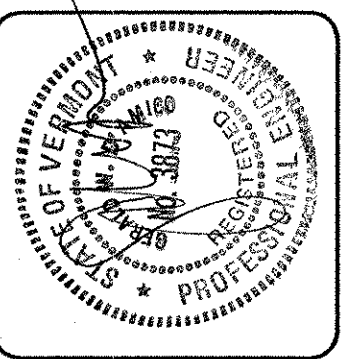

REV.	DATE	DESCRIPTION

File No. F200002046.00
Job No. F200002046.00

RUTLAND STATE AIRPORT
CLARENDON, VERMONT

CROSS SECTIONS
TAXIWAY "F"

URS
1 NORTHWAY LN.
LATHAM, NEW YORK












Designed by G.W.D.
Drawn by M.C.M.
Checked by M.C.C.
Approved by G.W.D.

Scale: AS SHOWN

Date: FEB., 2003

Sheet 33 OF 40

Sheet No
33

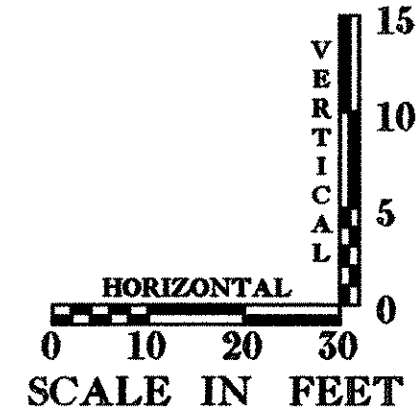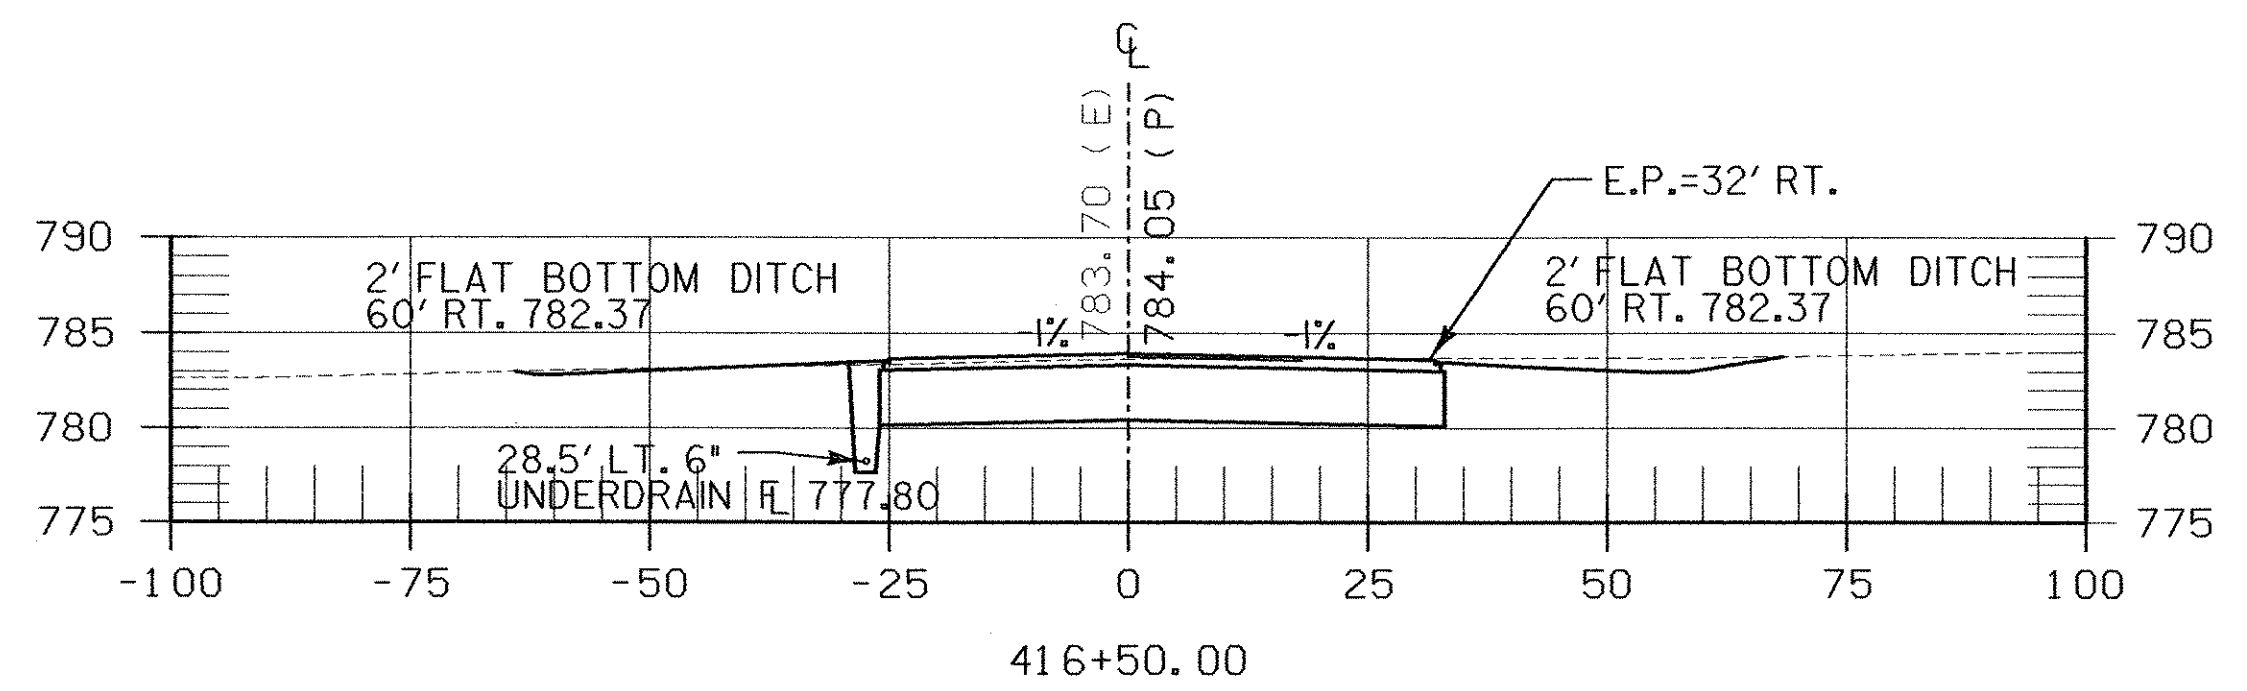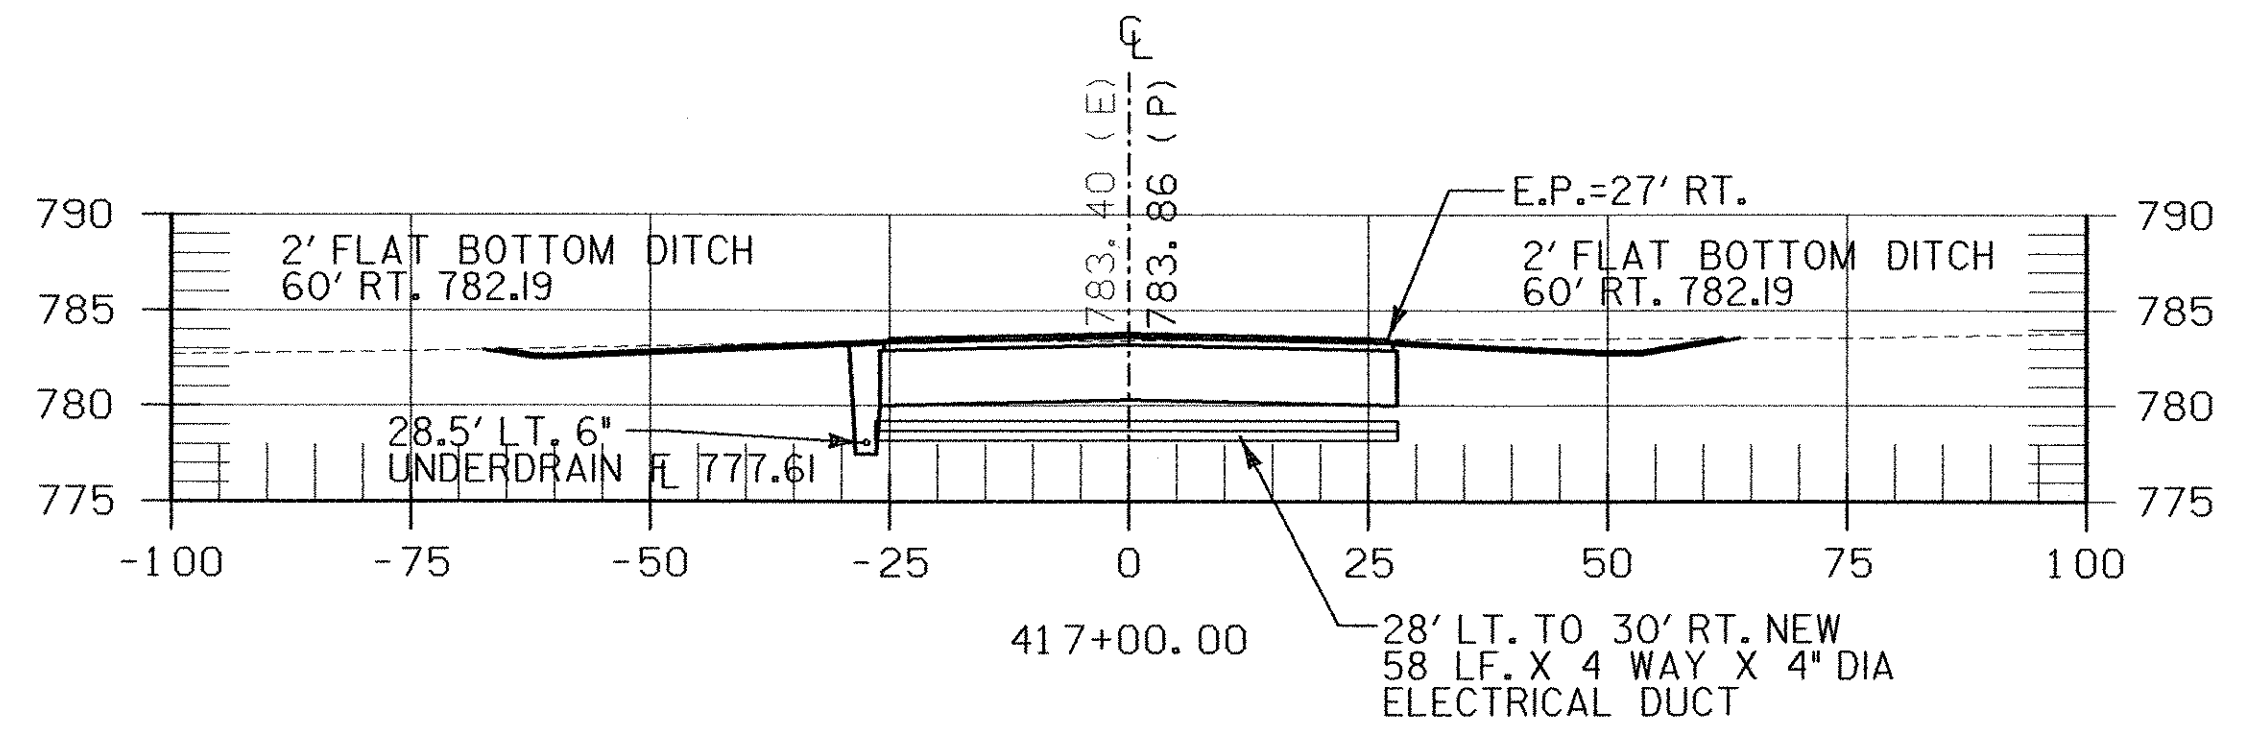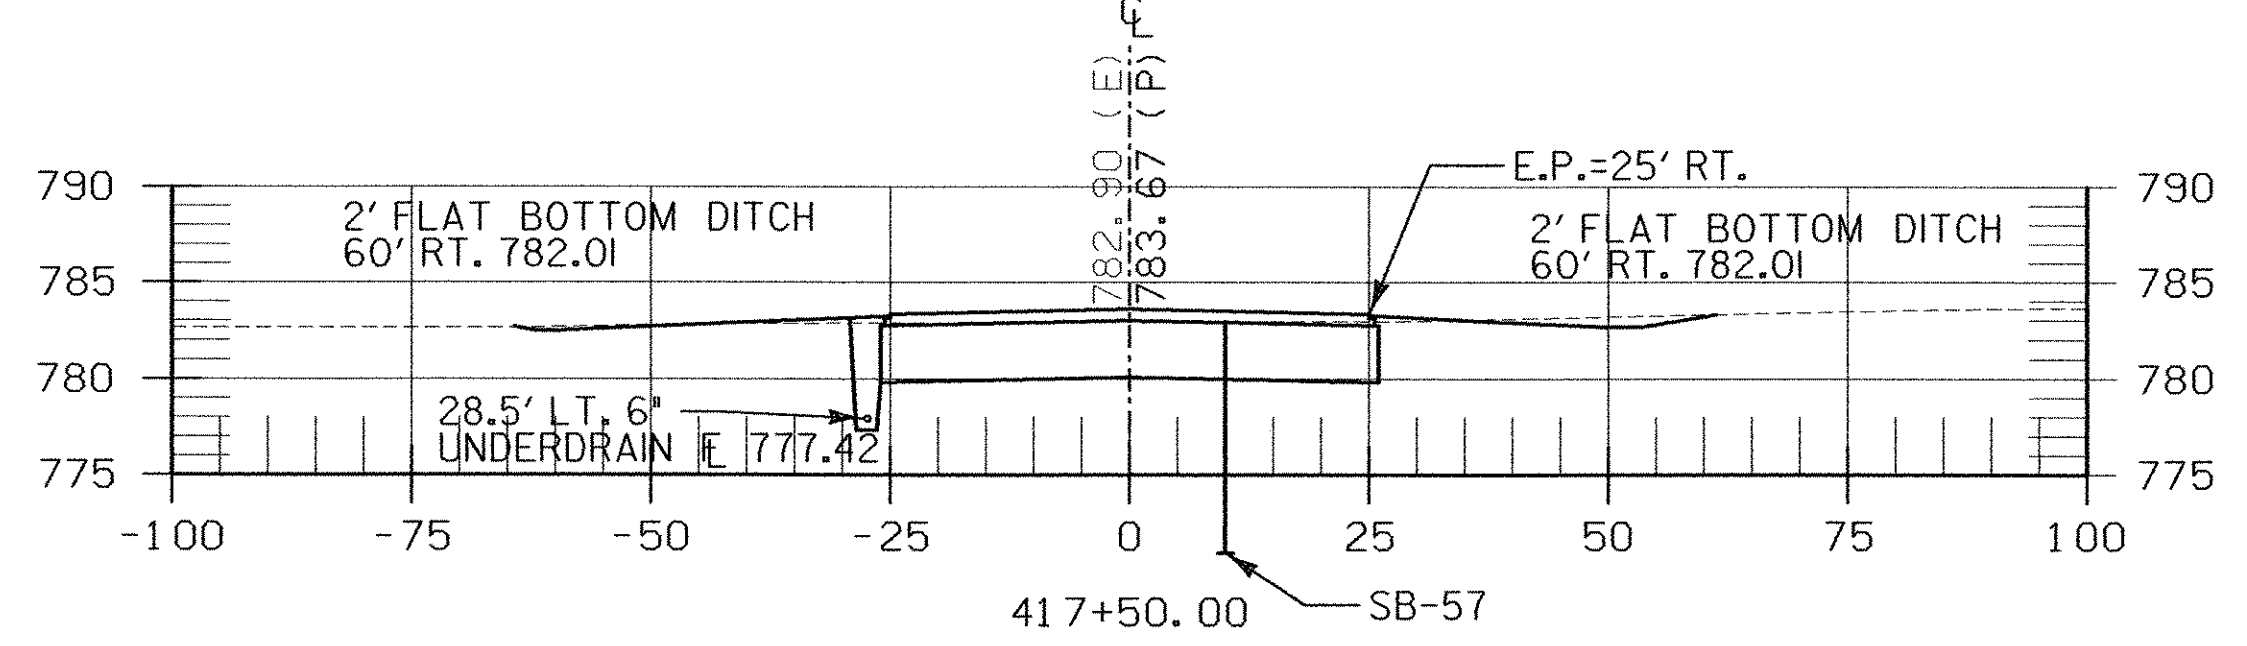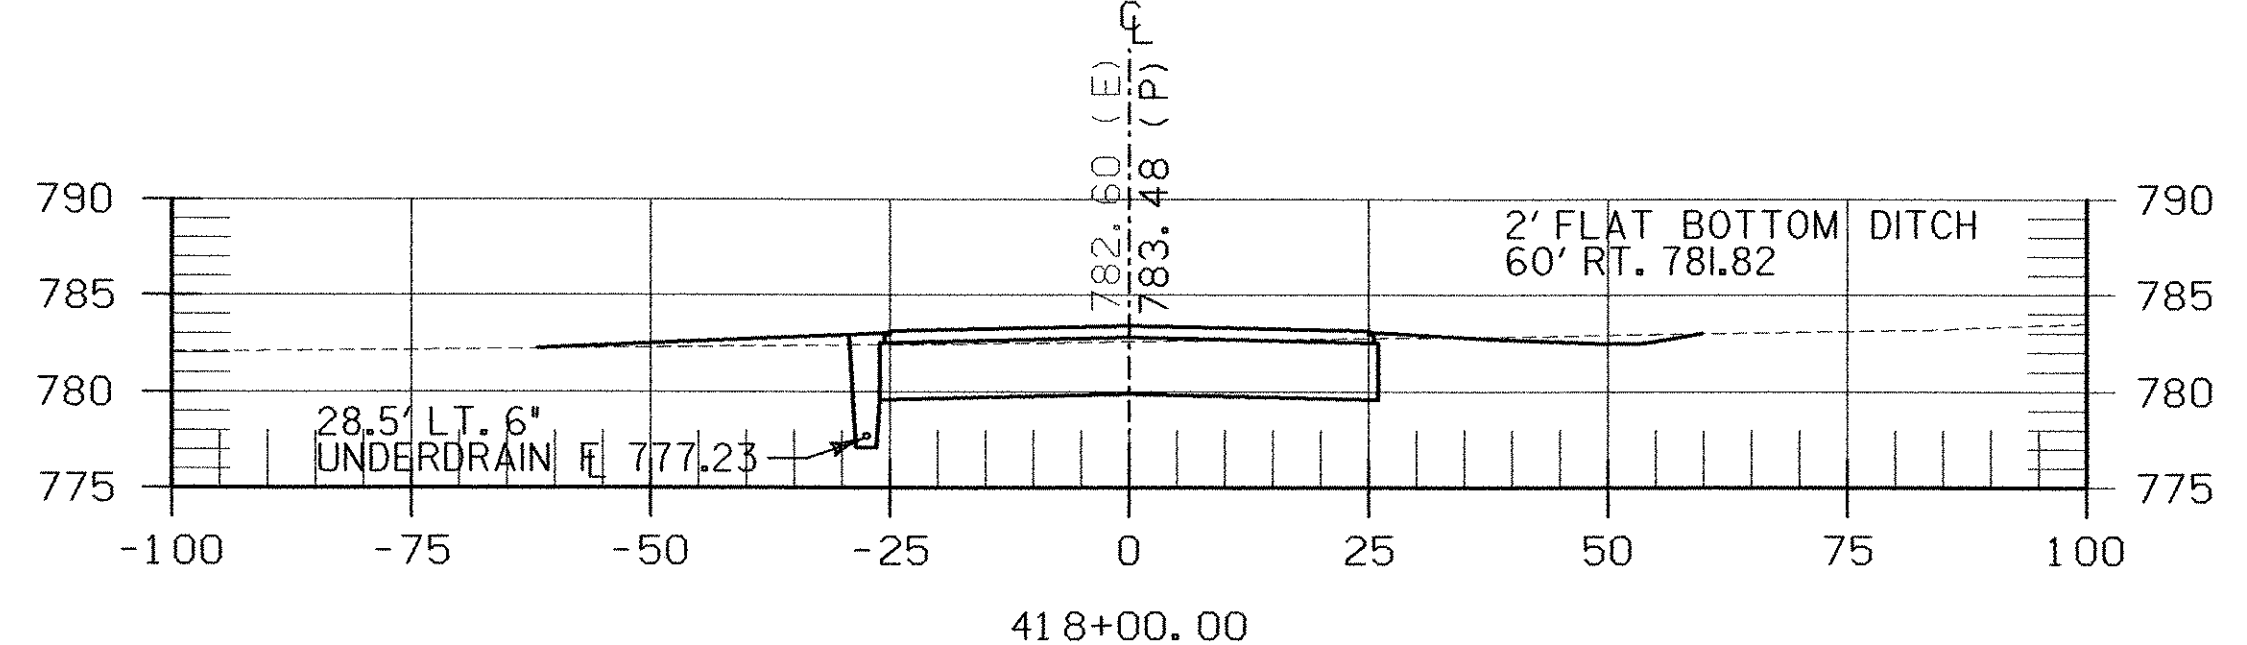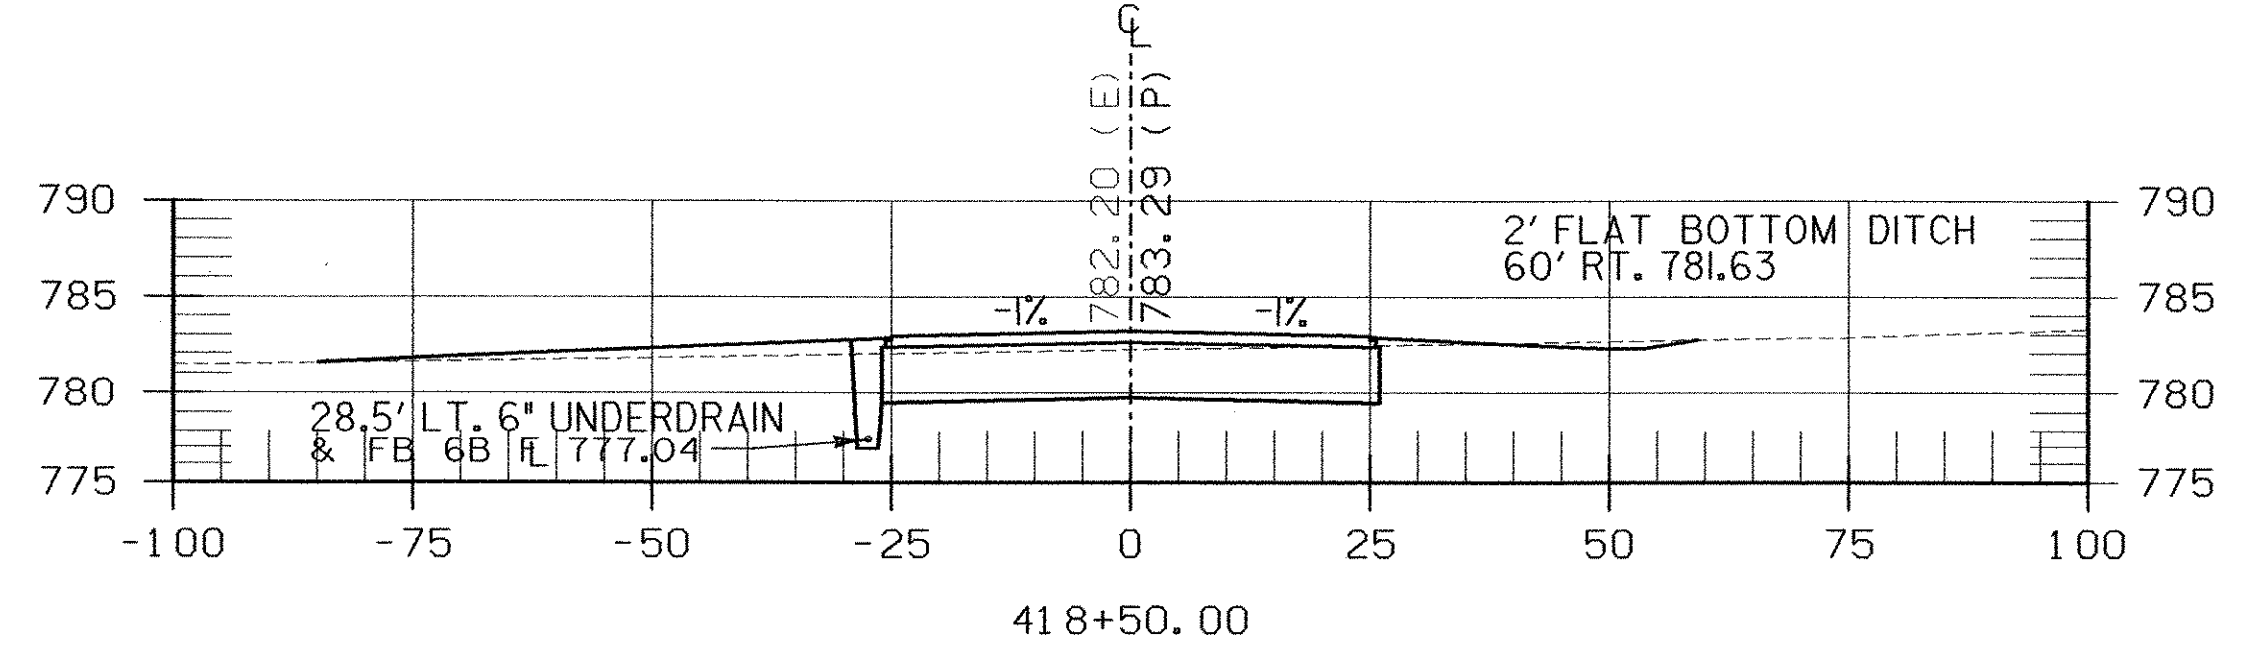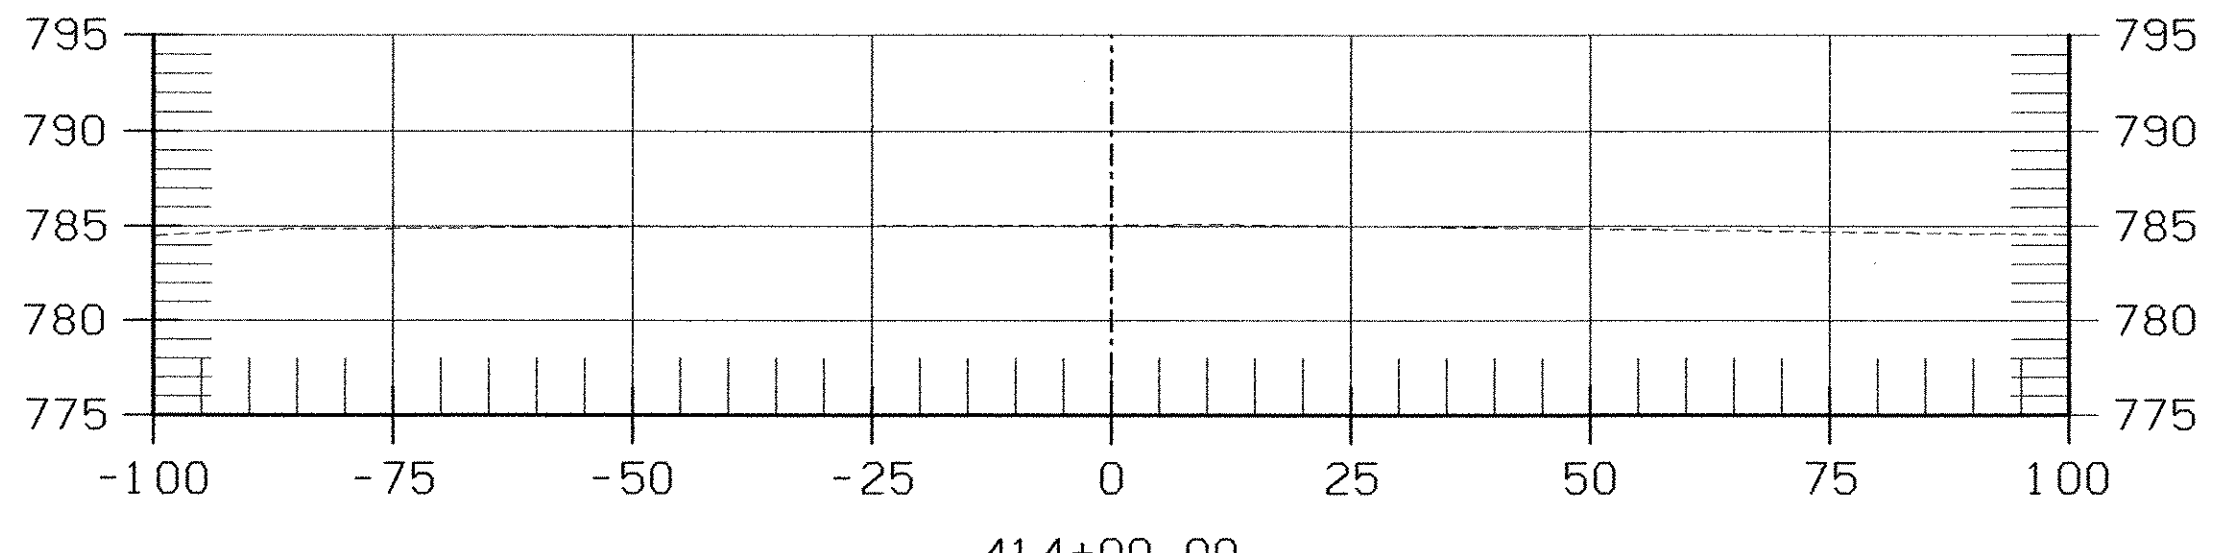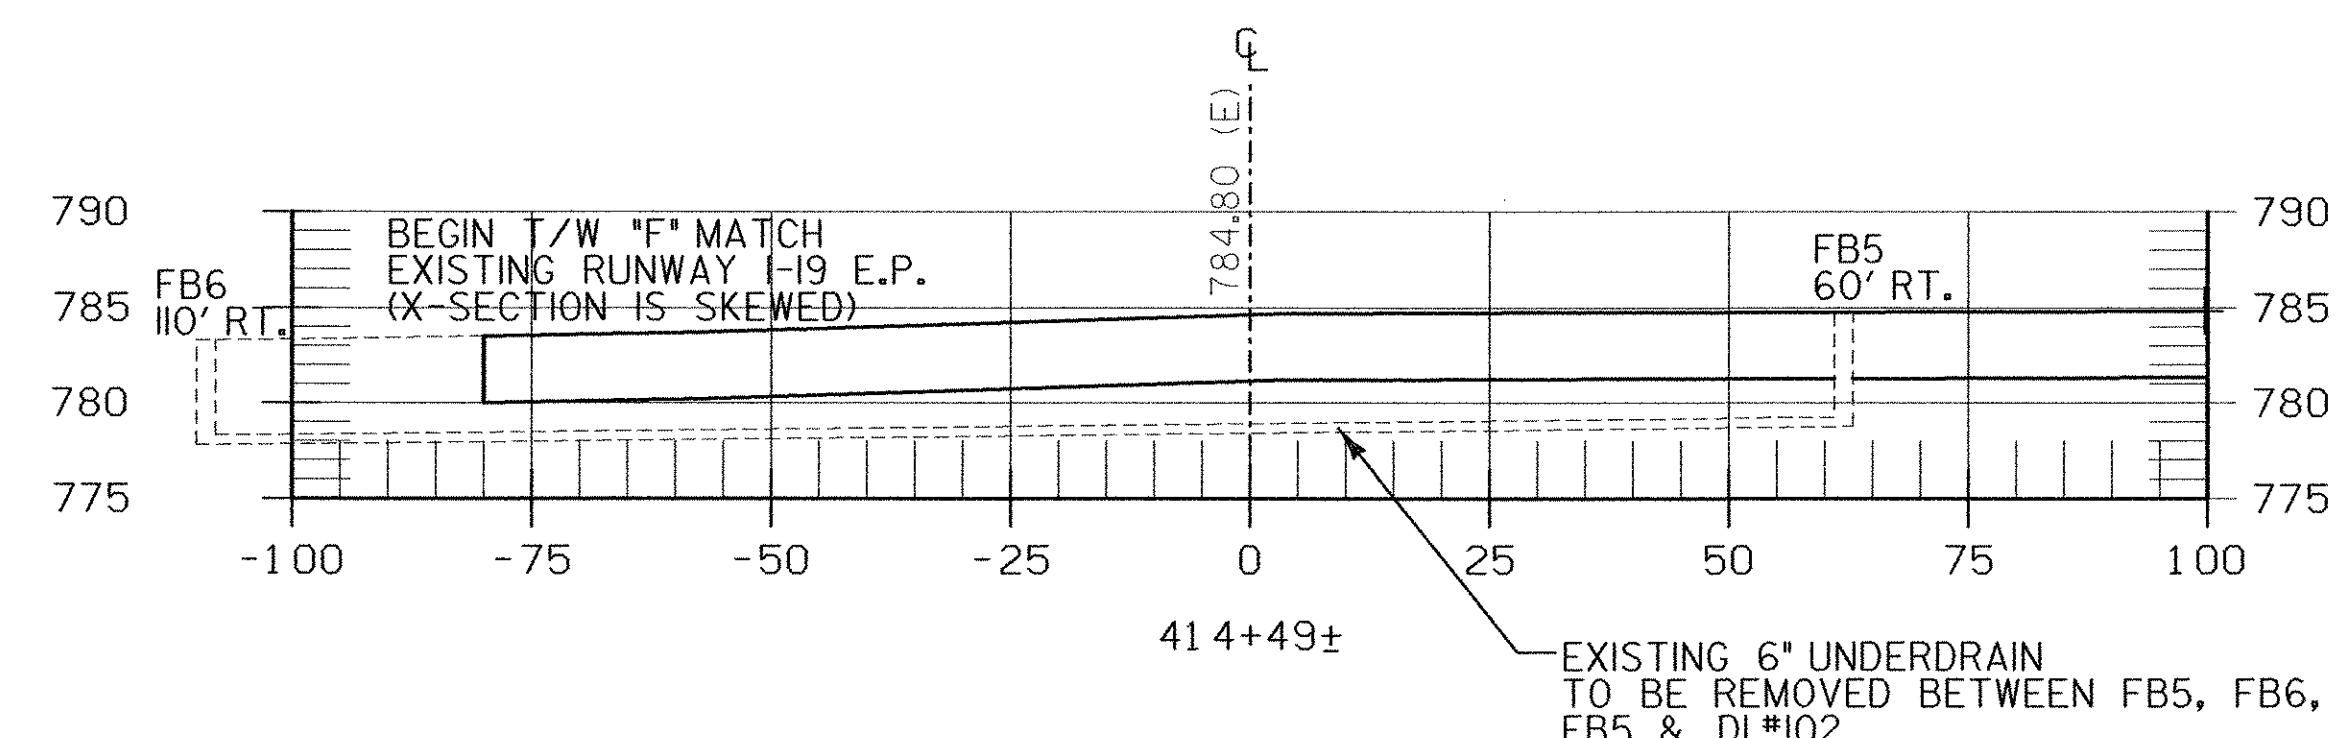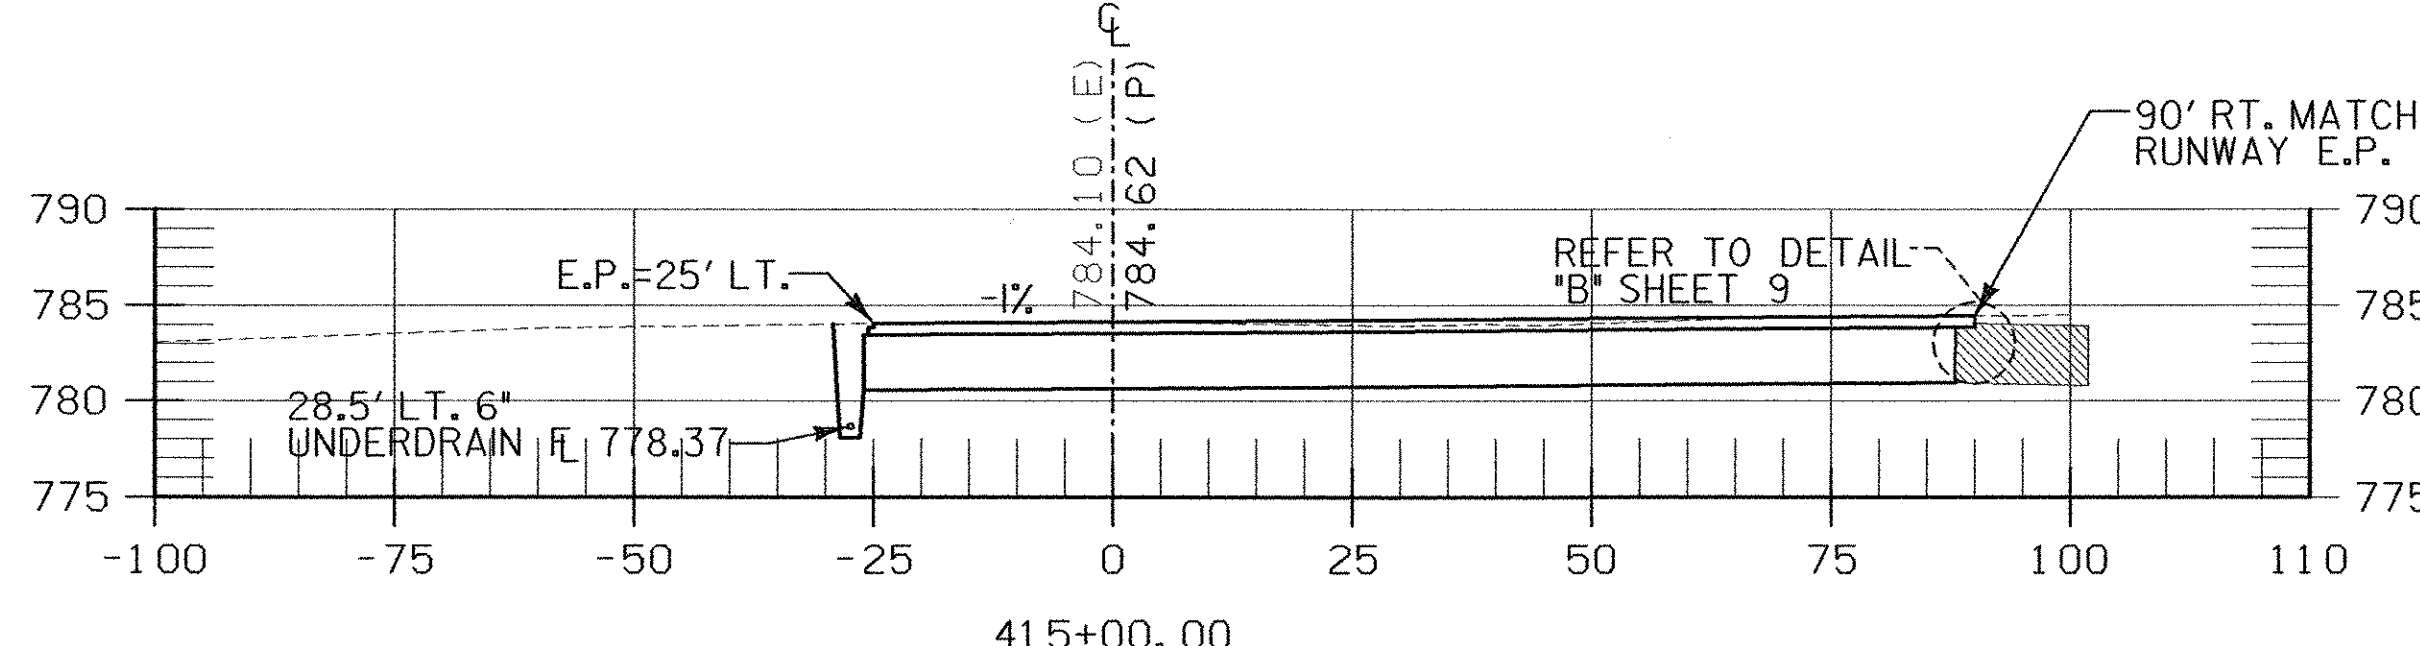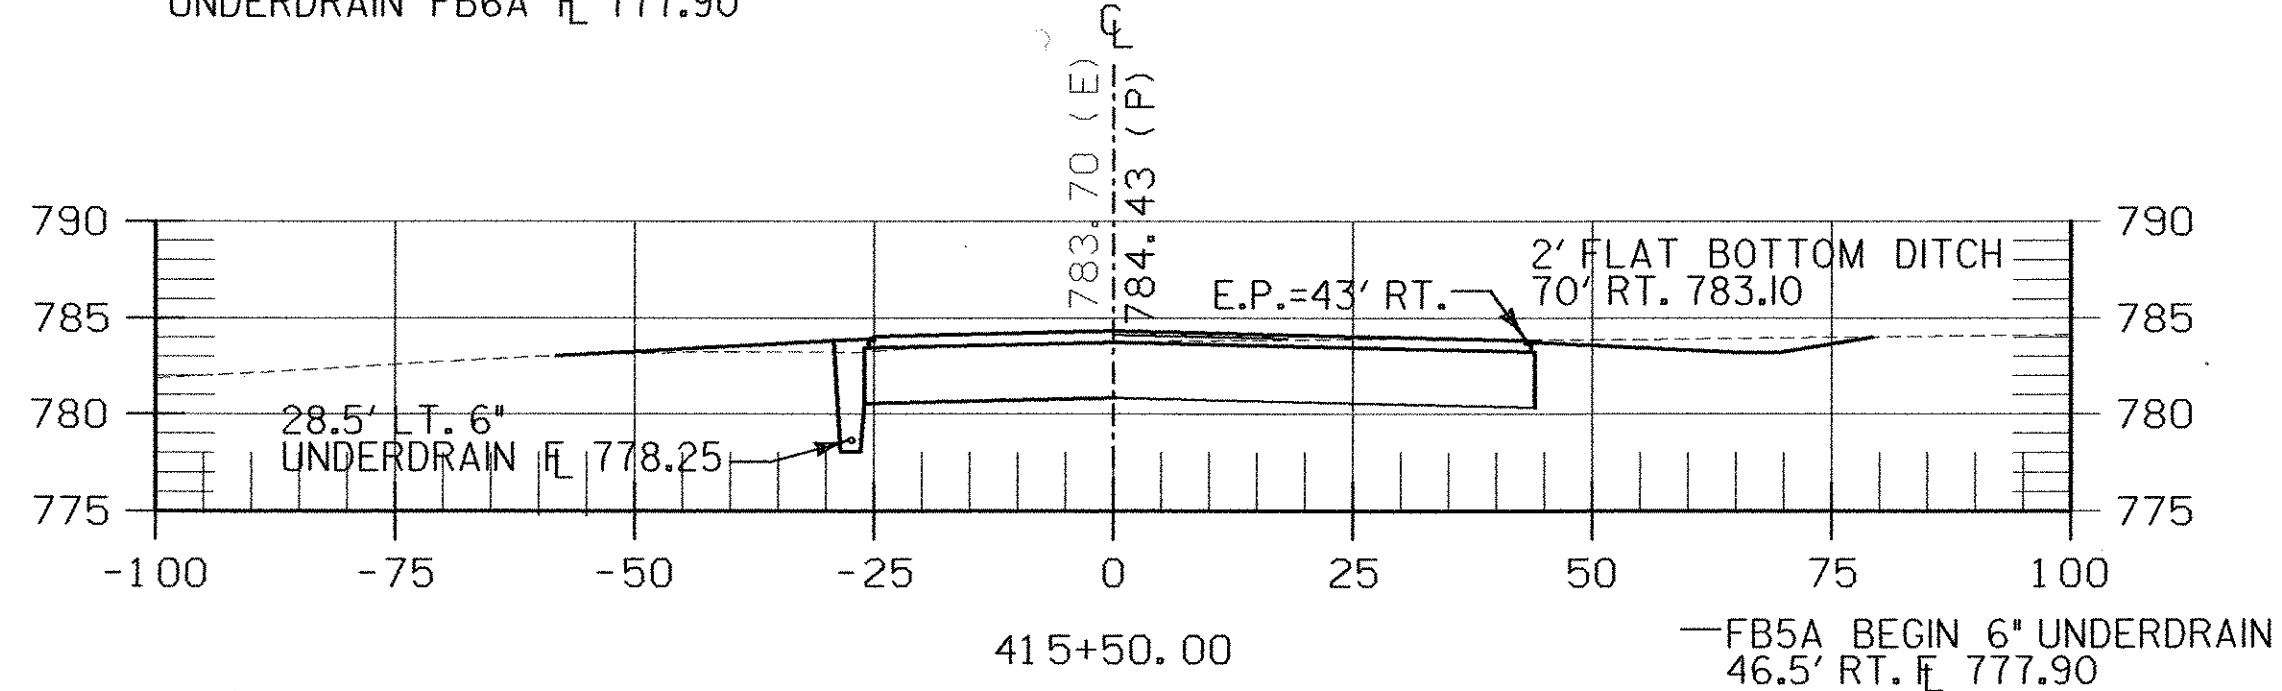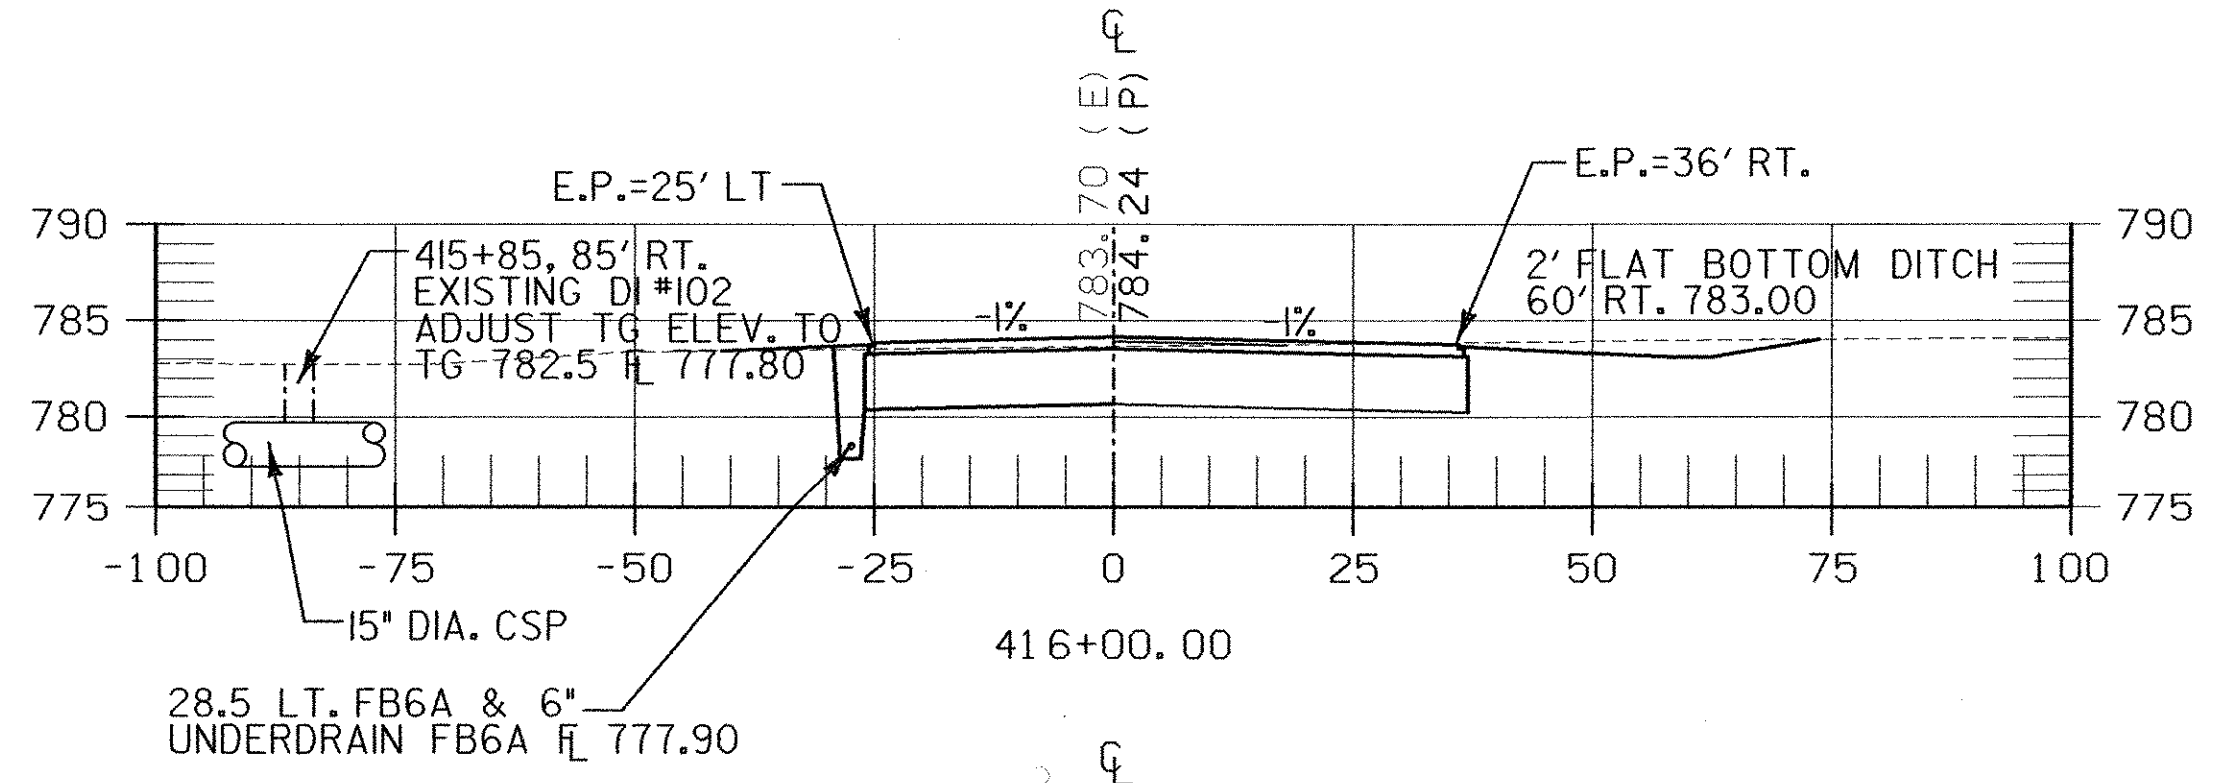

PROJECT "B"
A.I.P. 3-50-0015-17



REV.	DATE	DESCRIPTION



Job No. F20002046.00
File No. F20204601d34

RUTLAND STATE AIRPORT
CLARENDON, VERMONT






CROSS SECTIONS
TAXIWAY "F"

URS
1 NORTHWAY LN.
LATHAM, NEW YORK


Designed by: G.W.D.	Scale: AS SHOWN
Drawn by: M.C.M.	Date: FEB., 2003
Checked by: M.A.C.	Sheet 34 OF 40
Approved by: G.W.D.	Sheet No 34

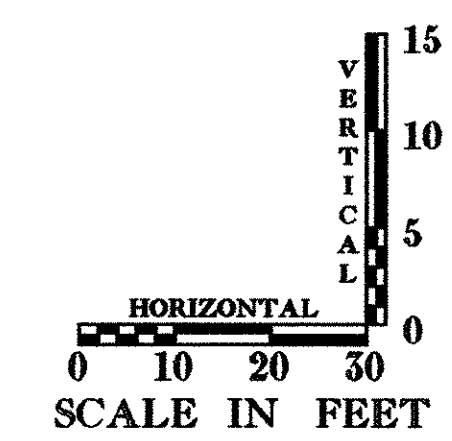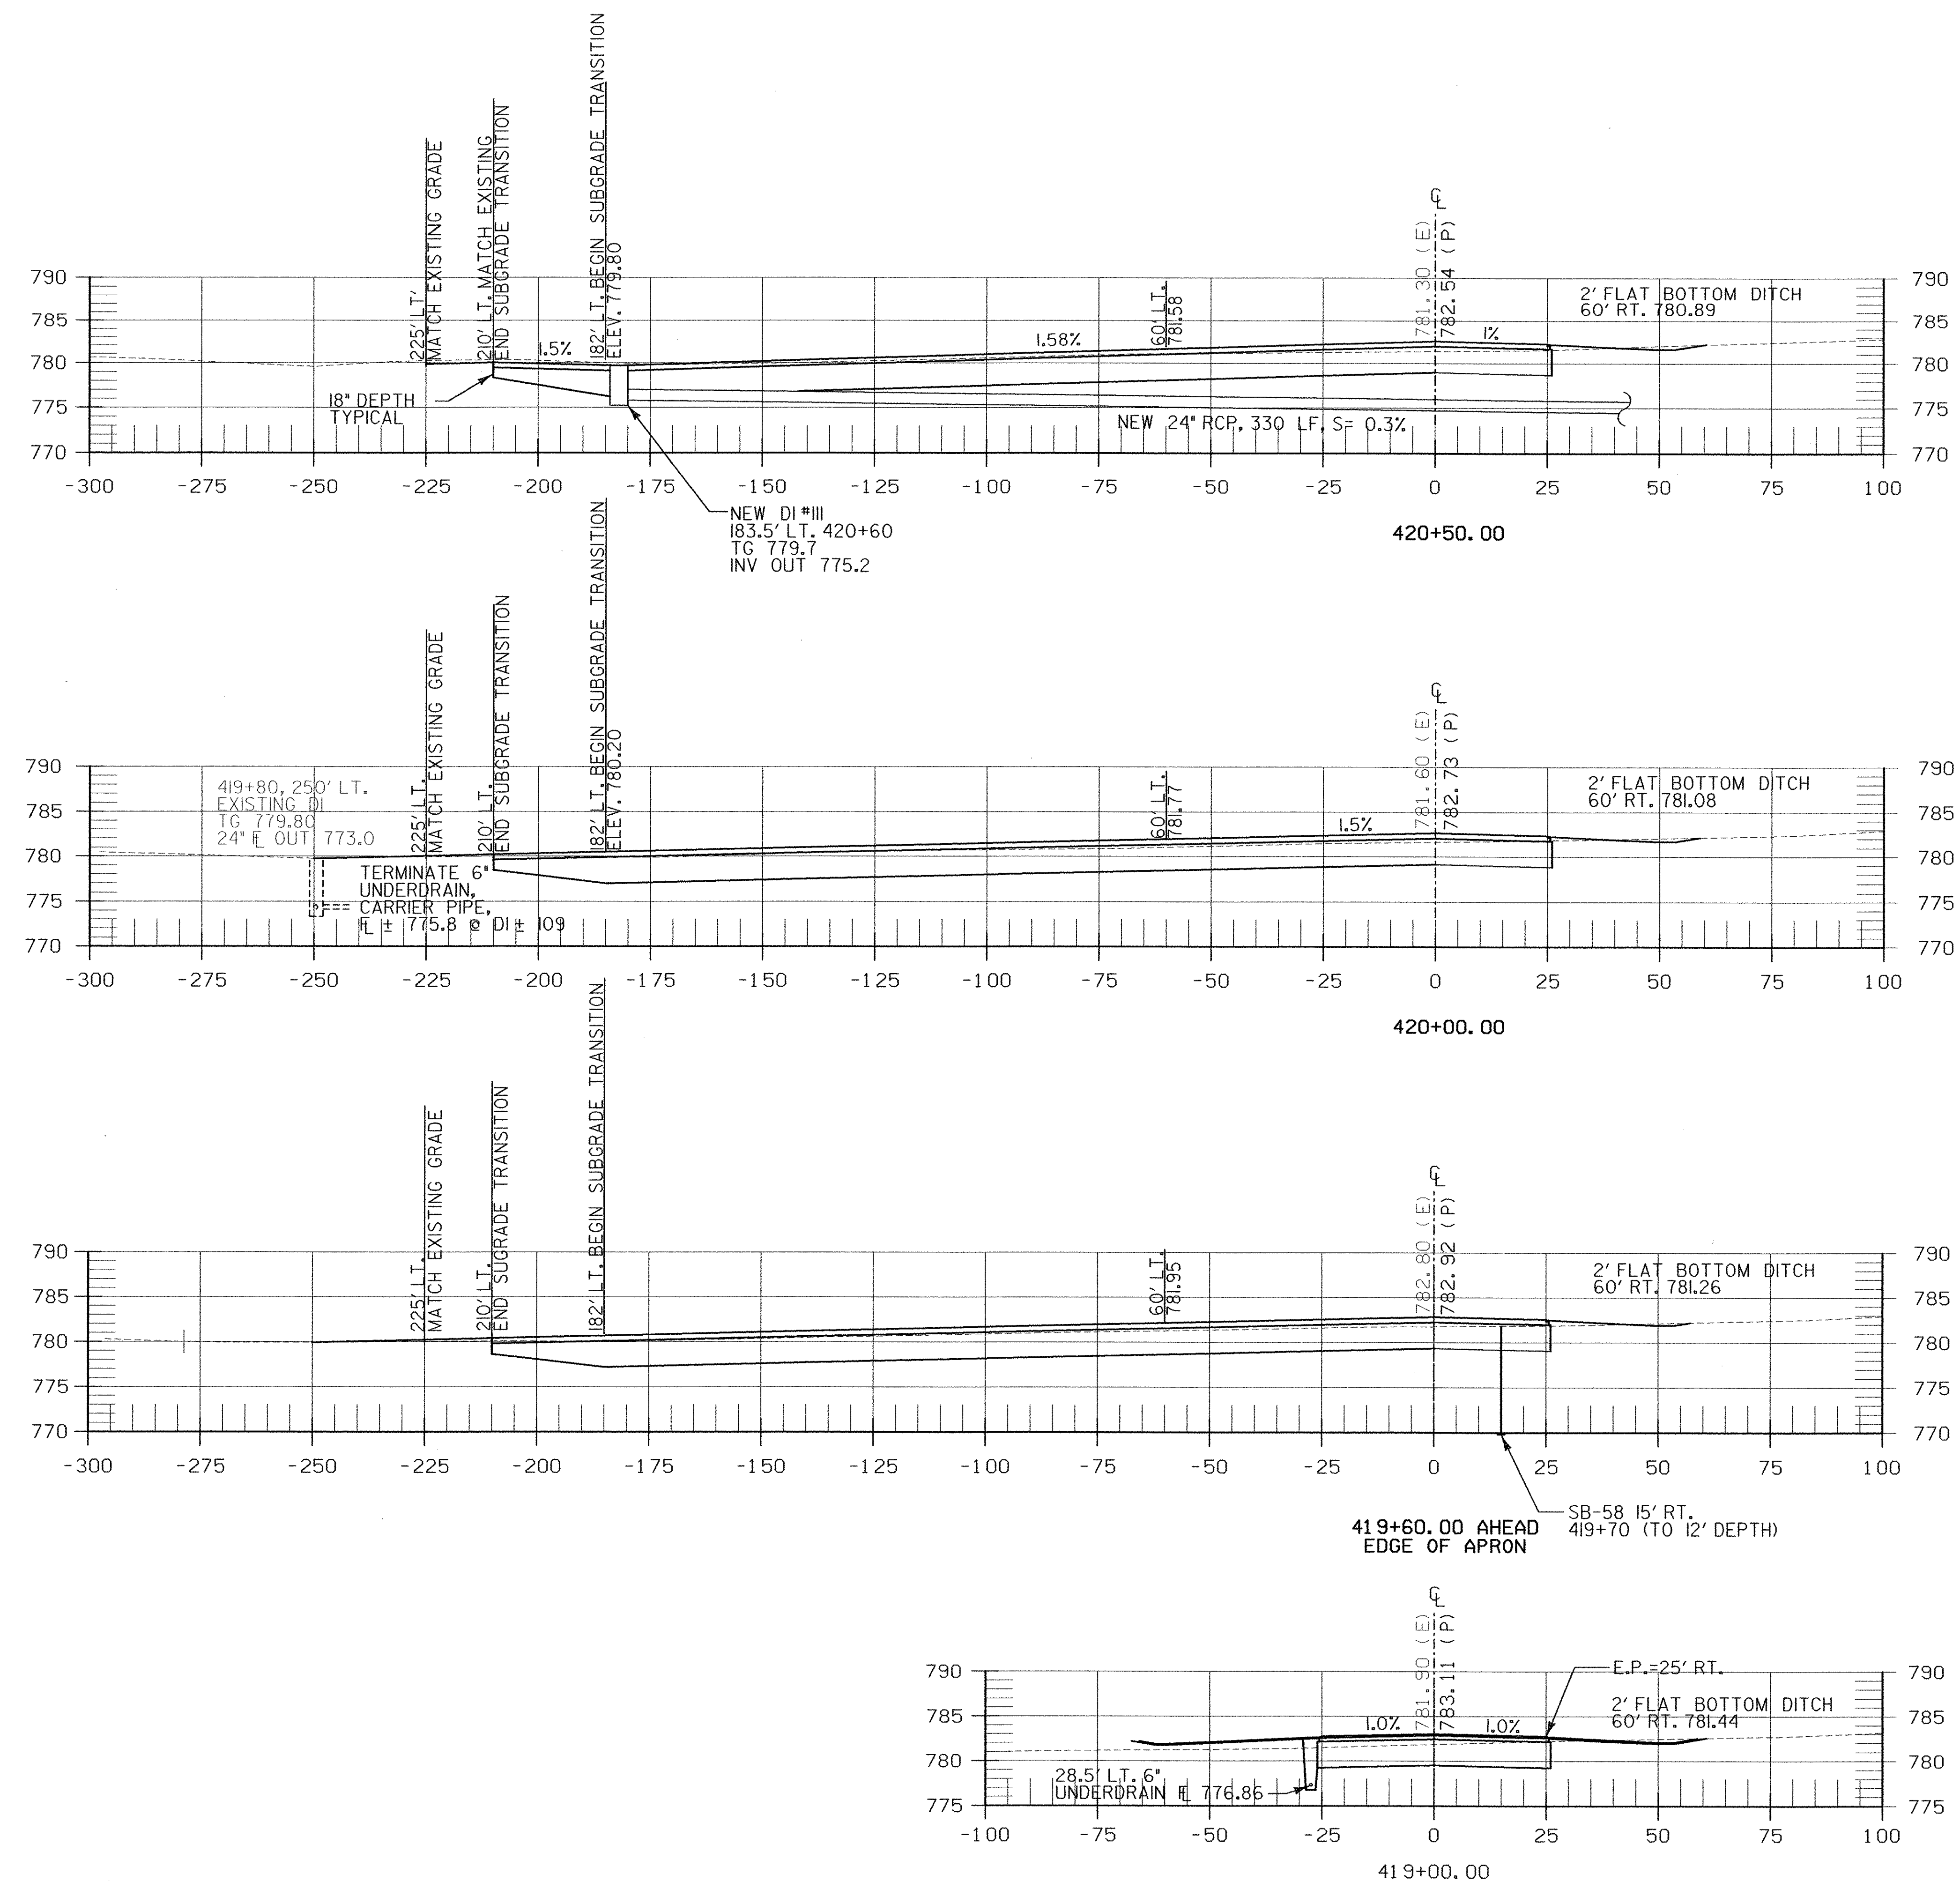

P:\CIVIL\Sheet\0015-17\0015-17.dgn

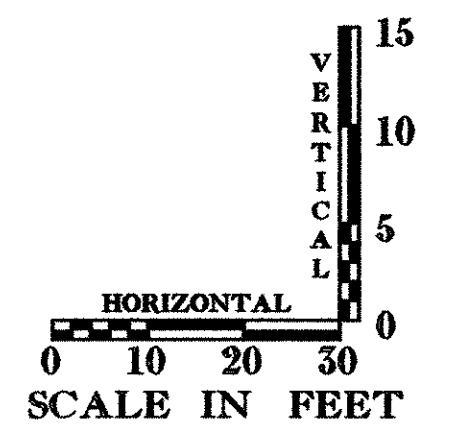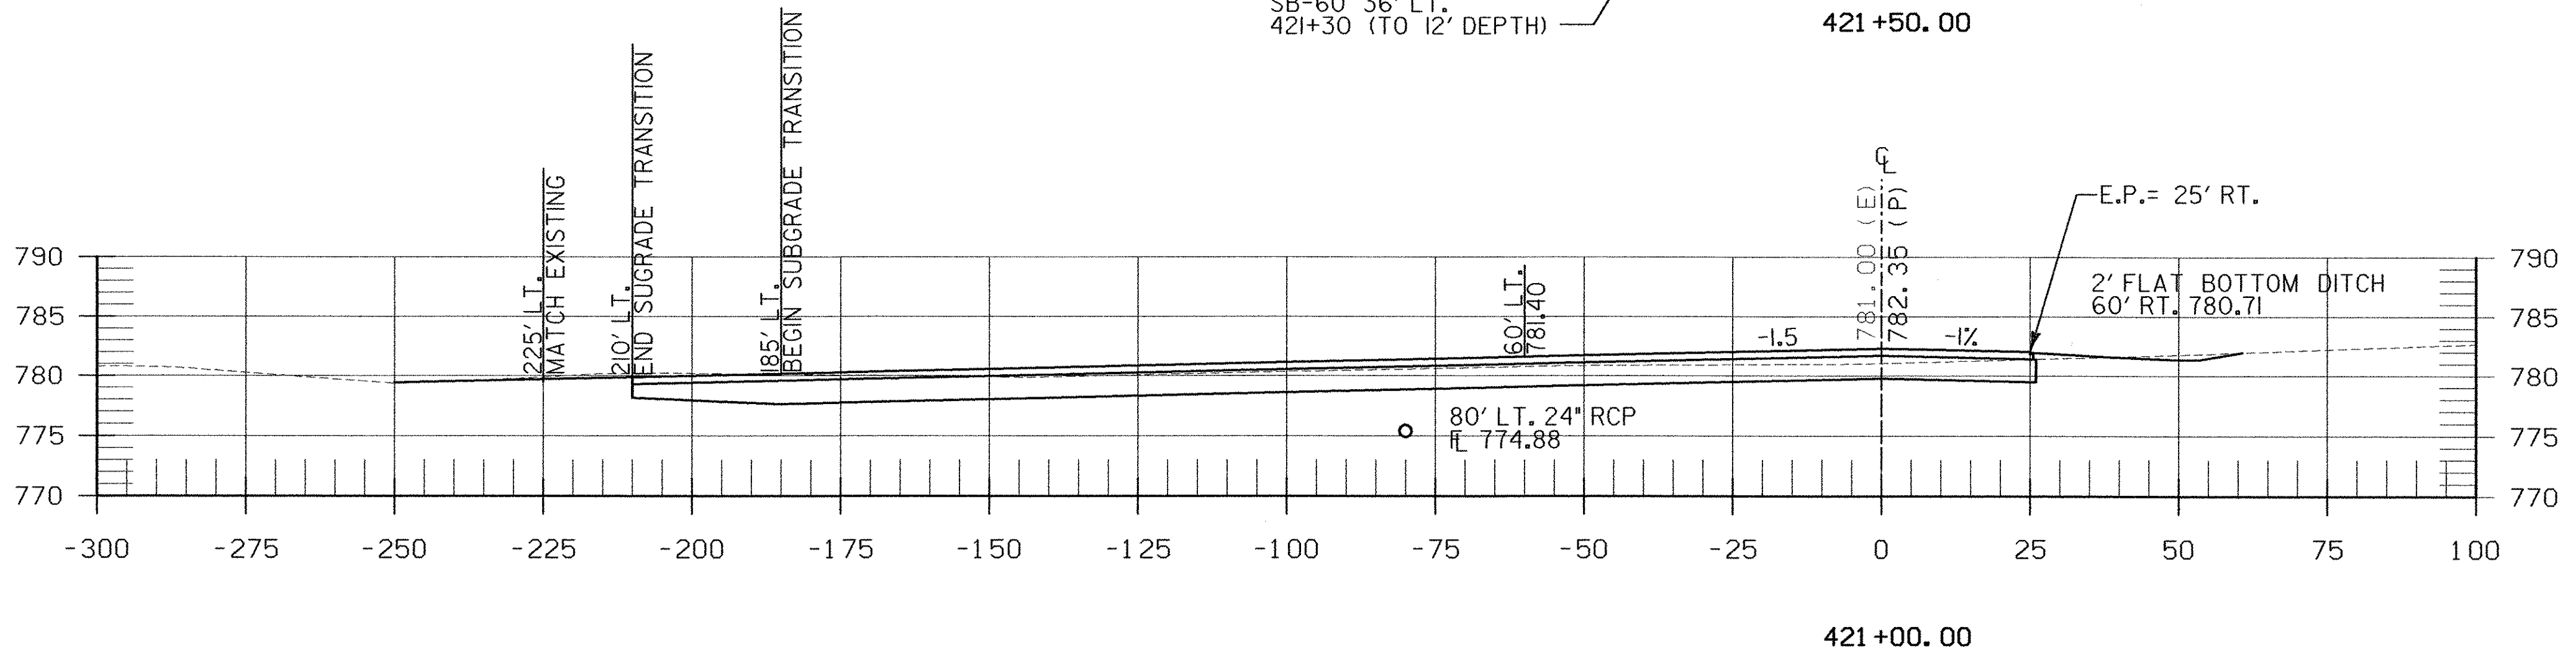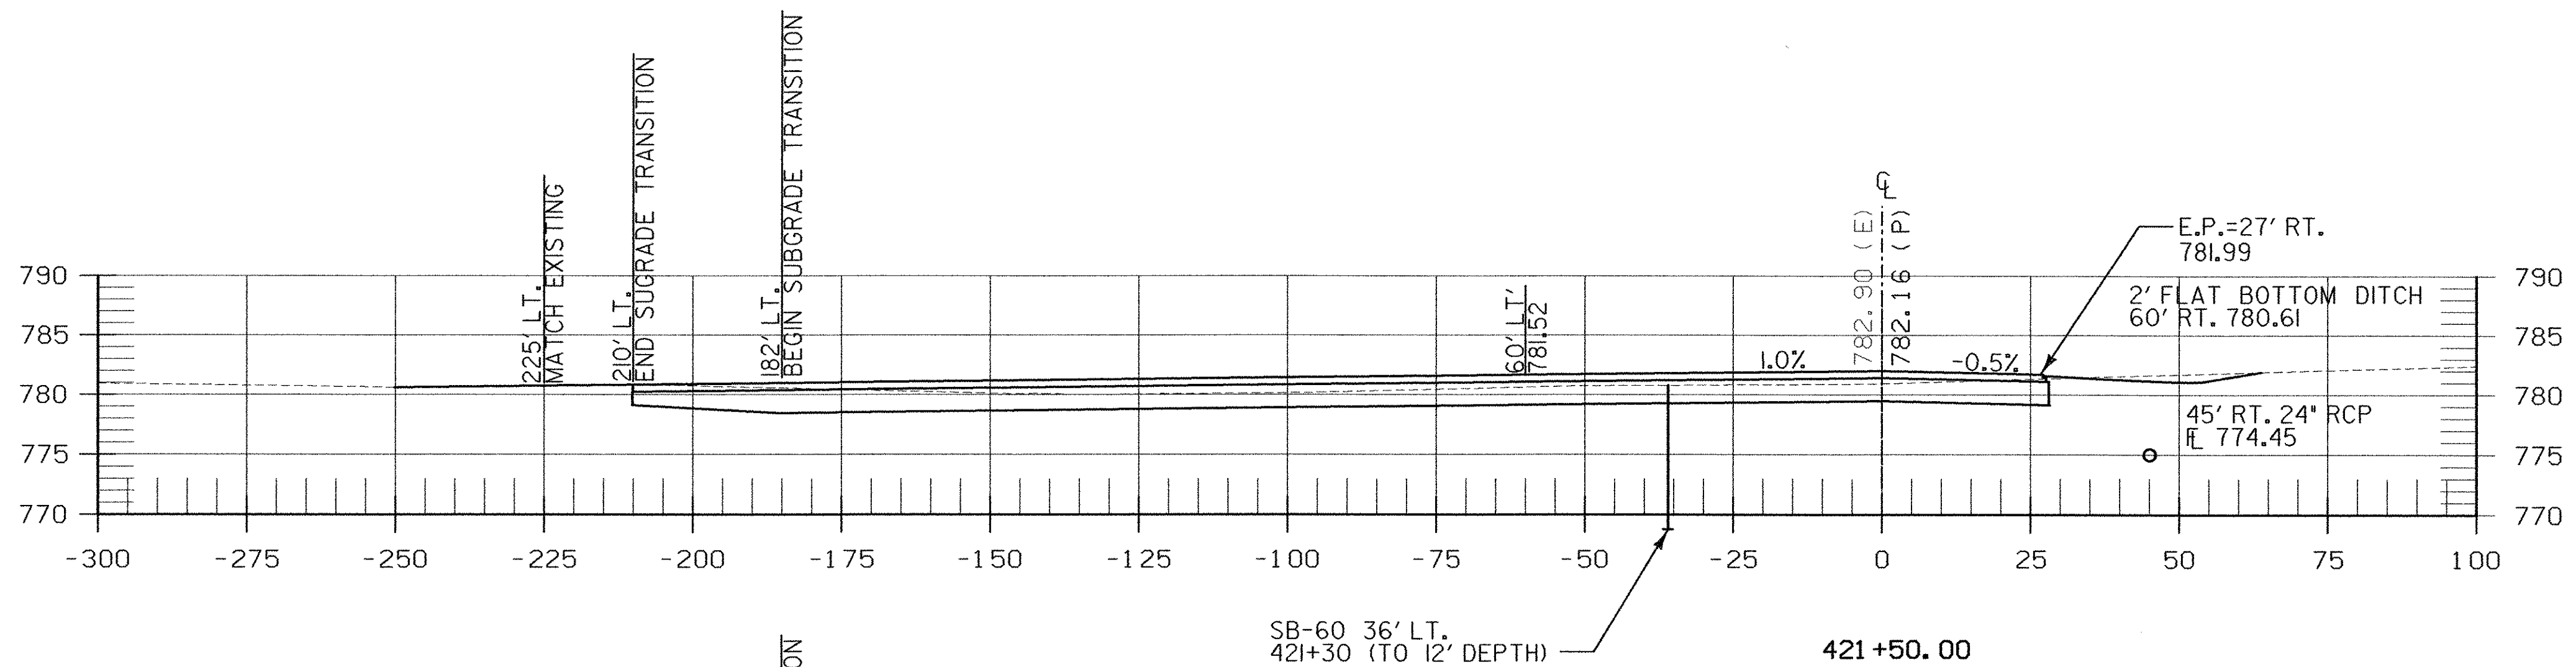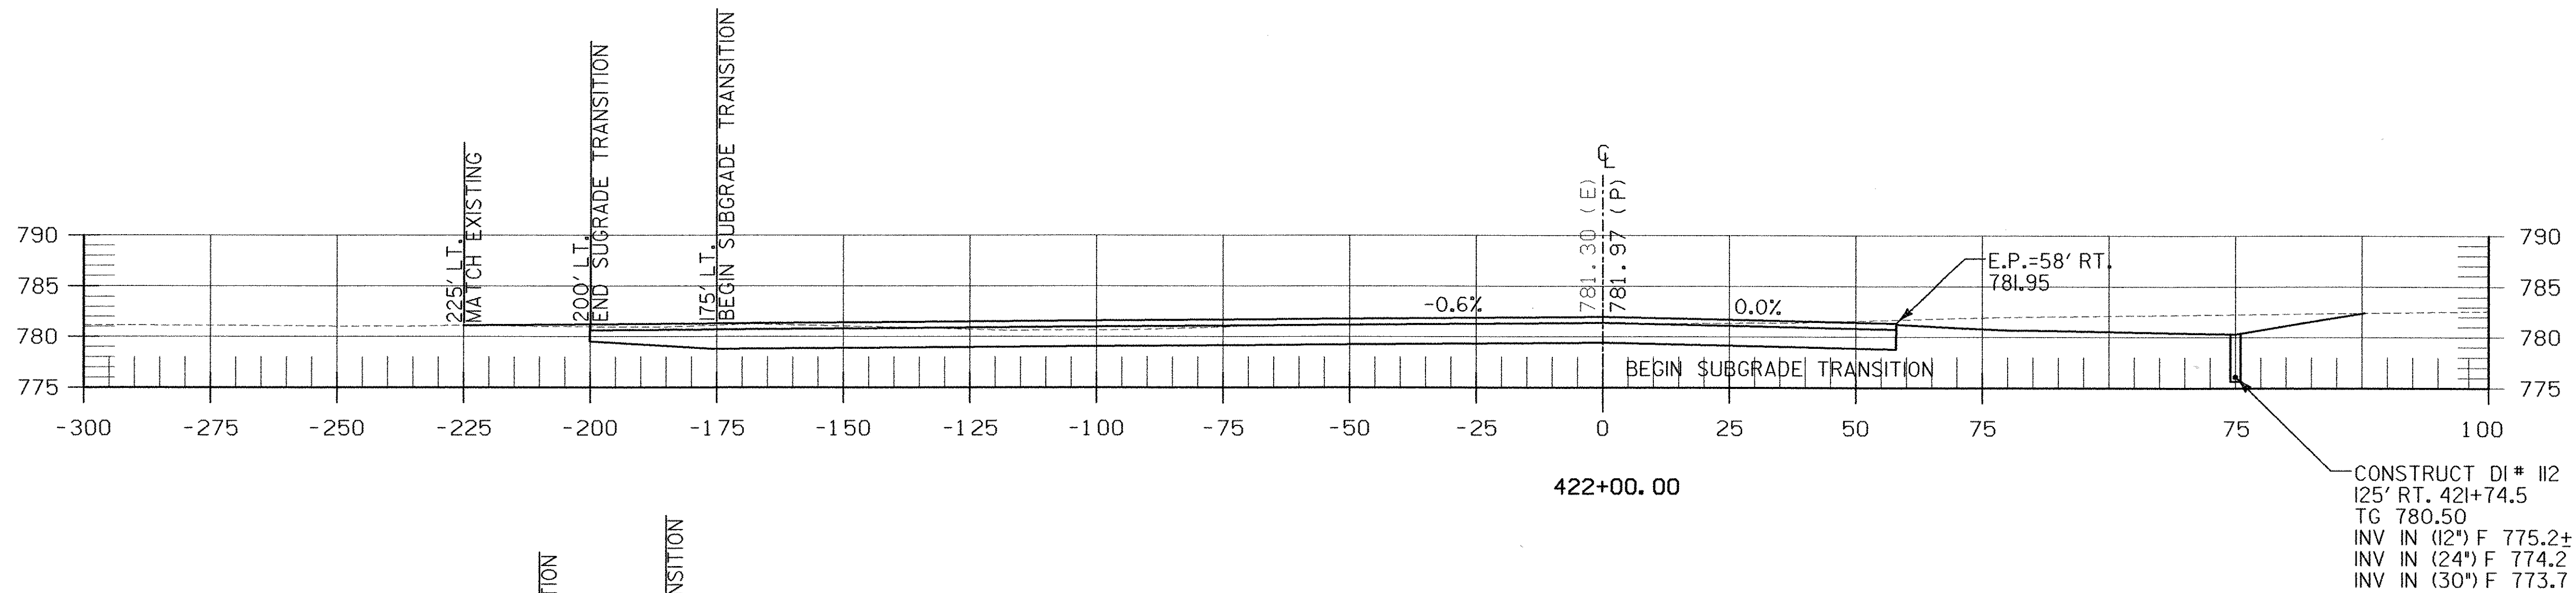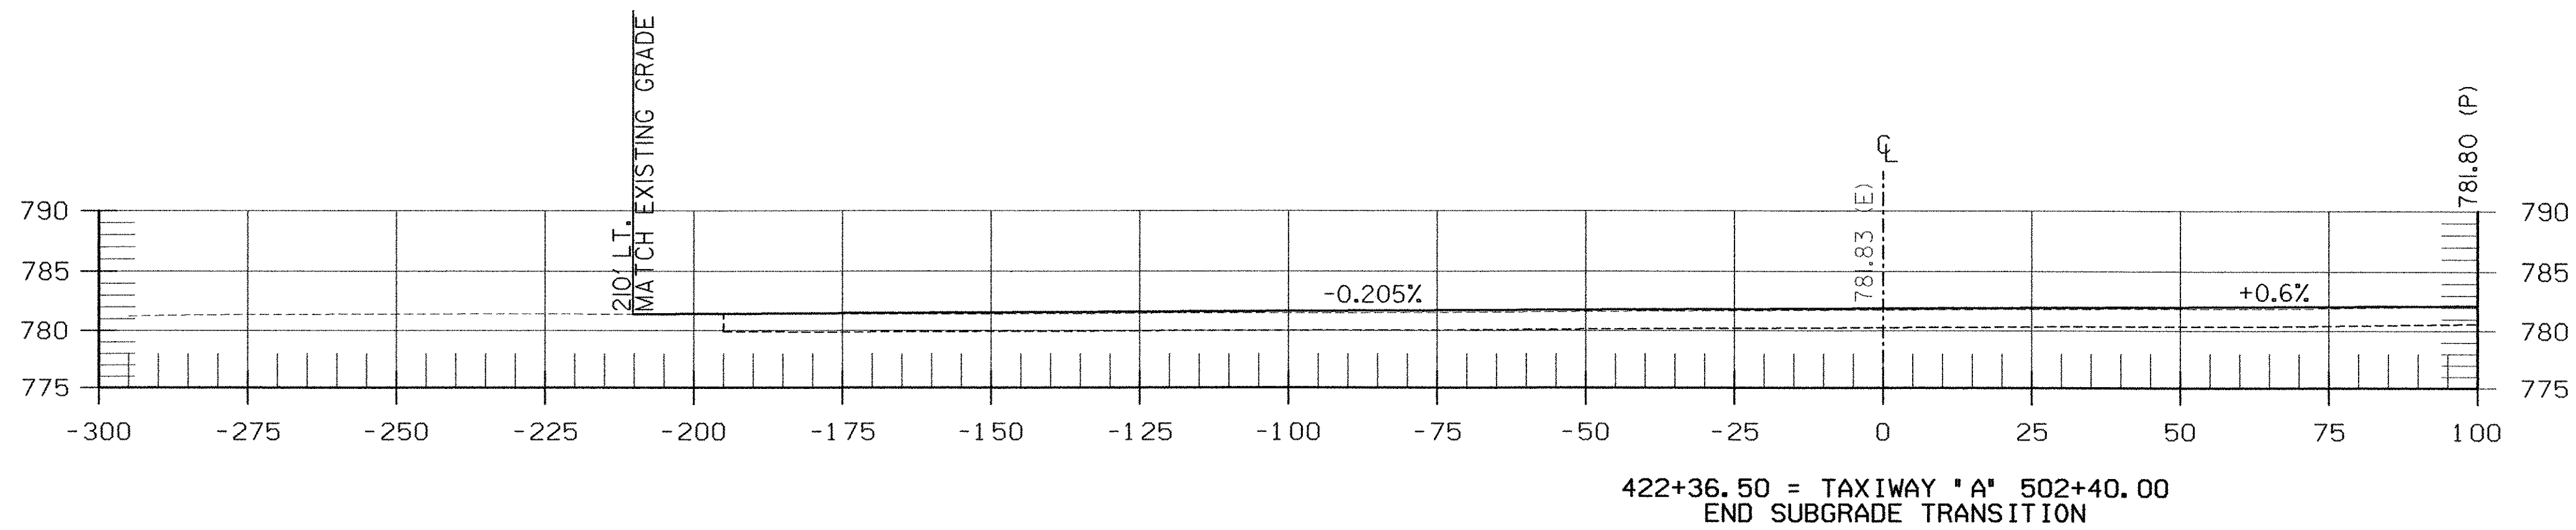

PROJECT "B"
A.I.P. 3-50-0015-17

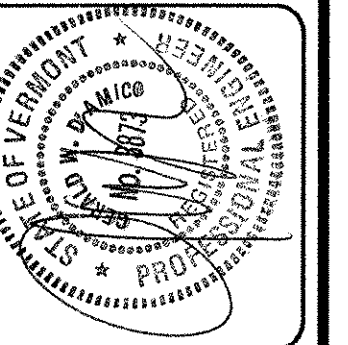

REV.	DATE	DESCRIPTION

Job No. F200002046.00
File No. F20204604635

RUTLAND STATE AIRPORT
CLARENDON, VERMONT

CROSS SECTIONS
TAXIWAY "A"

URS
1 NORTHWAY LN.
LATHAM, NEW YORK

Designed by: G.W.D.
Drawn by: M.C.M.
Checked by: M.K.C.
Approved by: G.W.D.













Scale: AS SHOWN

Date: FEB., 2003

Sheet 35 OF 40

Sheet No
35

P:\CTV\N\Sheet\CT2002\F20204604635.dgn

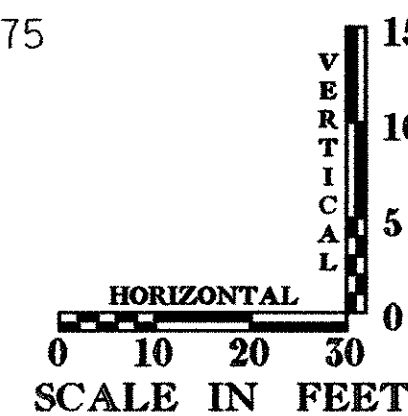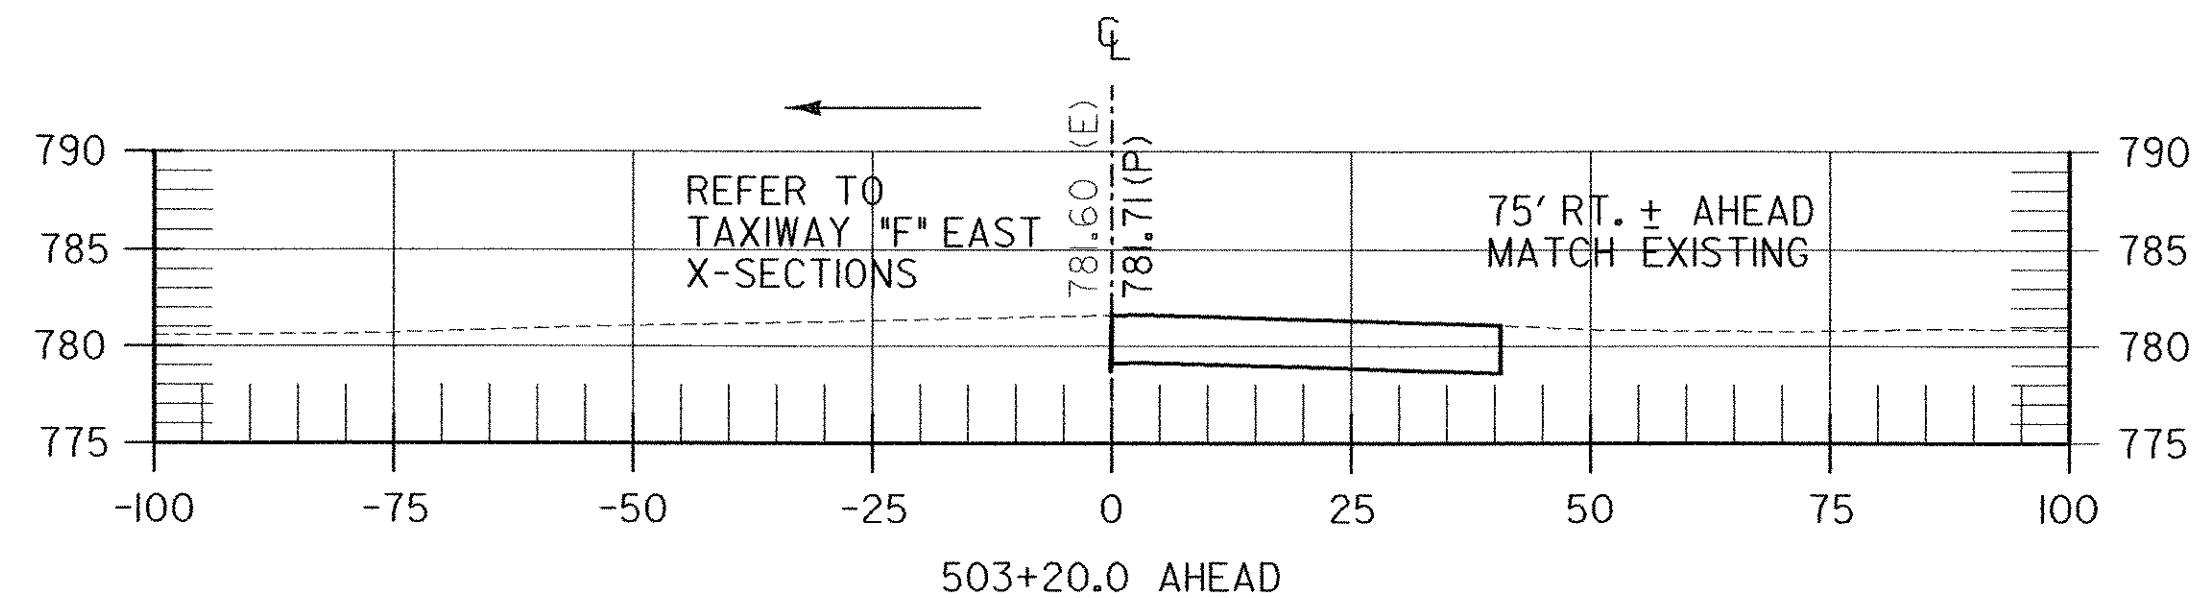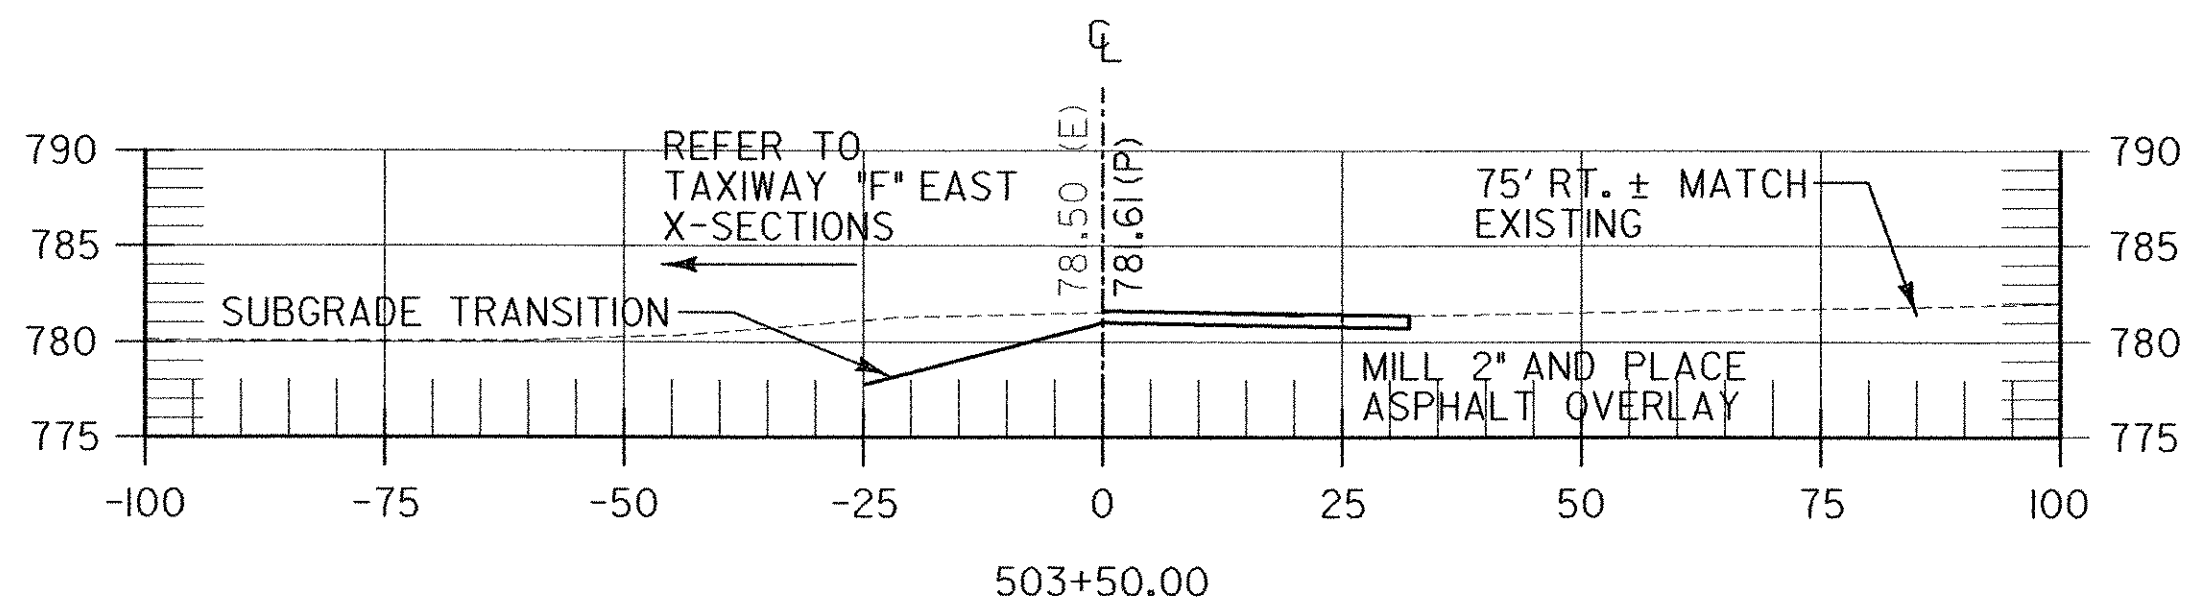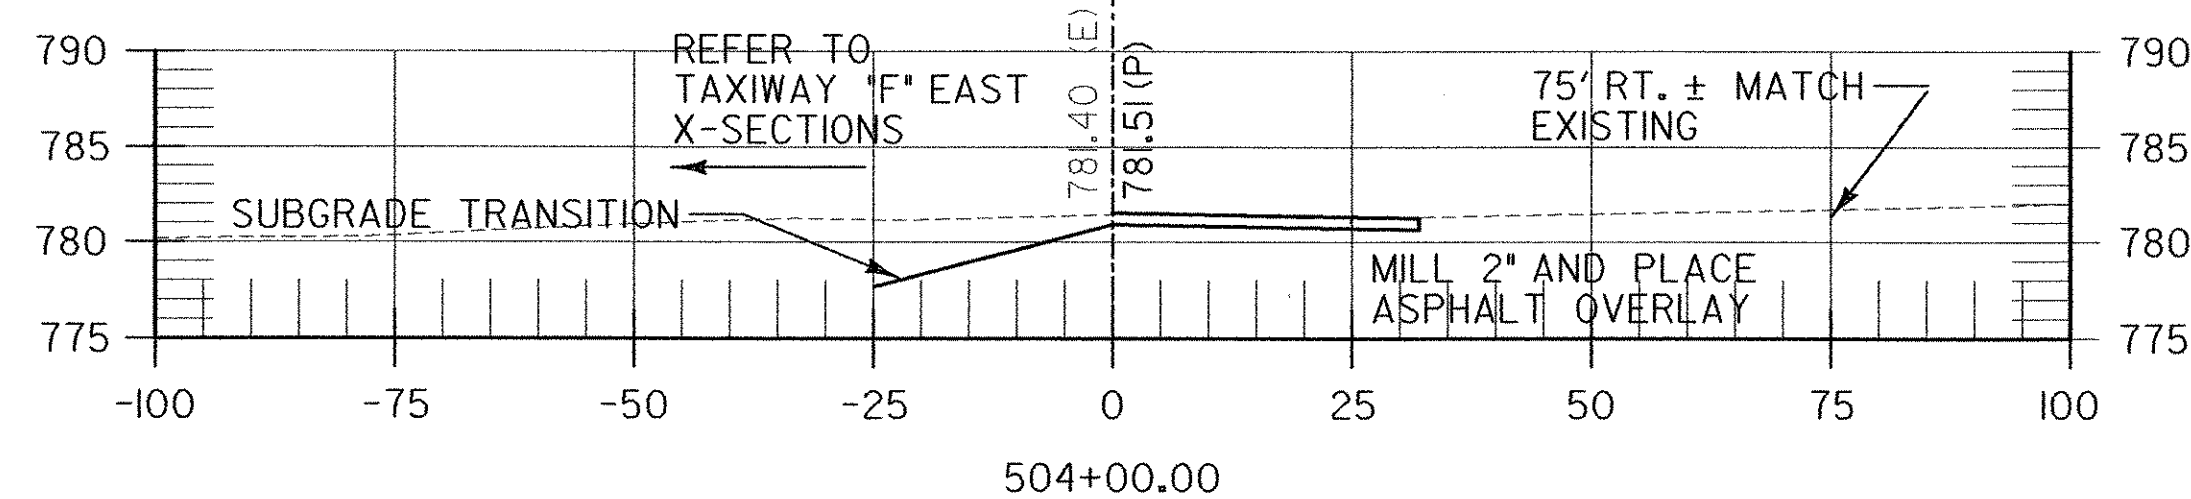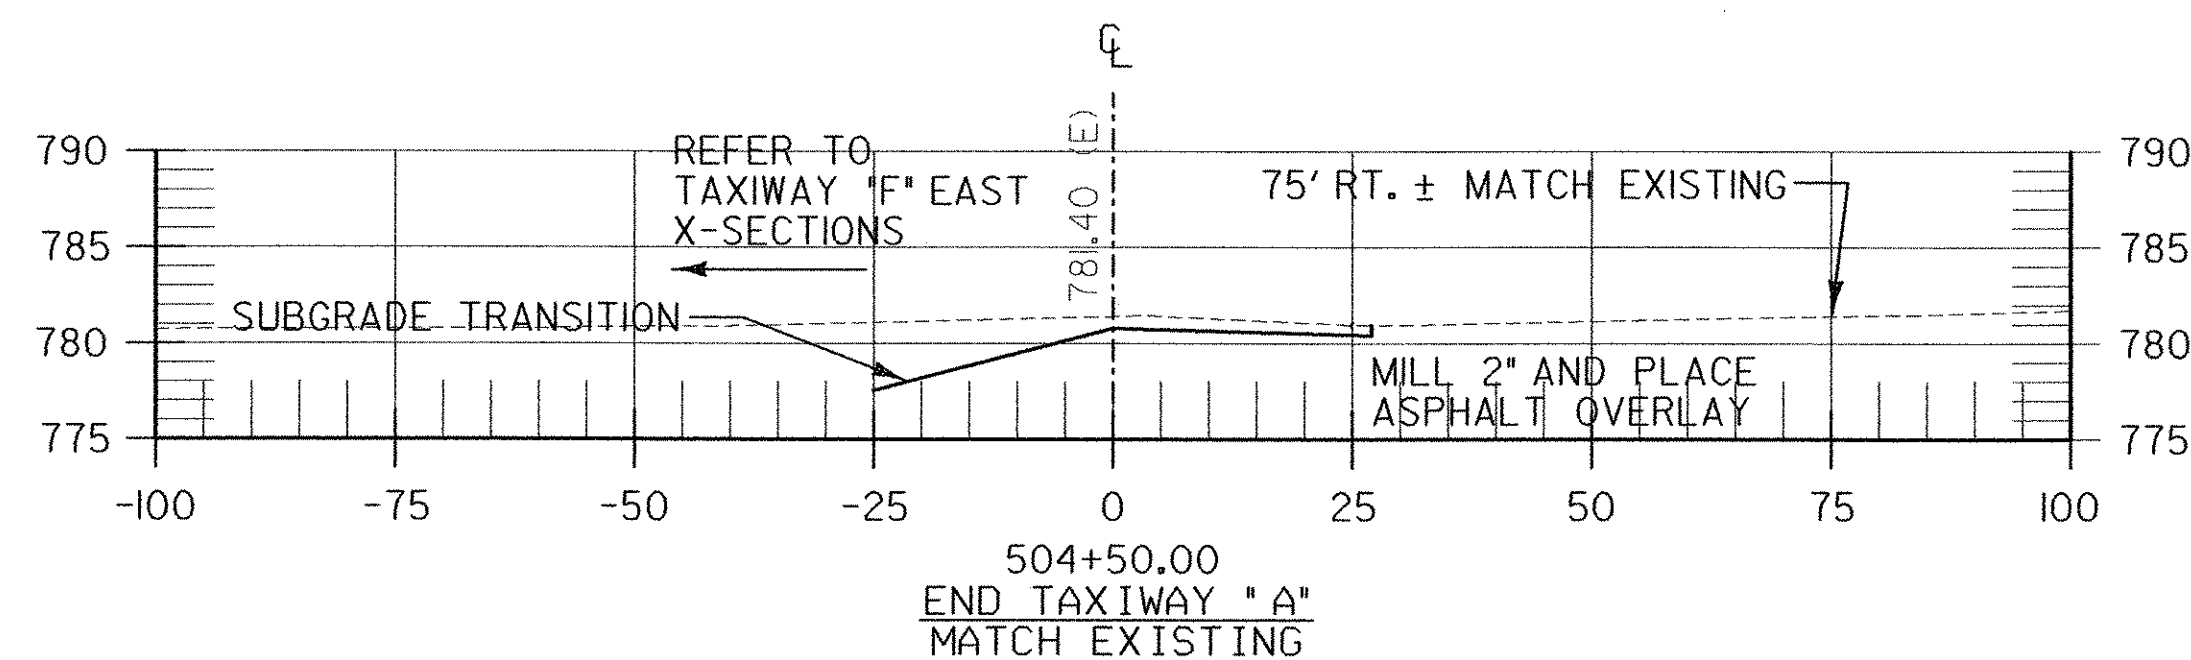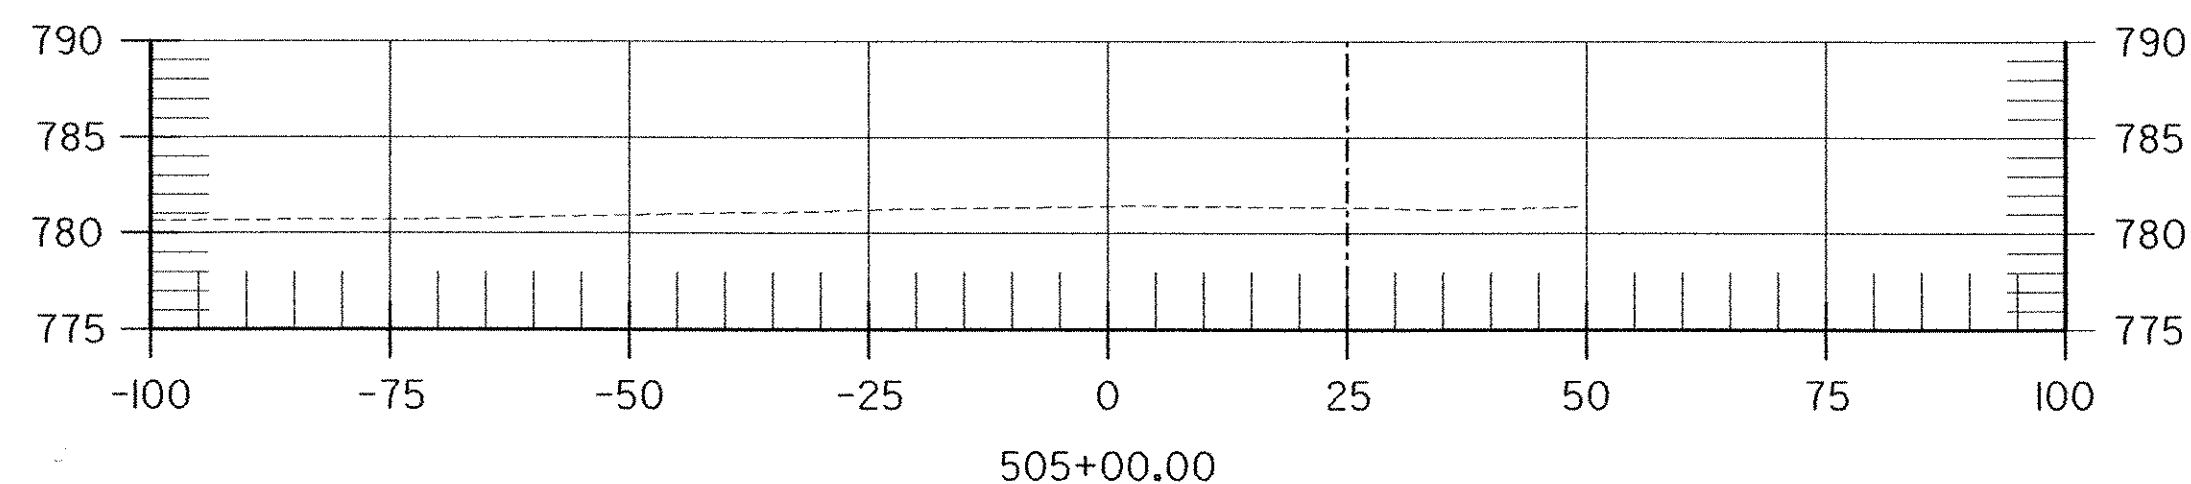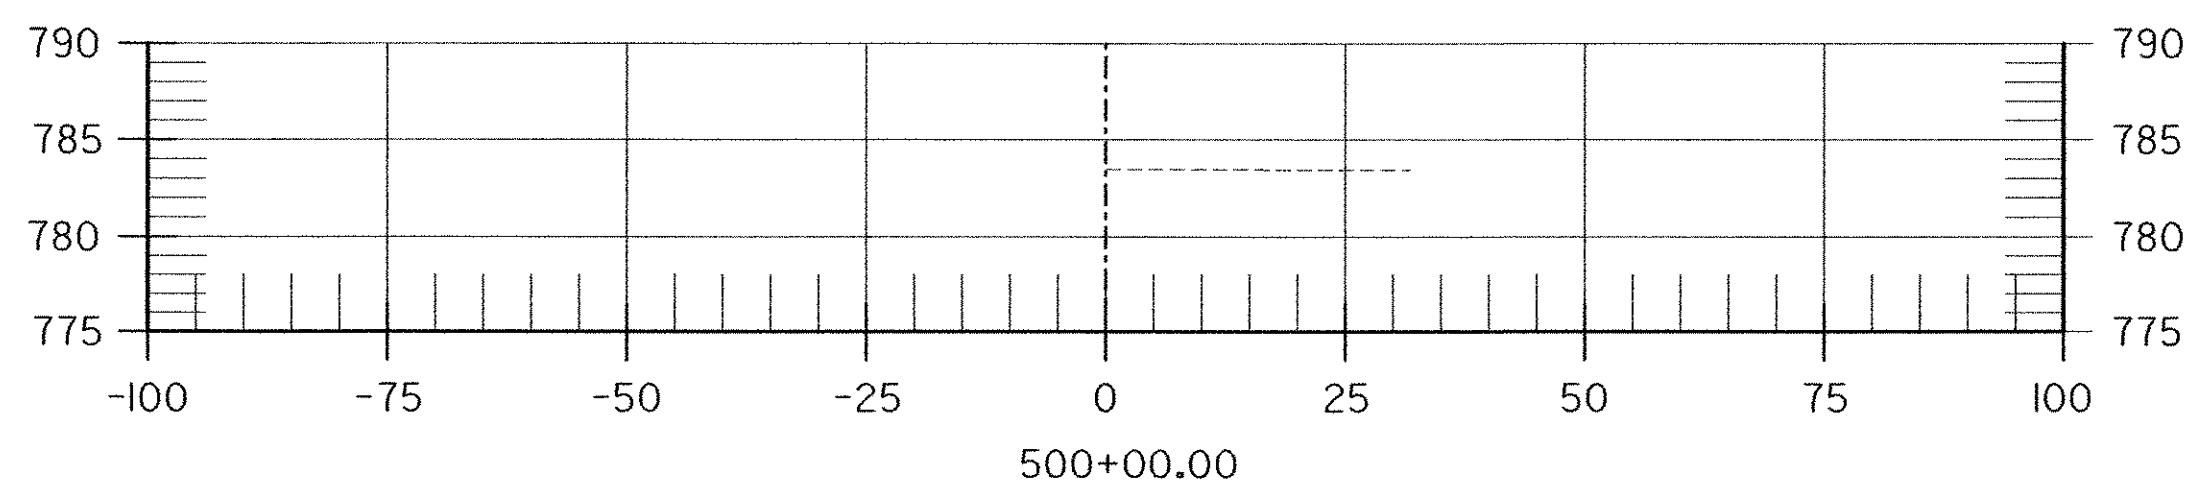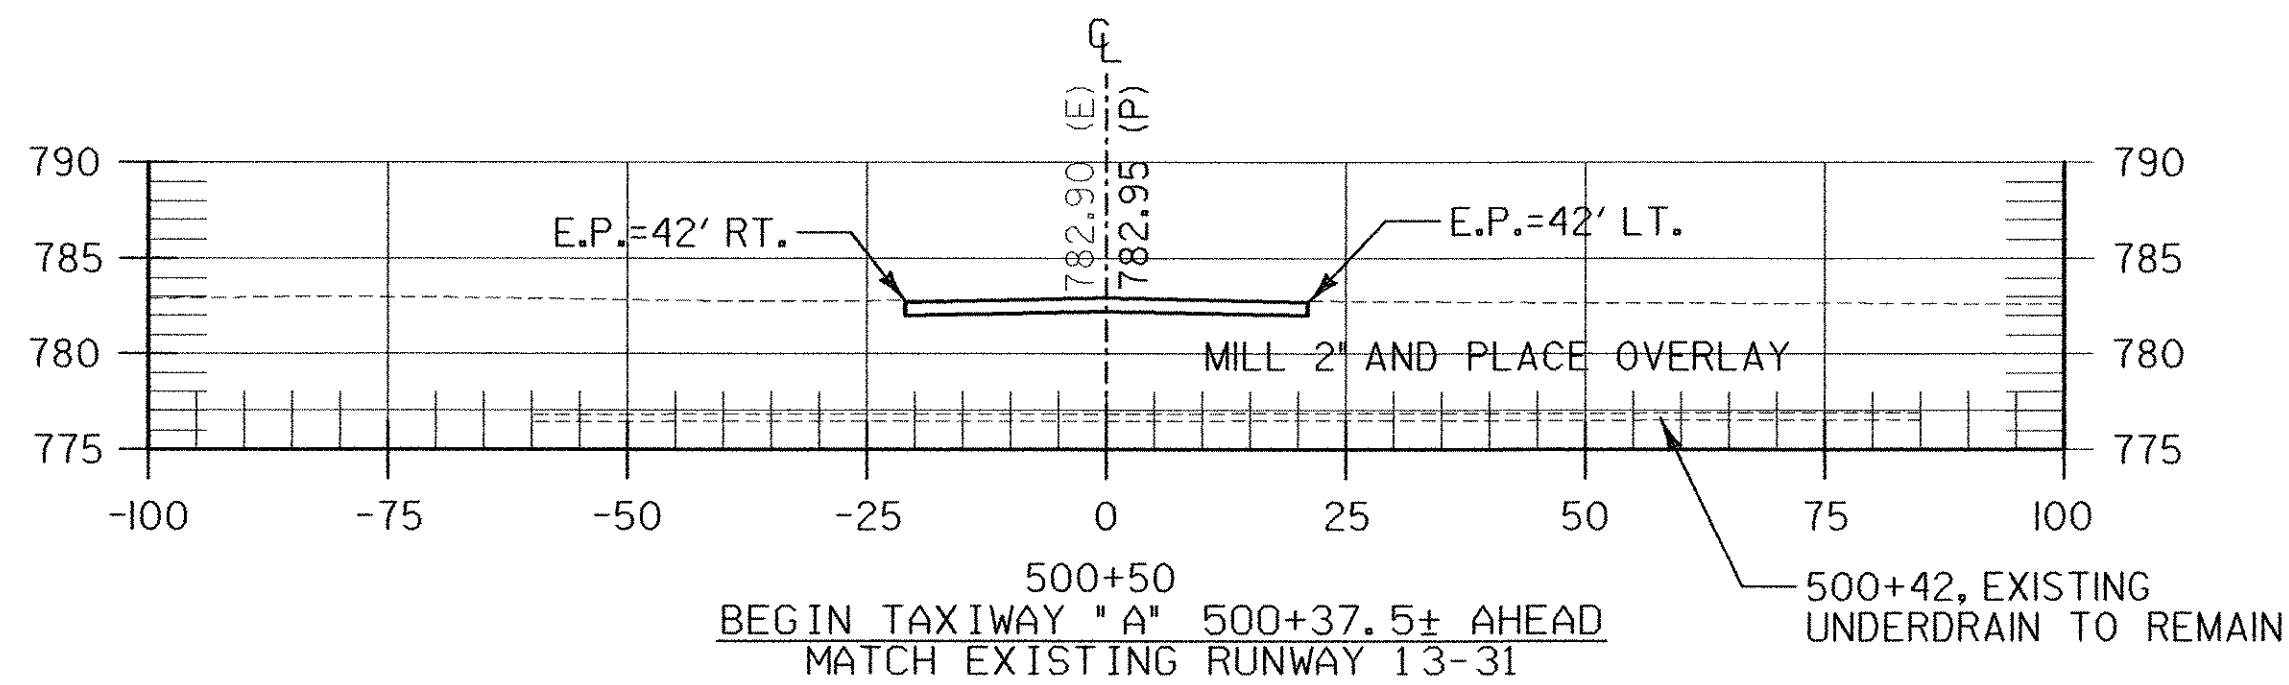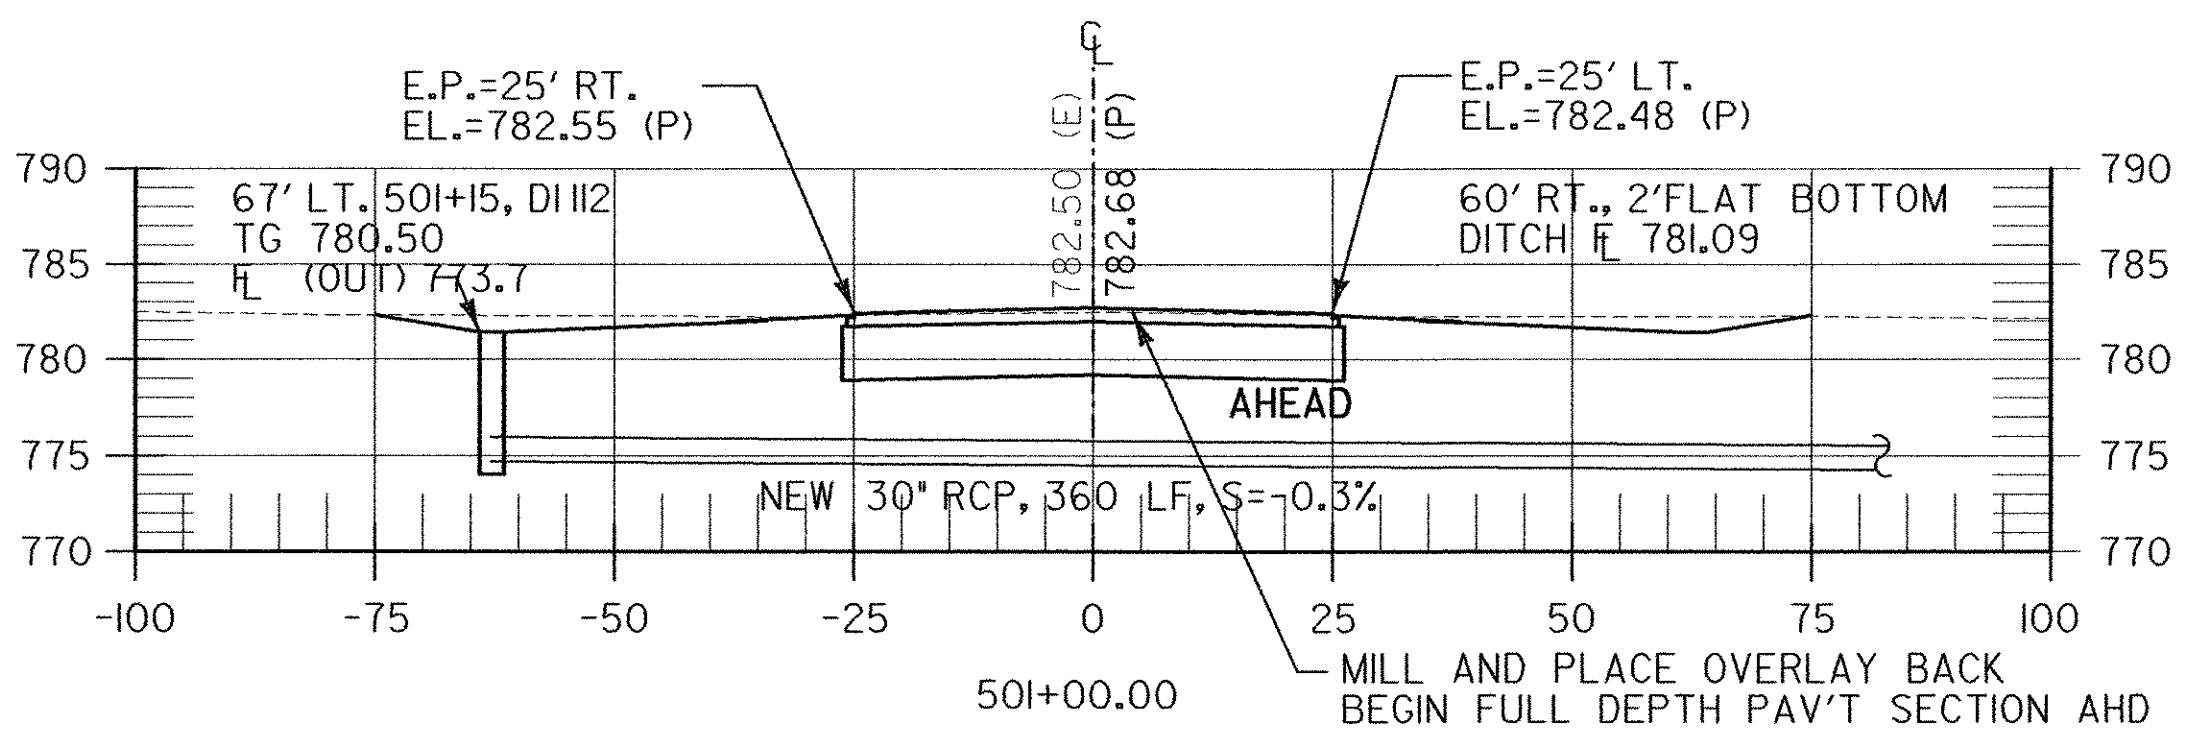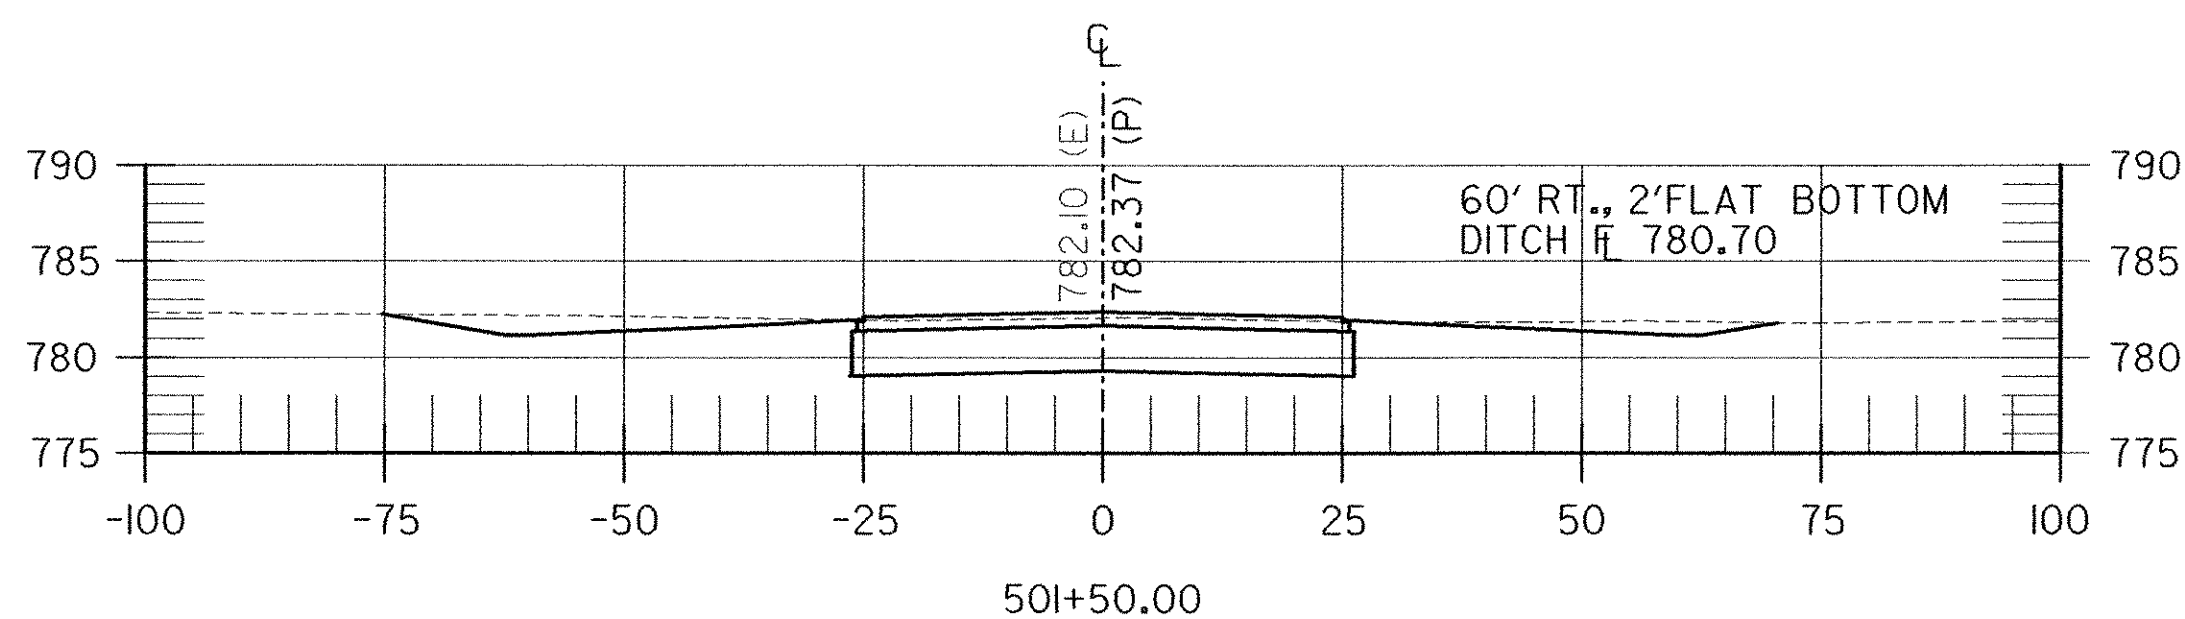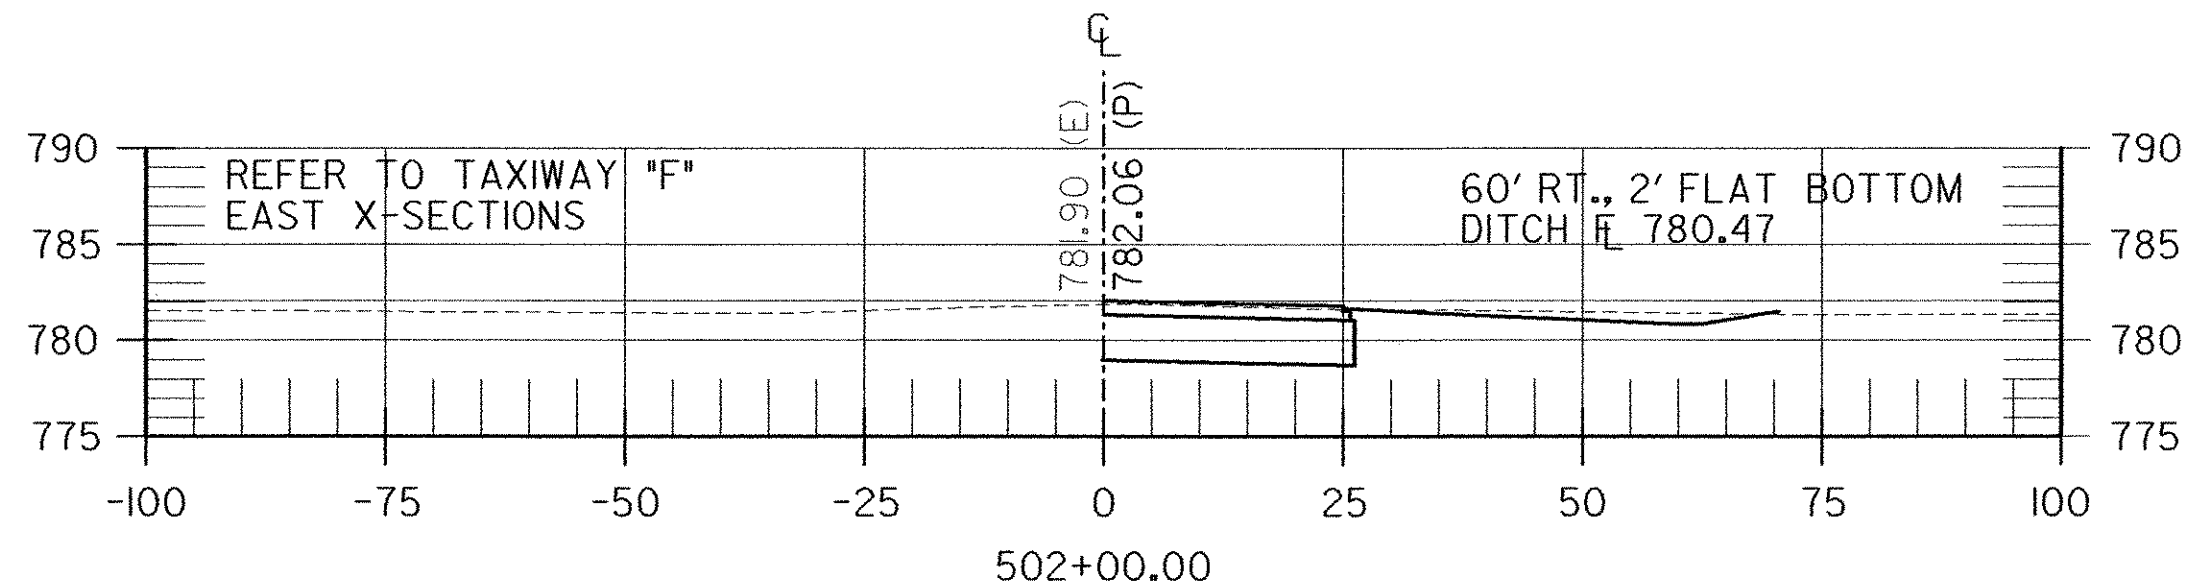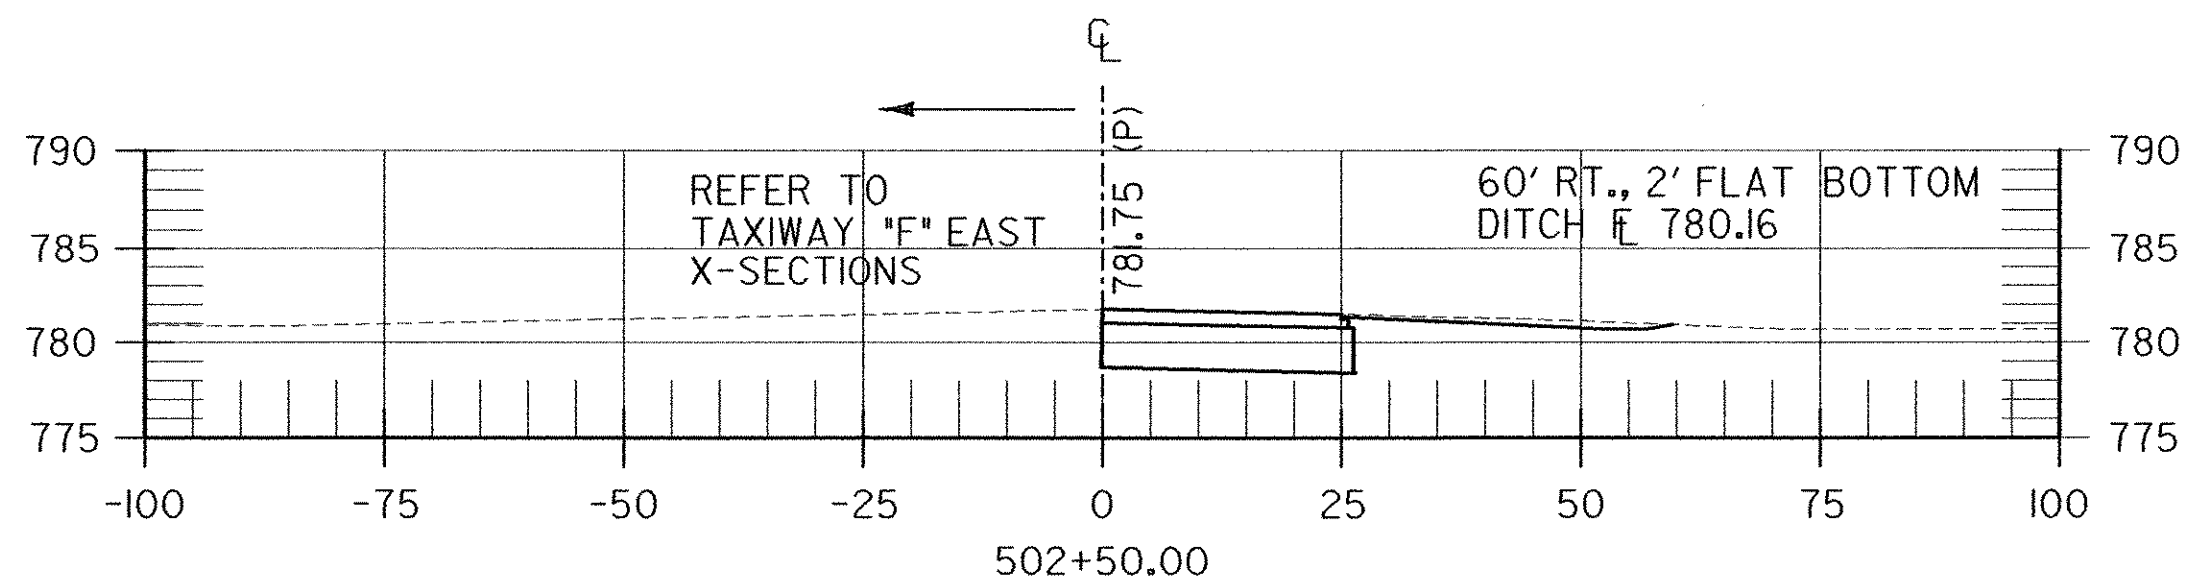

PROJECT "B"
A.I.P. 3-50-0015-17



REV.	DATE	DESCRIPTION

RUTLAND STATE AIRPORT
CLARENDON, VERMONT

CROSS SECTIONS
TAXIWAY "A"

URS
1 NORTHWAY LN.
LATHAM, NEW YORK



Designed by G.W.D.
Drawn by M.C.M.
Checked by M.K.C.
Approved by G.W.D.

Scale: AS SHOWN

Date: FEB., 2003



Sheet 36 OF 40

Sheet No.
36

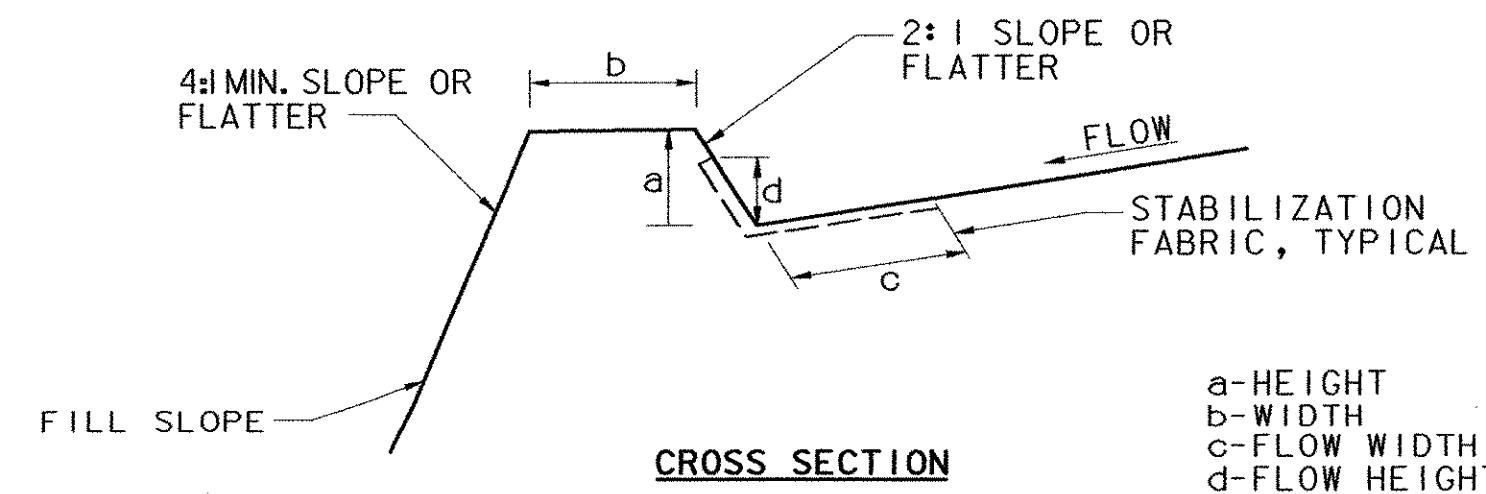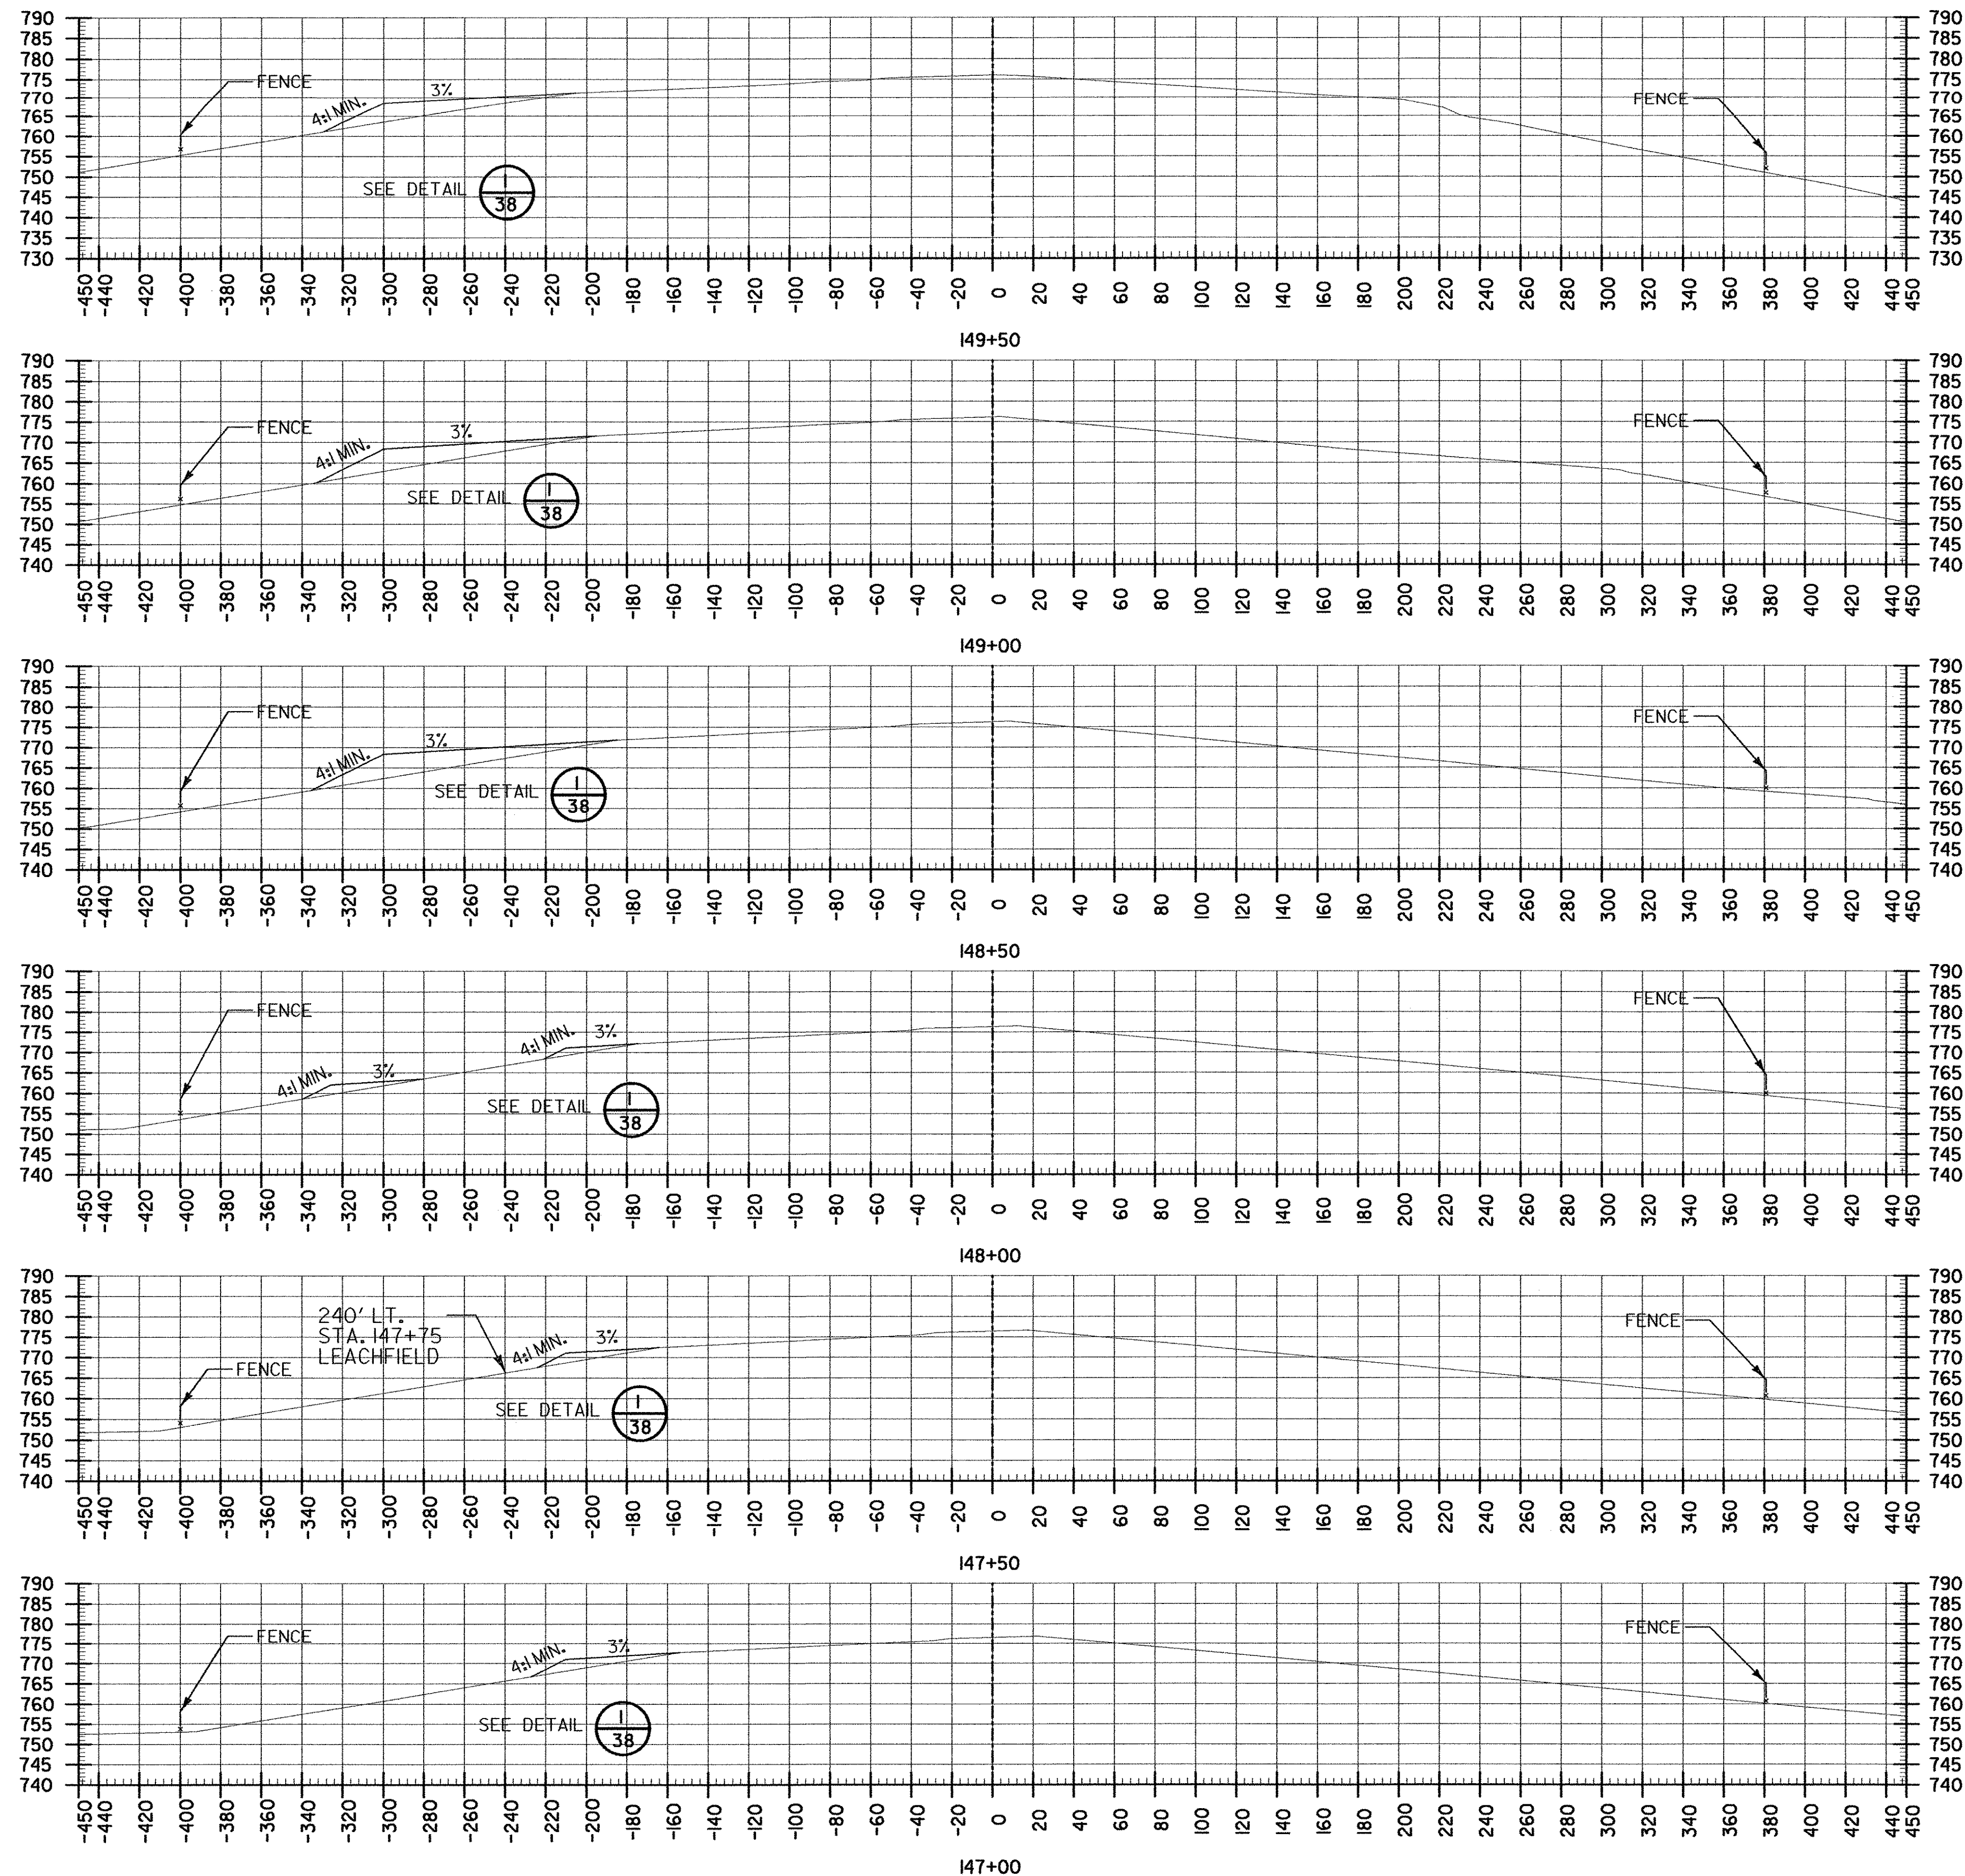

1. BERMS TO BE COMPACTED BY EARTH-MOVING EQUIPMENT.
2. TOP MAY BE WIDER AND SIDE SLOPES MAY BE FLATTER.
3. BERMS TO BE CONSTRUCTED ALONG TOP OF SLOPE OUTSIDE RUNWAY SAFETY AREA OVERRUNS.

1
38 EARTH BERM
SCALE: NONE

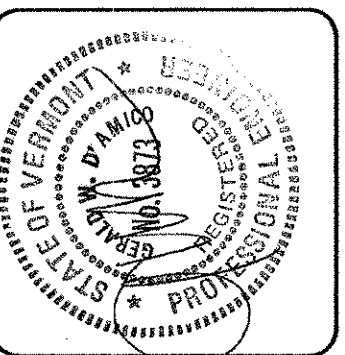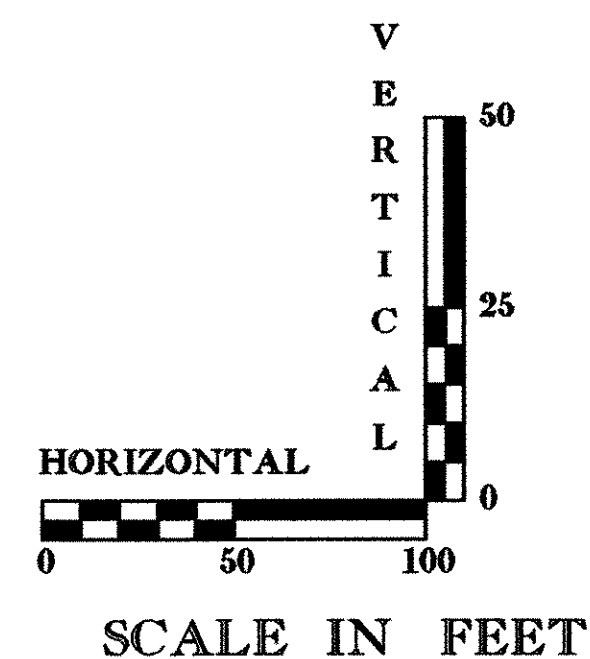

REV.	DATE	DESCRIPTION

RUTLAND STATE AIRPORT
CLARENDON, VERMONT




TAXIWAY IMPROVEMENTS
WASTE AREA CROSS SECTIONS

URS
1 NORTHWAY LN.
LATHAM, NEW YORK

Designed by G.W.D.
Drawn by M.C.M.
Checked by M.C.C.
Approved by G.W.D.

Scale: AS SHOWN
Date: FEB., 2003
Sheet 38 OF 40
Sheet No
38

A.I.P. 3-50-0015-17

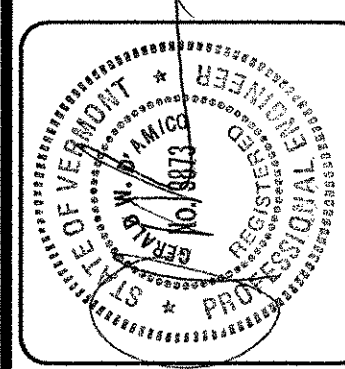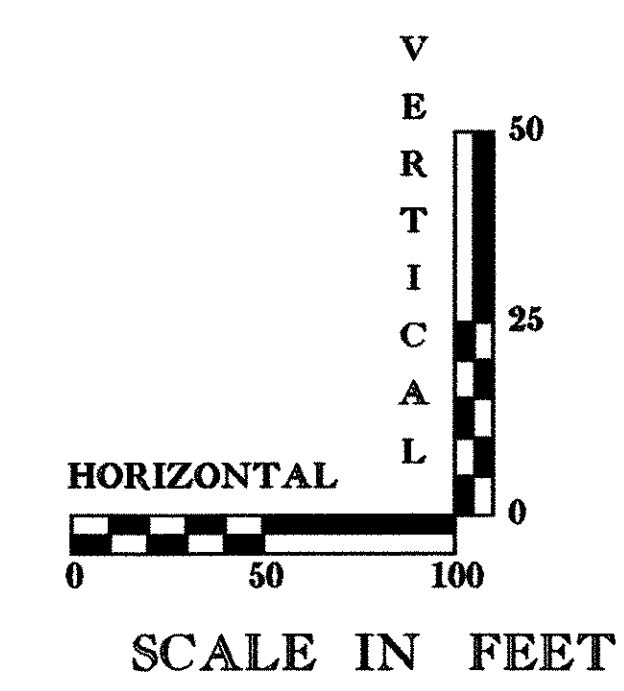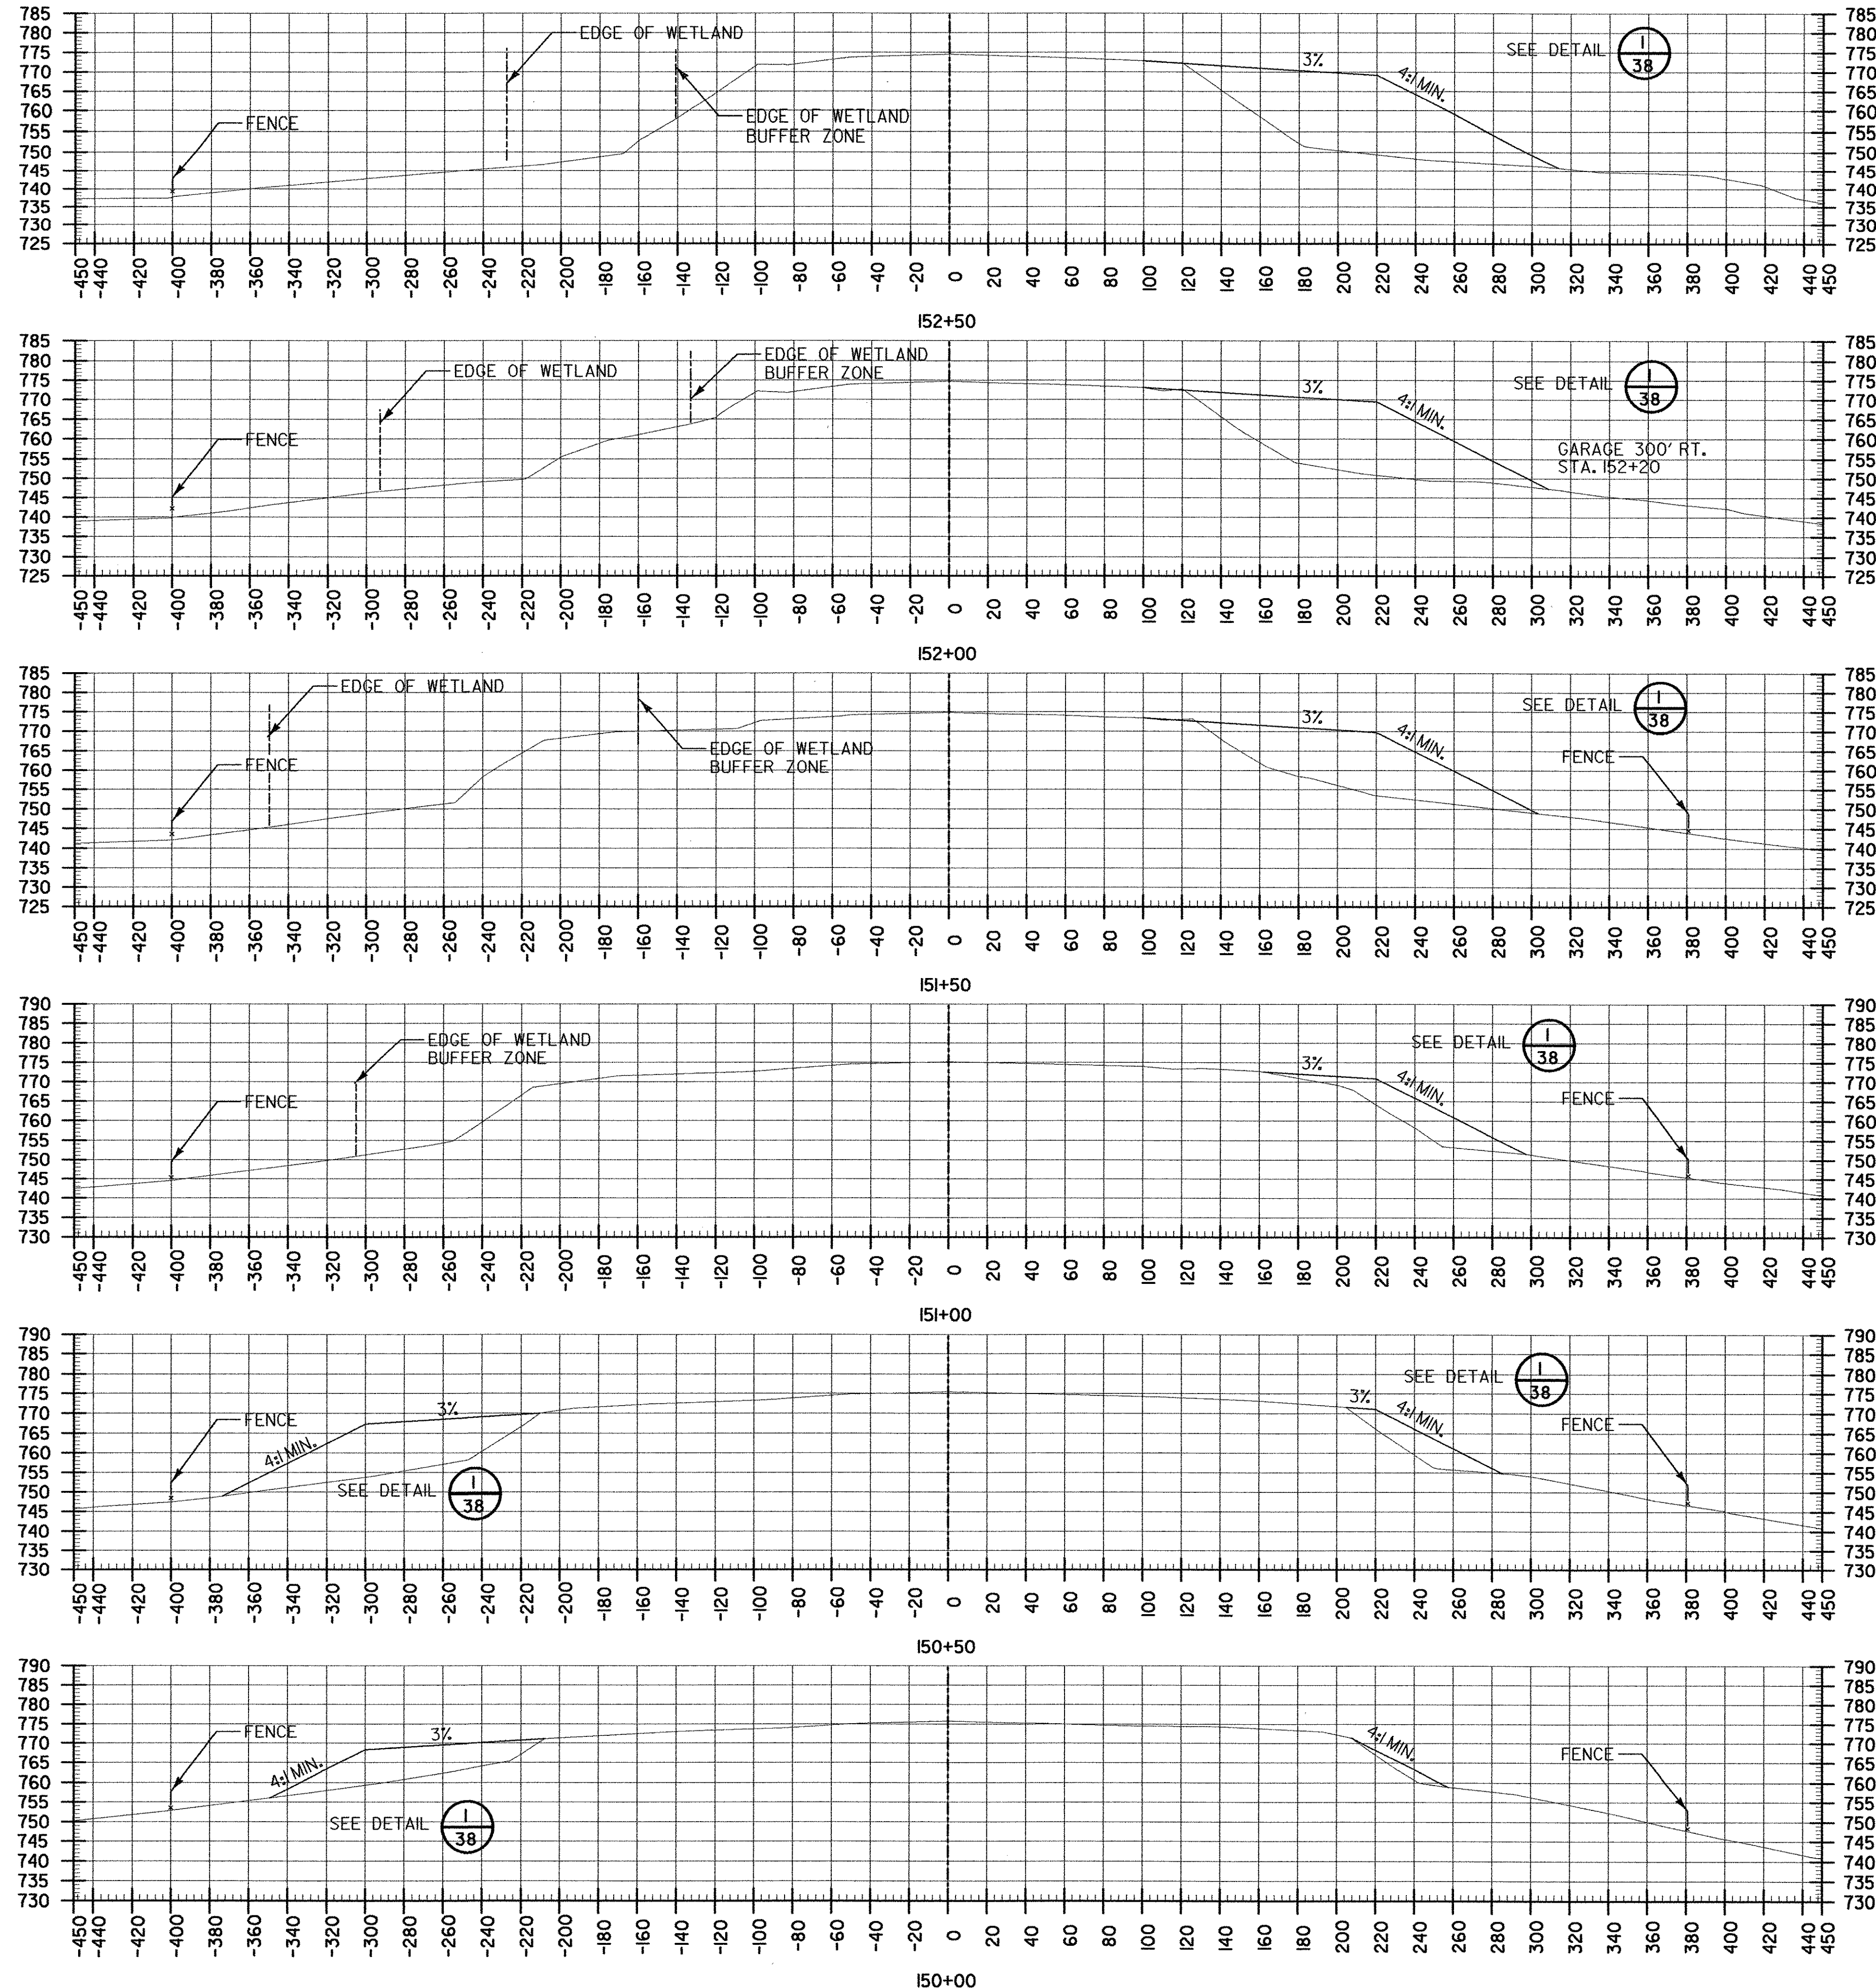

REV.	DATE	DESCRIPTION

RUTLAND STATE AIRPORT
CLARENDON, VERMONT

TAXIWAY IMPROVEMENTS
WASTE AREA CROSS SECTIONS

URS
1 NORTHWAY LN.
LATHAM, NEW YORK


Designed by G.W.D.
Drawn by M.C.M.
Checked by M.K.C.
Approved by G.W.D.


Scale: AS SHOWN

Date: FEB., 2003

Sheet 39 OF 40

Sheet No
39



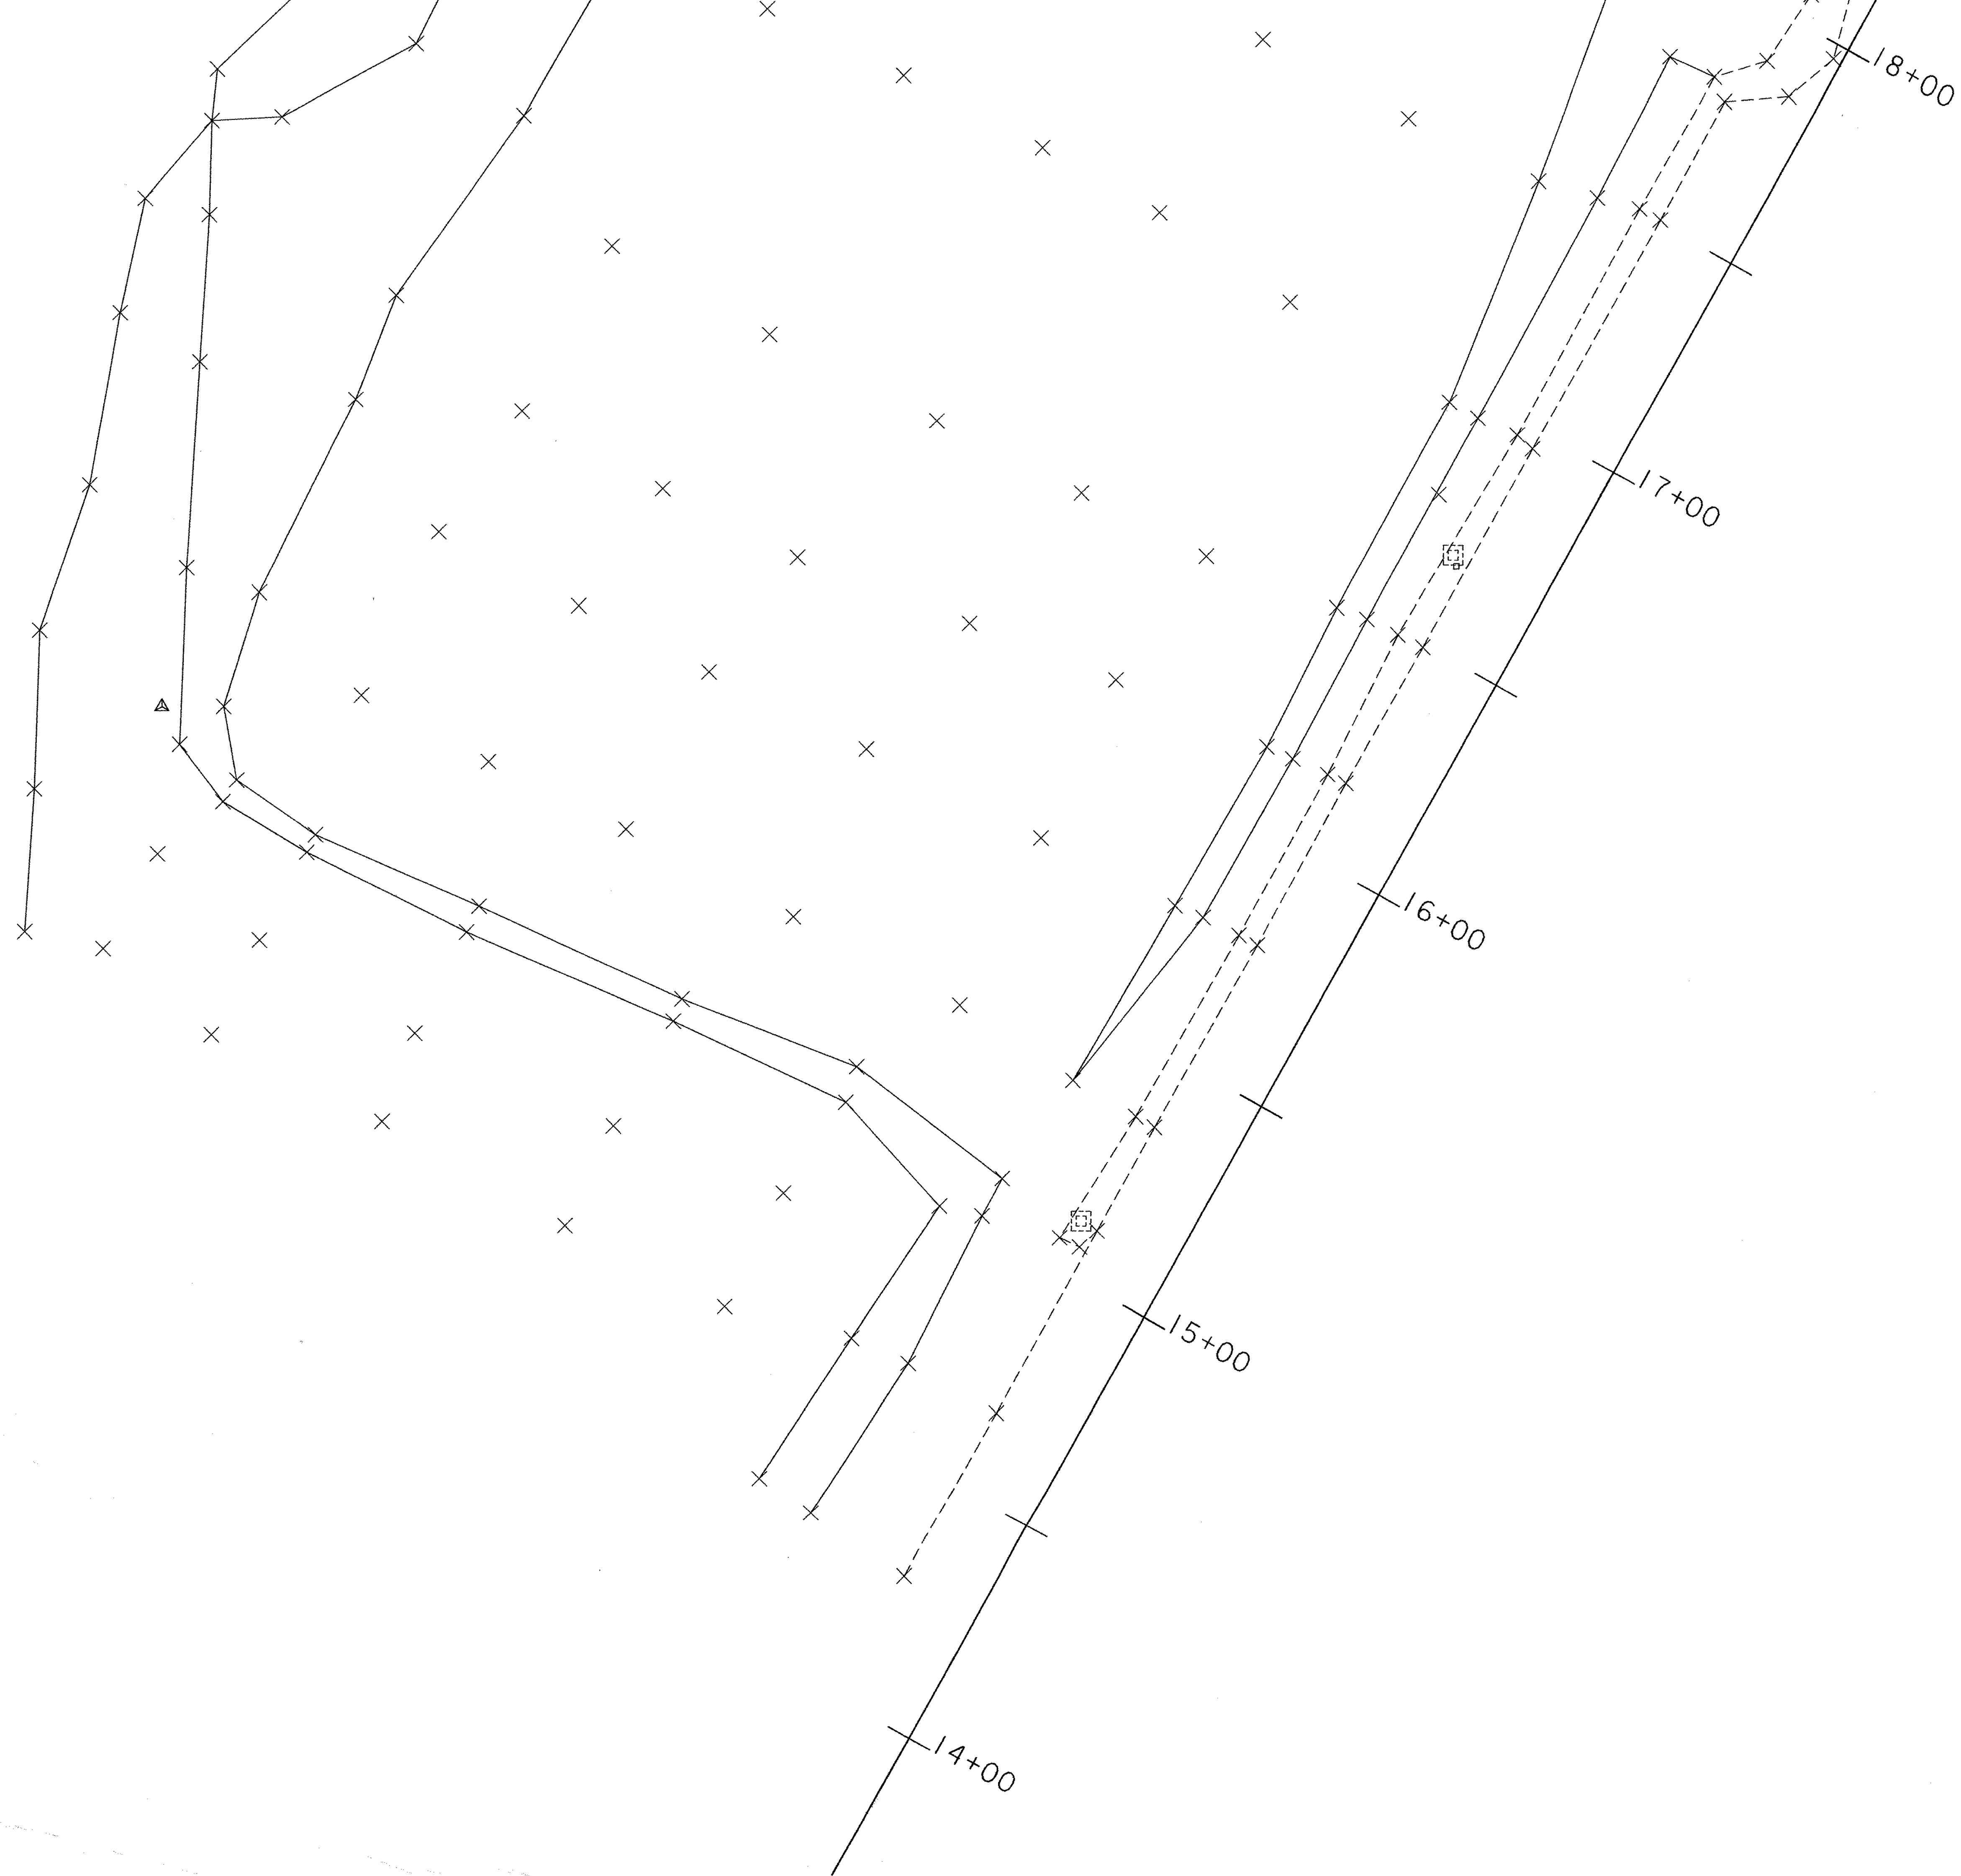


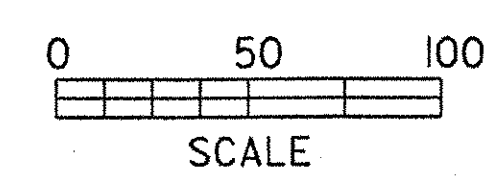

- | | |
|-------------------------------------|------------------------|
| PROJECT NAME: RUTLAND AIRPORT APRON | |
| PROJECT NUMBER: 15639.00 | |
| FILE NAME: Z15639WRK.DGN | PLOT DATE: 02-OCT-2000 |
| PROJECT LEADER: E. NASSAR | DRAWN BY: R. PERKINS |
| DESIGNED BY: R. PERKINS | CHECKED BY: E. NASSAR |
| SITE PLAN | SHEET 7 OF 12 042 |




WASTE AREA #3

PAGE 1 OF 4

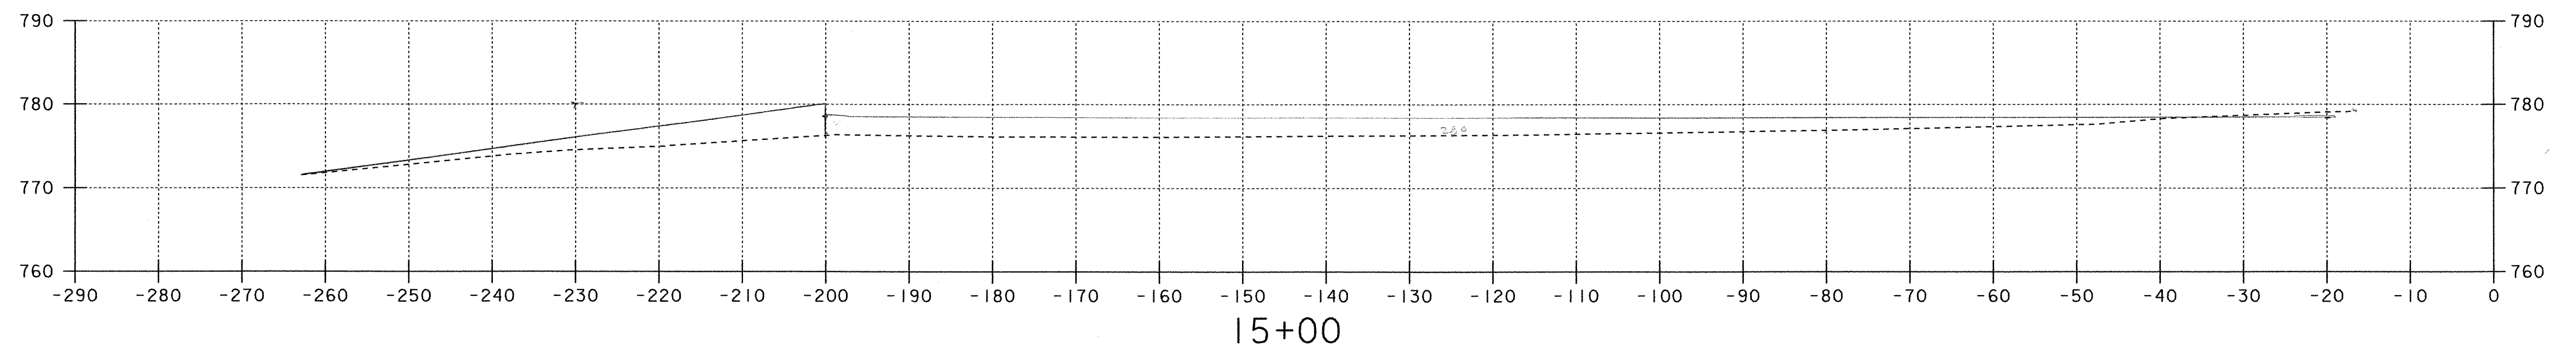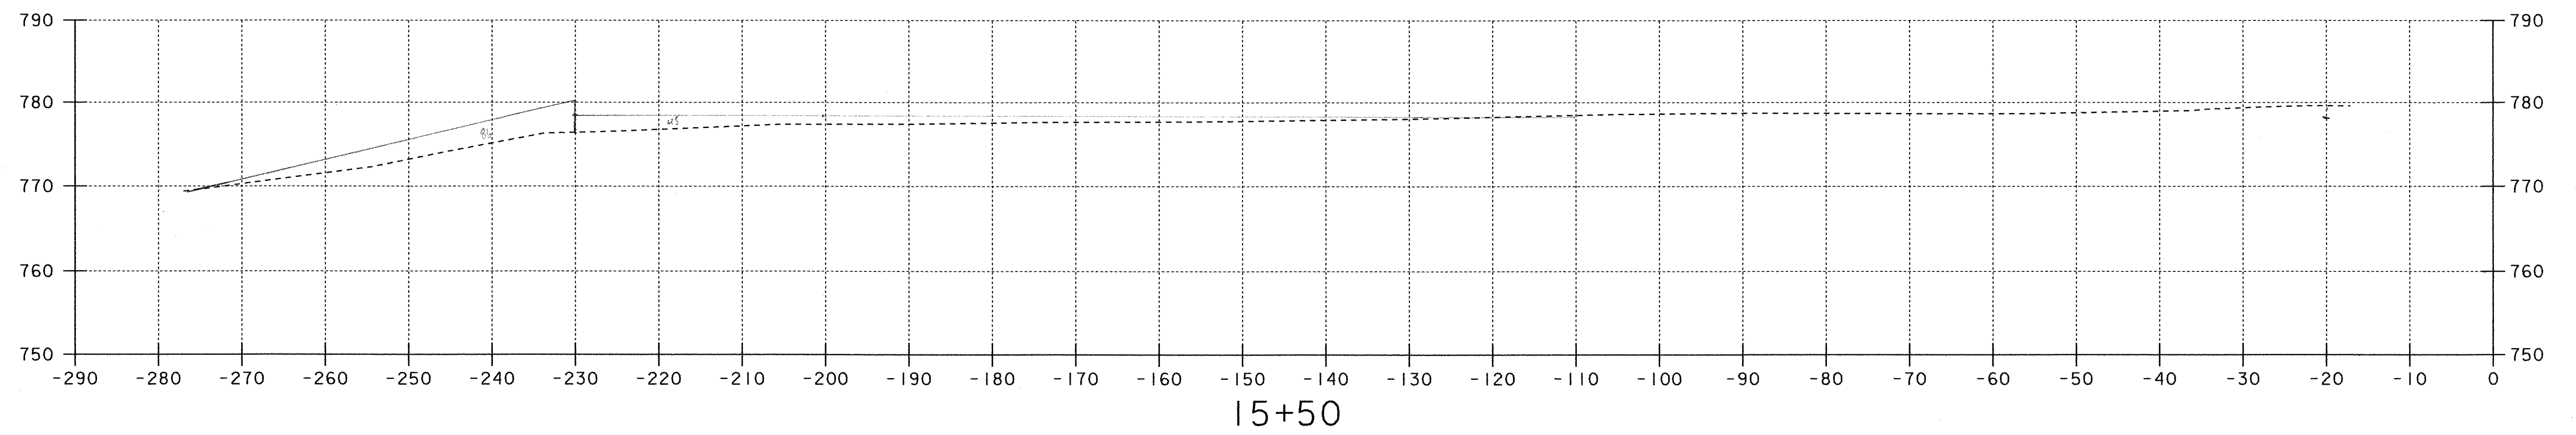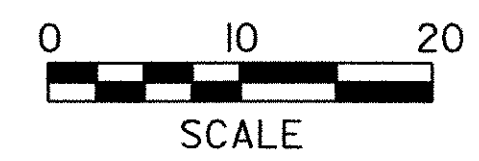




WASTE AREA #3

PAGE 2 OF 4

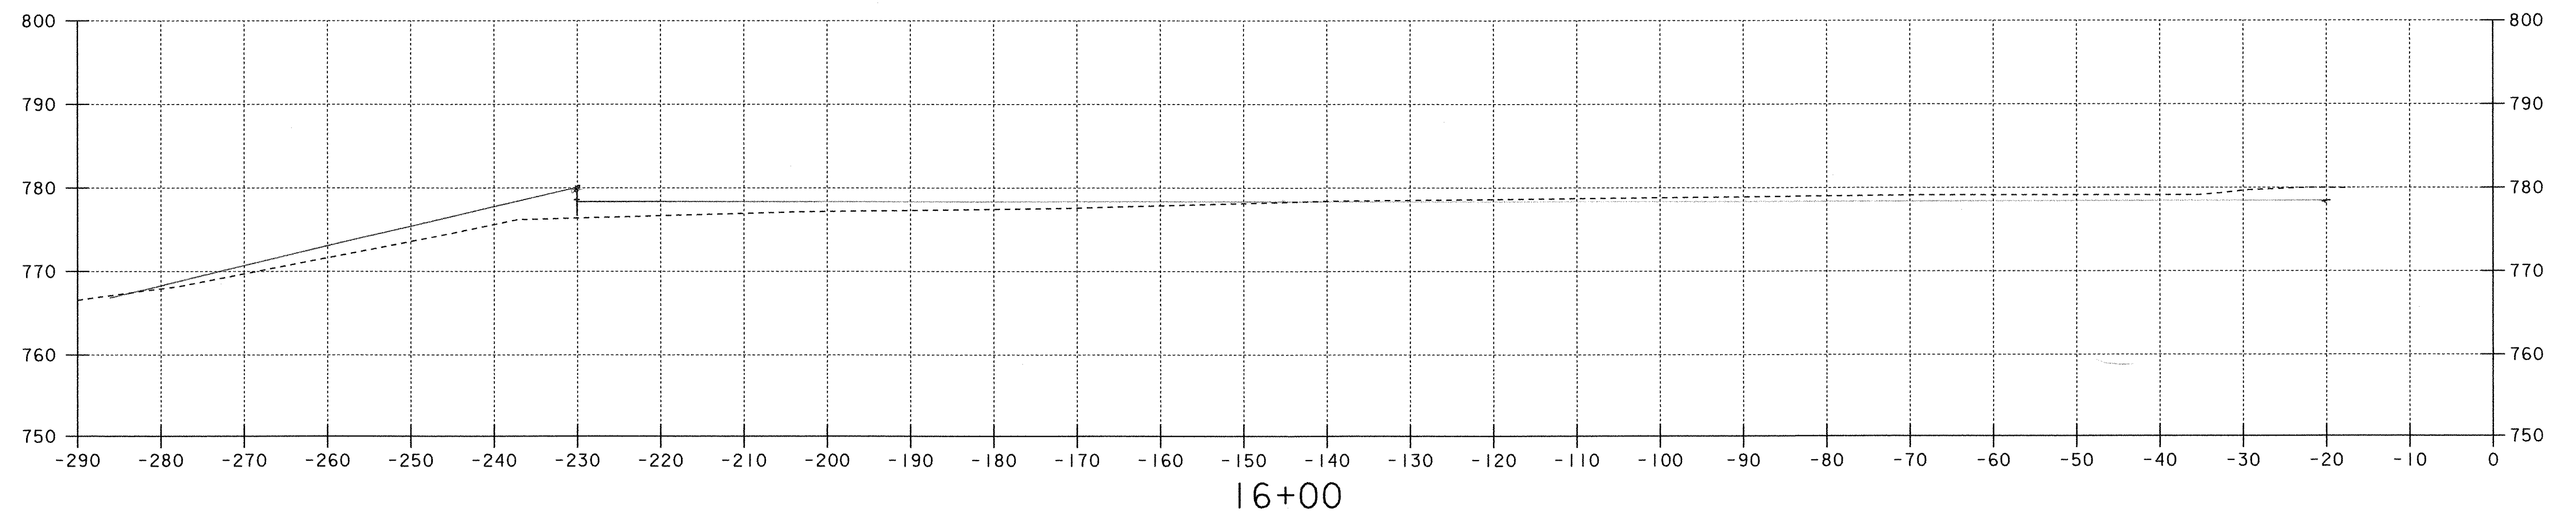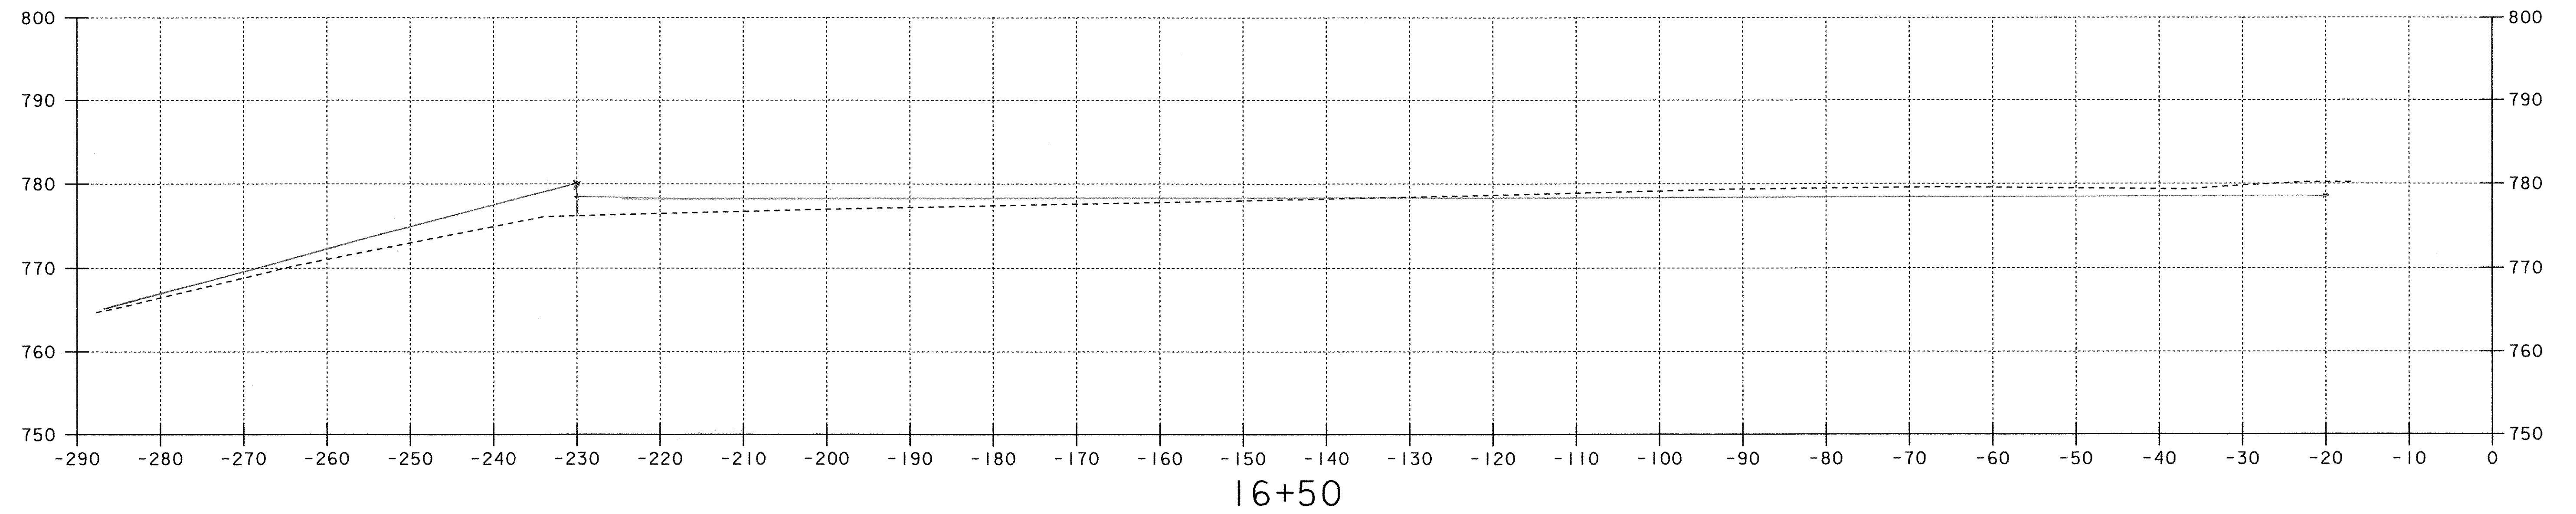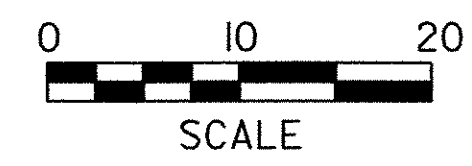



WASTE AREA #3


PAGE 3 OF 4

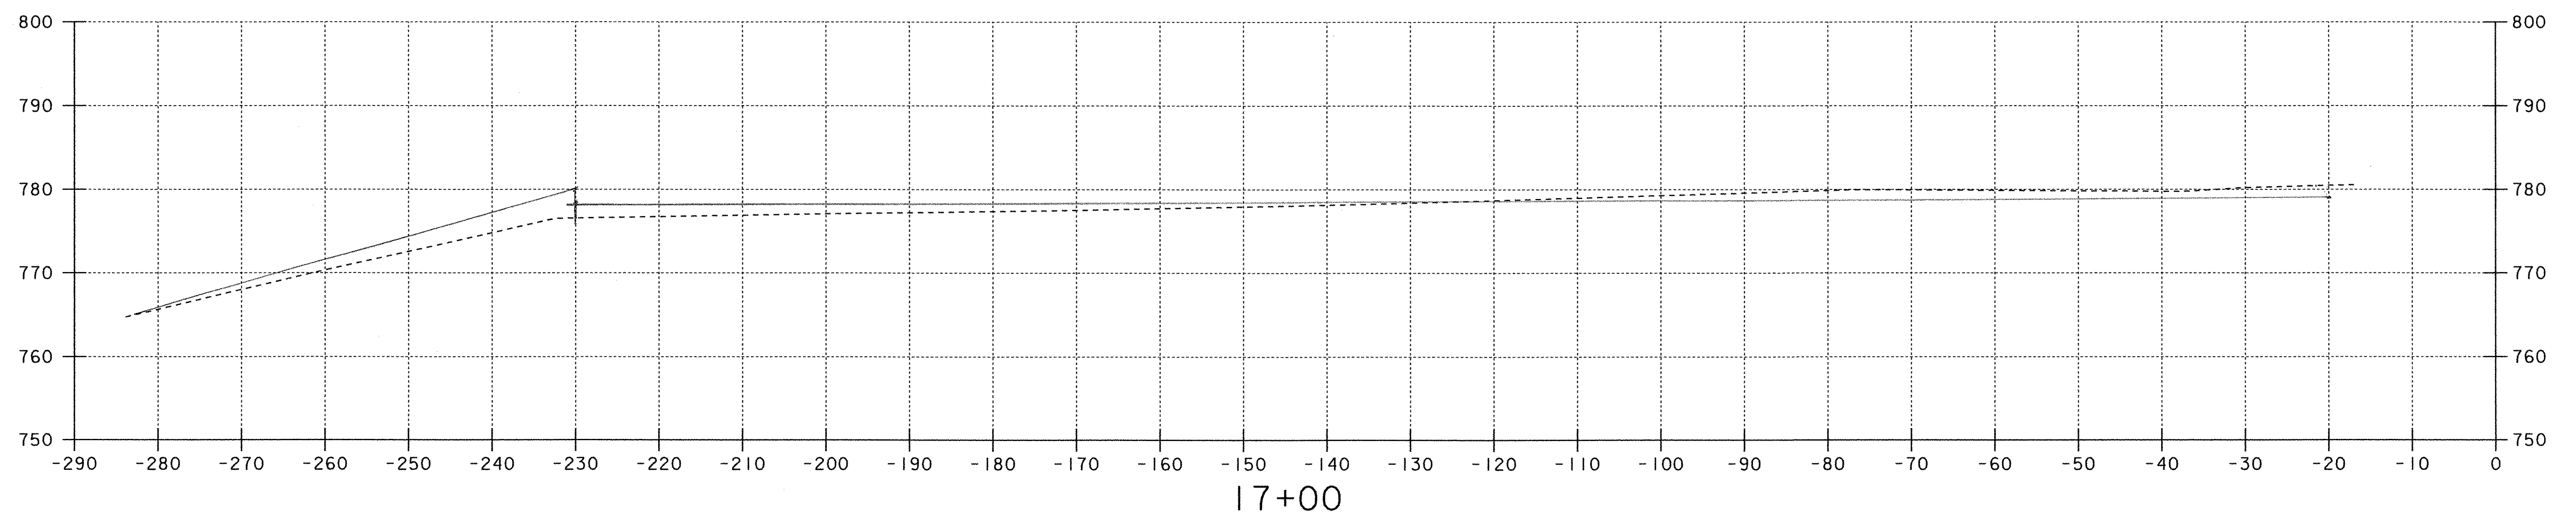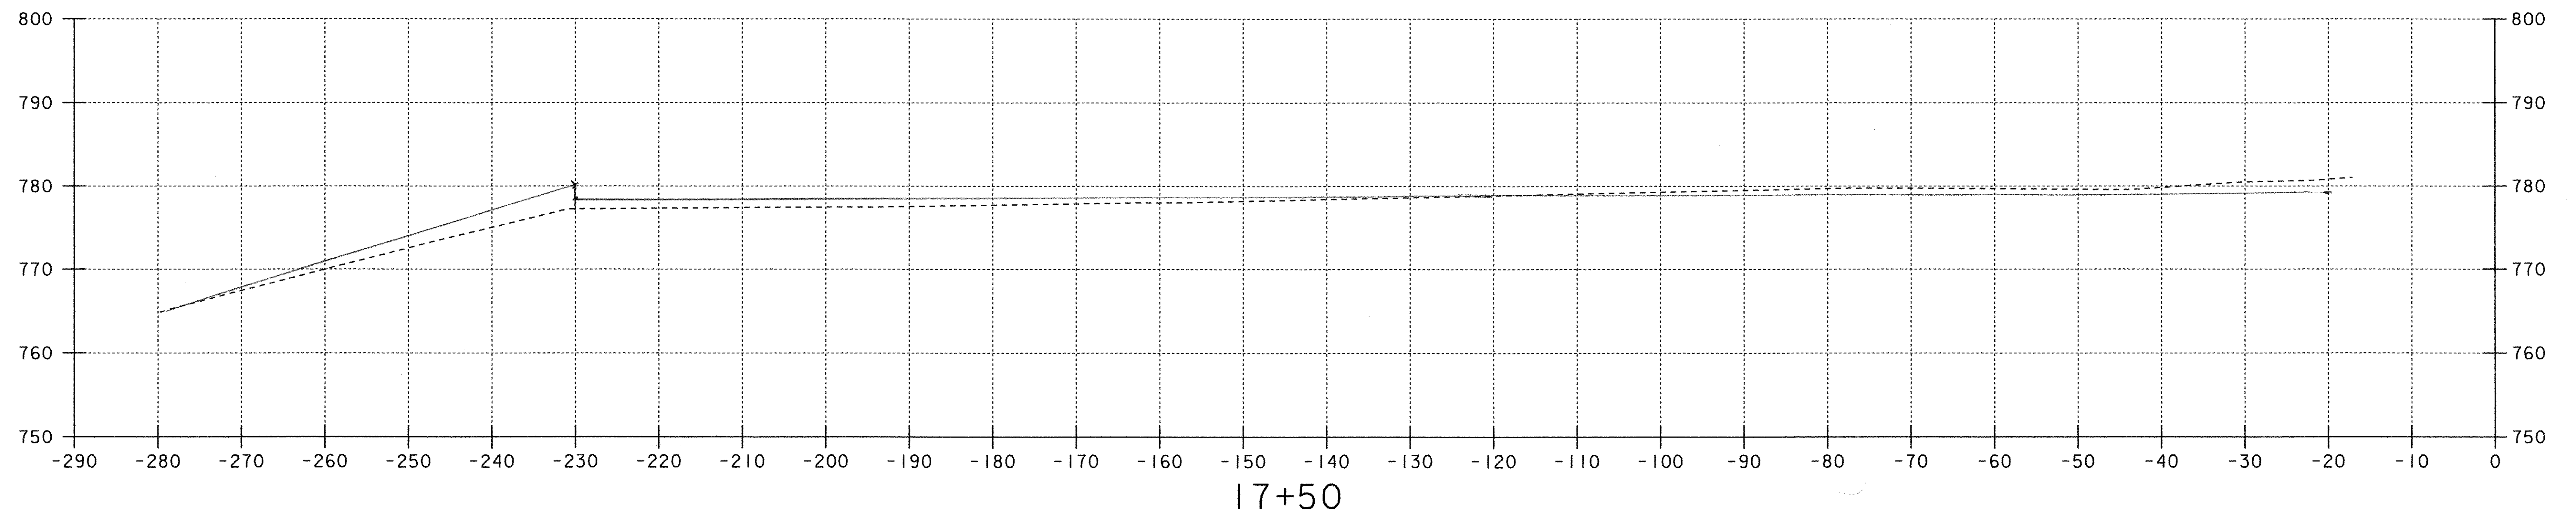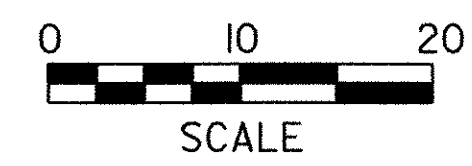


WASTE AREA #3

PAGE 4 OF 4


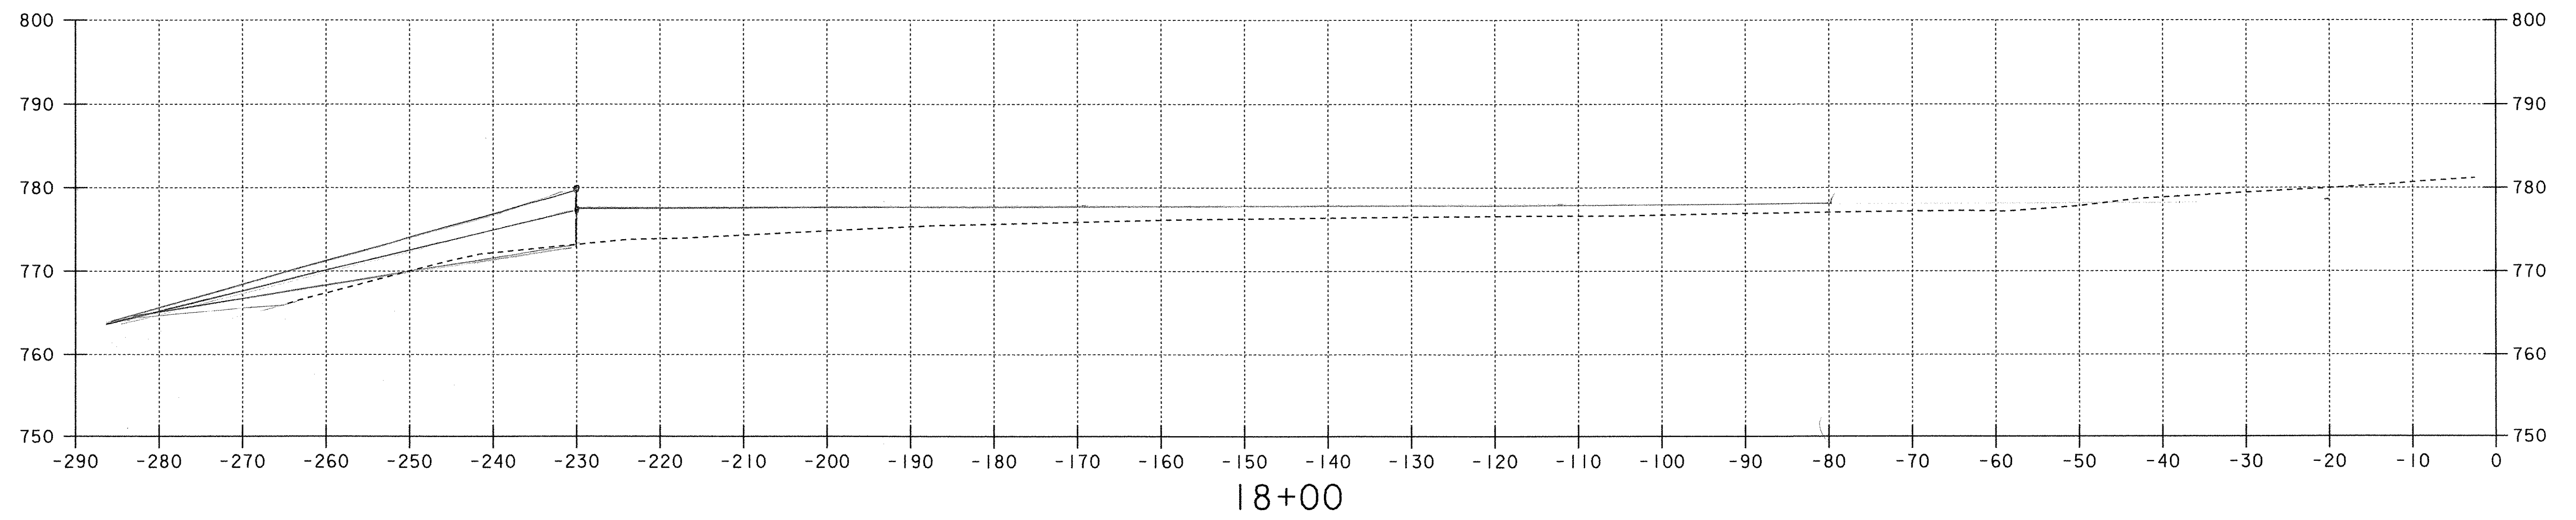
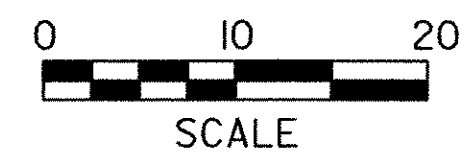


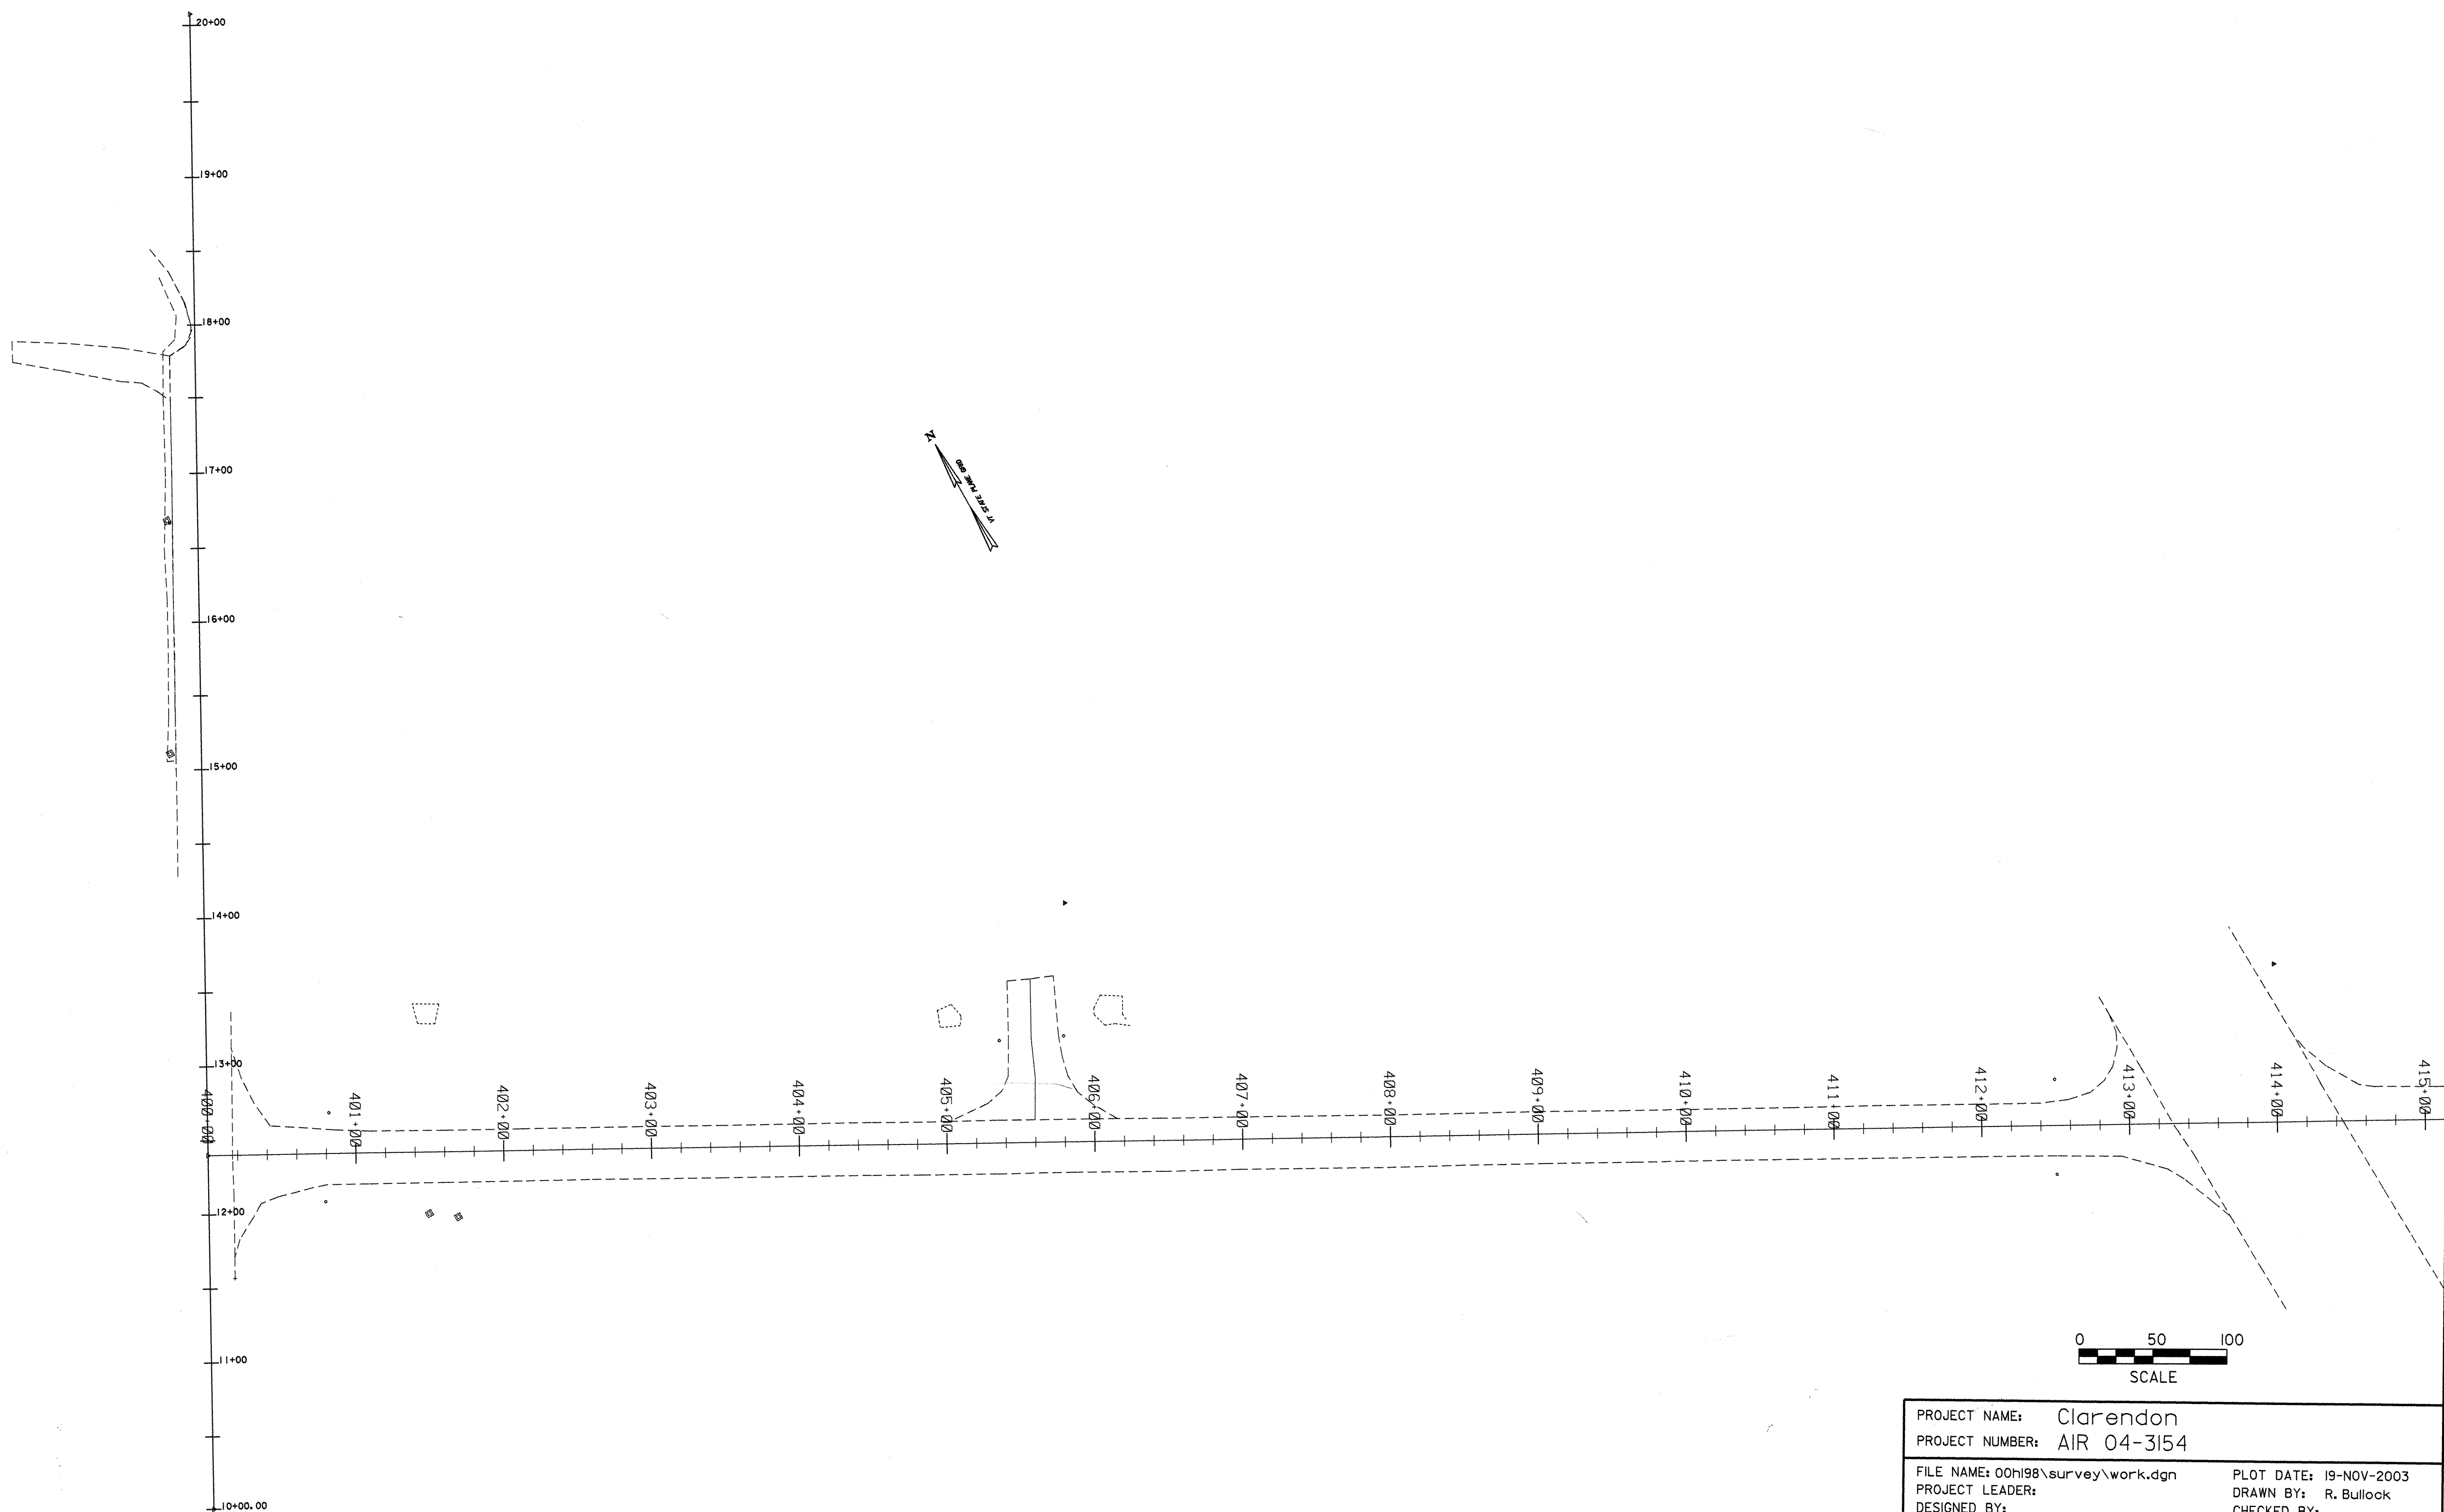

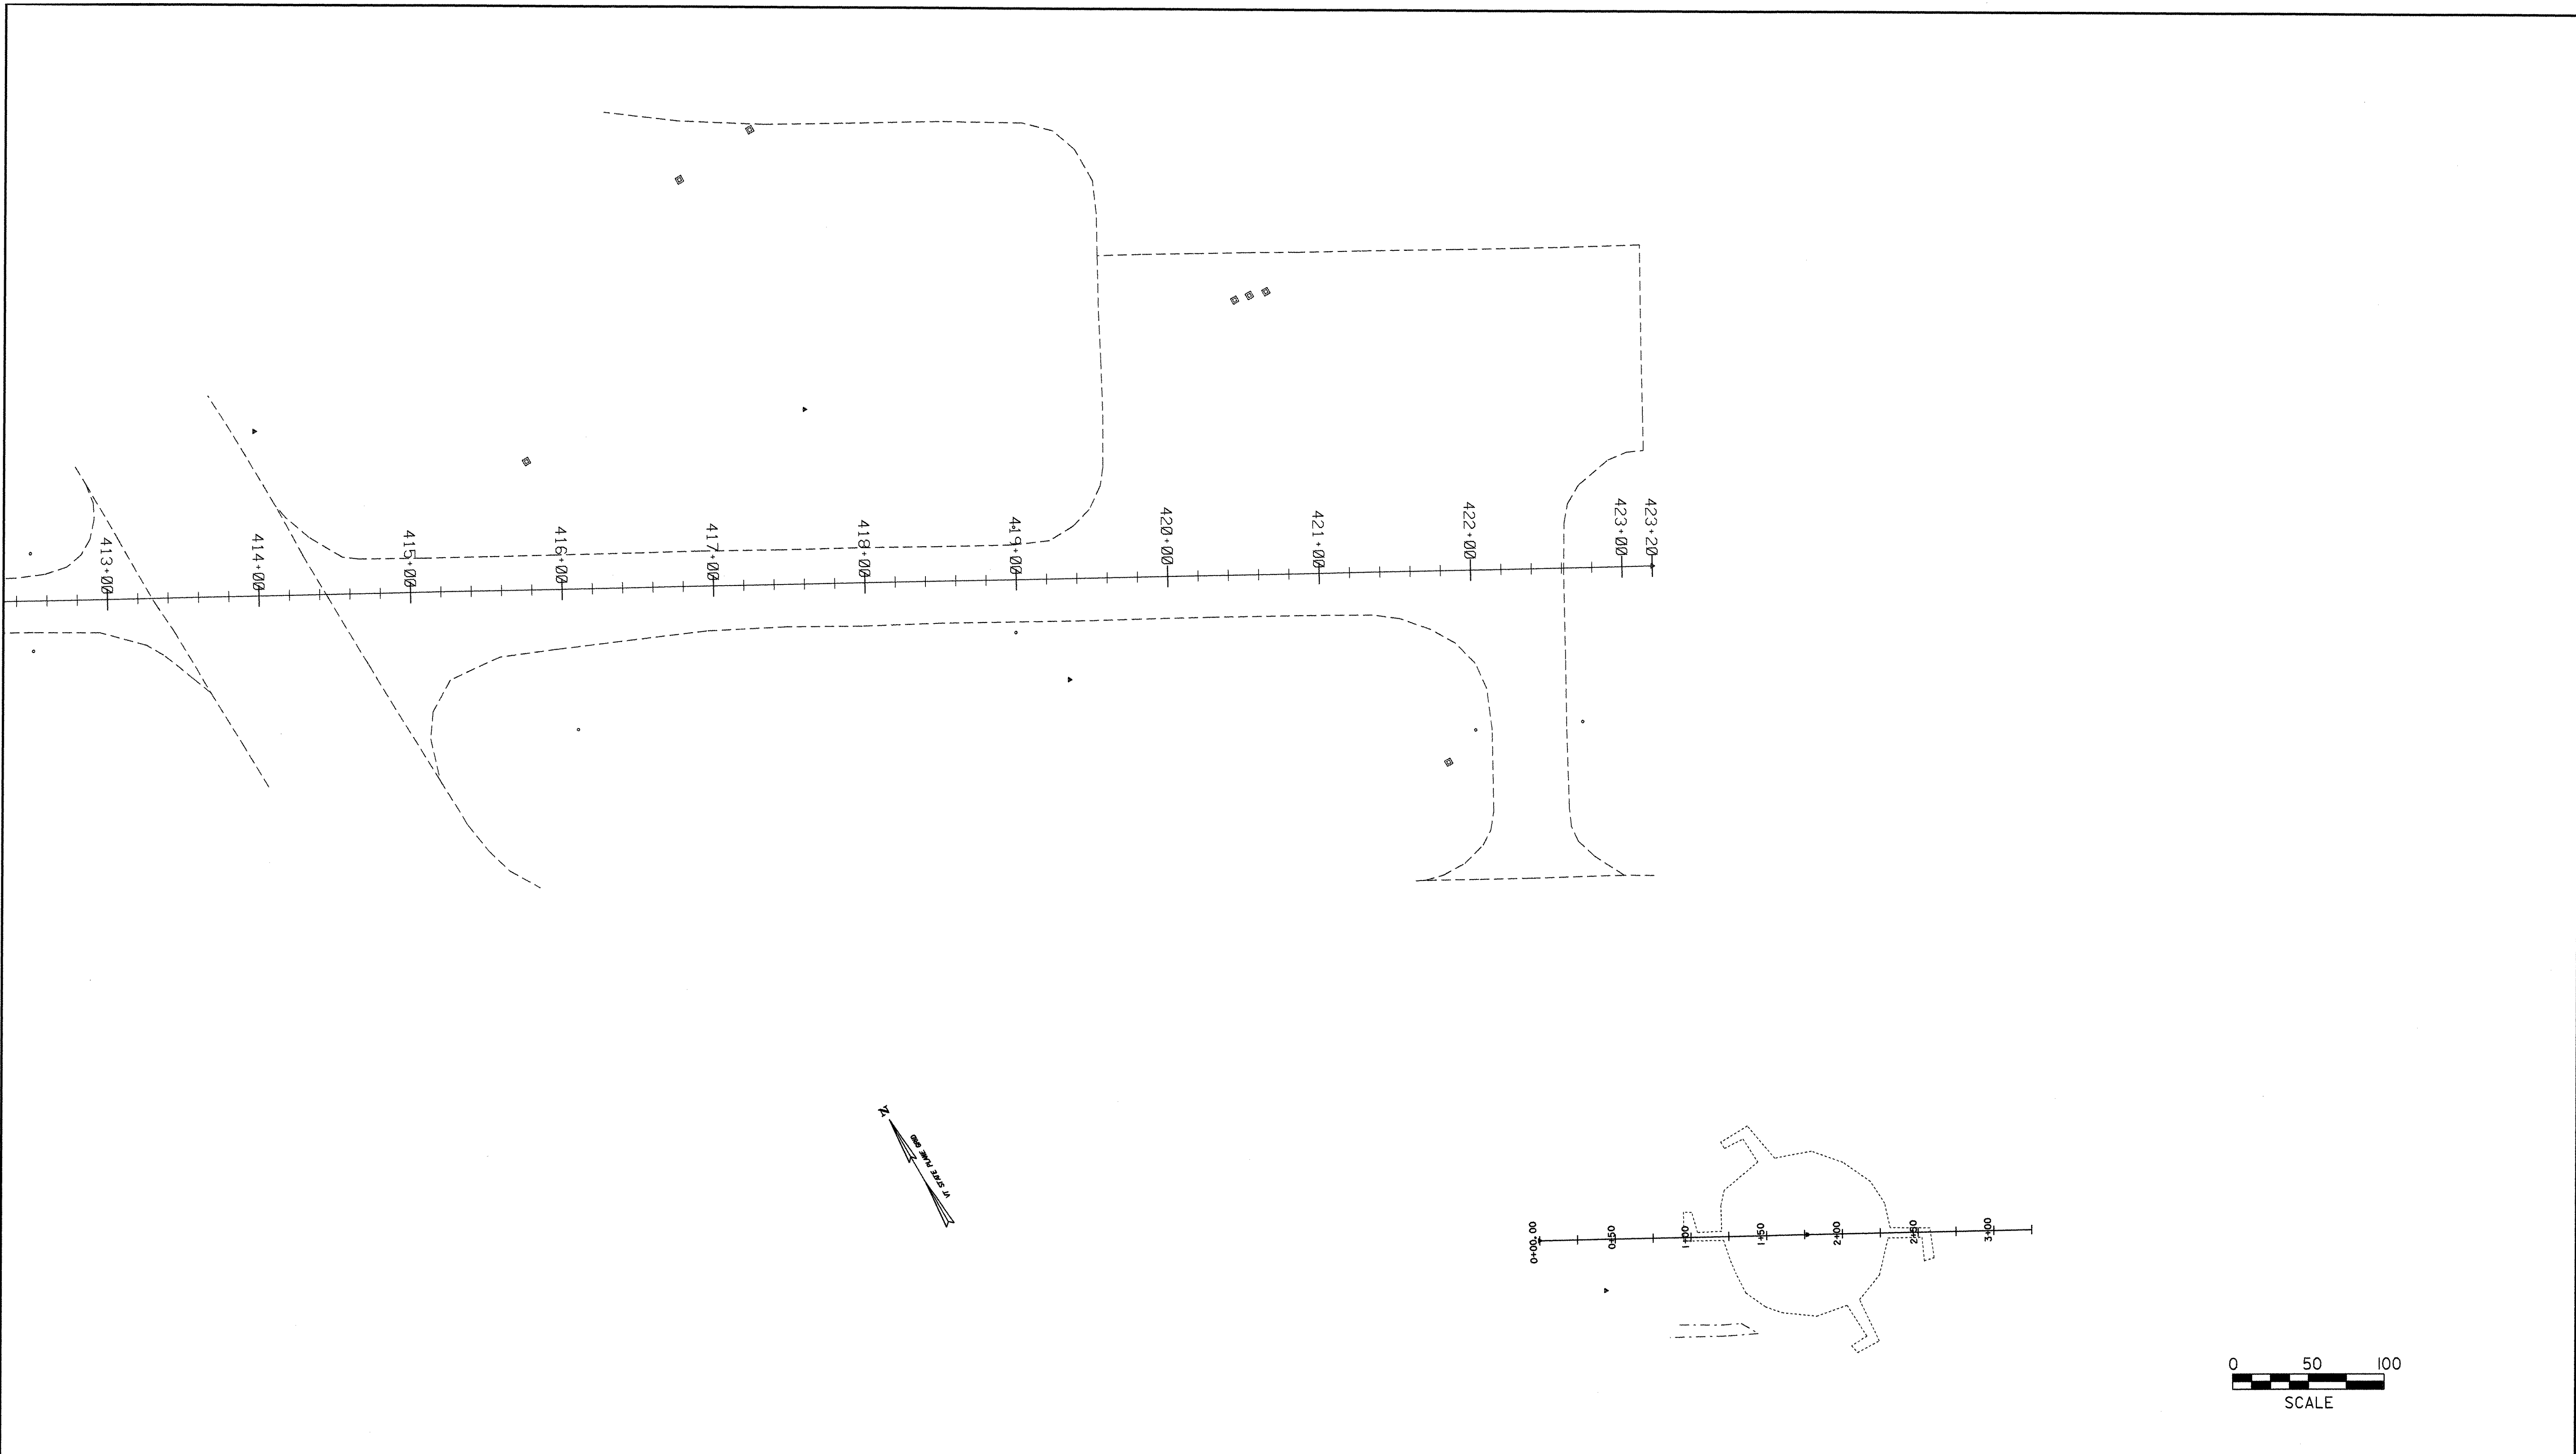


PROJECT NAME: Clarendon	
PROJECT NUMBER: AIR 04-3154	
FILE NAME: 00h198\survey\work.dgn	PLOT DATE: 19-NOV-2003
PROJECT LEADER:	DRAWN BY: R. Bullock
DESIGNED BY:	CHECKED BY:
	SHEET 2 OF 2 048


Waste Area 3

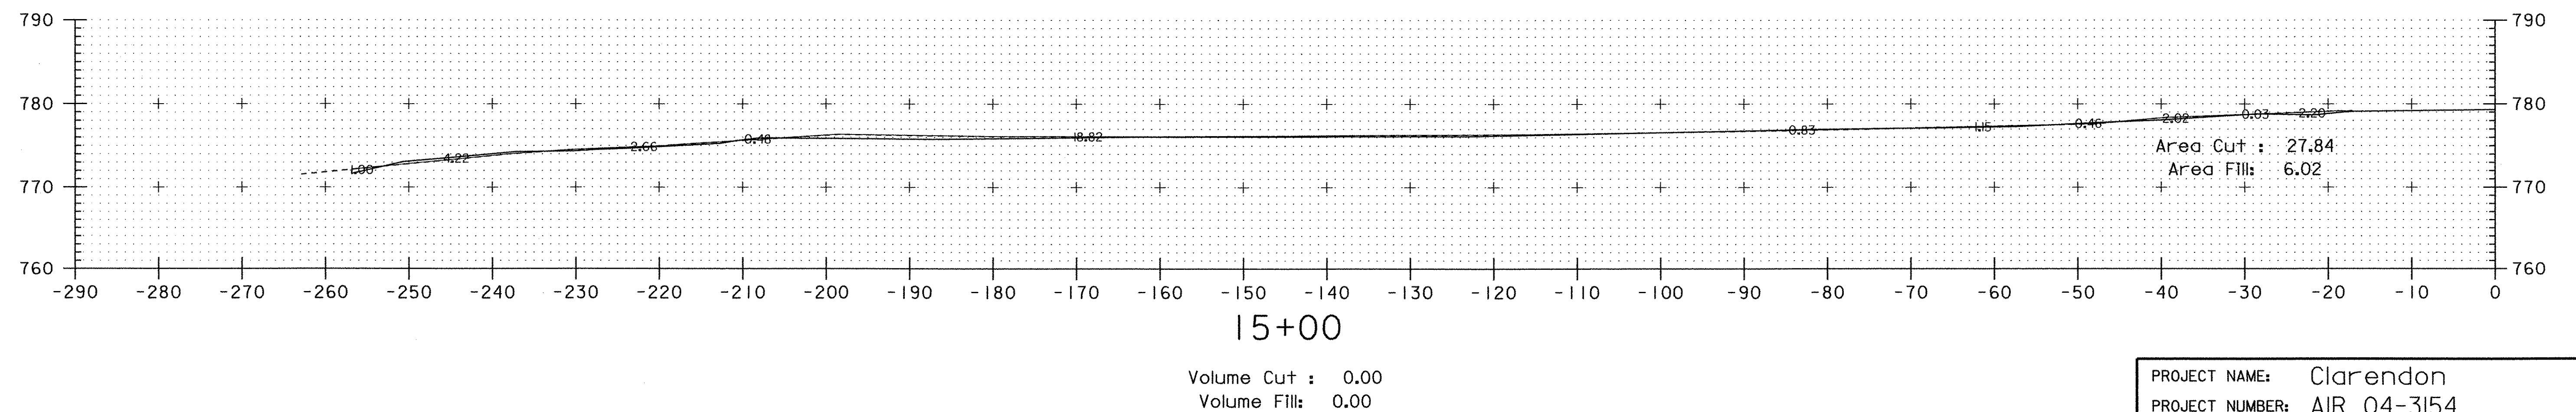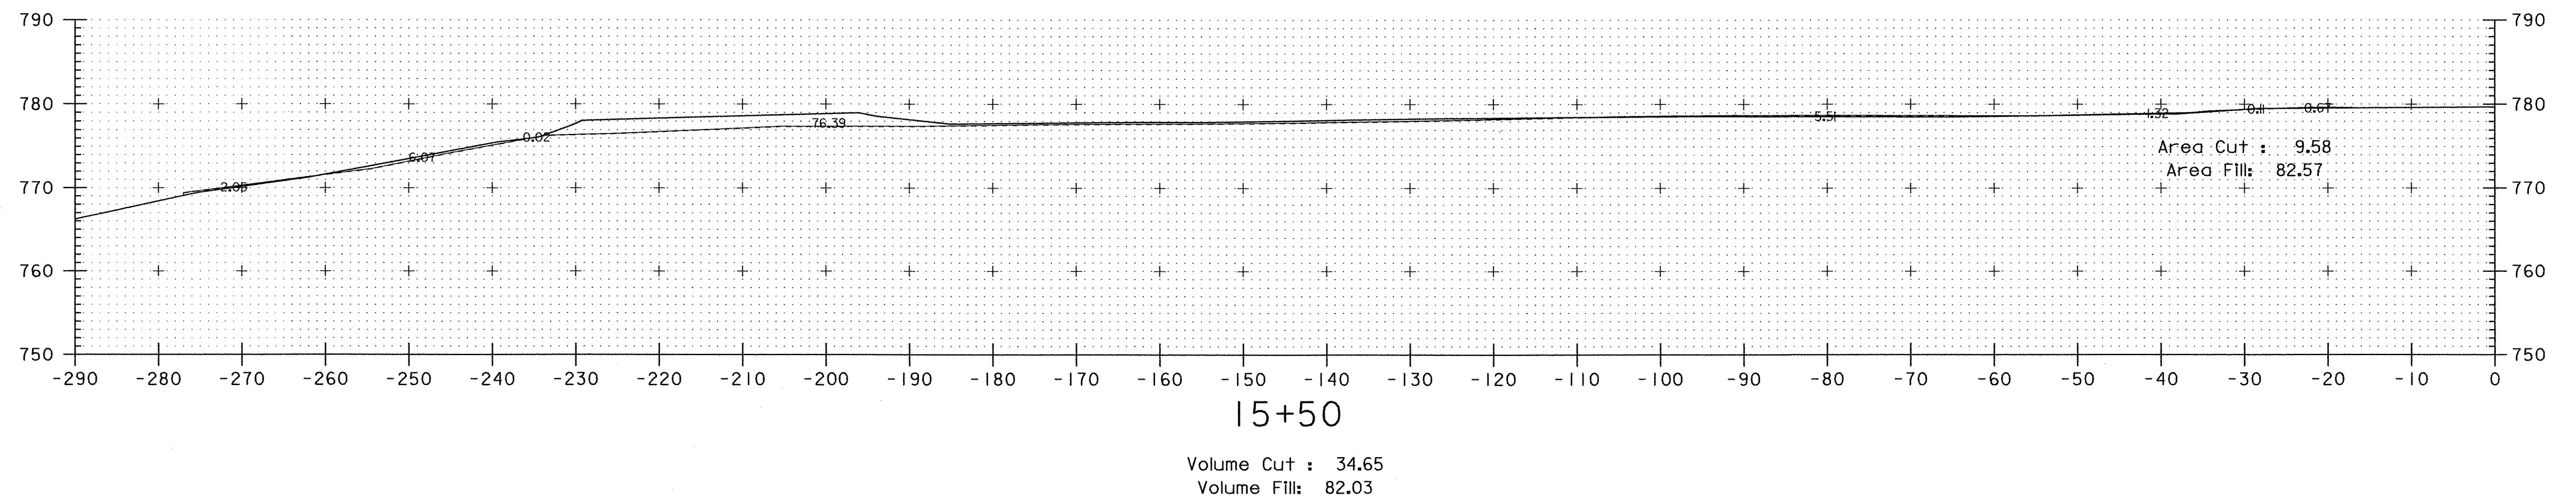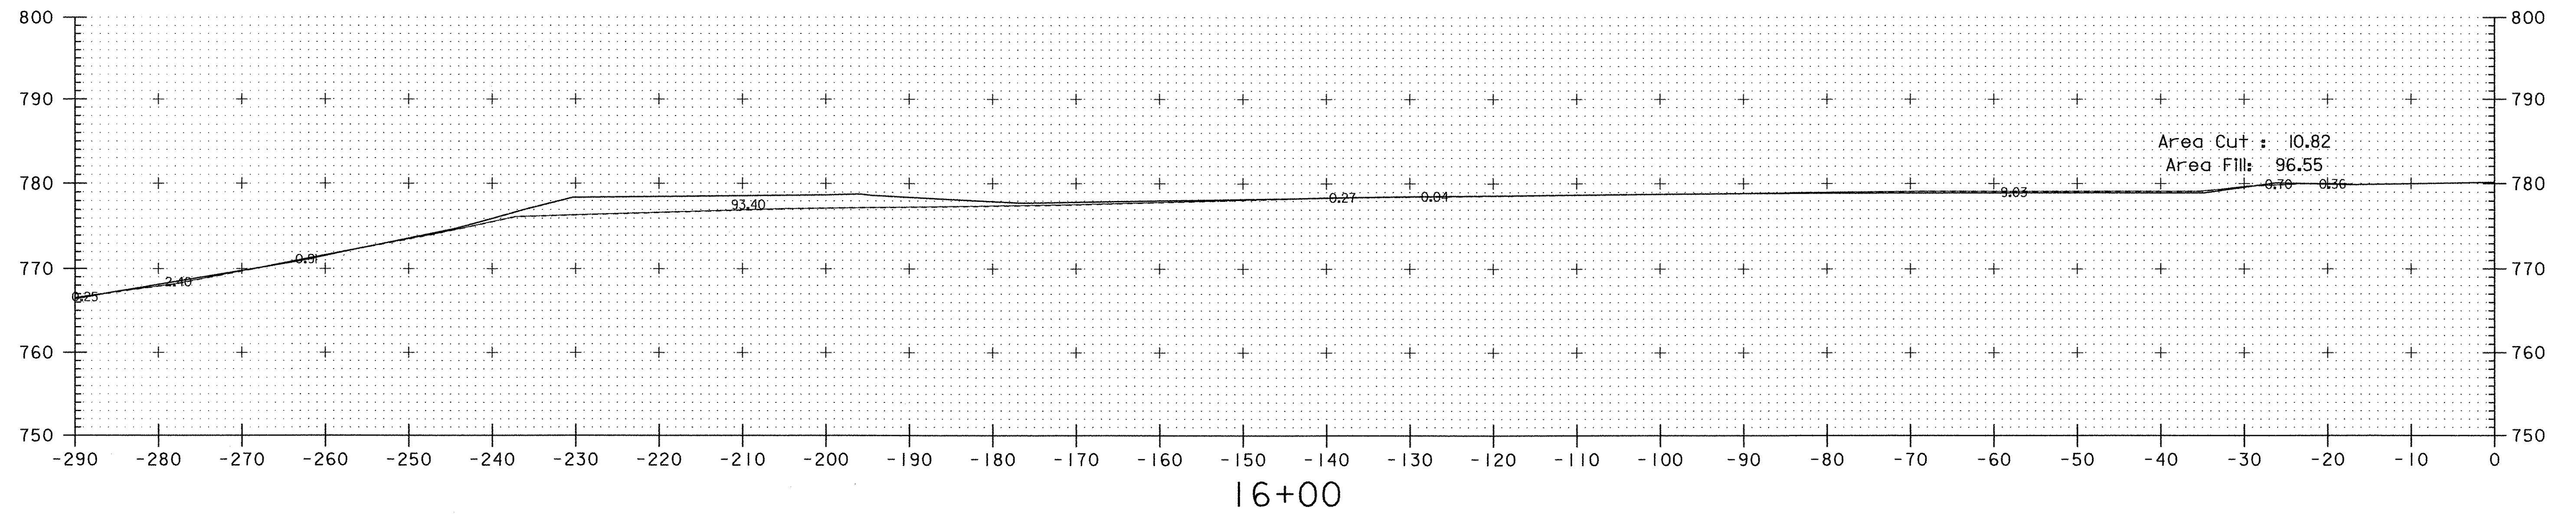

PROJECT NAME:	Clarendon
PROJECT NUMBER:	AIR 04-3154
FILE NAME:	00h98/survey/work.dgn
PROJECT LEADER:	R. Bullock
DESIGNED BY:	CHECKED BY:
Waste Area	SHEET 1 OF 3 049

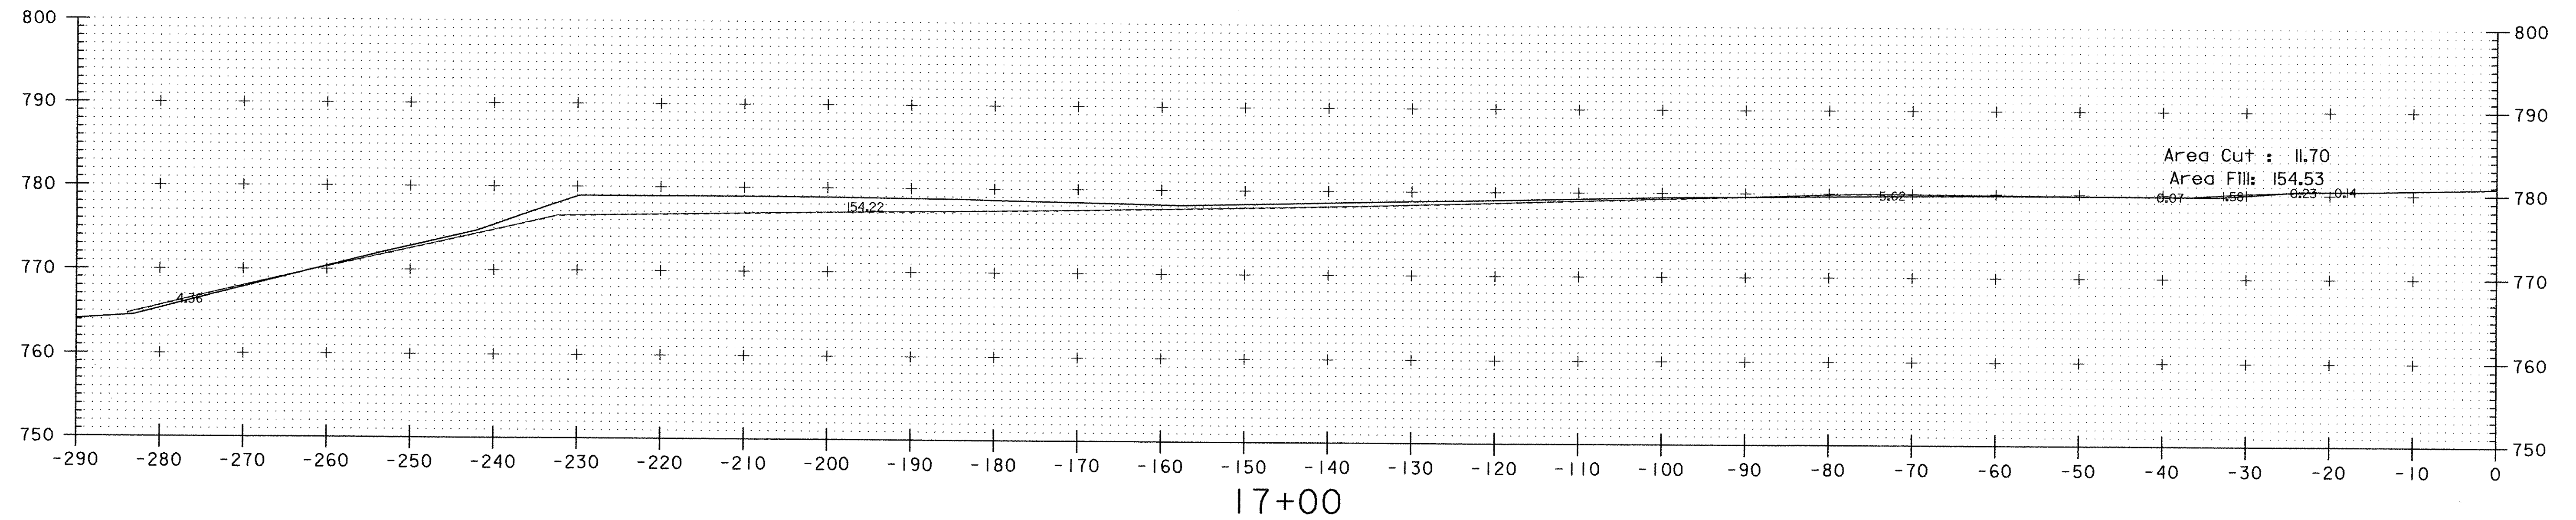


Volume Cut : 37.70
Volume Fill: 269.99

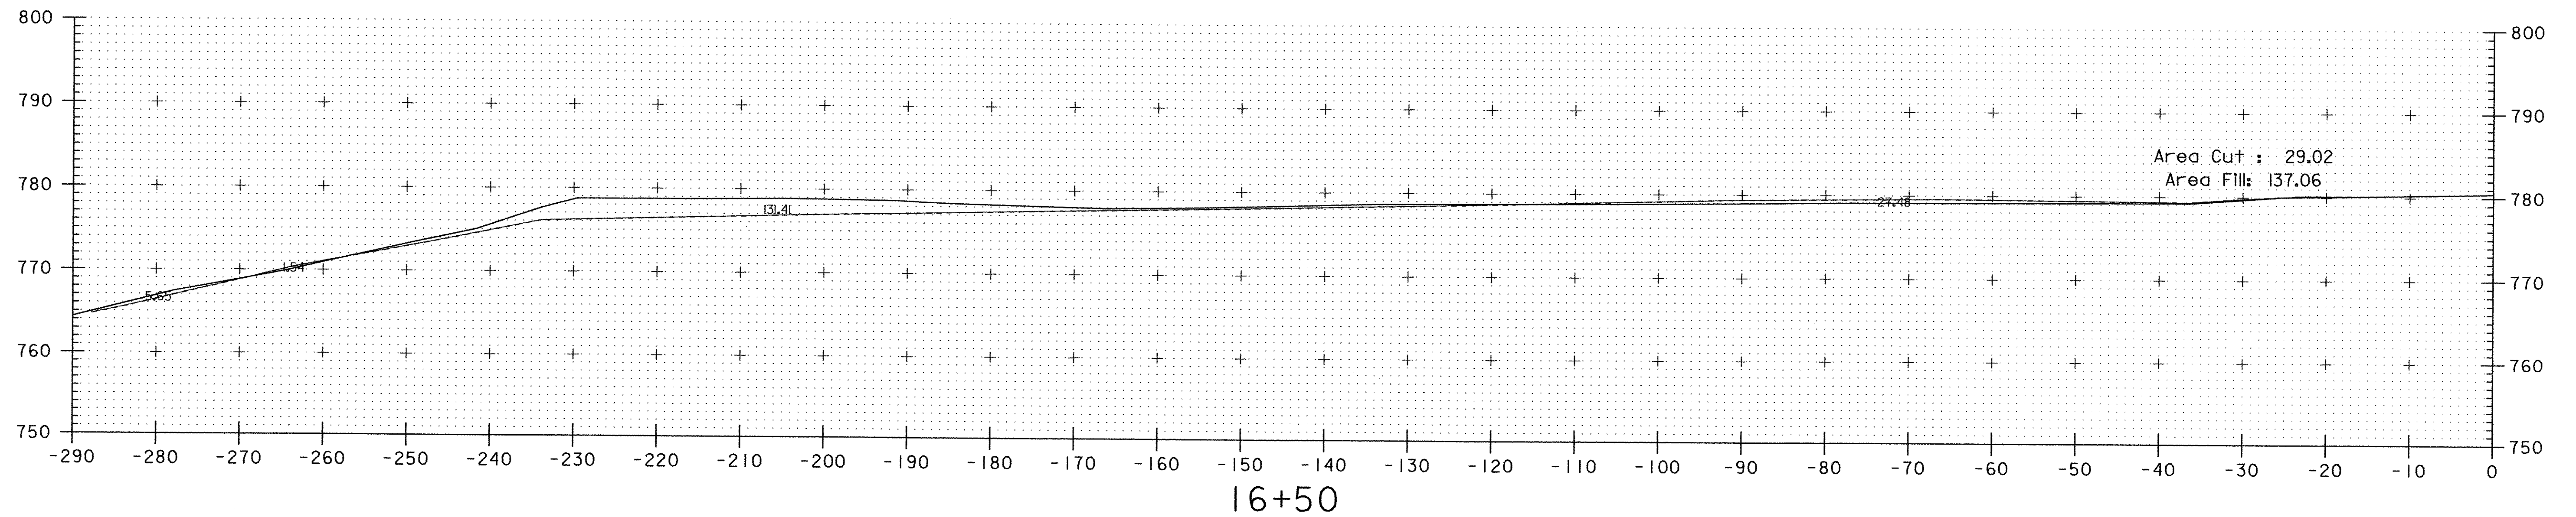


Volume Cut : 36.88
Volume Fill: 216.30

PROJECT NAME: Clarendon	
PROJECT NUMBER: AIR 04-3154	
FILE NAME: 00h98/survey/work.dgn	PLOT DATE: 19-NOV-2003
PROJECT LEADER:	DRAWN BY: R. Bullock
DESIGNED BY:	CHECKED BY:
Waste Area	SHEET 2 OF 3 050

Waste Area 3

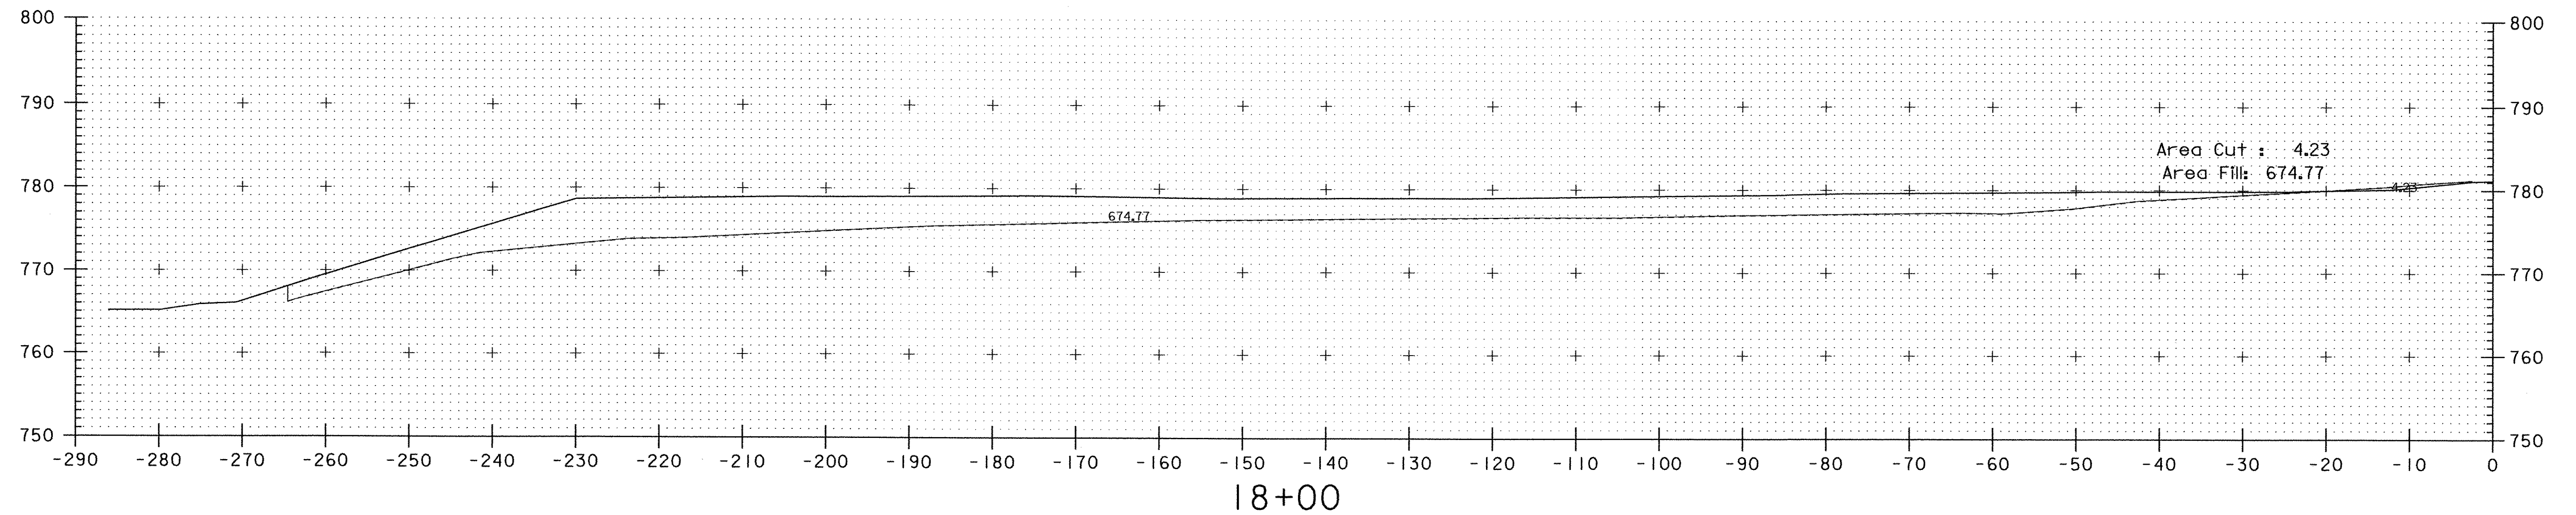


Volume Cut : 7.31
Volume Fill: 755.15

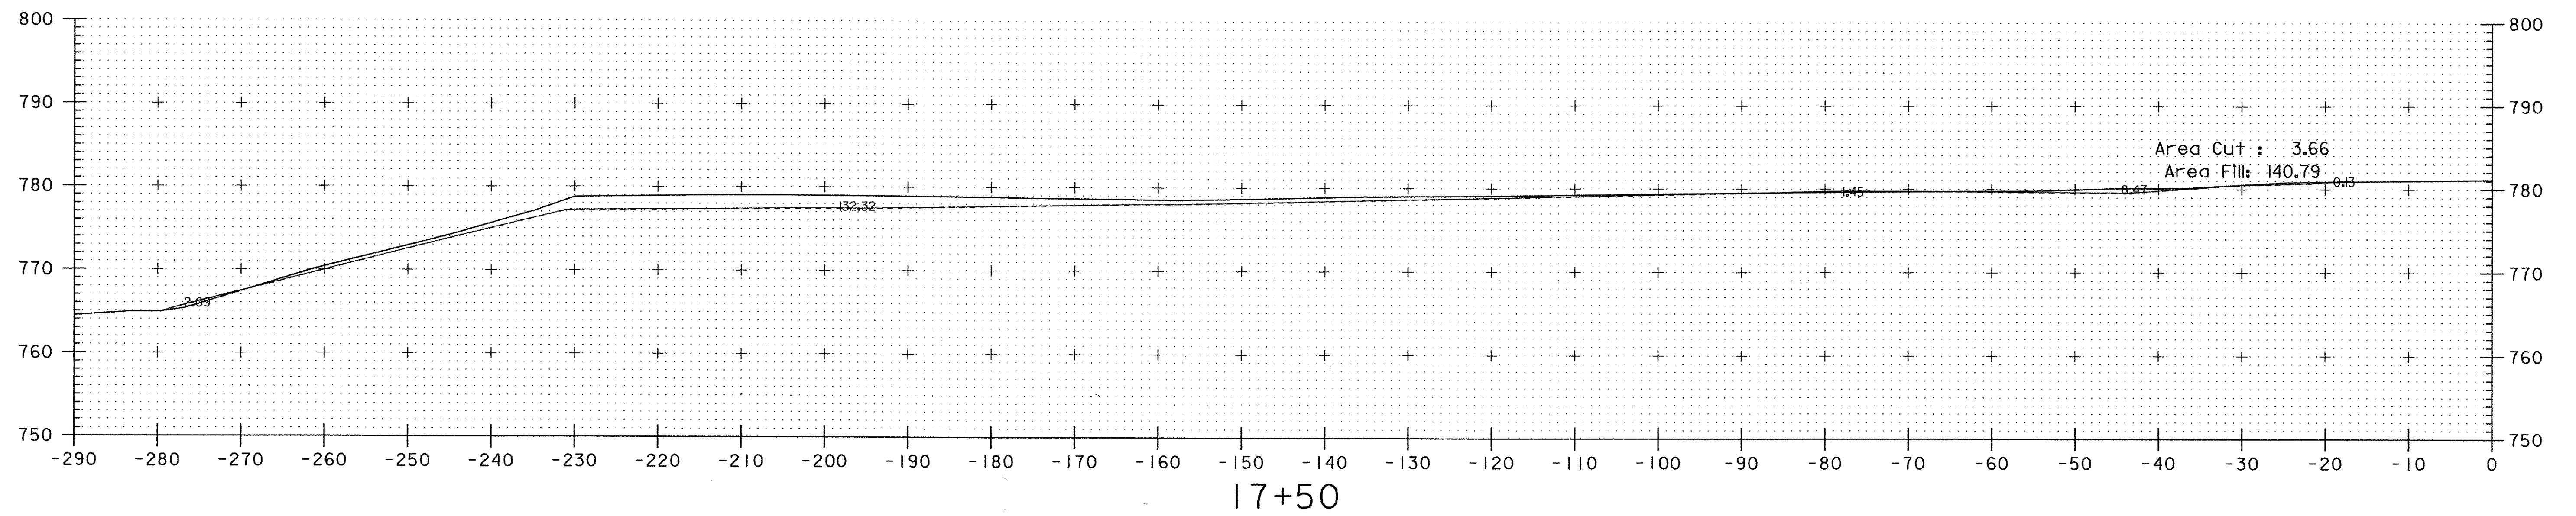


Volume Cut : 14.22
Volume Fill: 273.45

PROJECT NAME:	Clarendon
PROJECT NUMBER:	AIR 04-3154
FILE NAME:	00h98/survey/work.dgn
PROJECT LEADER:	
DESIGNED BY:	
Waste Area	
PLOT DATE:	19-NOV-2003
DRAWN BY:	R. Bullock
CHECKED BY:	
SHEET 3	OF 3 051


Segmented Circle

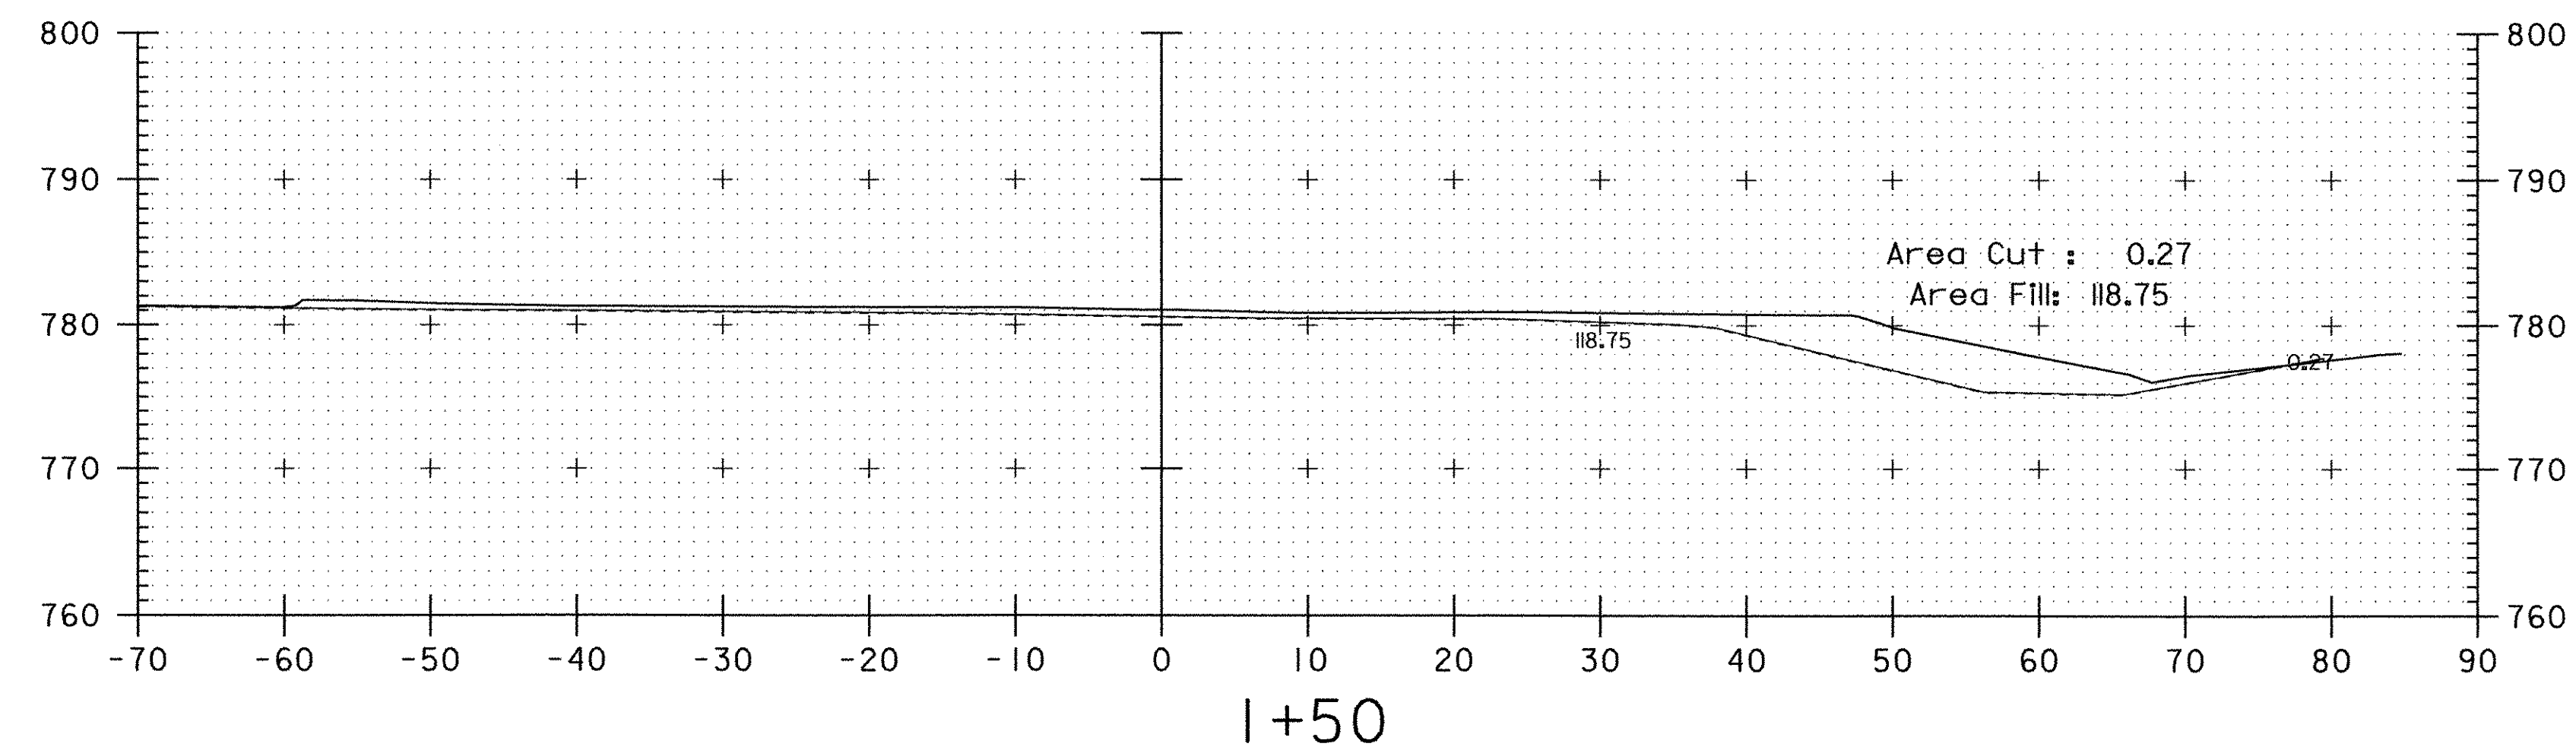

Volume Cut : 0.20
Volume Fill: 72.52

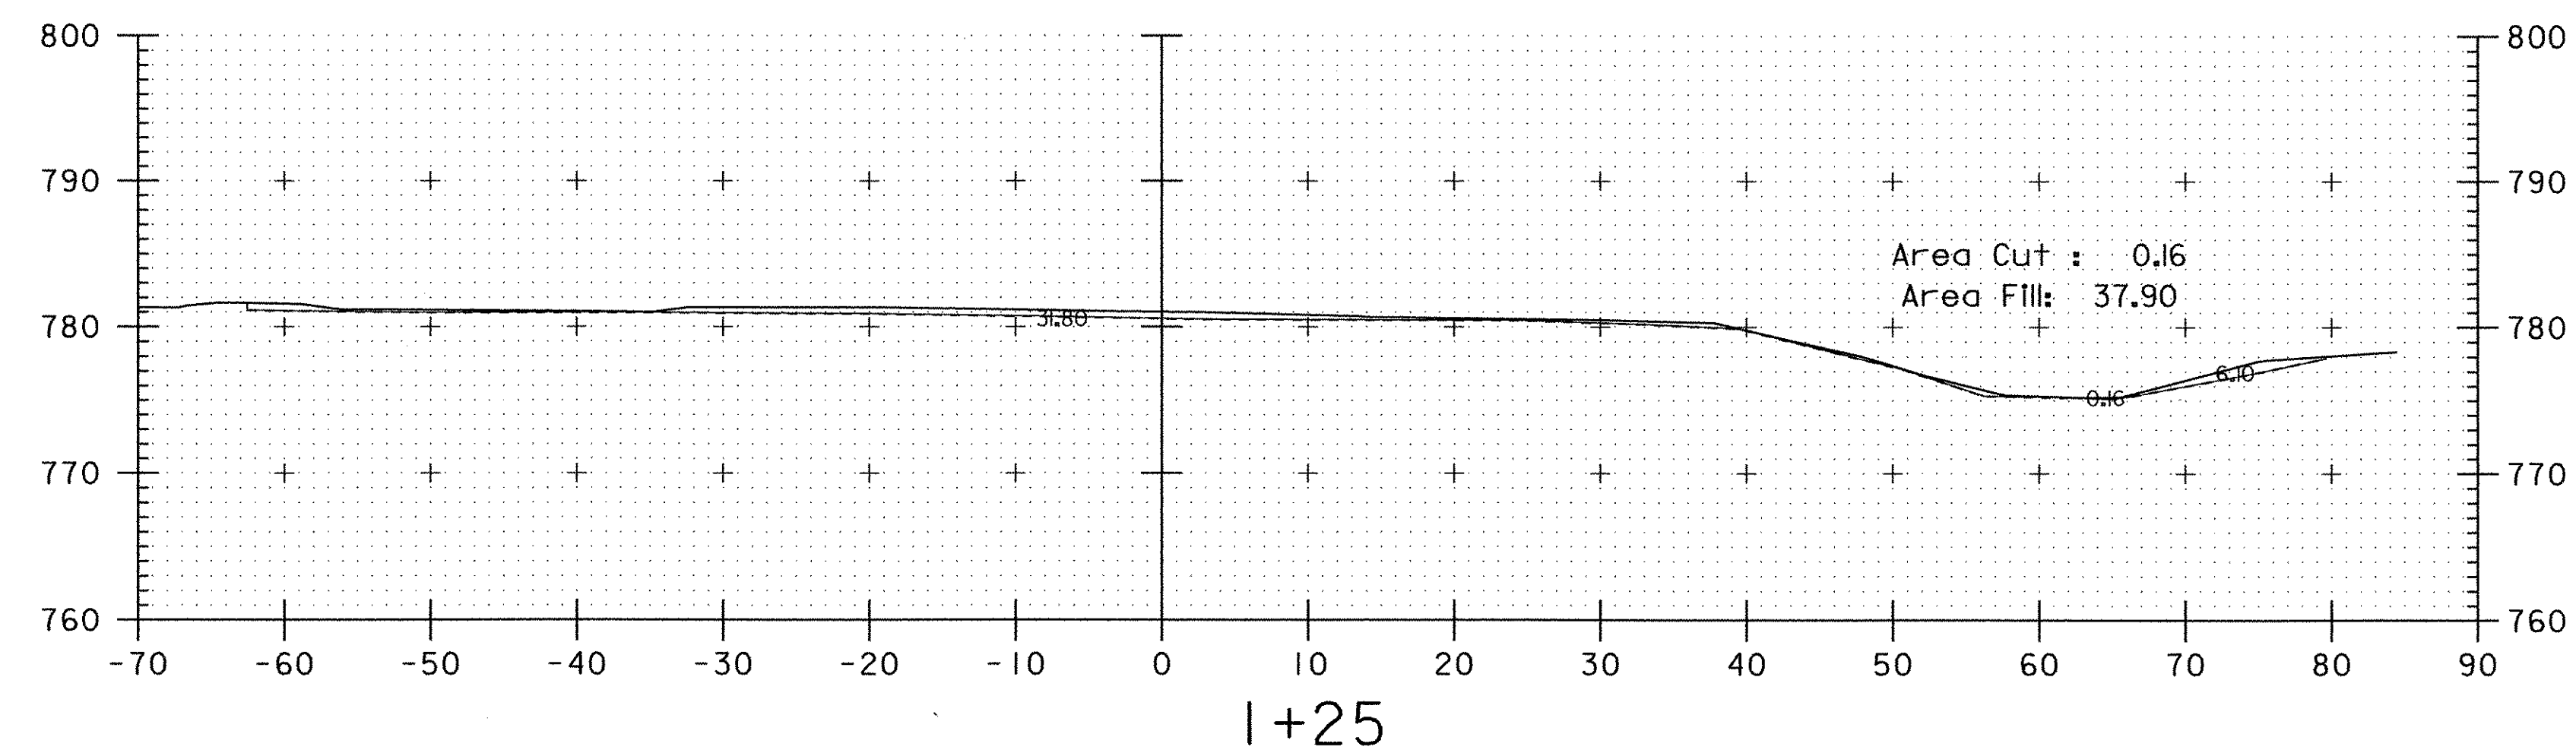

Volume Cut : 2.94
Volume Fill: 20.66

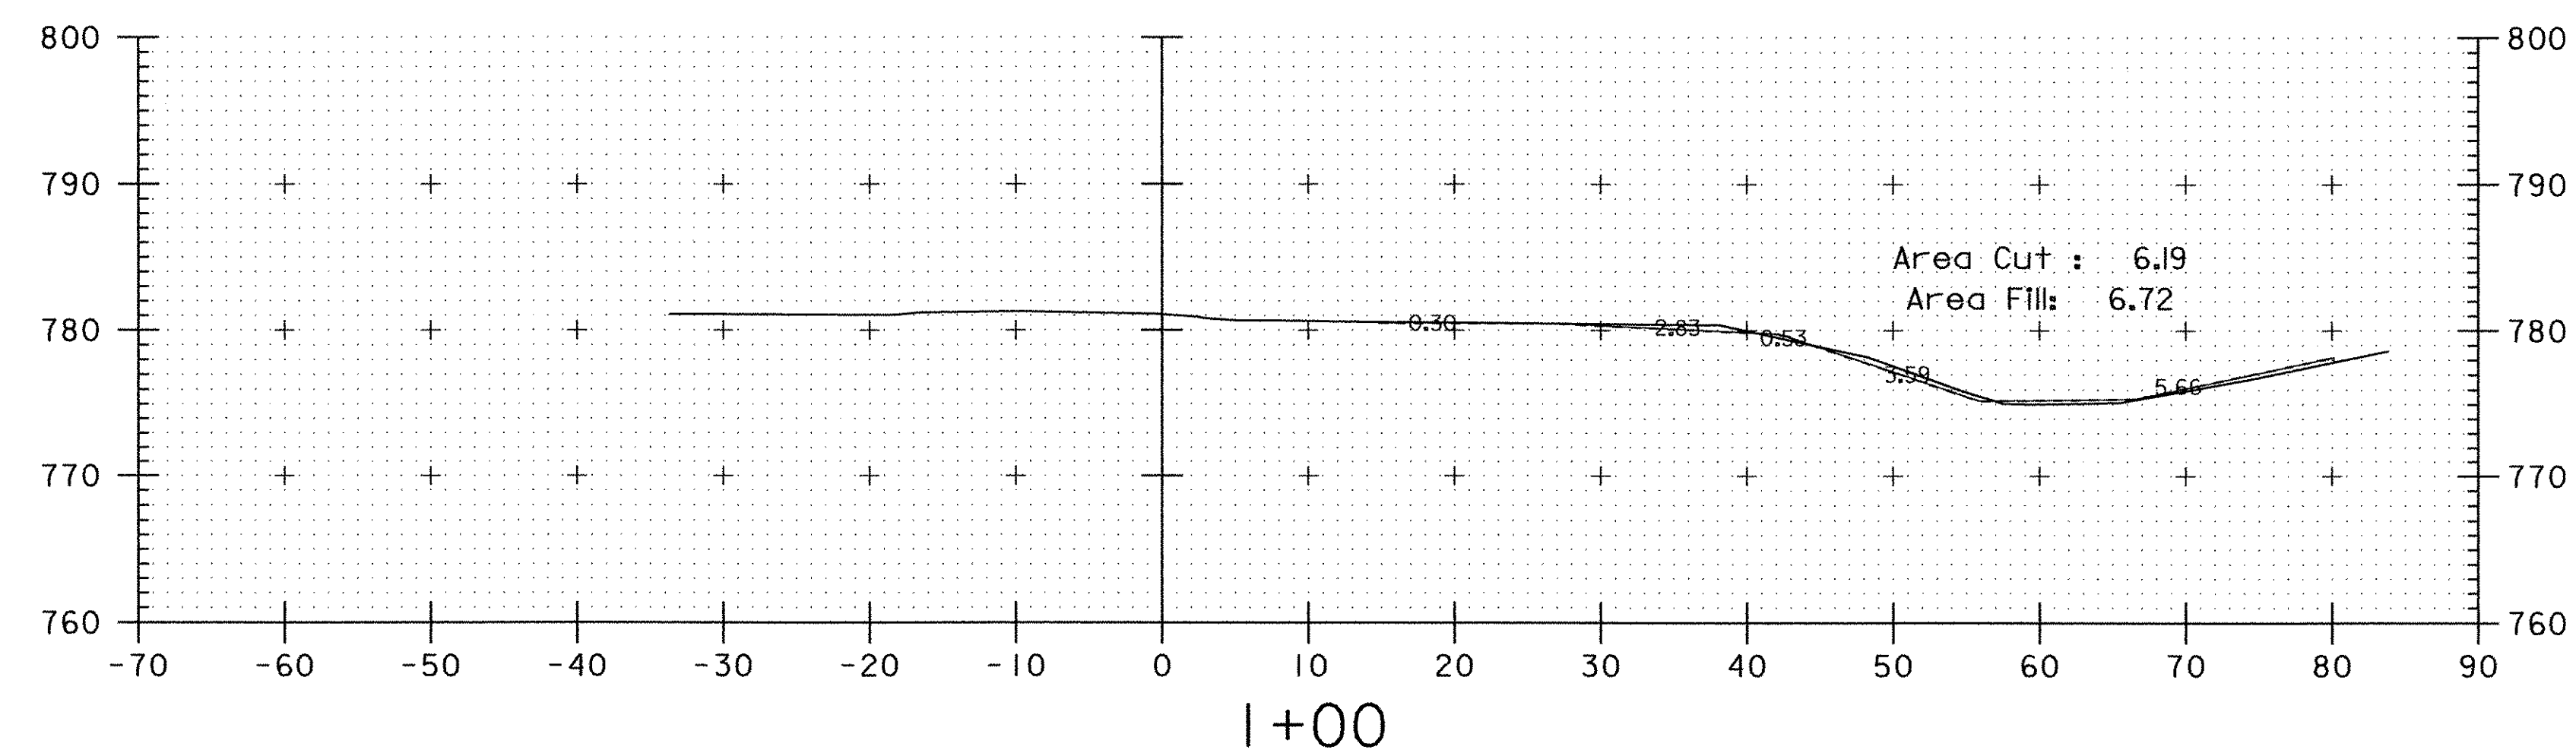


Volume Cut : 0.00
Volume Fill: 0.00

PROJECT NAME:	Clarendon	PLOT DATE:	19-NOV-2003
PROJECT NUMBER:	AIR 04-3154	DRAWN BY:	R. Bullock
FILE NAME:	00h98/survey/work.dgn	CHECKED BY:	
PROJECT LEADER:		SHEET 1	OF 2 052
DESIGNED BY:			
Circle Segment			


Segmented Circle

12/22/2003 2:22:41 PM


053

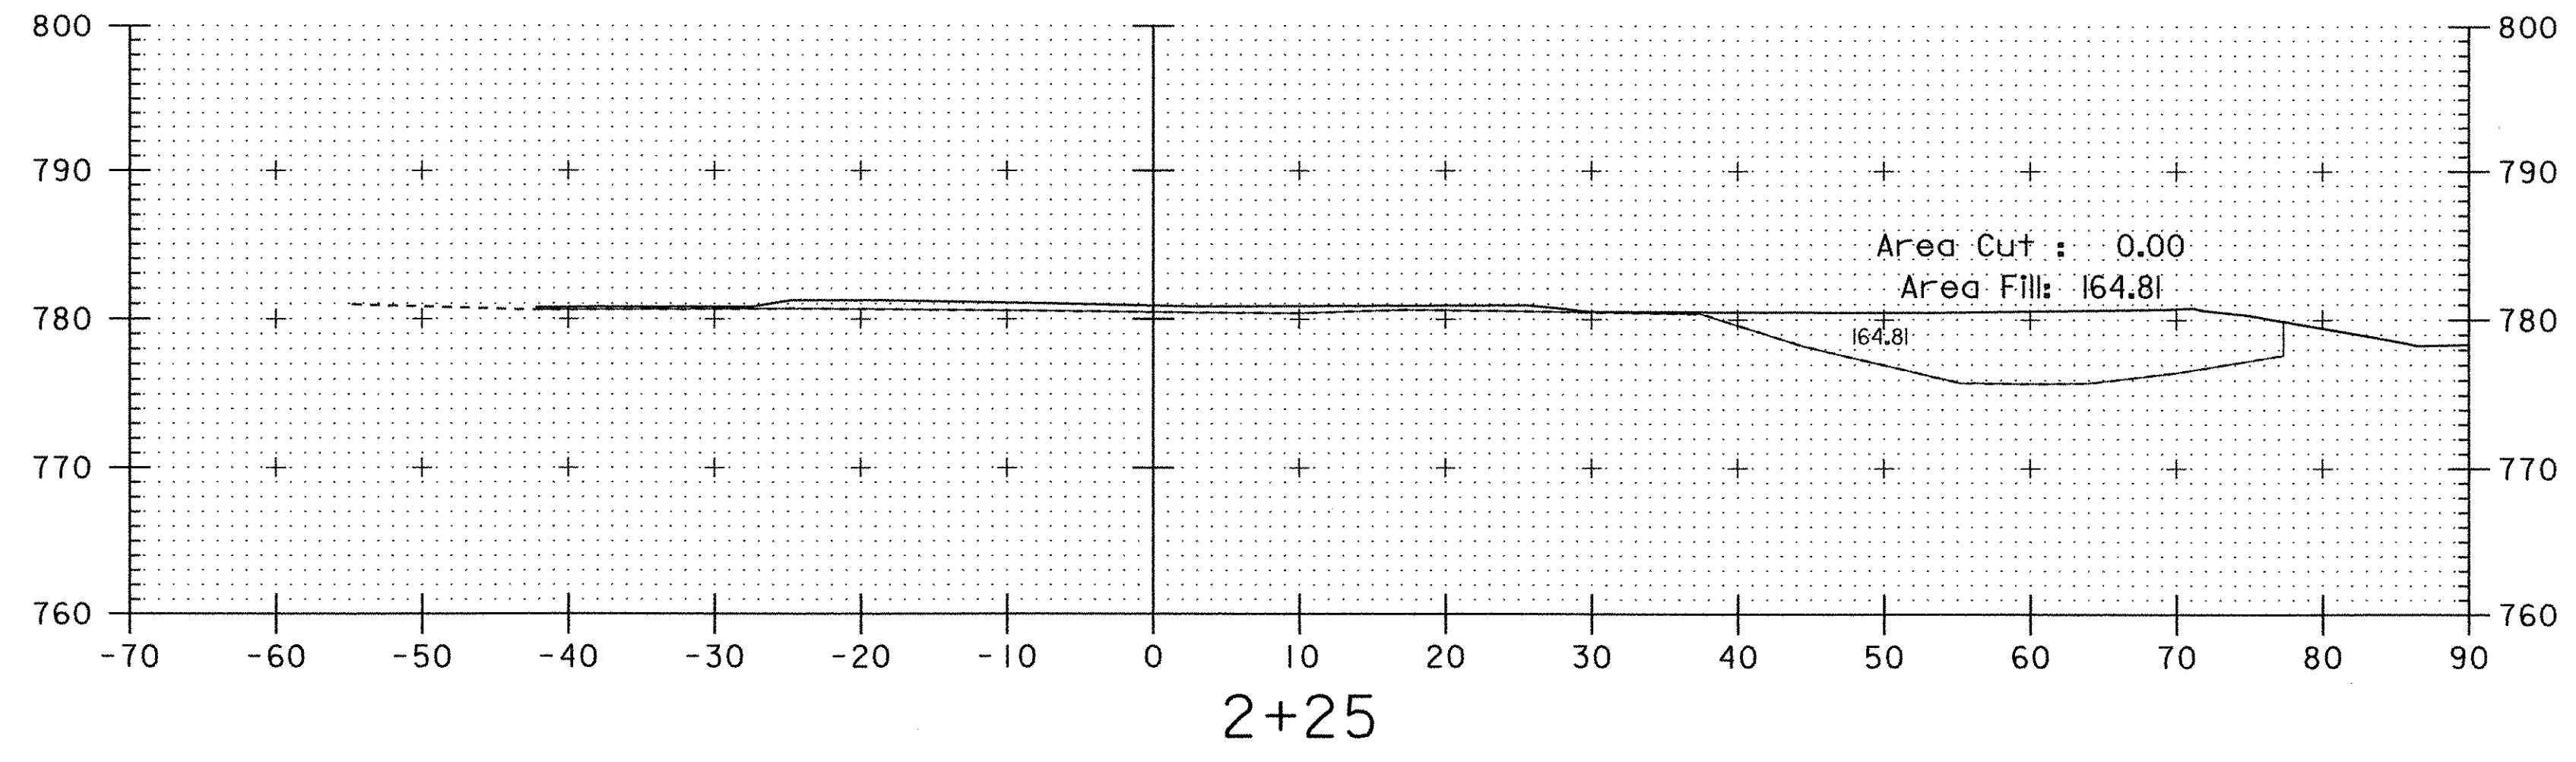

Volume Cut : 0.01
Volume Fill: 169.48








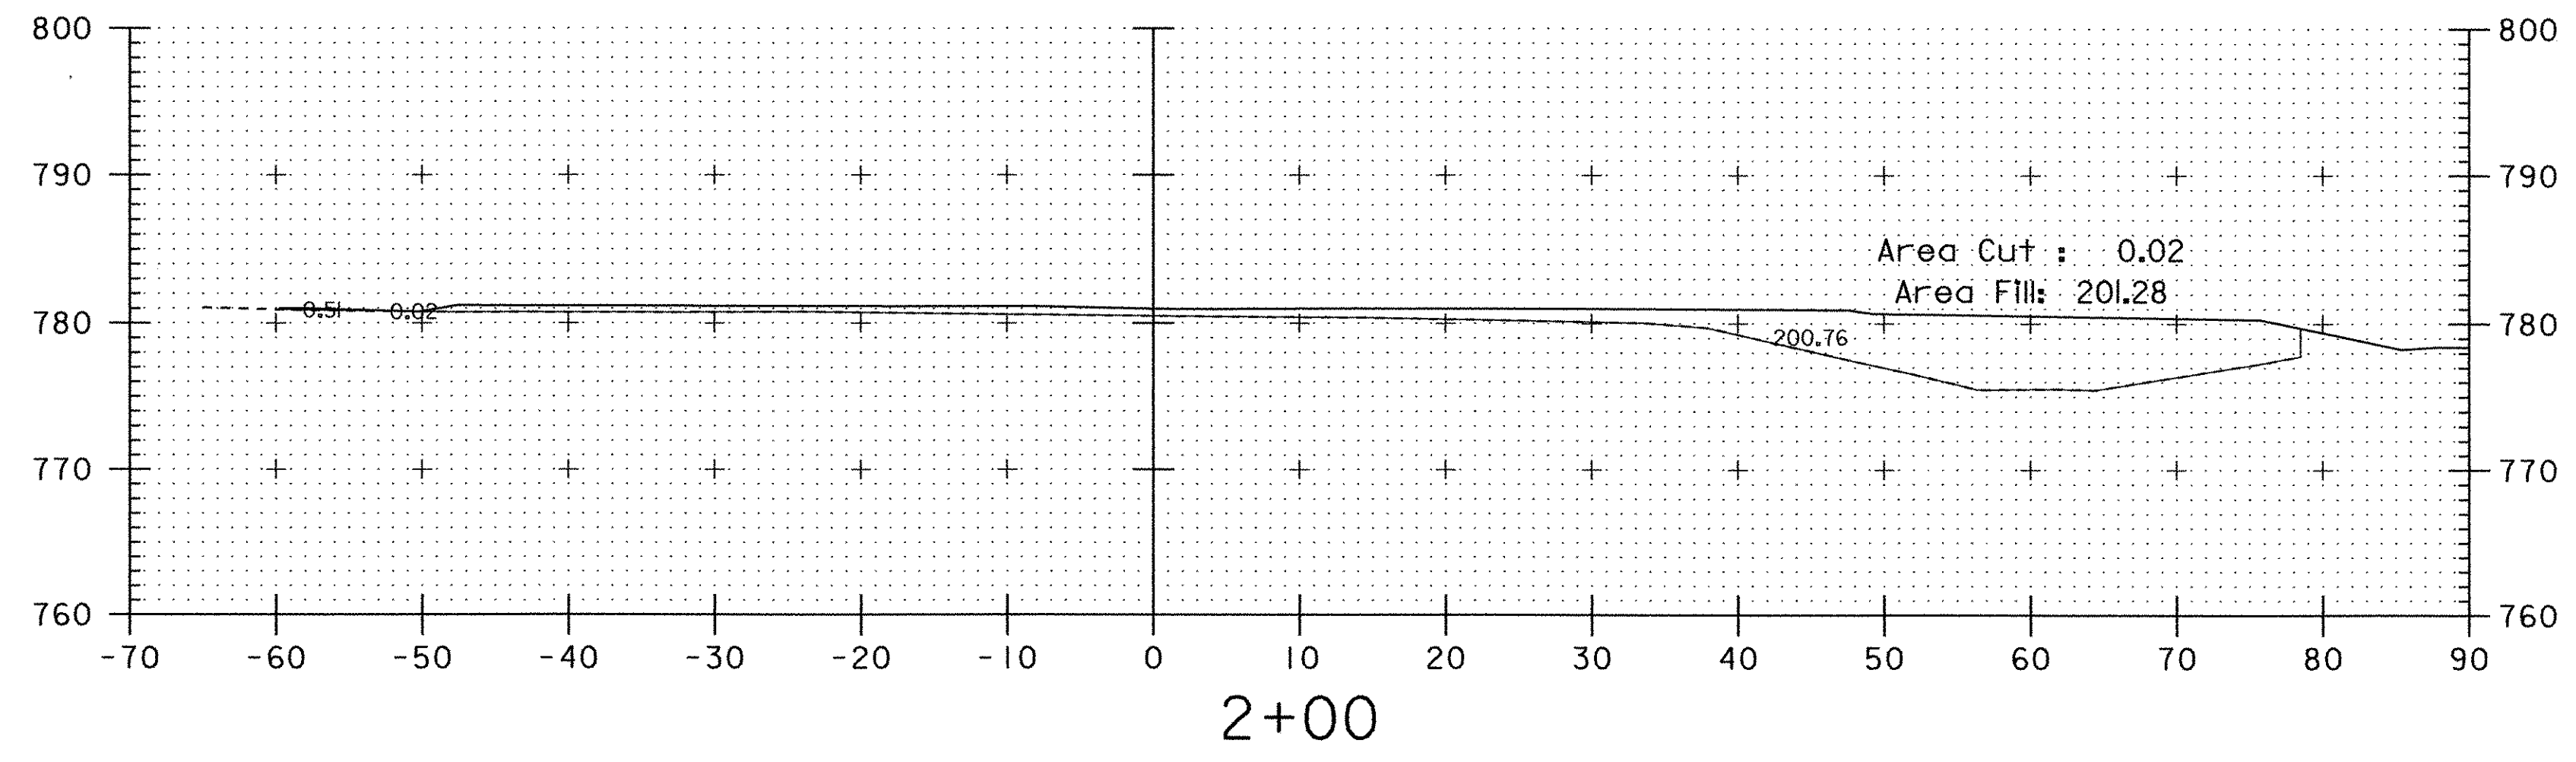


Volume Cut : 0.05
Volume Fill: 178.09

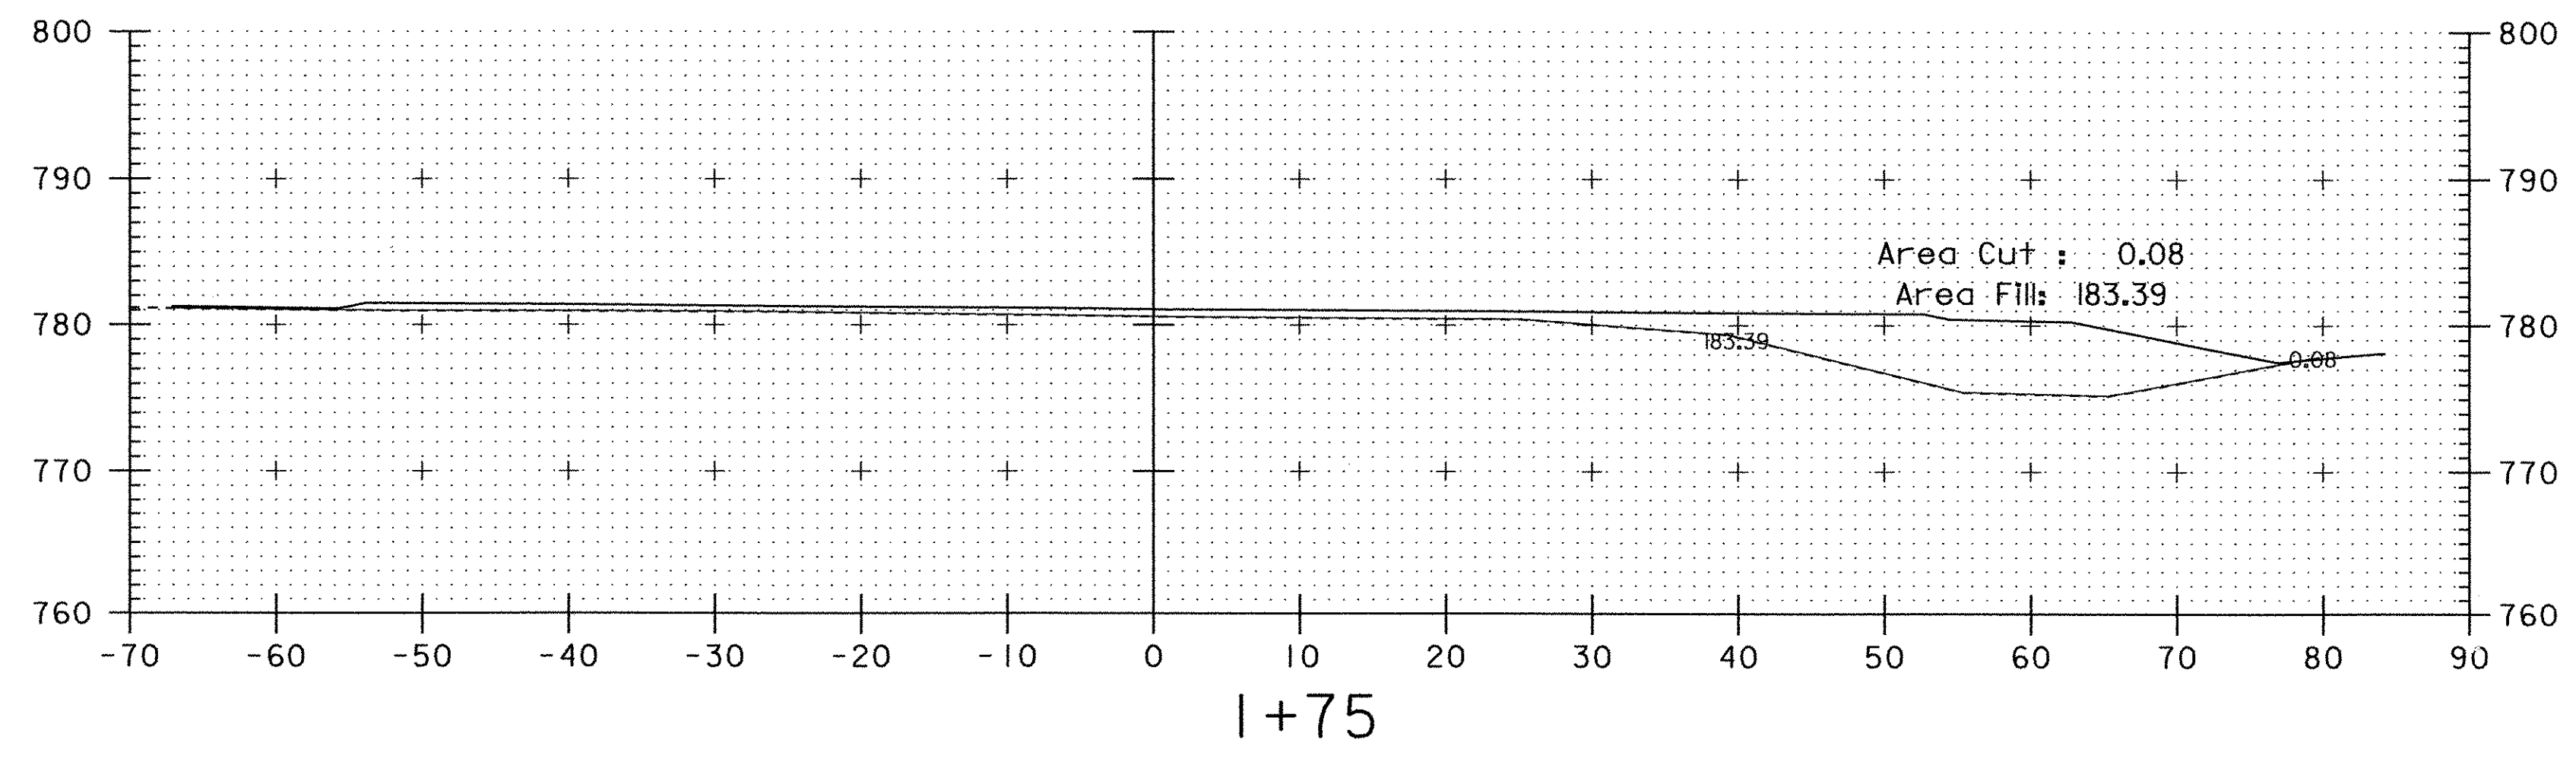


Volume Cut : 0.16
Volume Fill: 139.88

PROJECT NAME: Clarendon	PLOT DATE: 19-NOV-2003
PROJECT NUMBER: AIR 04-3154	DRAWN BY: R. Bullock
FILE NAME: 00h198/survey/work.dgn	CHECKED BY:
PROJECT LEADER:	SHEET 2 OF 2 053
DESIGNED BY:	
Circle Segment	

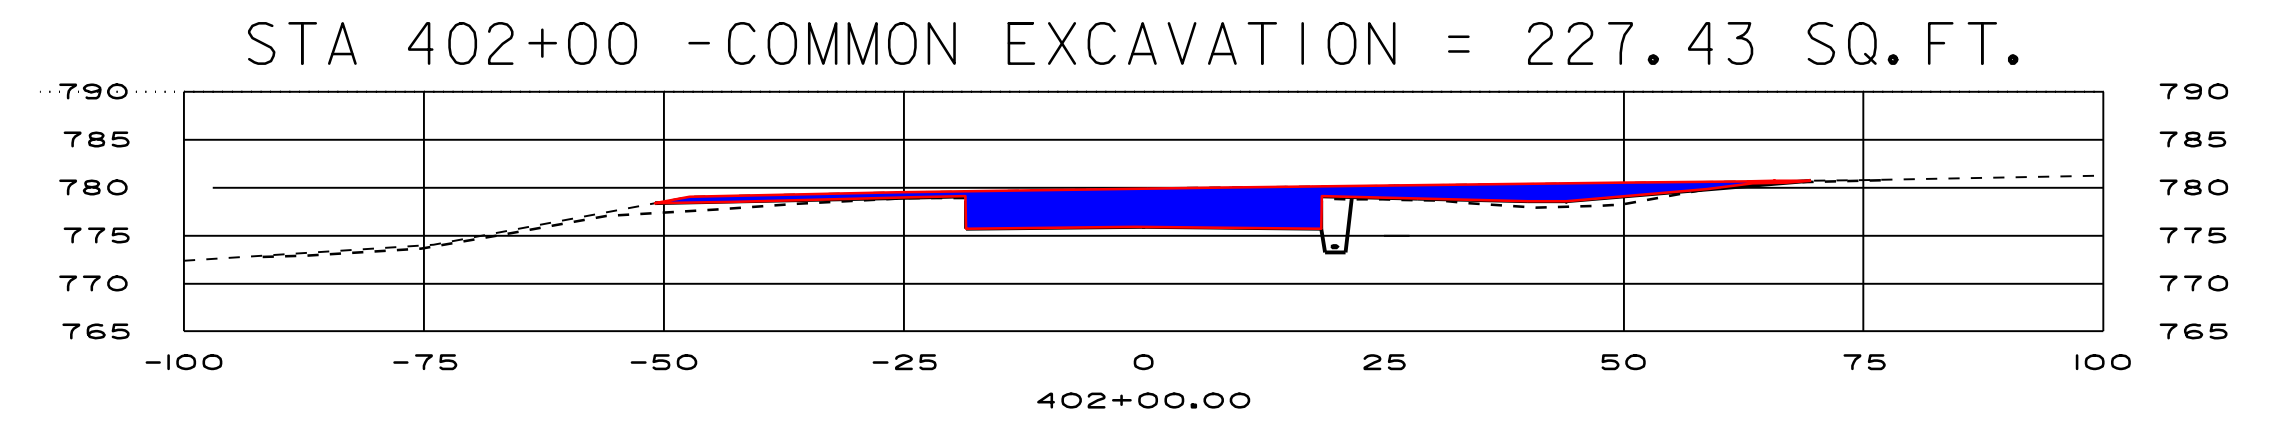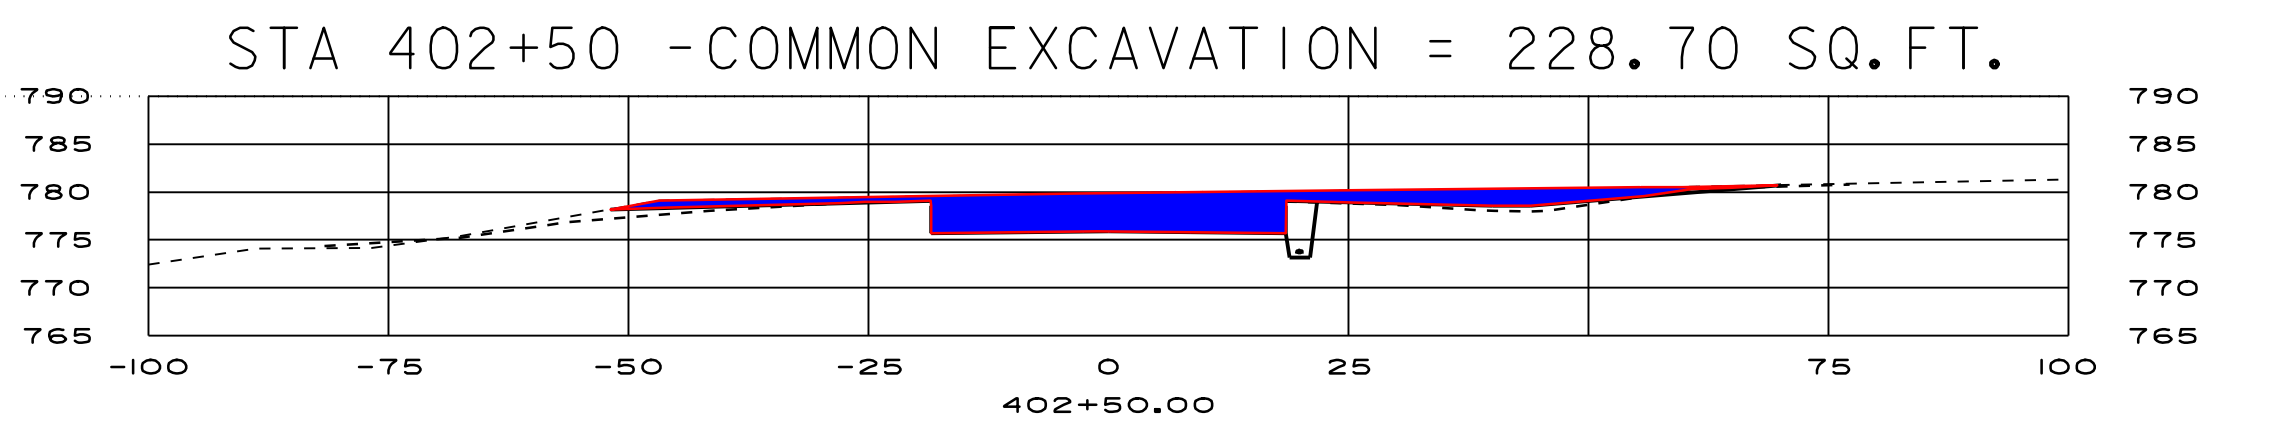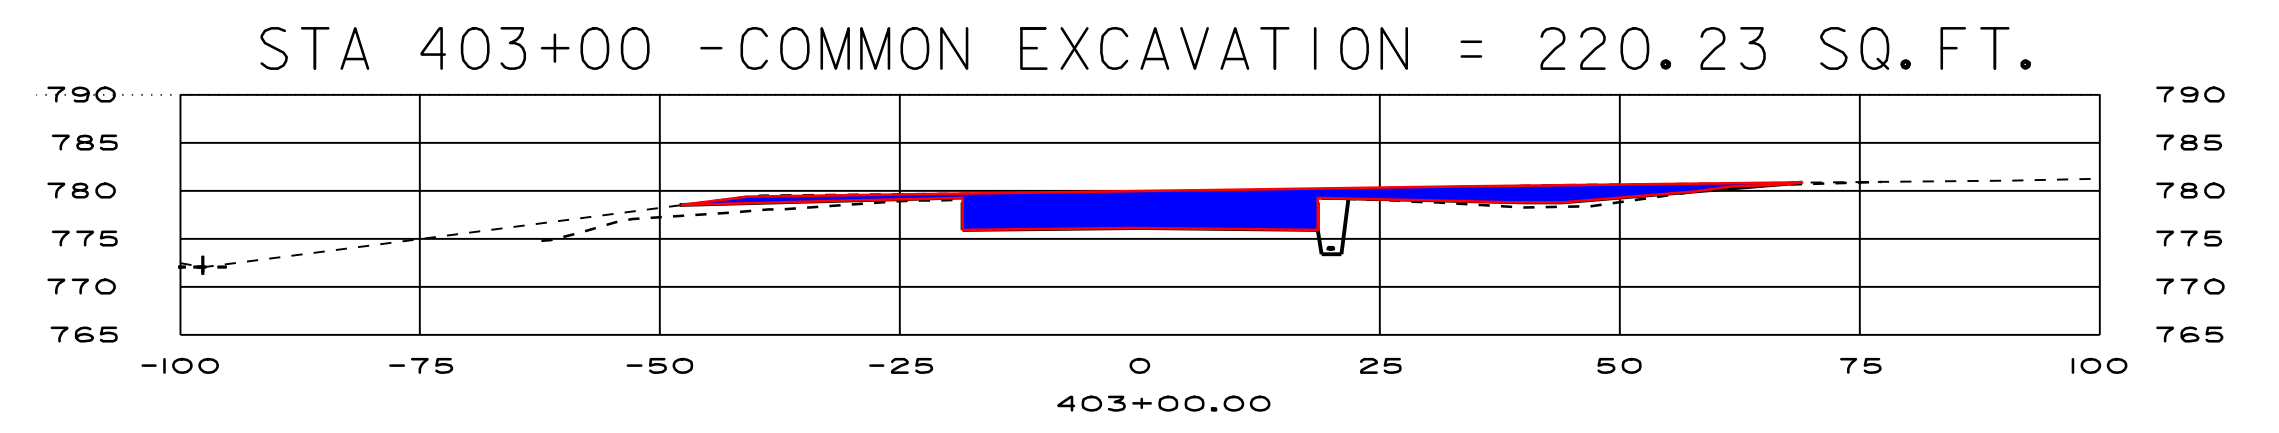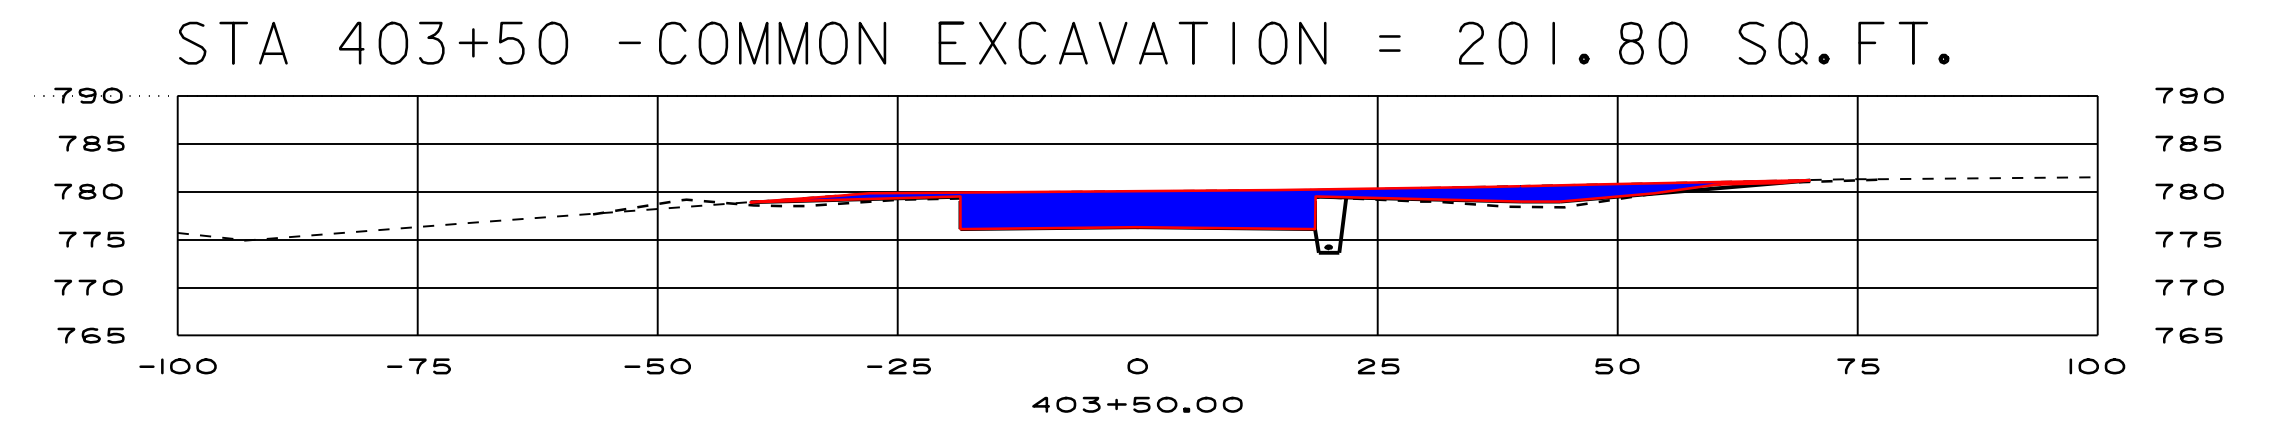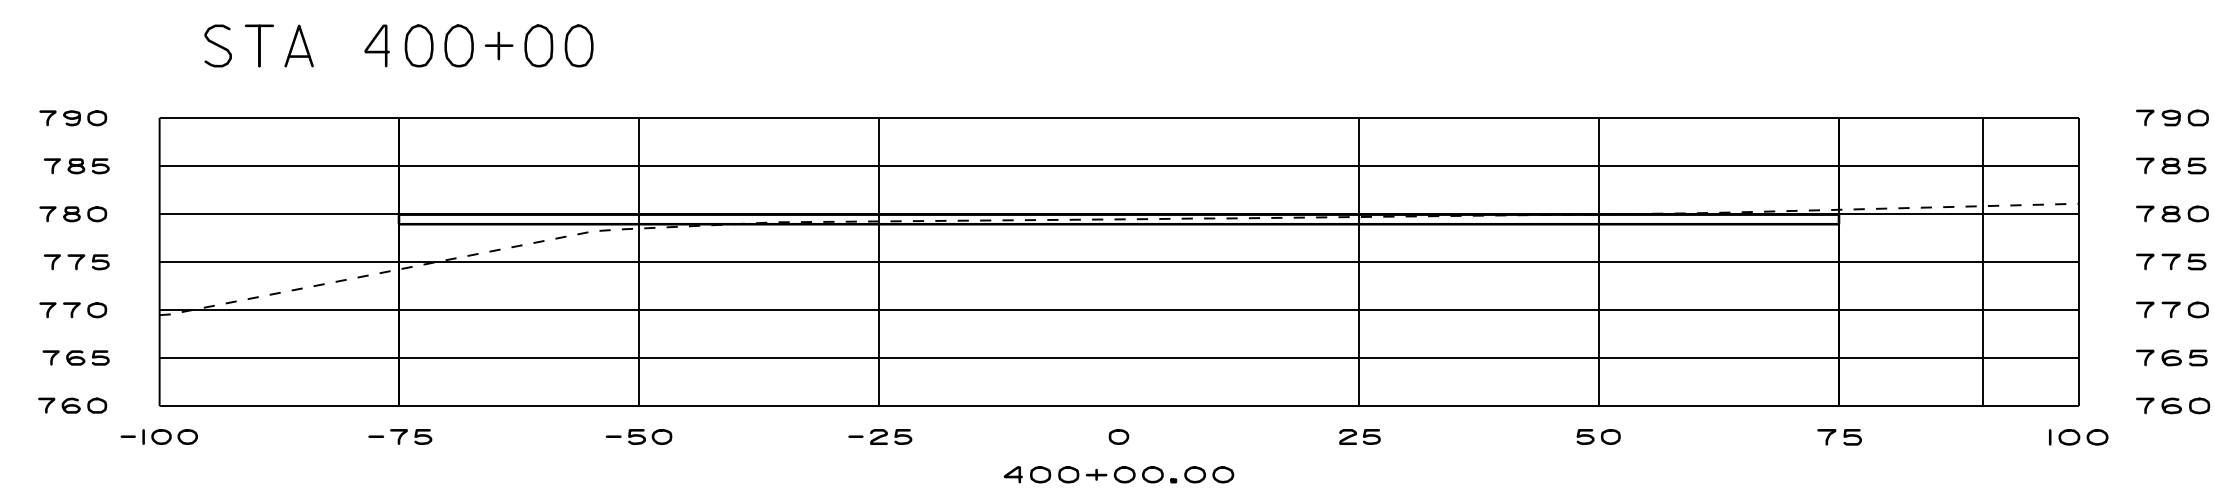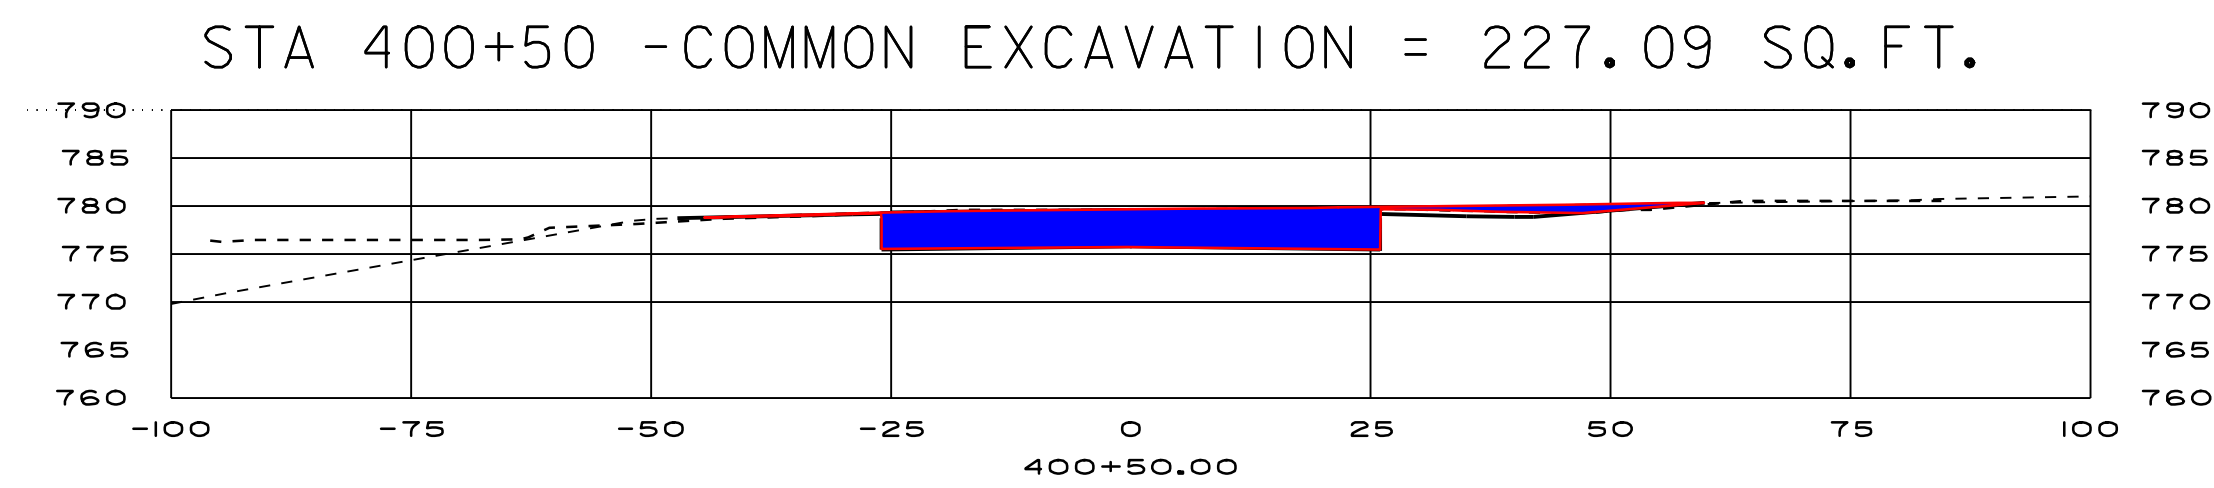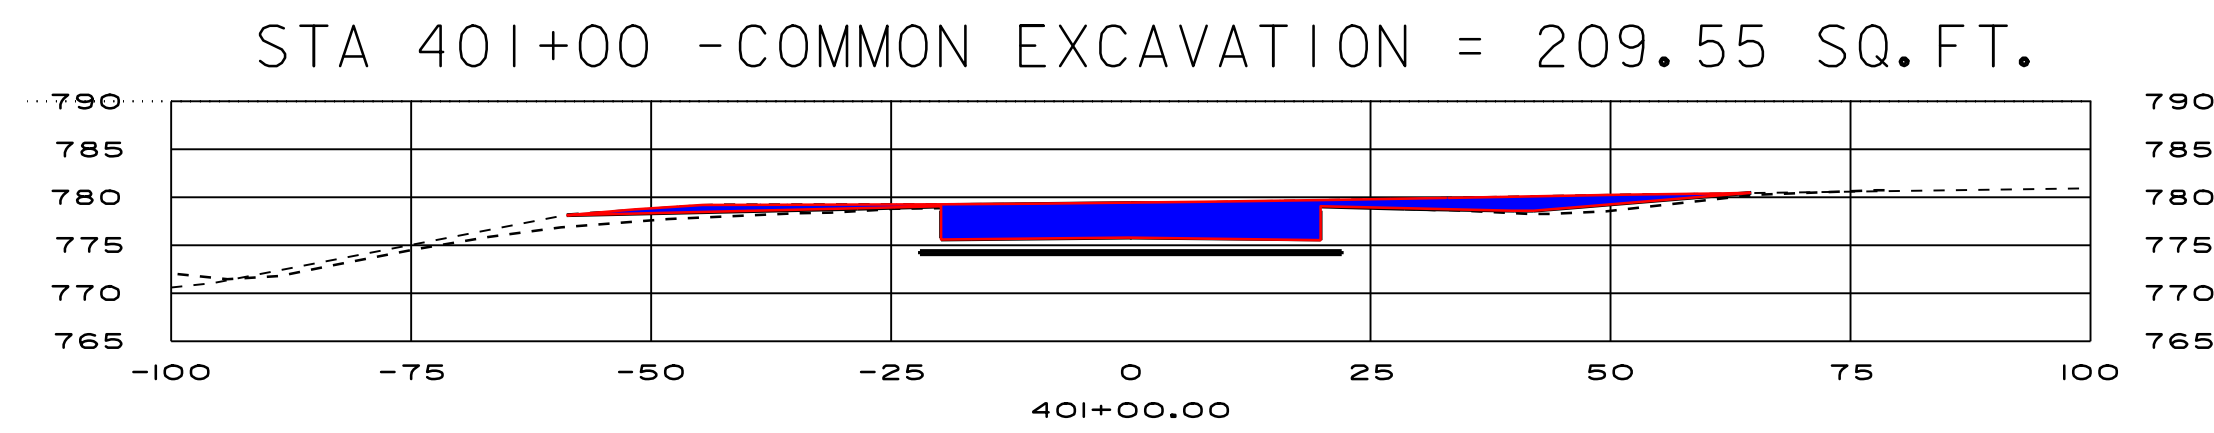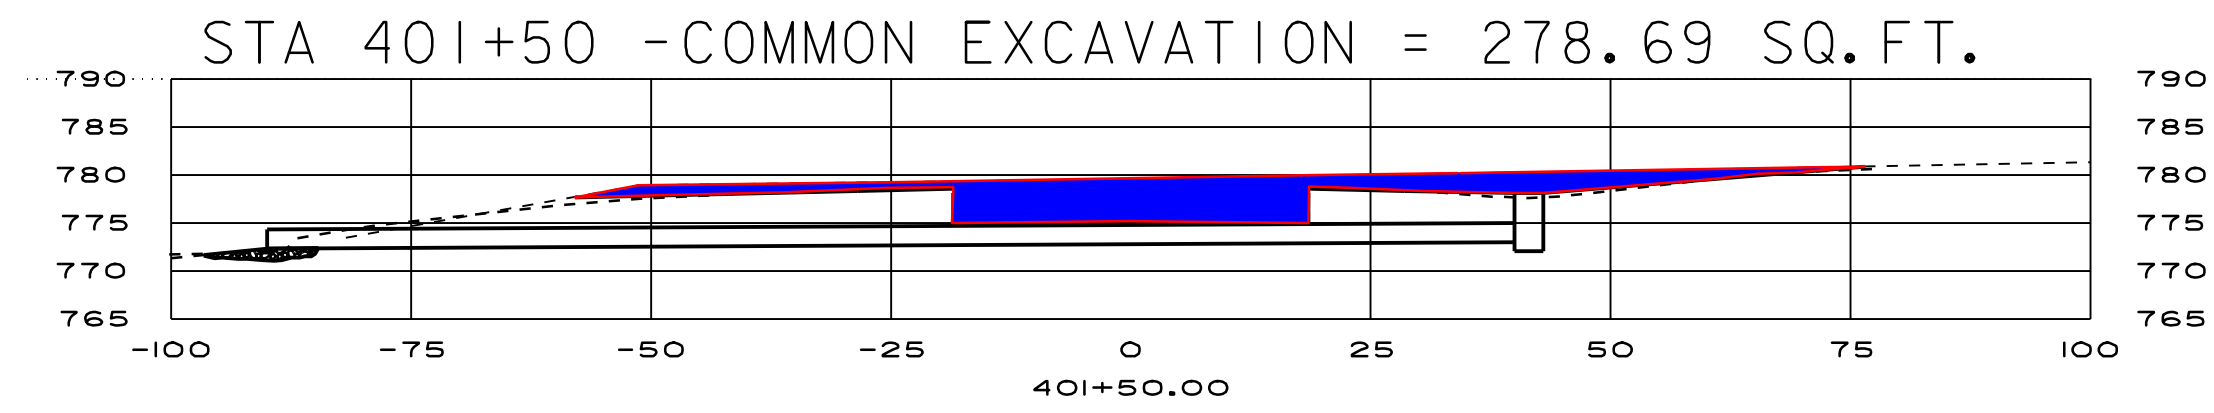


PROJECT:	CLARENDON	PROJECT NO. :	AIR 04-3154 C/I
DESIGN FILE NAME:			
IPARM FILE NAME:	S 01	PLOT DATE:	27-JUL-2005
COMMON EXCAVATION			


STA 406+00 -COMMON EXCAVATION = 237.48 SQ.FT.

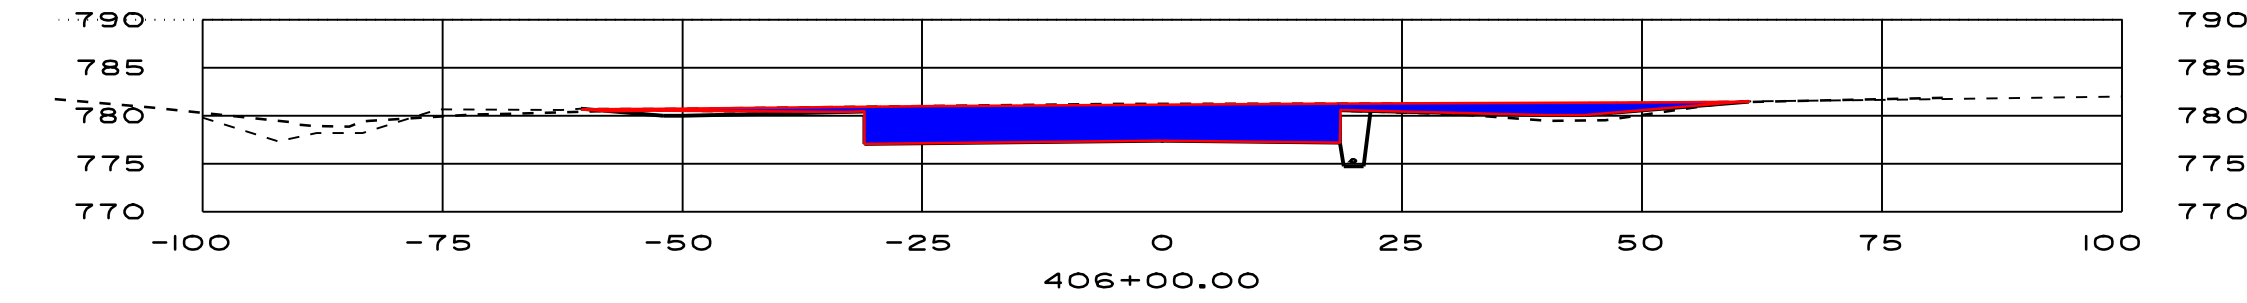


STA 408+50 -COMMON EXCAVATION = 220.16 SQ.FT.

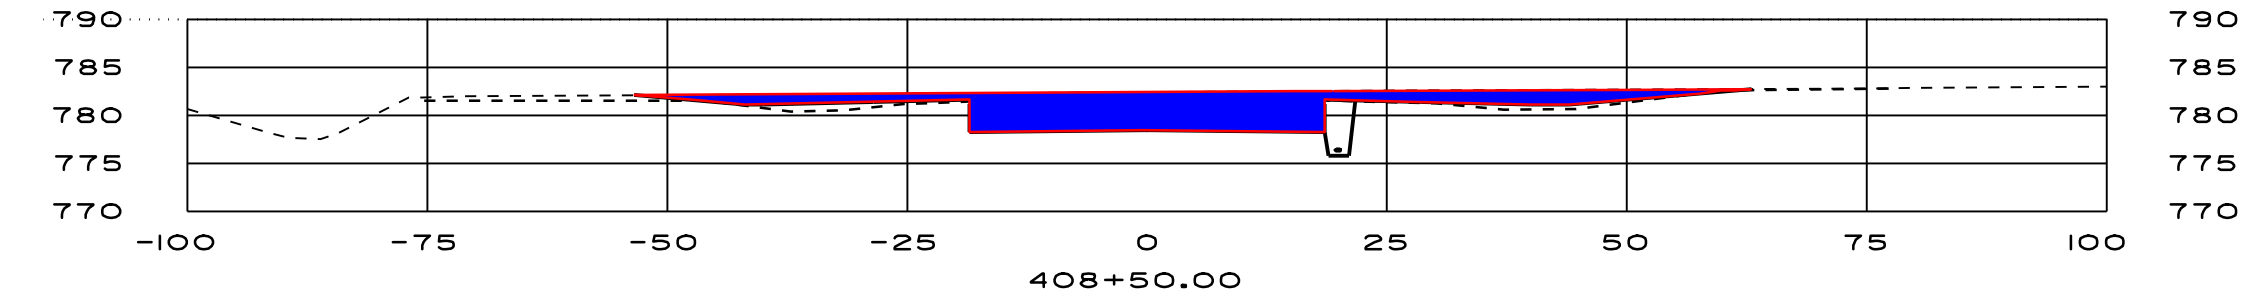


STA 405+50 -COMMON EXCAVATION = 397.79 SQ.FT.

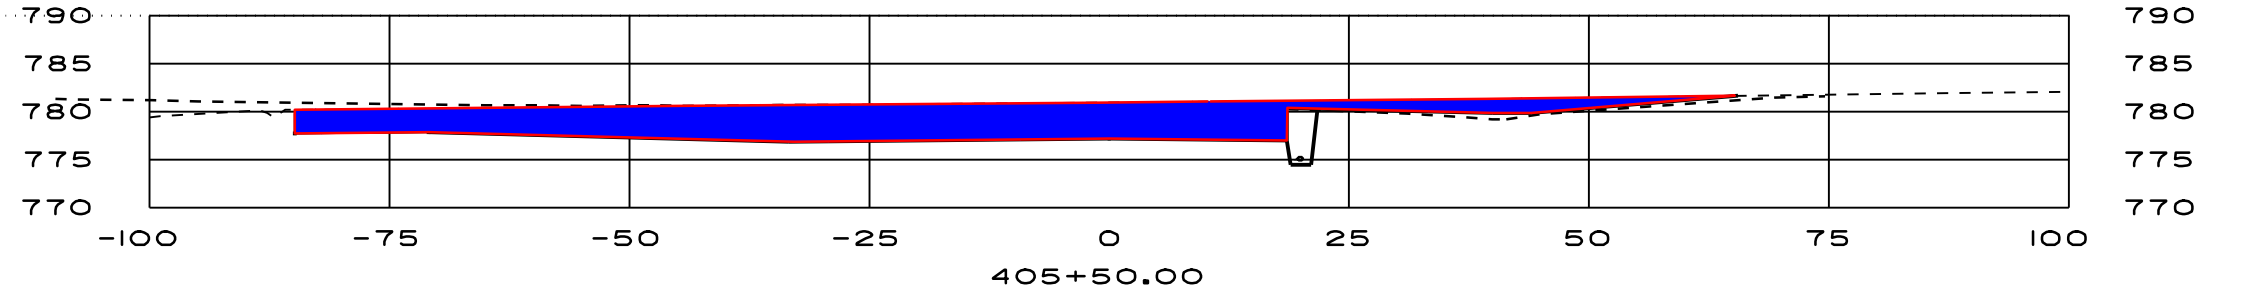


STA 408+00 -COMMON EXCAVATION = 212.41 SQ.FT.

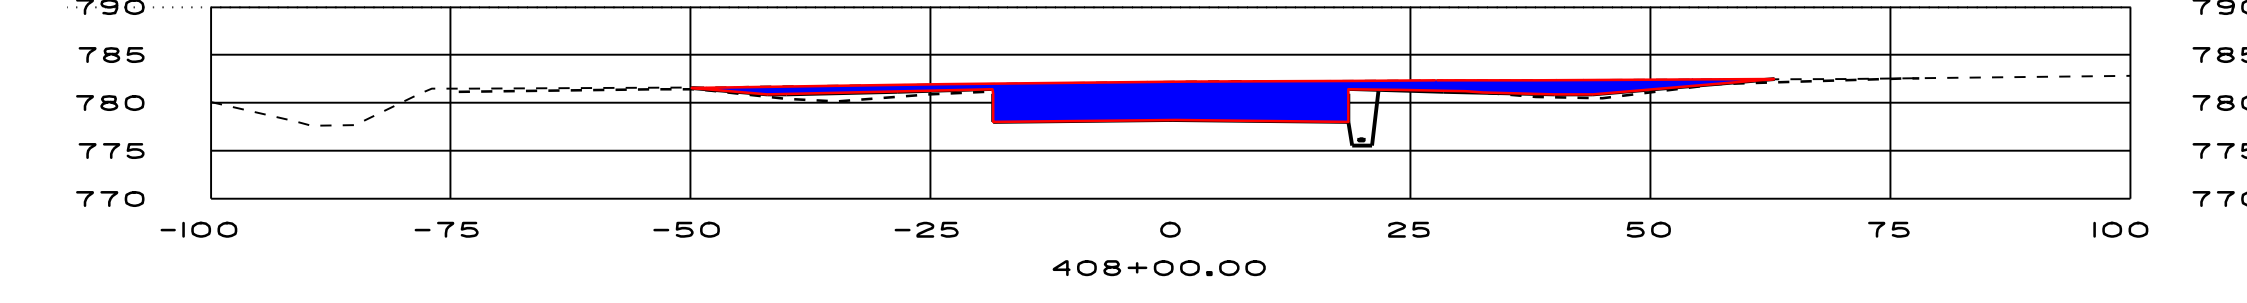


STA 405+00 -COMMON EXCAVATION = 226.77 SQ.FT.

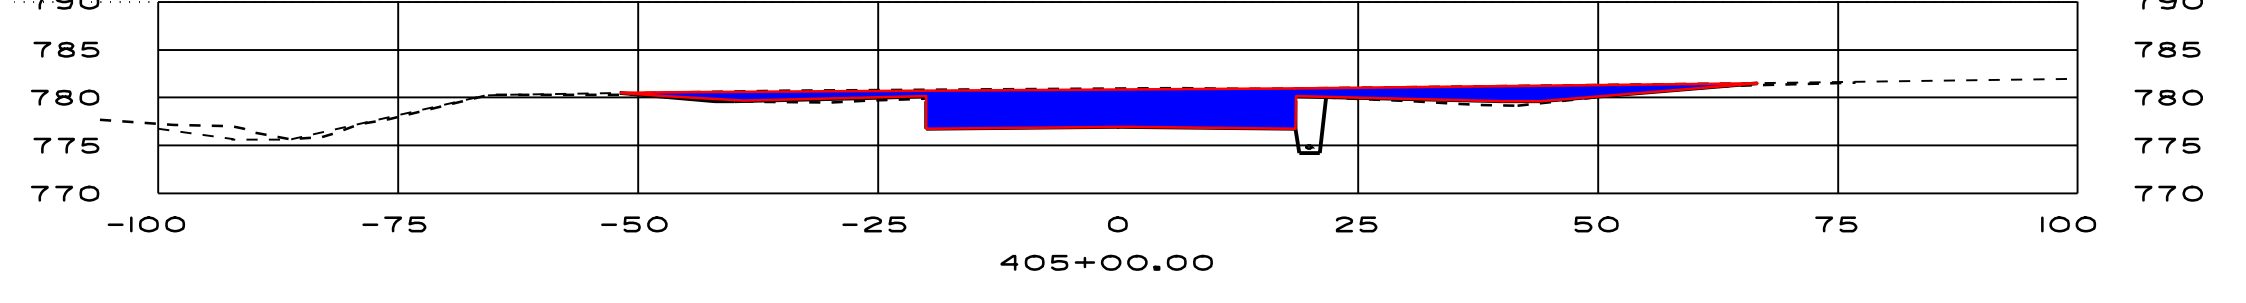


STA 407+50 -COMMON EXCAVATION = 196.69 SQ.FT.

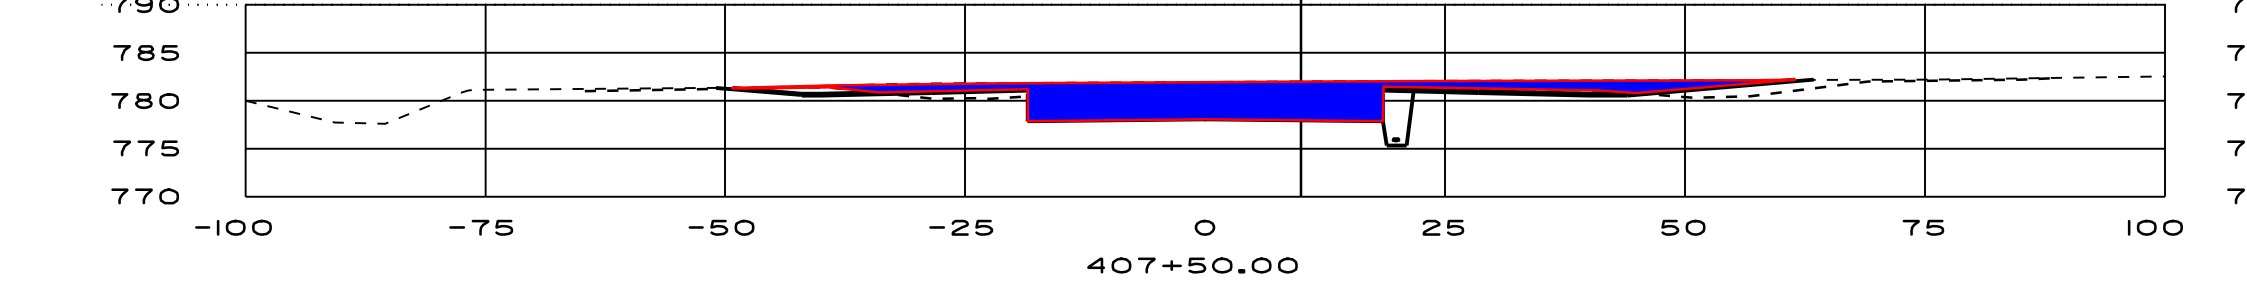


STA 404+50 -COMMON EXCAVATION = 221.93 SQ.FT.

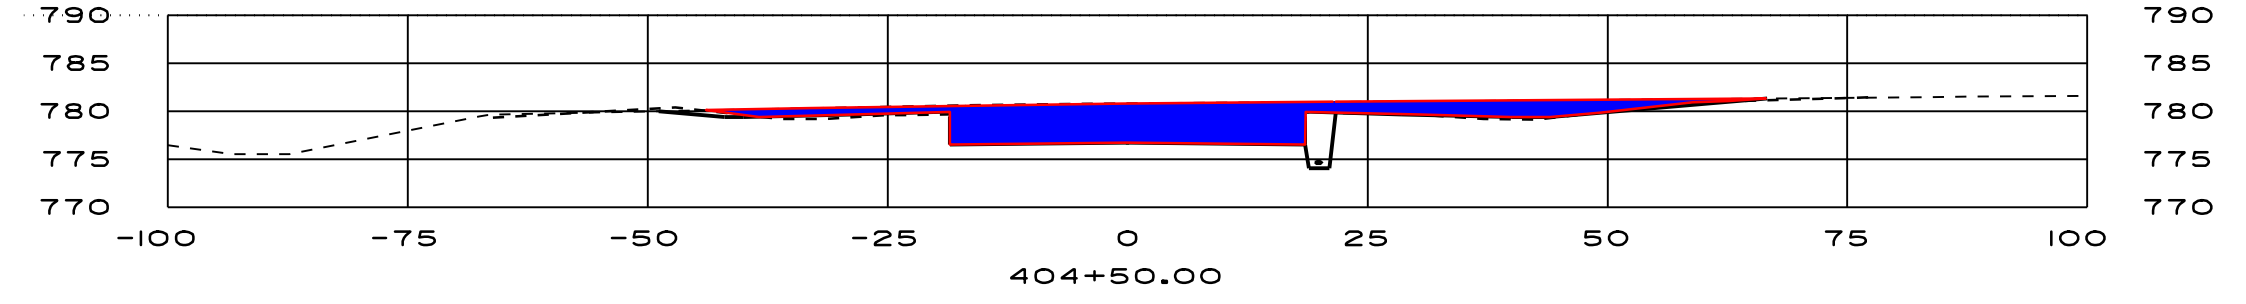


STA 407+00 -COMMON EXCAVATION = 212.44 SQ.FT.

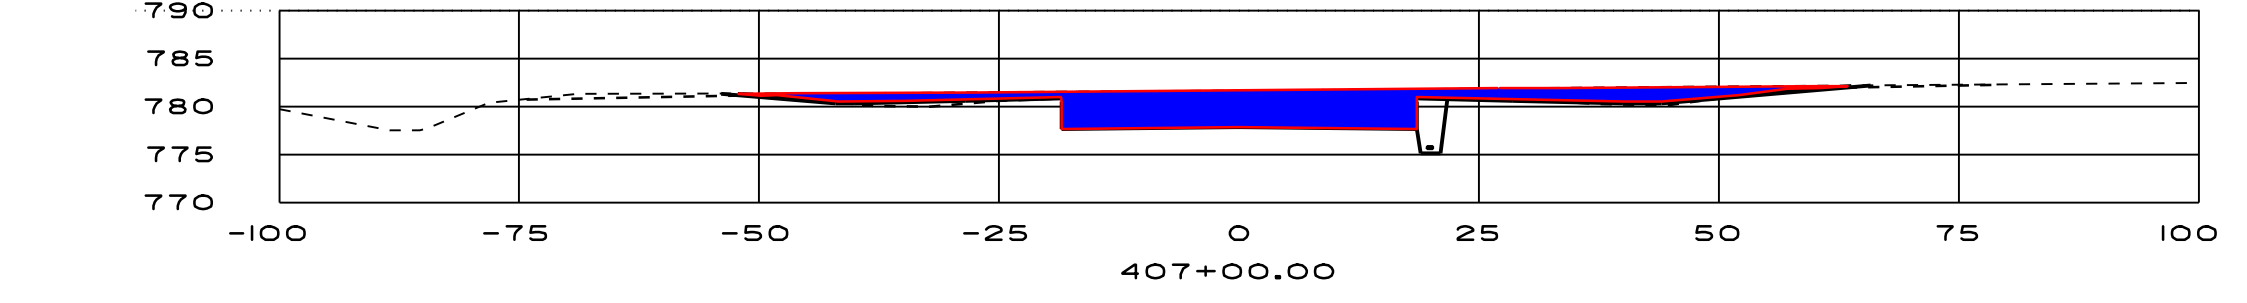

STA 404+00 -COMMON EXCAVATION = 181.44 SQ.FT.

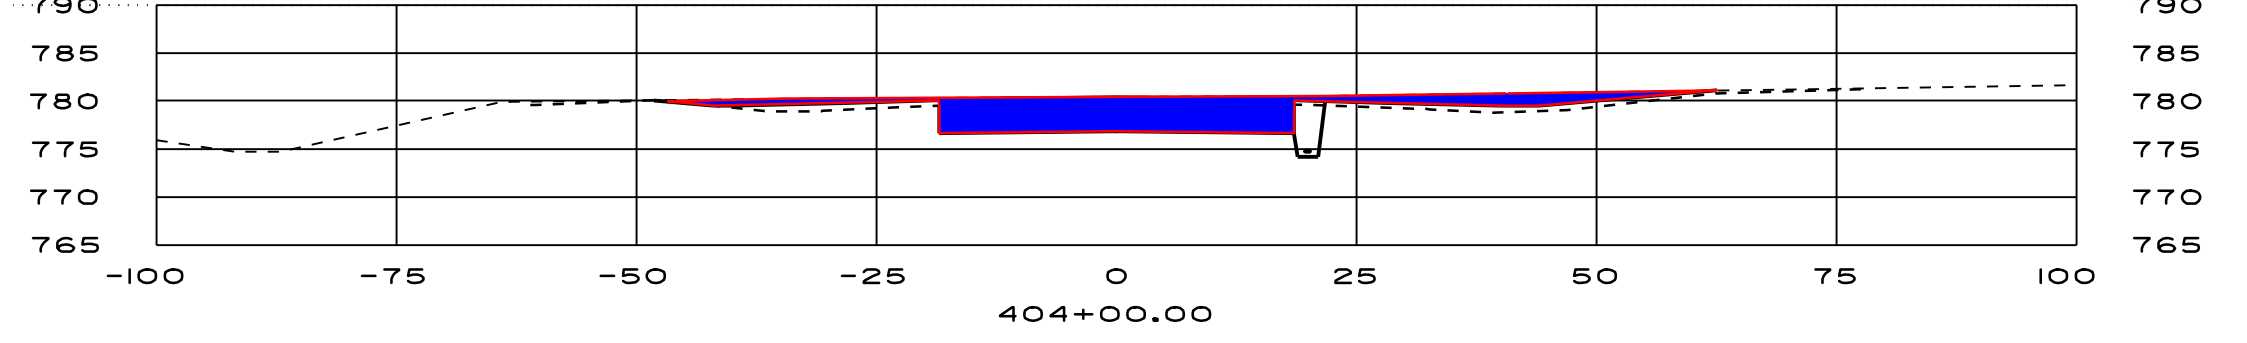

STA 406+50 -COMMON EXCAVATION = 217.46 SQ.FT.

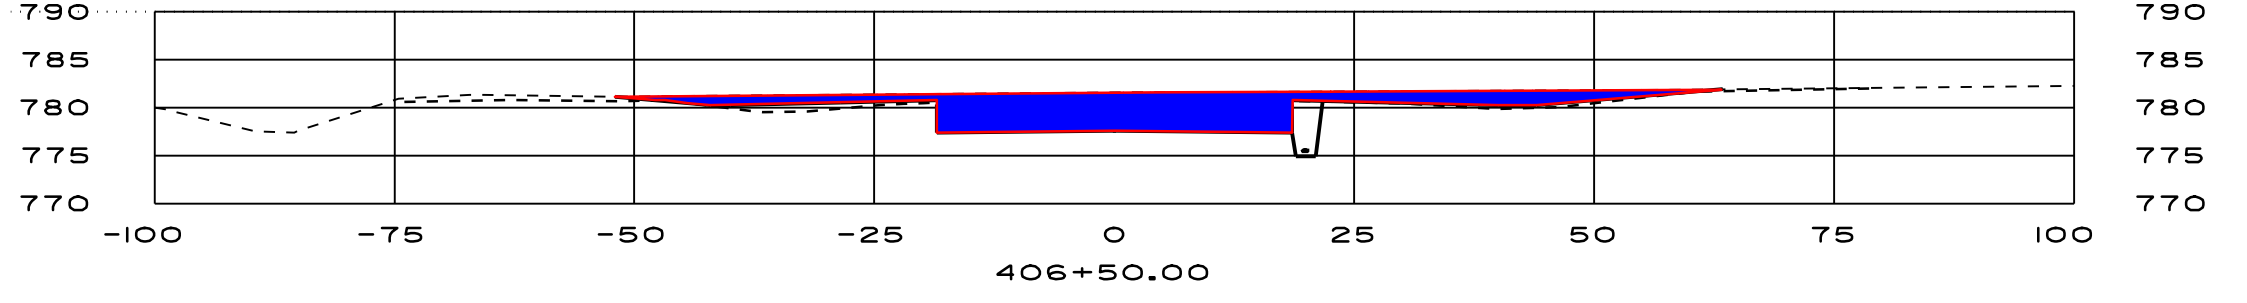











PROJECT: CLARENDON

PROJECT NO. : AIR 04-3154 C/I











DESIGN FILE NAME:
IPARM FILE NAME: S 02

PLOT DATE: 27-JUL-2005





COMMON EXCAVATION

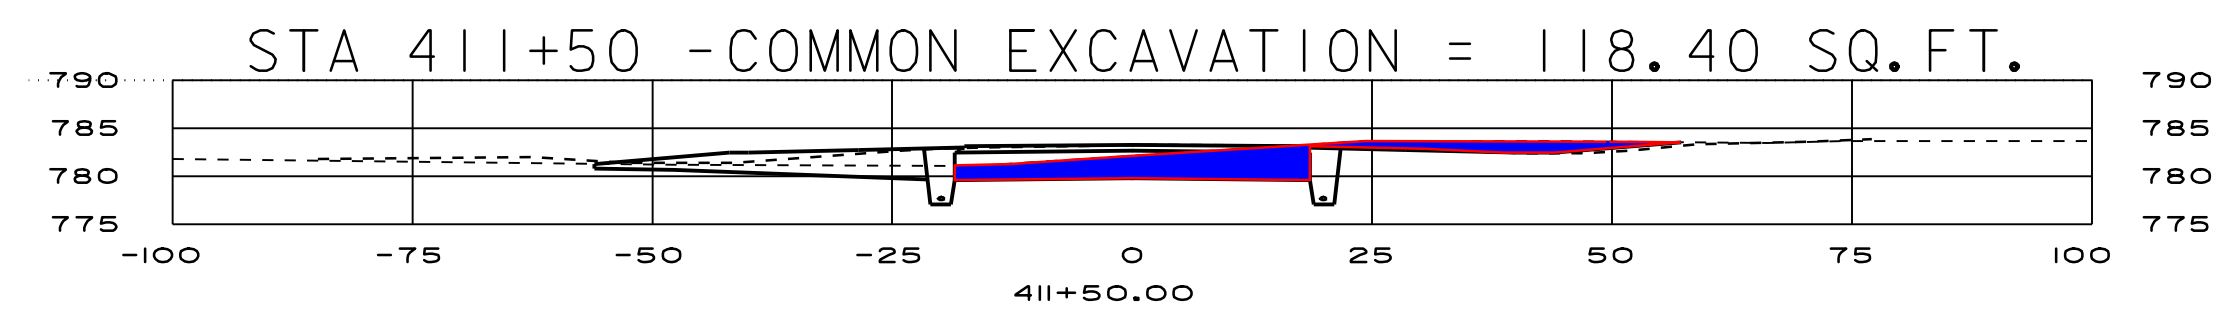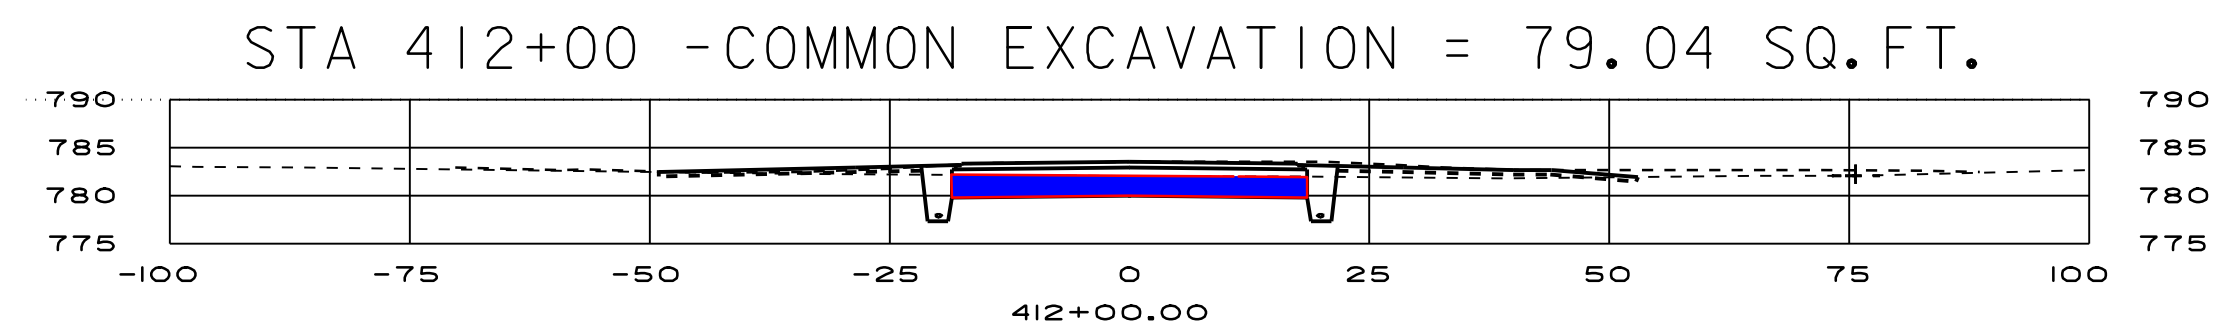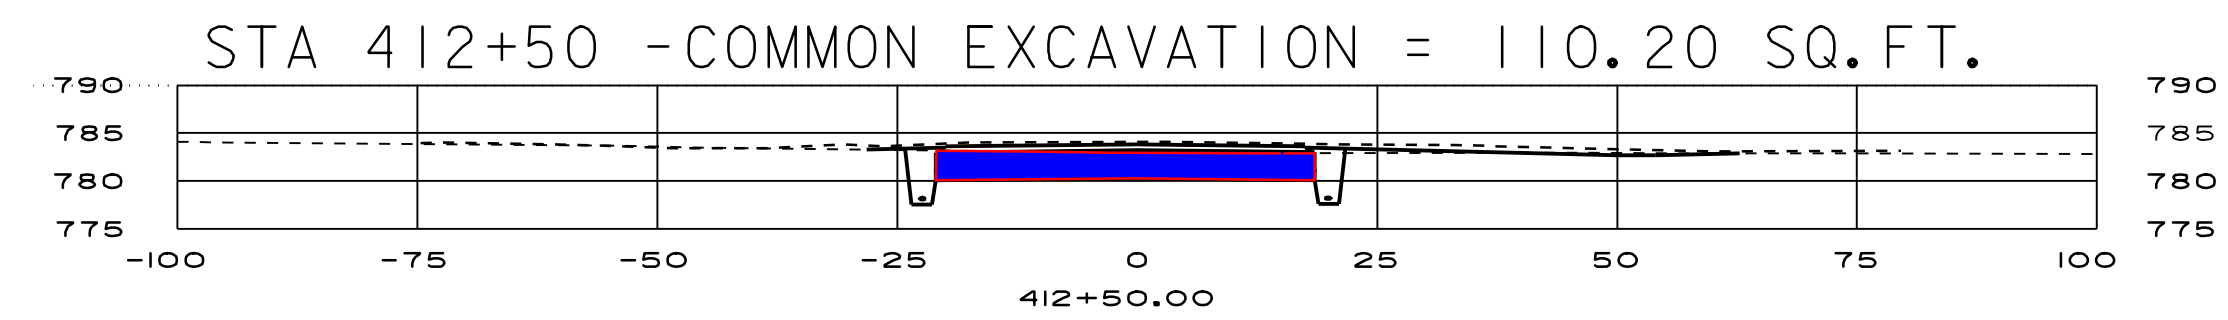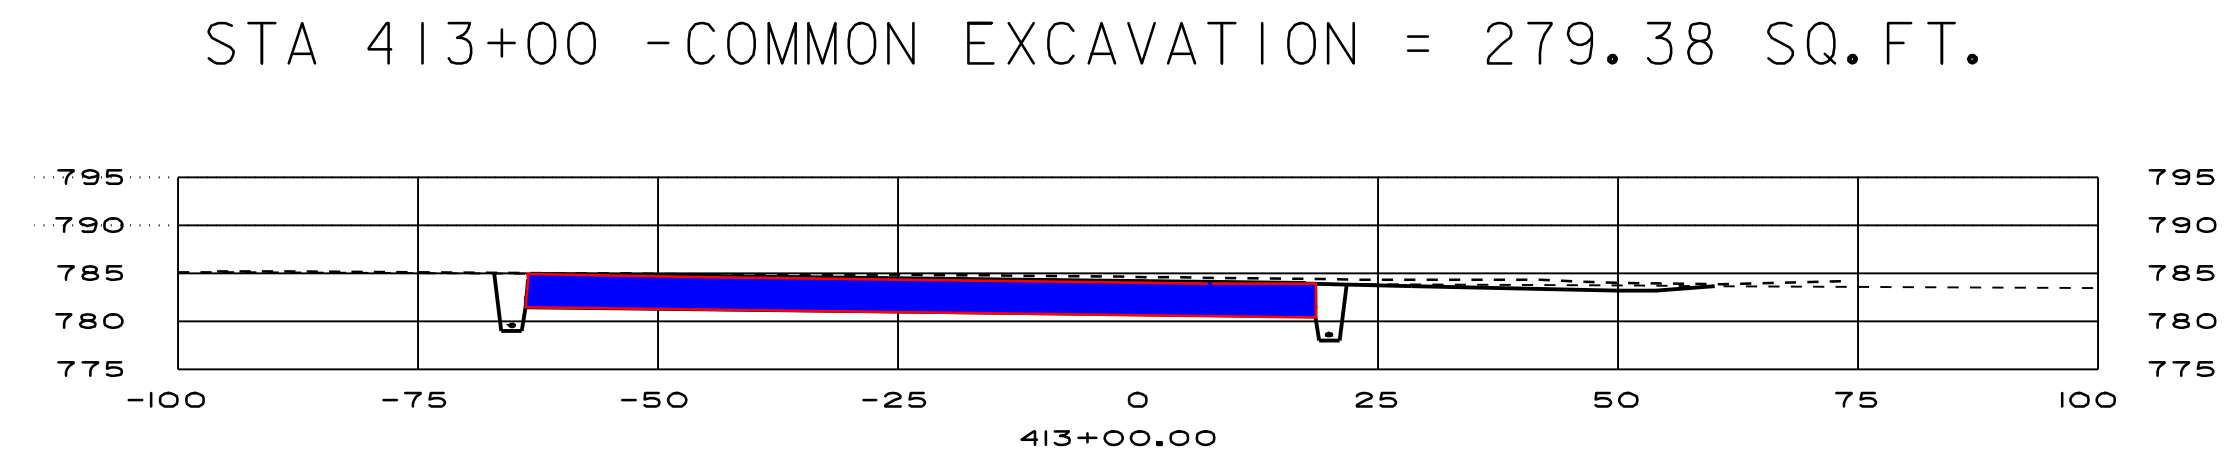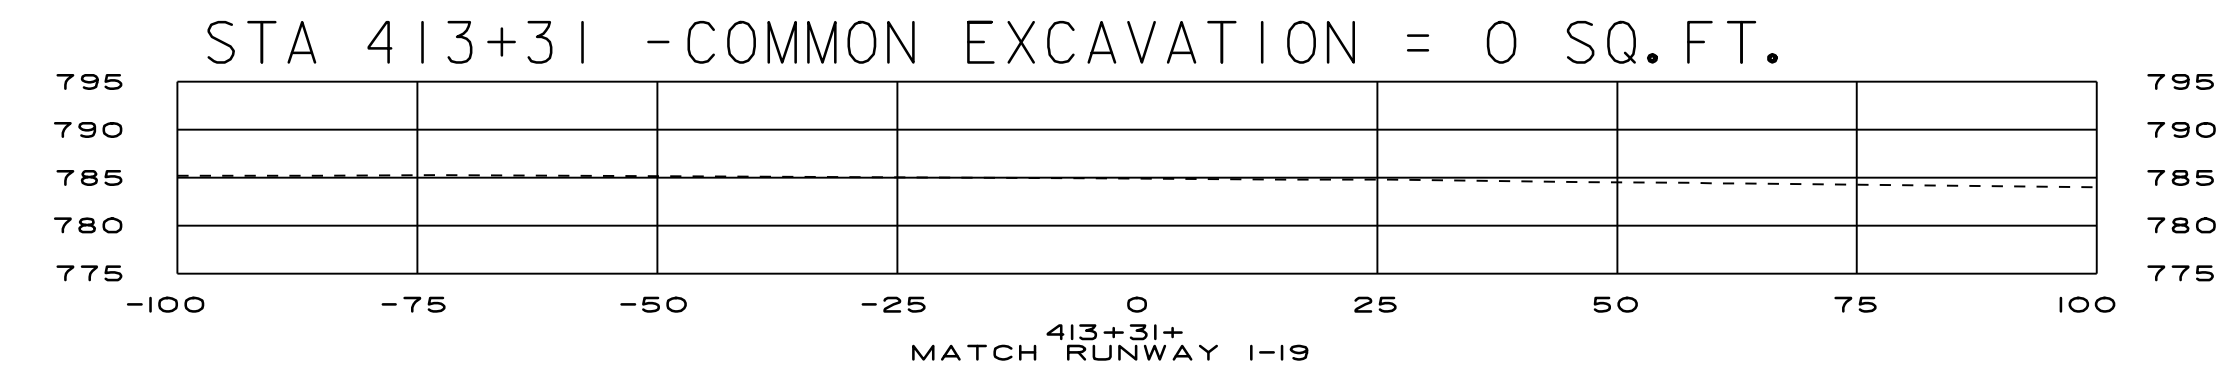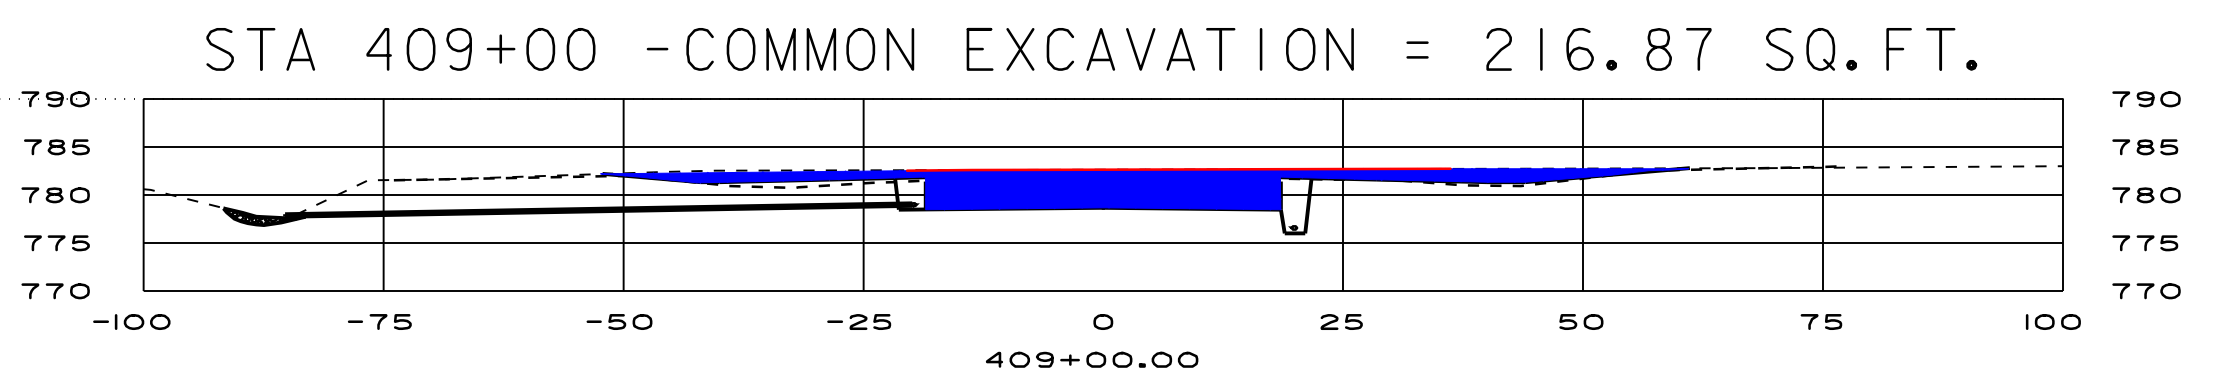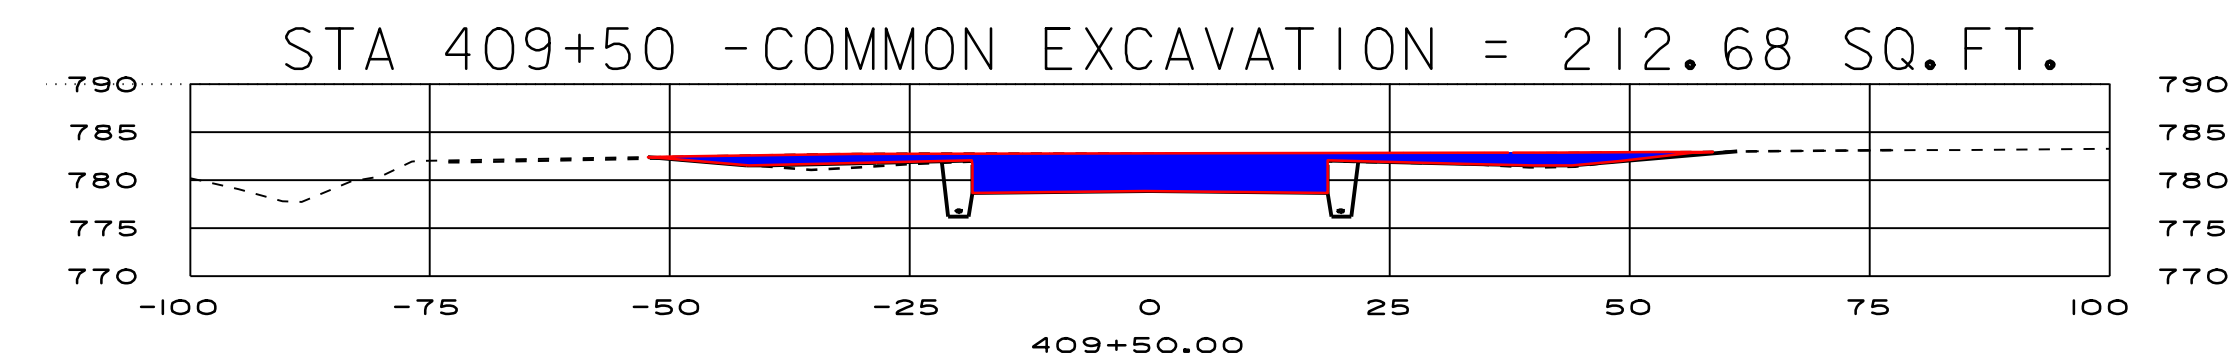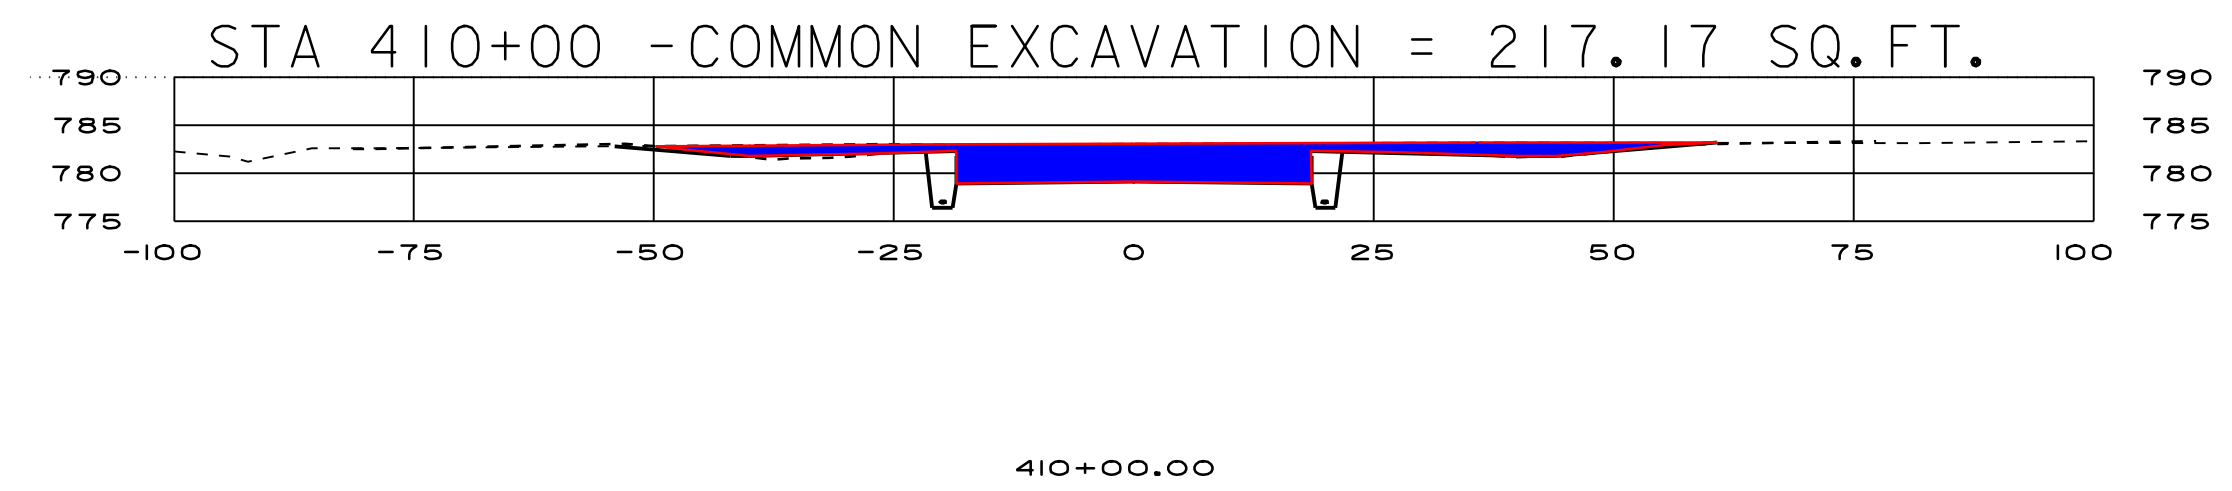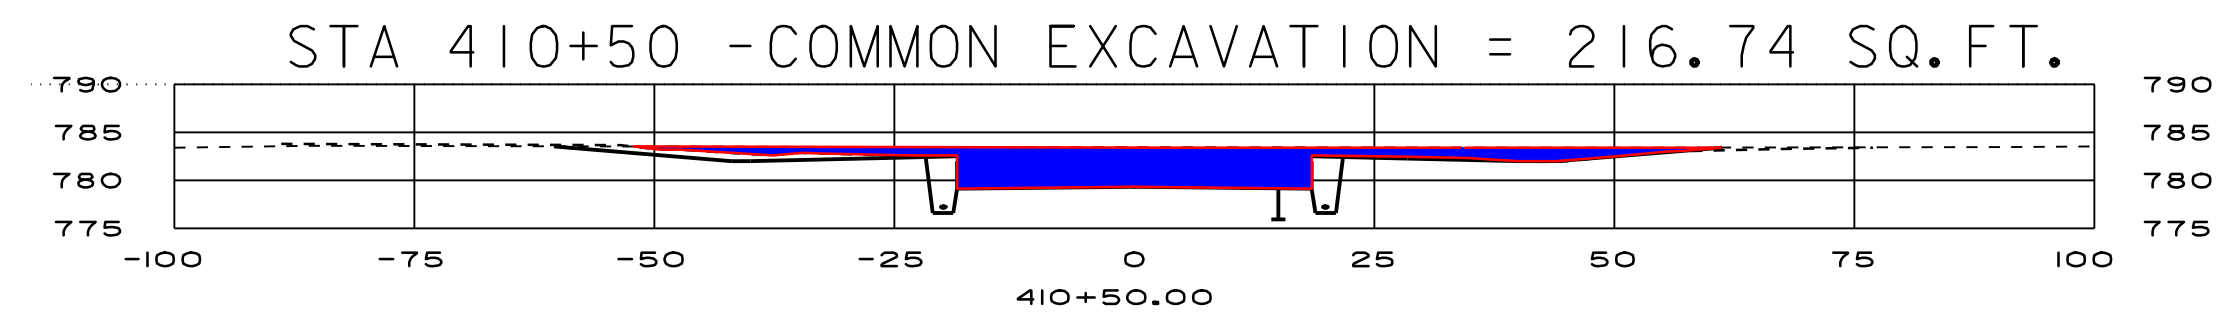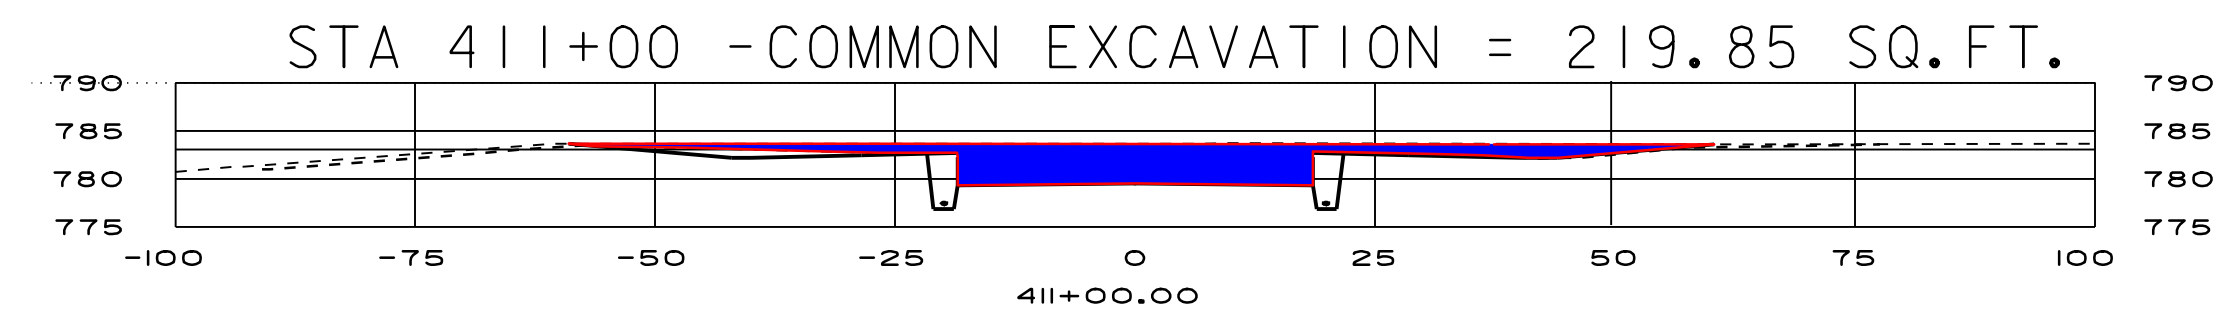

PROJECT:	CLARENDON	PROJECT NO. :	AIR 04-3154 C/I
DESIGN FILE NAME:			
IPARM FILE NAME:	S 03	PLOT DATE:	27-JUL-2005
COMMON EXCAVATION			

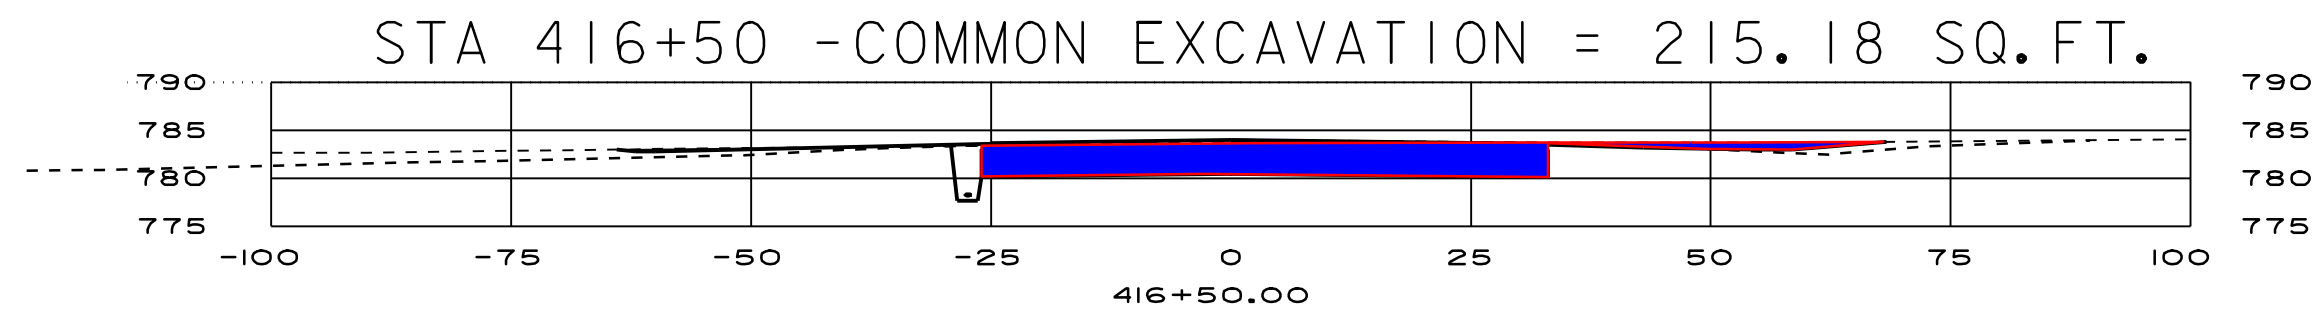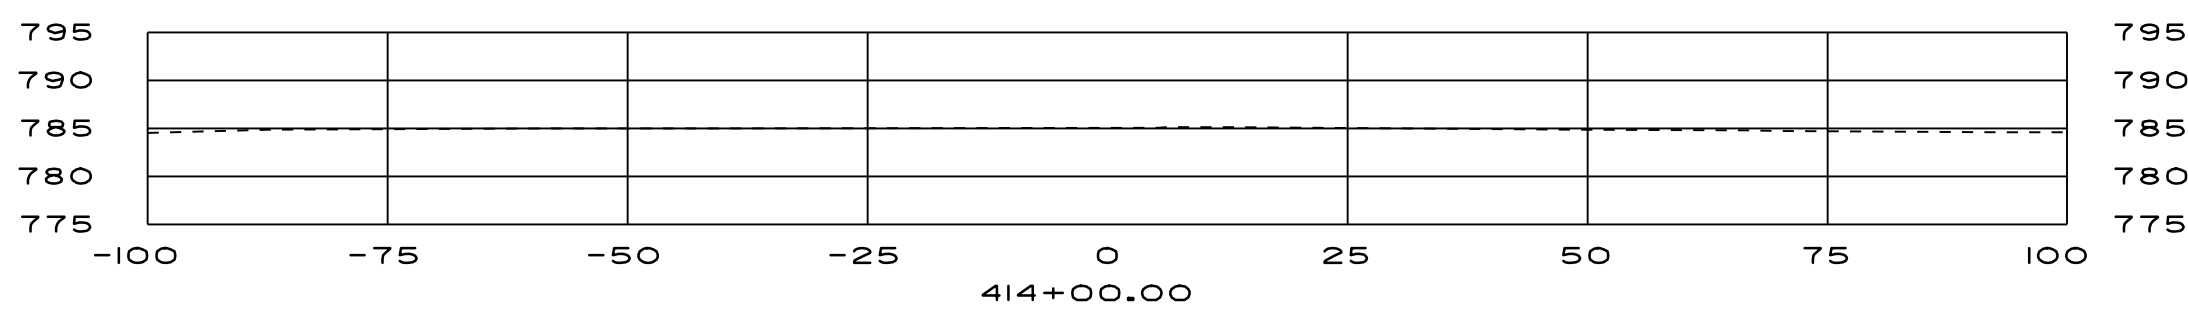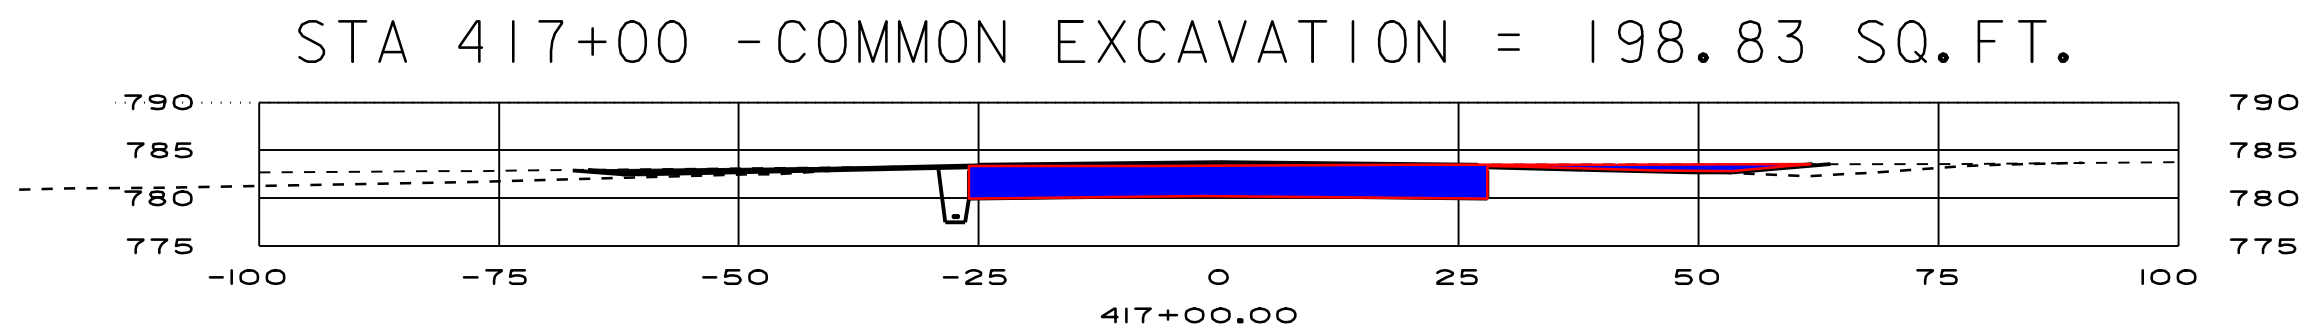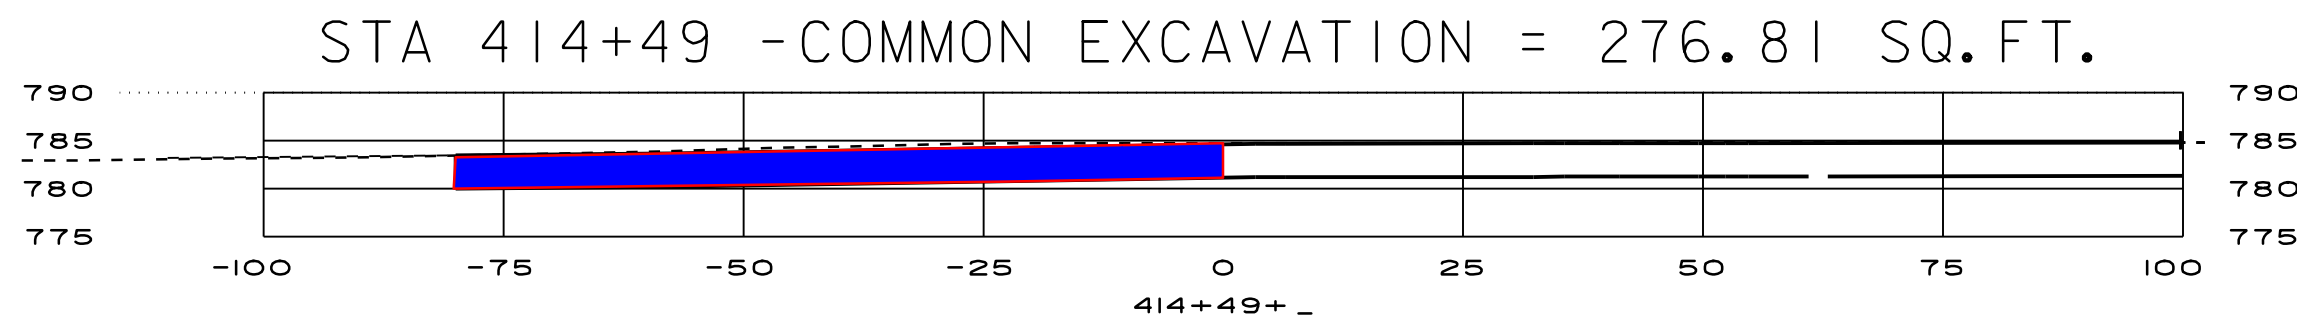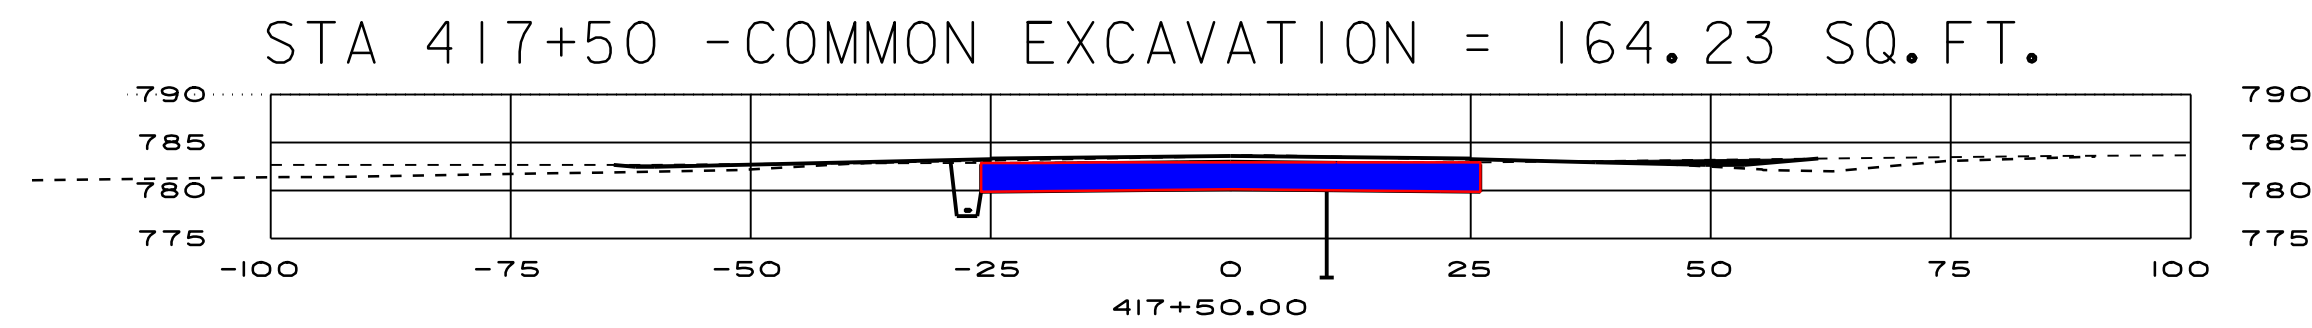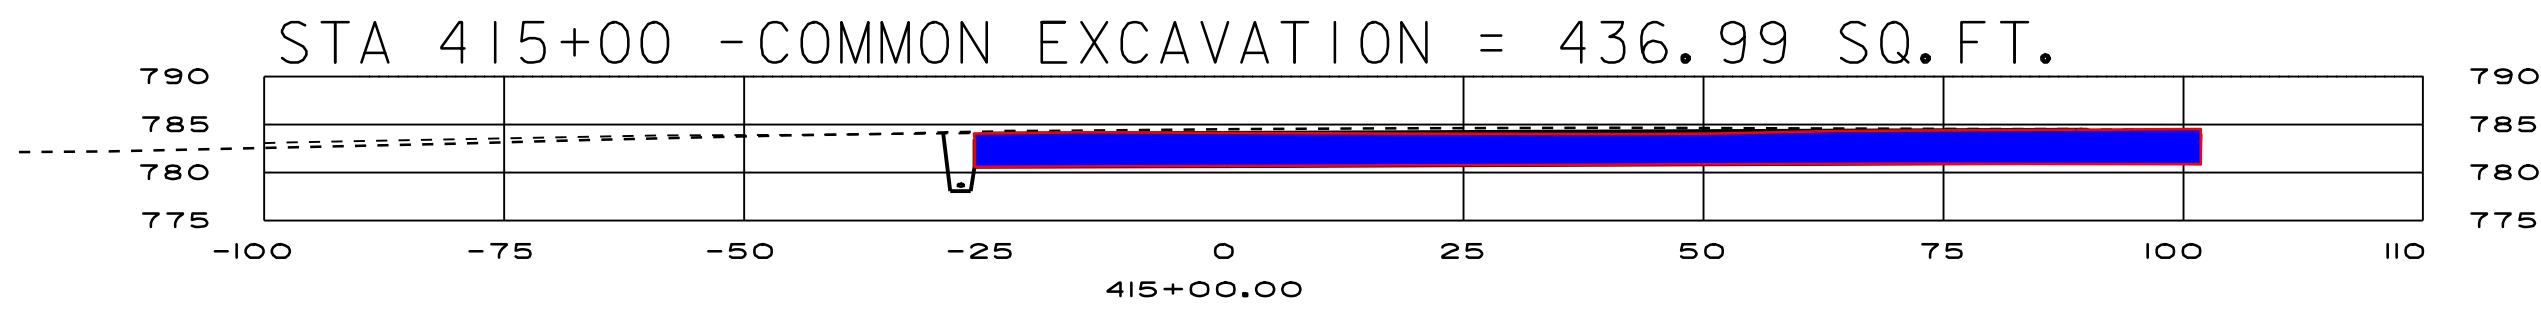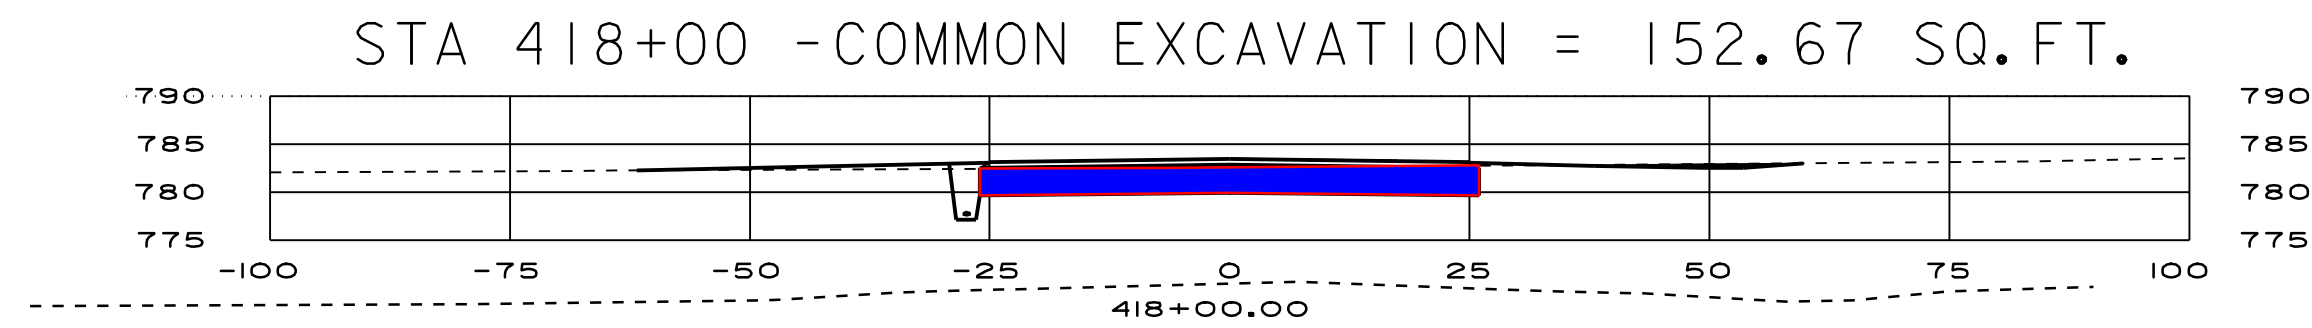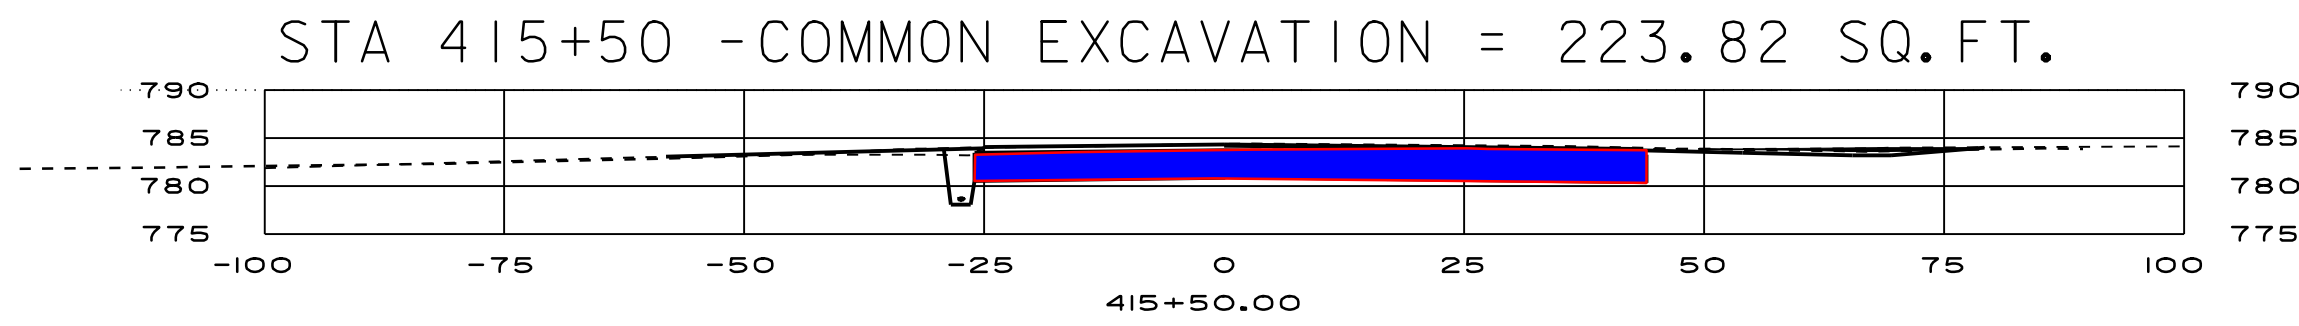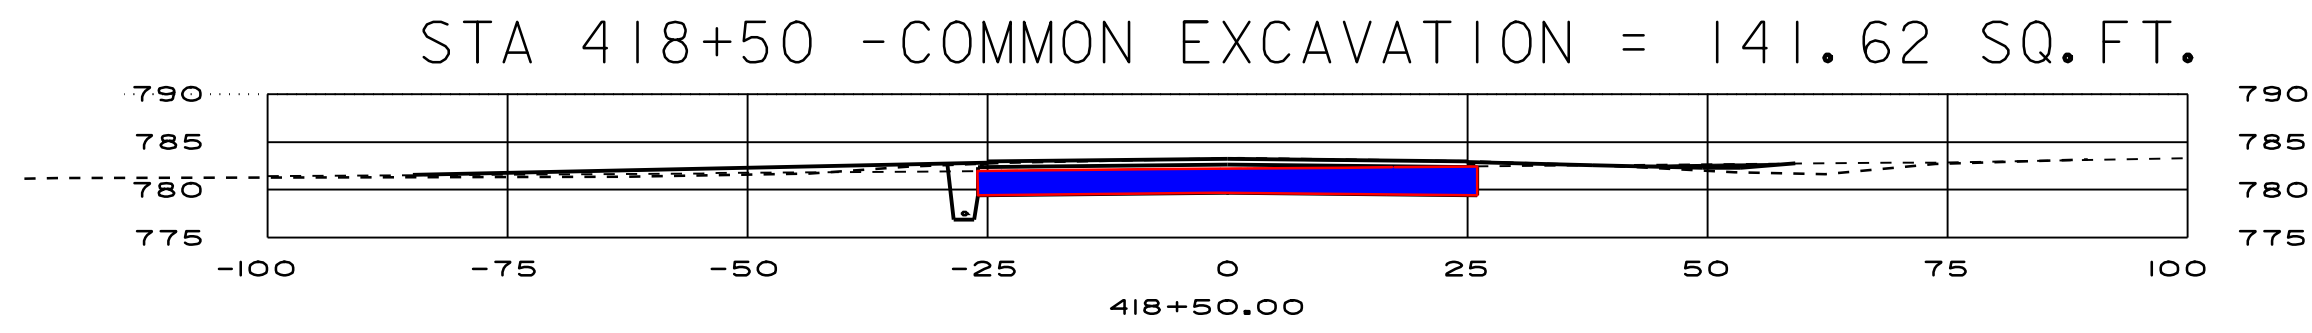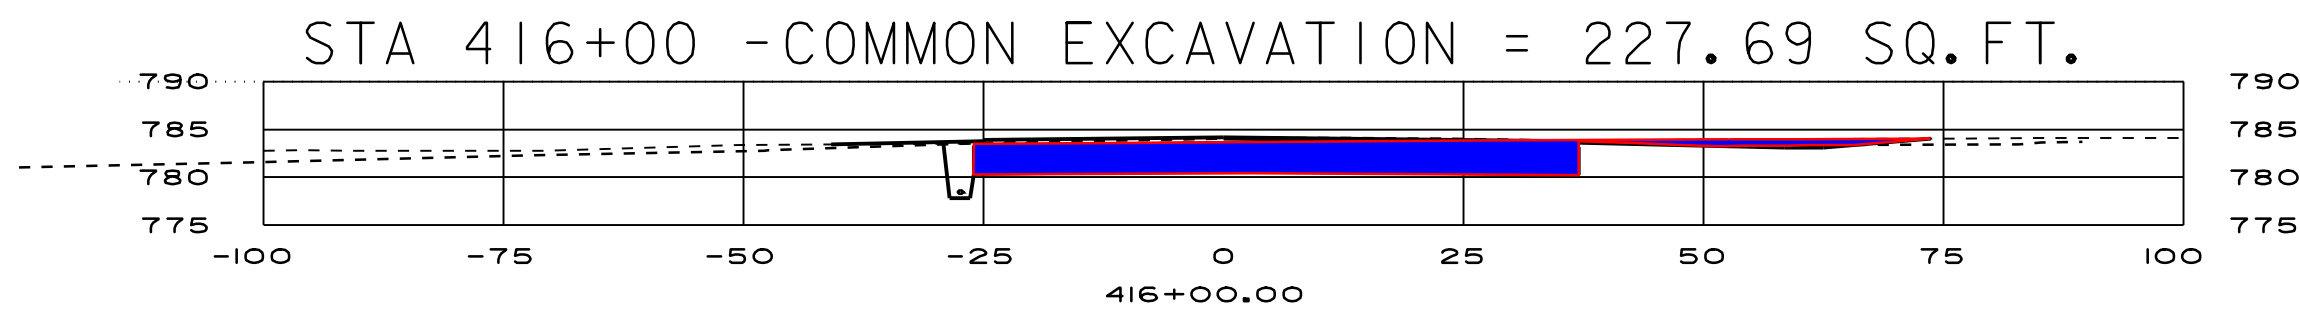

PROJECT:	CLARENDON	PROJECT NO. :	AIR 04-3154 C/I
DESIGN FILE NAME:			
IPARM FILE NAME:	S 04	PLOT DATE:	27-JUL-2005
COMMON EXCAVATION			

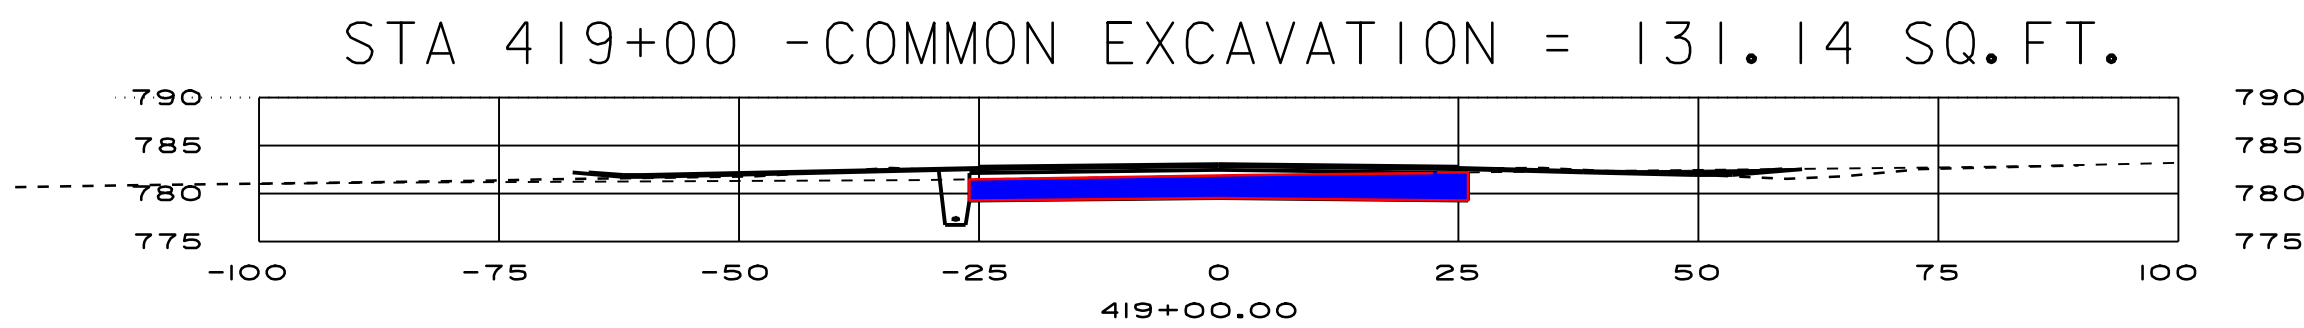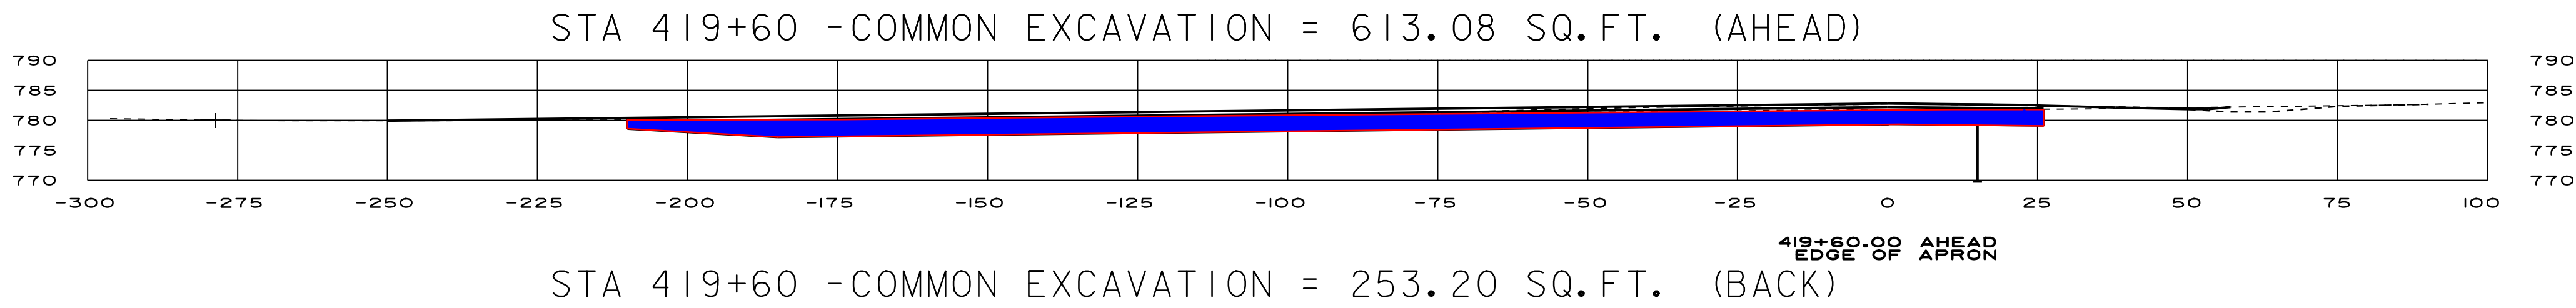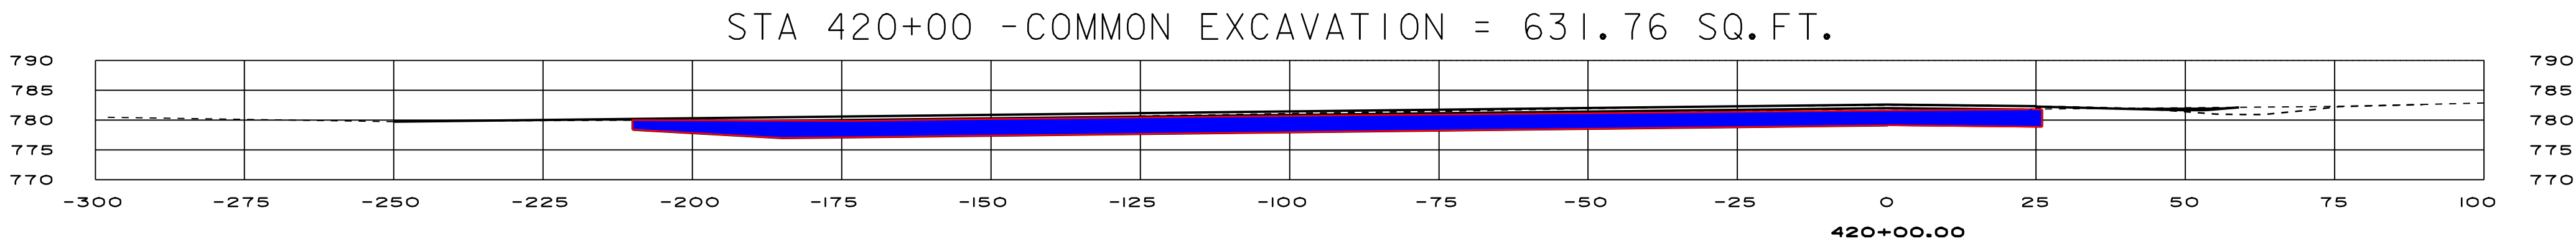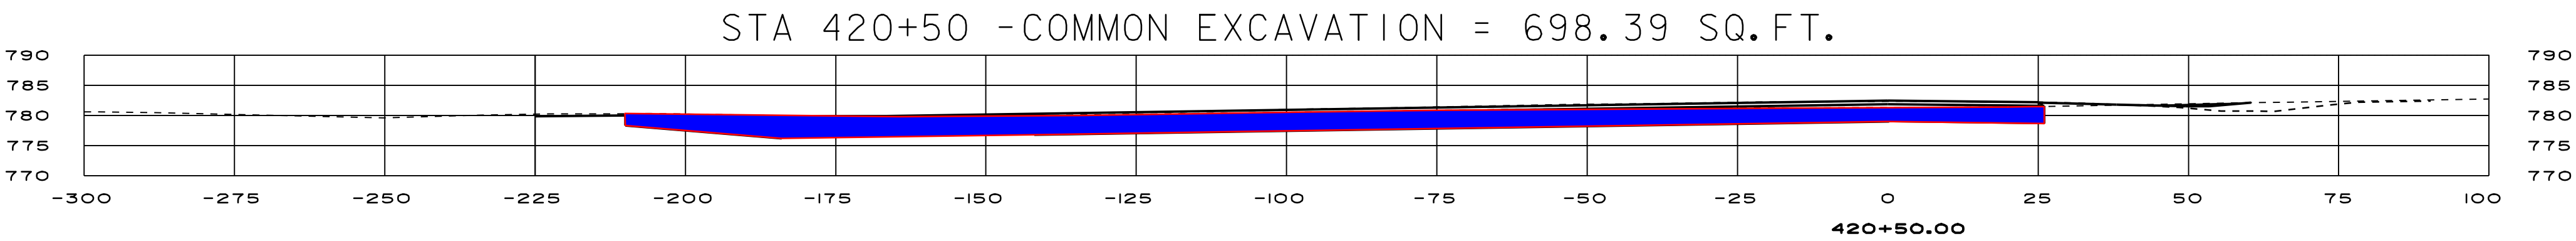

PROJECT:	CLARENDON	PROJECT NO. :	AIR 04-3154 C/I
DESIGN FILE NAME:			
IPARM FILE NAME:	S05	PLOT DATE:	27-JUL-2005
COMMON EXCAVATION			

