

# STATE OF VERMONT

## DEPARTMENT OF TRANSPORTATION

3-50-0012-03

AIR 03-2027

★ 1984

instruction  
has been



According to the following description:

By Daniel D. White Resident Engineer

Date 1-7-87


### PROPOSED IMPROVEMENT

TOWN OF: MORRISTOWN

COUNTY OF: LAMOILLE

ROUTE NO: MORRISVILLE - STOWE STATE AIRPORT

ROUTE CLASS: N/A

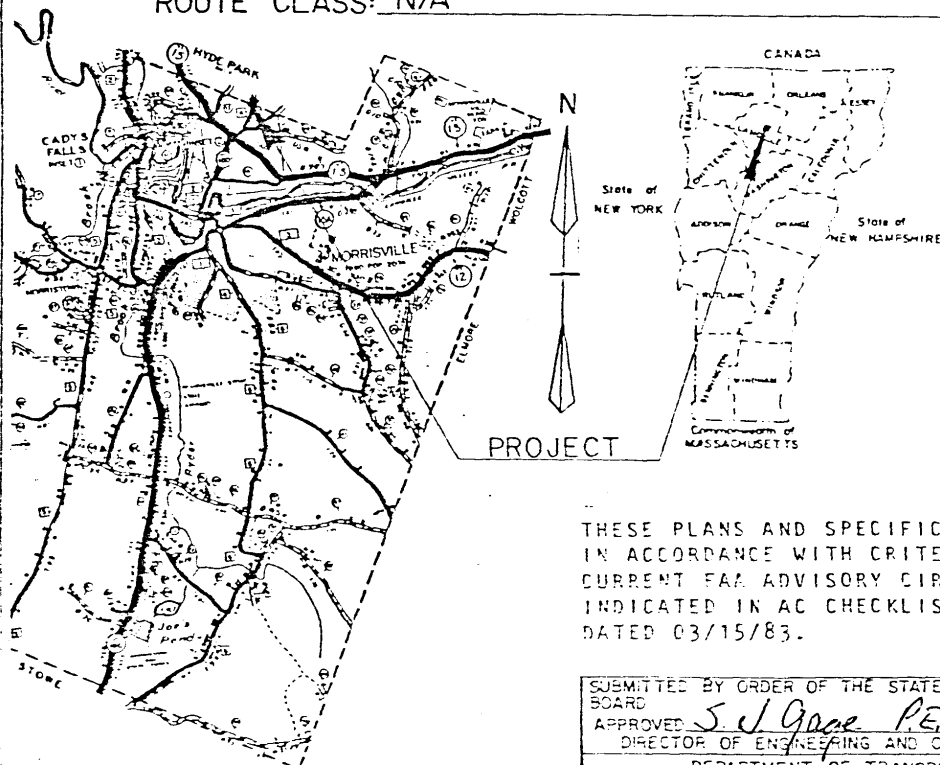

THESE PLANS AND SPECIFICATIONS ARE  
IN ACCORDANCE WITH CRITERIA IN  
CURRENT FAA ADVISORY CIRCULARS AS  
INDICATED IN AC CHECKLIST AC 00-2WW  
DATED 03/15/83.

#### INDEX OF SHEETS

1. TITLE SHEET
2. PROJECT DESCRIPTION AND LOCATION
3. PLAN SHEET

|                                                                |                     |
|----------------------------------------------------------------|---------------------|
| SUBMITTED BY ORDER OF THE STATE TRANSPORTATION BOARD           |                     |
| APPROVED <u>S. J. Gagne P.E.</u>                               | DATE <u>8-13-84</u> |
| DIRECTOR OF ENGINEERING AND CONSTRUCTION                       |                     |
| DEPARTMENT OF TRANSPORTATION<br>FEDERAL HIGHWAY ADMINISTRATION |                     |
| APPROVED _____                                                 | DATE _____          |
| DIVISION ADMINISTRATOR                                         |                     |

PROJECT NO. AIR 03-2027

STATE OF VERMONT  
Department of Administration  
PURCHASING DIVISION  
MONTPELIER

REPORT OF VENDOR PERFORMANCE

| CONTRACT NUMBER | DATE     | DEPARTMENT     | COMMODITY<br>OR<br>TYPE OF WORK | CONTRACTOR     |
|-----------------|----------|----------------|---------------------------------|----------------|
| 14775C          | 10/19/88 | Transportation | Aviation Fueling System         | The DeCo Corp. |

This section to be used for contracts involving labor and material.

DESCRIPTION OF PROJECT: Design and install an aviation fueling system at Franklin  
County Stat Airport.

- 1) Completion Date..... January 6, 1989
  - 2) Was Workmanship and Progress Satisfactory? ..... Yes
  - 3) Should This Contractor Be Invited To Quote On Future Projects? ..... Yes
- Final Approval and Inspection Made By Marvin Pfenning, Roy Nicholson,  
John D. Clifford, and Robert McMullin
- Date January 17, 1989


This section to be used for purchase orders or contracts involving commodities.

- 1) Date of Contract Release Order or Purchase Order .....
  - 2) Date Delivery was Promised (If Promise Was Made By Contractor) .....
  - 3) Date Shipment Was Received .....
- Inspection Made By .....
- Date .....

REMARKS:

Please Return This Completed Form To:  
Purchasing Director, Montpelier, Vermont

# PROJECT DESCRIPTION AND LOCATION

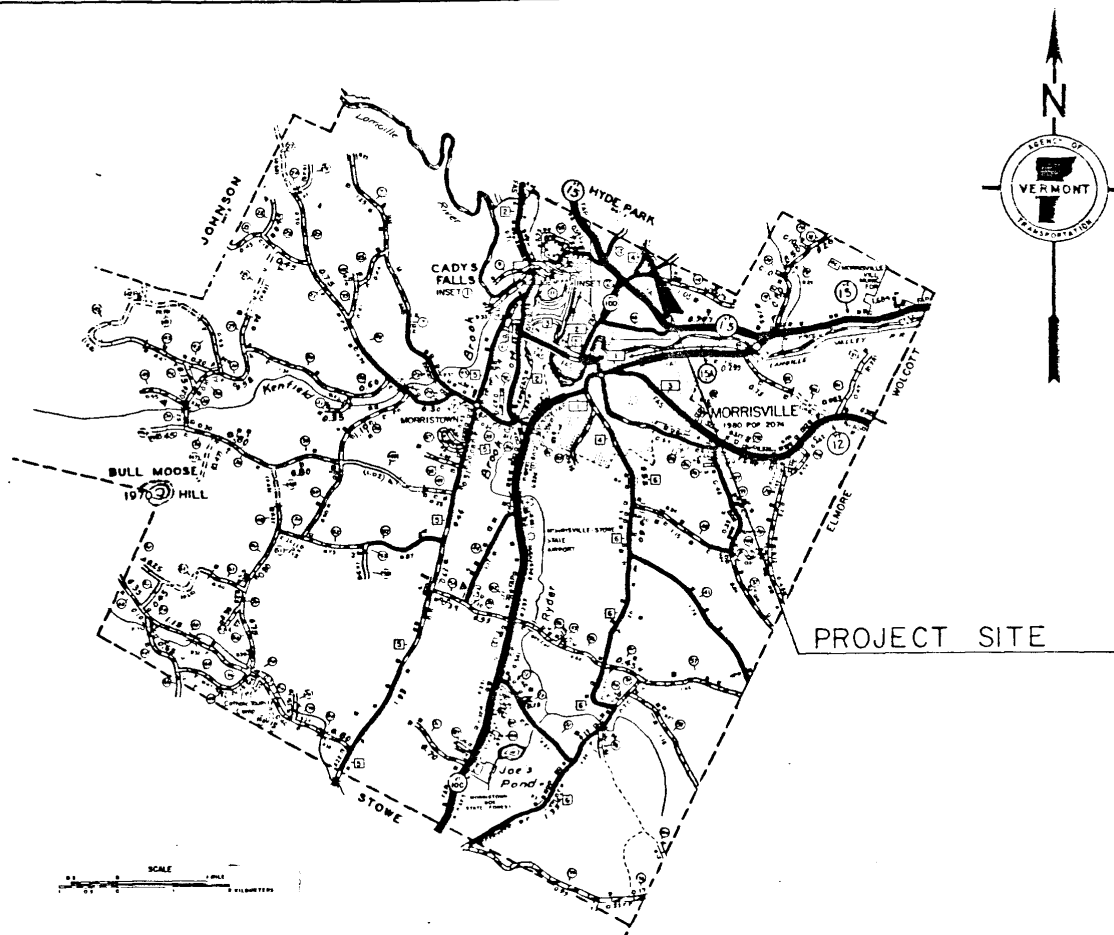

PROJECT DESCRIPTION: REPLACEMENT OF EXISTING, NON-DIRECTIONAL  
BEACON AND BUILDING, INCLUDING ANTENNA  
AND UNDERGROUND COUNTERPOISE.

## AS BUILT PLANS

I hereby certify that the construction  
required for this project has been  
accomplished as stated herein.

By David W. Hill Resident Engineer

Date 1-2-87

NO. AIR 03-2027

PROJECT MORRISVILLE-STOWE STATE AIRPORT

SHEET 2 OF 3 SHEETS

# STATE OF VERMONT

## AGENCY OF TRANSPORTATION AS BUILT PLANS

I have examined the construction  
required by the drawings has been  
accomplished in accordance with the  
specifications.

By Donald W. Hill Resident Engineer

Date 1-7-87




## PROPOSED IMPROVEMENT

TOWN OF: MORRISTOWN

COUNTY OF: LAMOILLE

ROUTE NO: MORRISVILLE - STOWE STATE AIRPORT

ROUTE CLASS: N/A

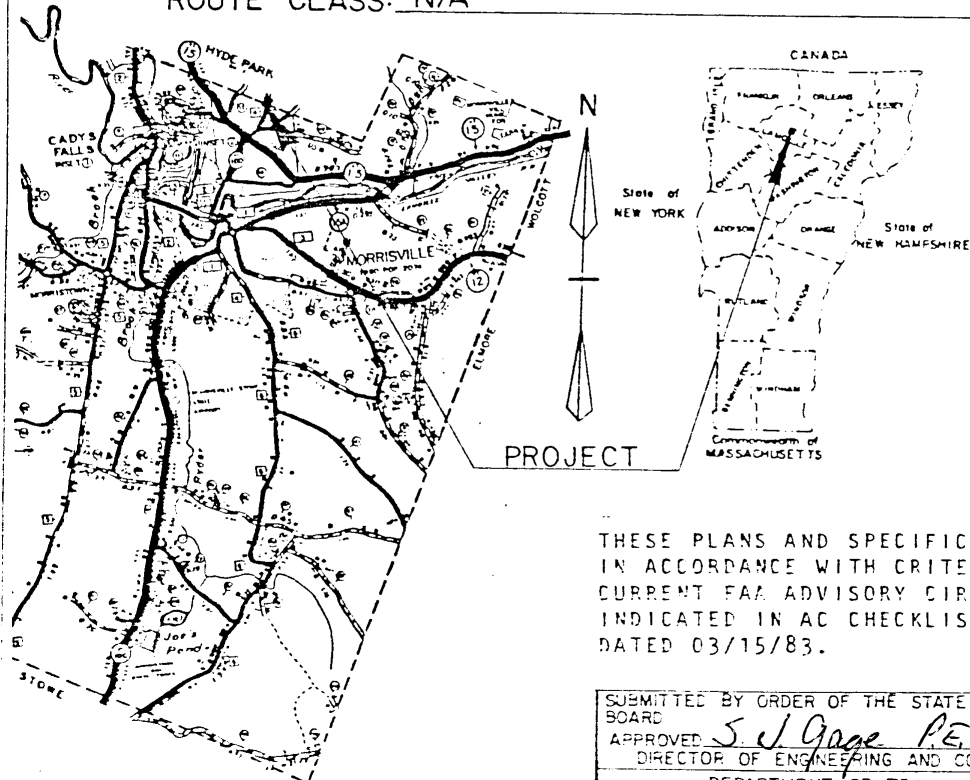

PROJECT

THESE PLANS AND SPECIFICATIONS ARE  
IN ACCORDANCE WITH CRITERIA IN  
CURRENT FAA ADVISORY CIRCULARS AS  
INDICATED IN AC CHECKLIST AC 00-2WW  
DATED 03/15/83.

### INDEX OF SHEETS


1. TITLE SHEET
2. PROJECT DESCRIPTION AND LOCATION
3. PLAN SHEET

|                                                                |                     |
|----------------------------------------------------------------|---------------------|
| SUBMITTED BY ORDER OF THE STATE TRANSPORTATION BOARD           |                     |
| APPROVED <u>S. J. Gage P.E.</u>                                | DATE <u>8-13-84</u> |
| DIRECTOR OF ENGINEERING AND CONSTRUCTION                       |                     |
| DEPARTMENT OF TRANSPORTATION<br>FEDERAL HIGHWAY ADMINISTRATION |                     |
| APPROVED _____                                                 | DATE _____          |
| DIVISION ADMINISTRATOR                                         |                     |

PROJECT NO AIR 03-2027

SHEET 1 OF 3 SHEETS

# PROJECT DESCRIPTION AND LOCATION

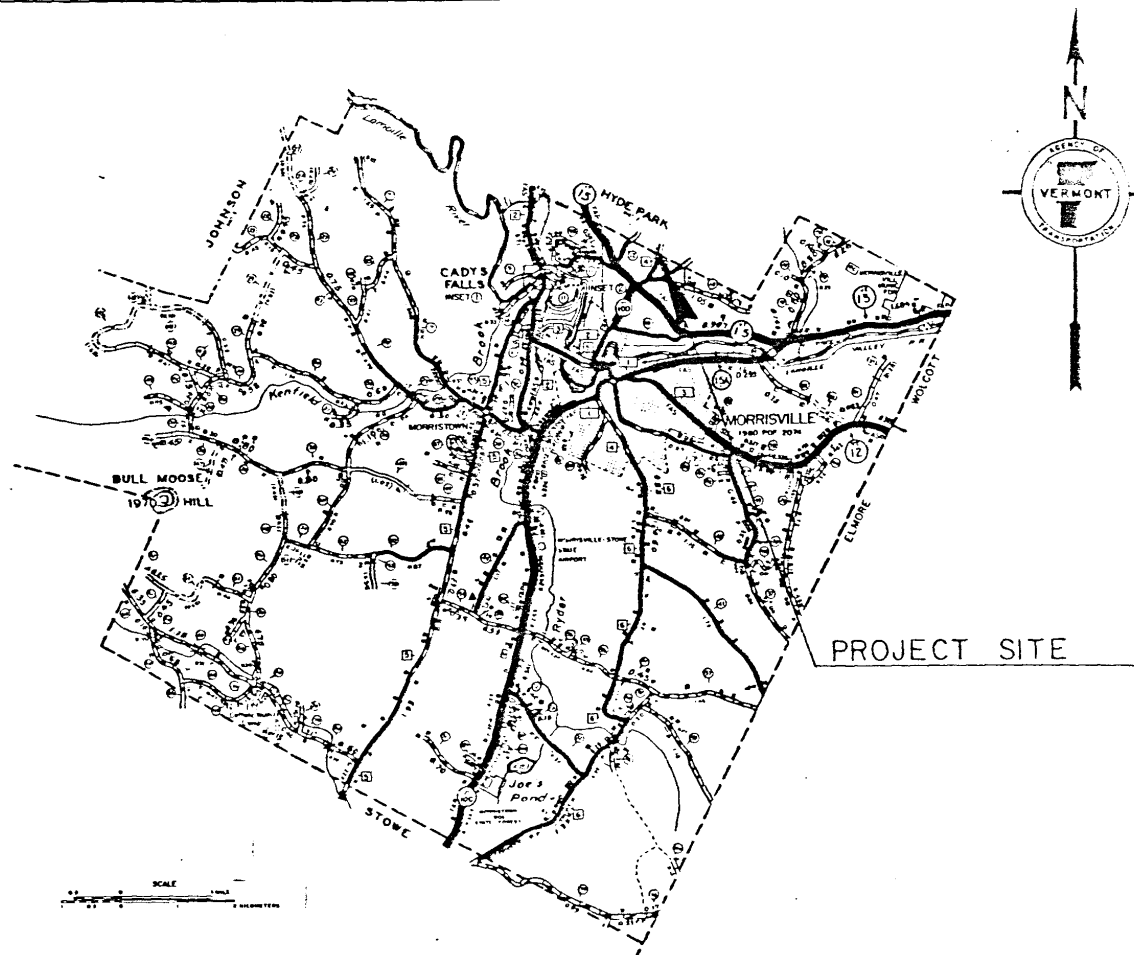

PROJECT DESCRIPTION: REPLACEMENT OF EXISTING, NON-DIRECTIONAL  
BEACON AND BUILDING, INCLUDING ANTENNA  
AND UNDERGROUND COUNTERPOISE.

## AS BUILT PLANS

I hereby certify that the construction  
required by the drawings has been  
accomplished as located herein.

By Daniel W. Hilly Resident Engineer


Date 1-7-87

STATE OF VERMONT  
AGENCY OF TRANSPORTATION



PROPOSED IMPROVEMENT  
NON-DIRECTIONAL BEACON REPLACEMENT

TOWN OF DERBY  
COUNTY OF ORLEANS  
NEWPORT STATE AIRPORT

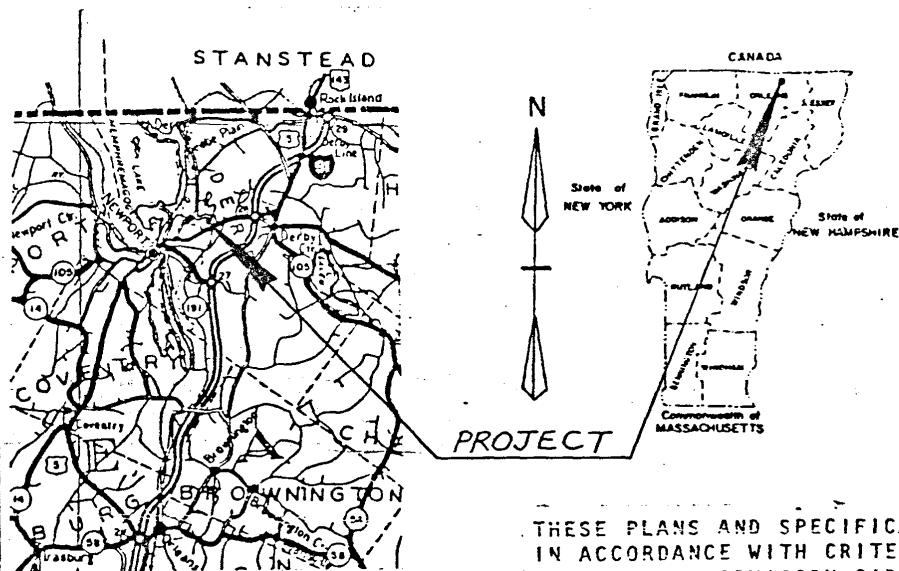

INDEX OF SHEETS

THESE PLANS AND SPECIFICATIONS ARE  
IN ACCORDANCE WITH CRITERIA IN  
CURRENT FAA ADVISORY CIRCULARS AS  
INDICATED IN AC CHECKLIST AC 00-2WW  
DATED 03/15/83.

AS BUILT PLANS

1. The construction of the beacon is  
required by the set of drawings has been  
accomplished in accordance with the  
plans and specifications.

By Leon E. Mason Resident Engineer

Date 1/20/87

SUBMITTED BY ORDER OF THE STATE TRANSPORTATION  
BOARD


APPROVED \_\_\_\_\_ DATE \_\_\_\_\_  
DIRECTOR OF ENGINEERING AND CONSTRUCTION

DEPARTMENT OF TRANSPORTATION  
FEDERAL AVIATION ADMINISTRATION

APPROVED \_\_\_\_\_ DATE \_\_\_\_\_  
DIVISION ADMINISTRATOR

PROJECT NO. AIR 03-2028

SHEET 1 OF SHEETS

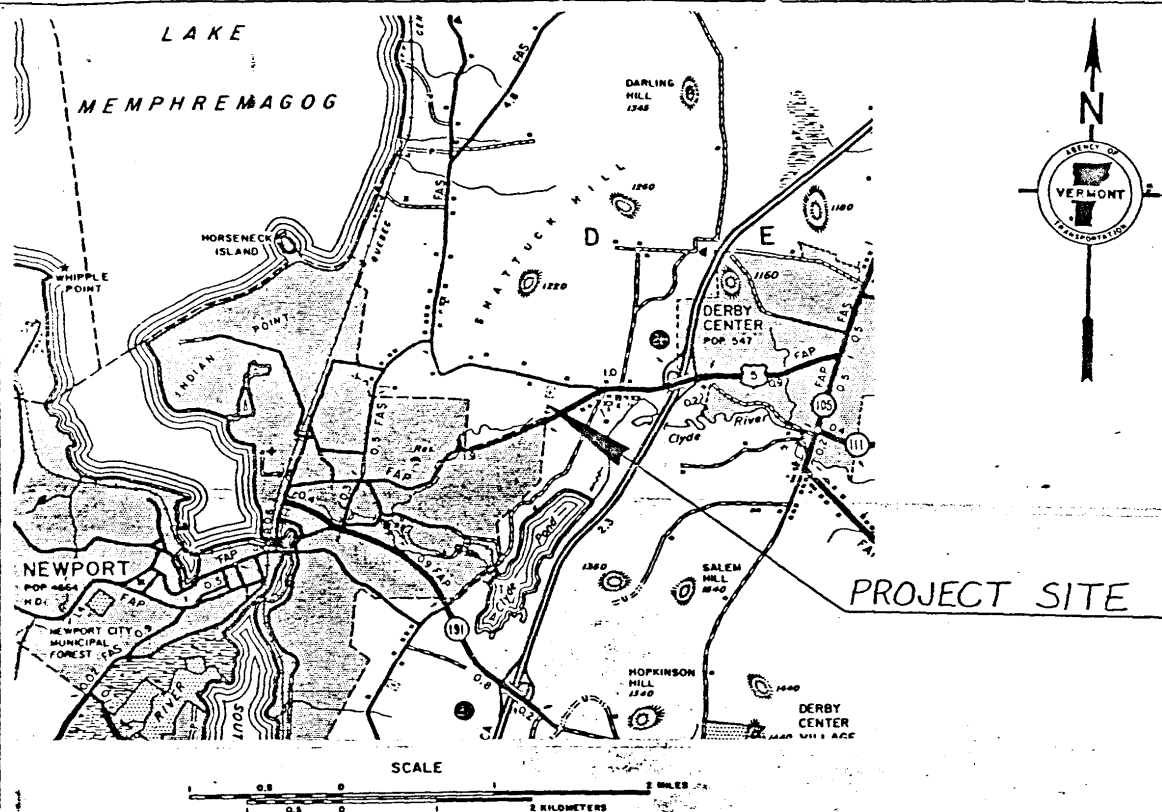

PROJECT DESCRIPTION: Replacement of existing non-directional beacon and building including antenna and underground counterpoise.

#### AS BUILT PLANS

I hereby certify that all the construction required by the contract has been accomplished in accordance with the plans.

By Leon E. Mason Resident Engineer

Date 1/20/87

PROJECT NEWPORT STATE AIRPORT

NO. AIR 03-2028

SHEET 2 OF 2 SHEETS

AS BUILT PLANS


The following certifies that all the construction  
required by the set of drawings has been  
accomplished as indicated herein.

By Leon E. Mason Resident Engineer

Date 1/20/87

By Leon E. Mason Resident Engineer

Date 1/20/87

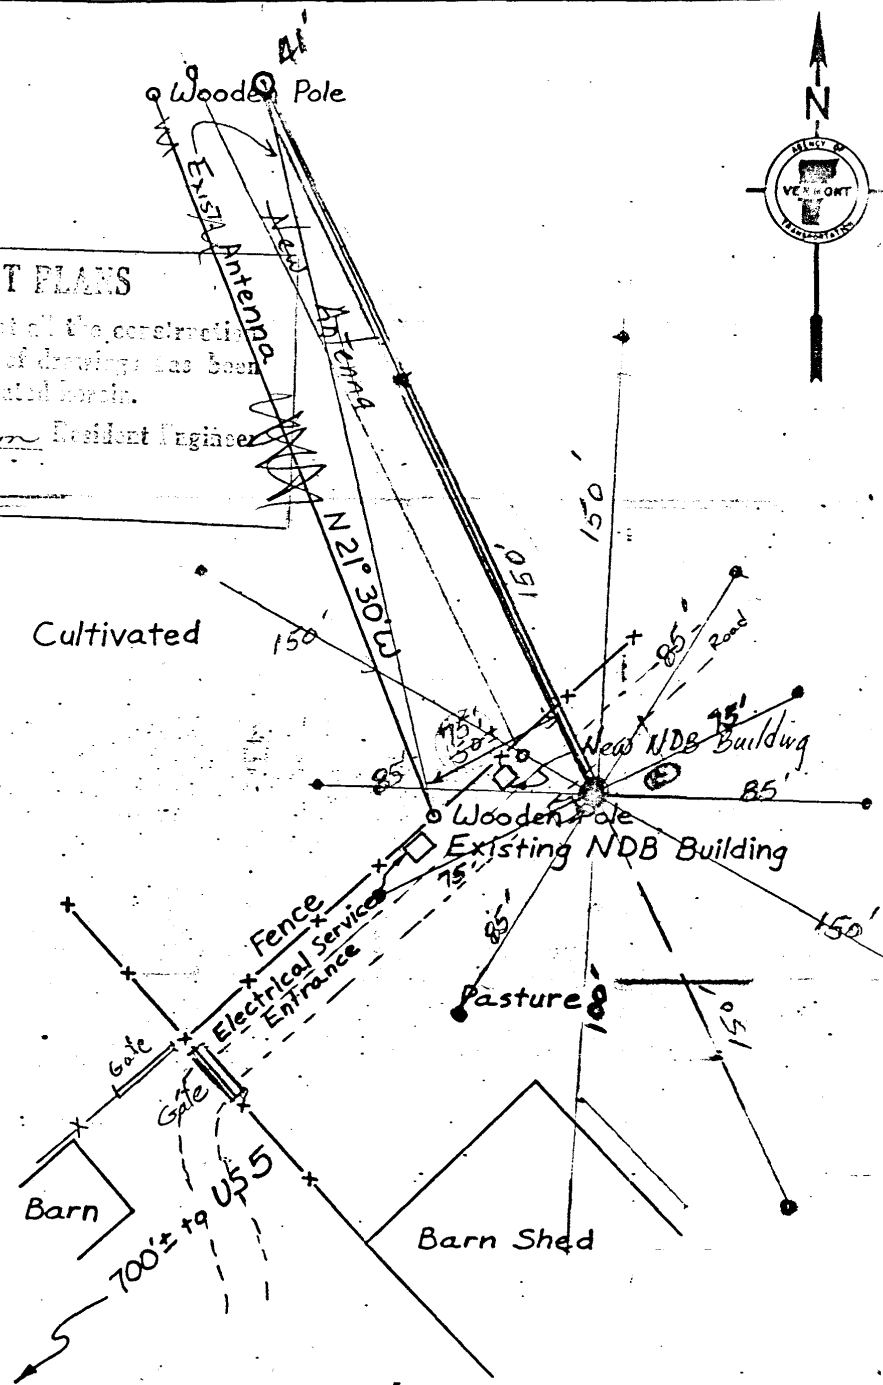

# AS BUILT PLANS

I hereby certify that all the construction  
required for this set of drawings has been  
accomplished as indicated on this.

By John E. Mason Resident Engineer


Date 1/20/87

16' x 16' embased area

NEWPORT  
STATE AIRPORT

NON-DIRECTIONAL  
BEACON

12/84 EHI 1"=4'-0"

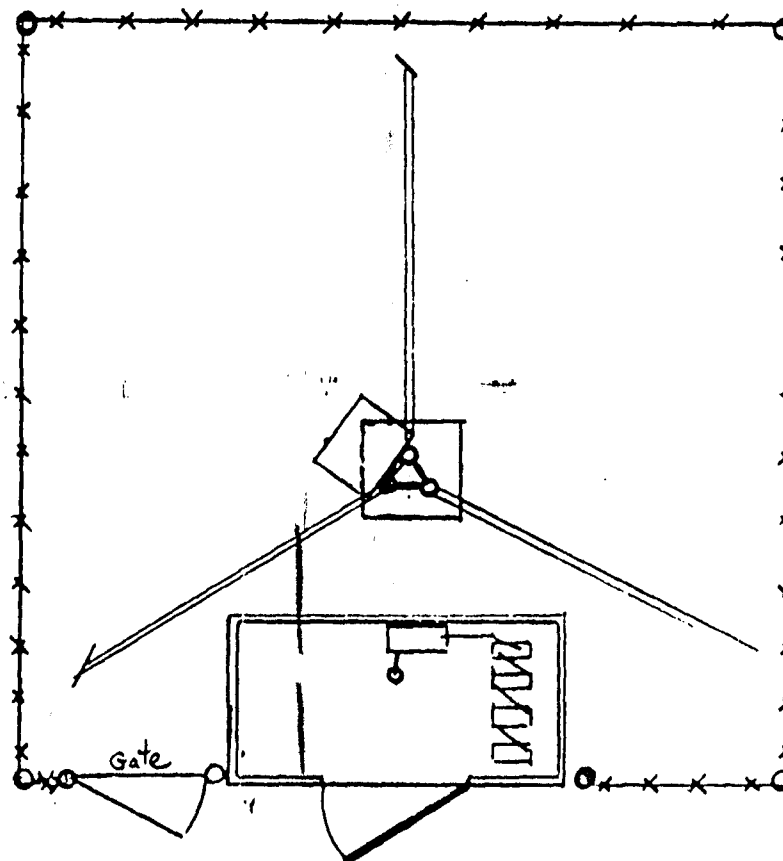

note: fence should be  
grounded on 3 sides.  
Antenna mast needs  
warning sign for electric  
charge.

"No Trespassing" signs  
on fence and building.  
Gate may be moved  
to Rt side of building

Guy Anchor  
40' from  
Antenna


Alum. Building 7' x 3 1/2' x 7' high  
concrete foundation

# SOUTHERN AVIONICS COMPANY

MANUFACTURERS OF LOW FREQUENCY RADIOBEACONS AND ASSOCIATED PRODUCTS



## INVERTED "L" ANTENNA


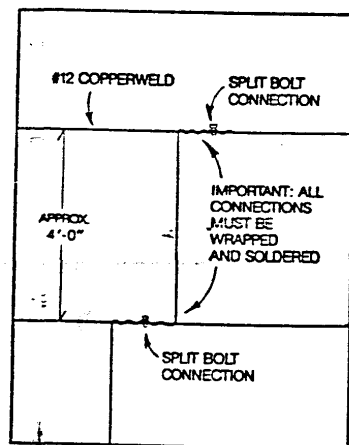


**AS BUILT PLANS**


I hereby certify that all the construction required by the specifications has been accomplished as indicated.

By Don E. Mason Resident Engineer


1/20/87

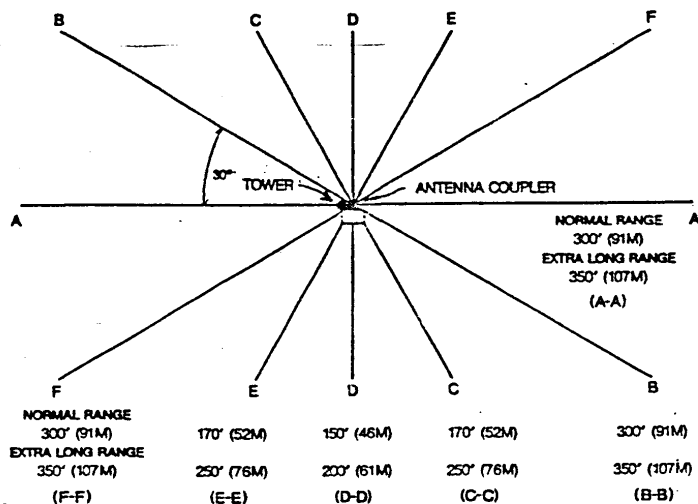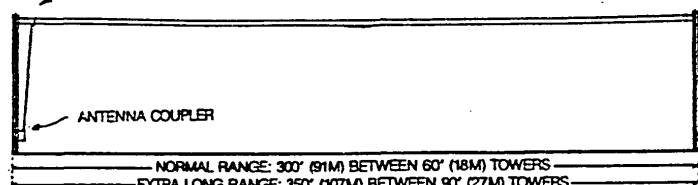

TOWER

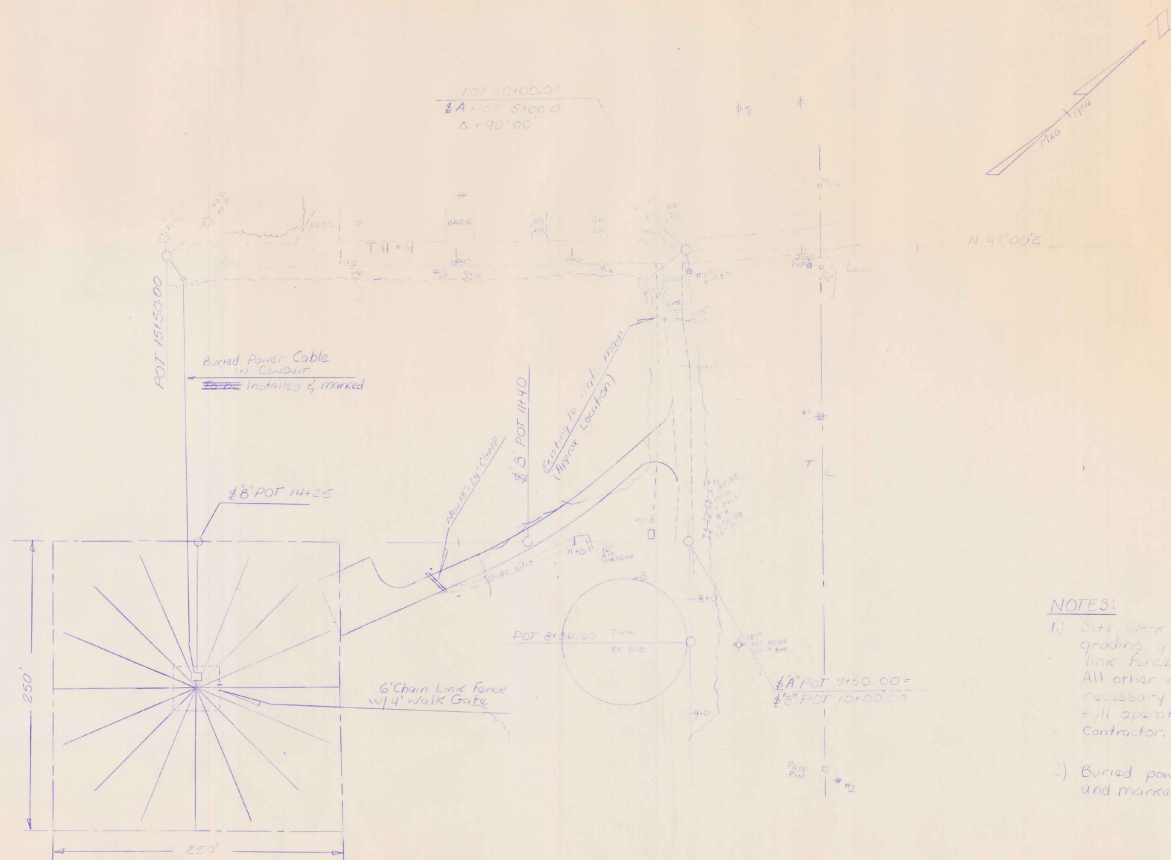

50'x 50'  
CONCRETE PAD

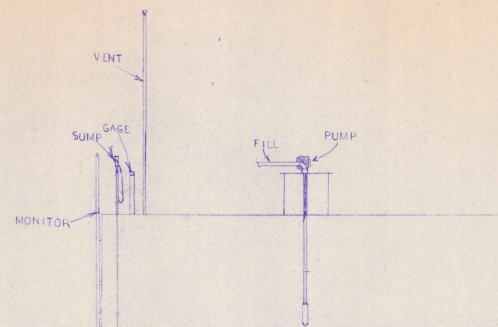

10000 GAL. TANK

PAVMENT

GRASS

UNDERGROUND ELECTRICAL CONDUIT

FENCE

STONE

FILL

CONDUIT

SUPPLY

PATIO AREA

OFFICE

FOR FRANKLIN COUNTY AIRPORT

SCALE: 1/4" = 1'

DATE: 1/5/89


DECO CORP

AS BUILT

APPROVED BY:

REVISION:

DRAWING NUMBER

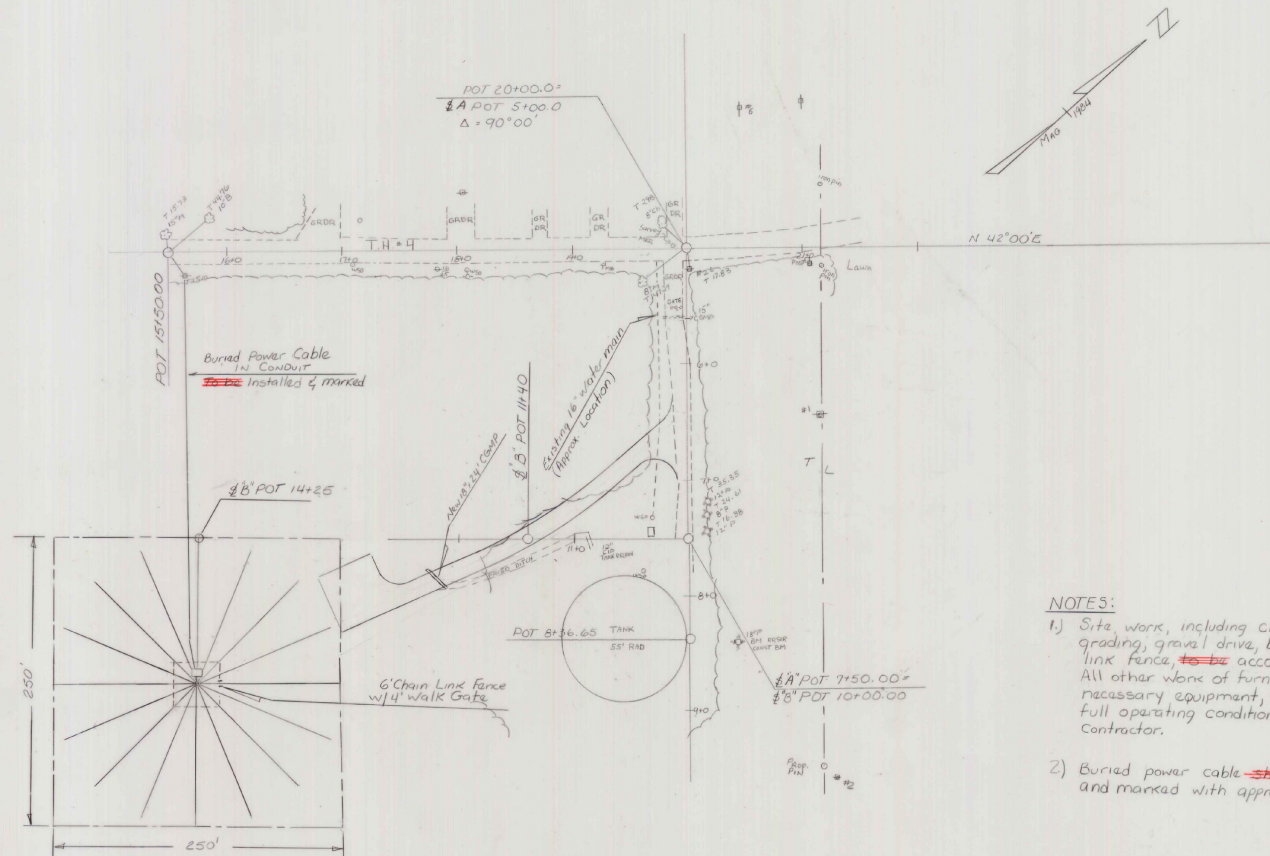

#### NOTES:

- 1) Site work, including clearing of trees and rough grading, gravel drive, buried power cable & chain link fence, ~~to be~~ accomplished by State Forces. All other work of furnishing and installing all necessary equipment, complete and in place, in full operating condition ~~shall be~~ done by the Contractor.
- 2) Buried power cable ~~shall be~~ run in conduit and marked with appropriate safety warnings.

#### AS BUILT PLANS

I hereby certify that all the construction required by this set of drawings has been accomplished as indicated herein.

By Donald W. Jelf Resident Engineer  
 Date 1-7-57

Scale in feet  
 0 20 40

MORRISVILLE STATE AIRPORT

Proj. No. 3-50-0012-03

Installation of New Non-Directional Beacon

EE. Modified Nov. 1958

DATUM  
 VERTICAL \_\_\_\_\_  
 HORIZONTAL \_\_\_\_\_

SURVEYED BY FANTONI DATE 7/54  
 DRAWN BY S. A. TRINIS DATE 7/54  
 TRACED BY S. A. TRINIS DATE 7/54

PROJ. AIR NO. 03-2027  
 SHEET 3 OF 3

MORRISVILLE

VERMONT AGENCY  
PLANNING DIVISION

Vermont Agency of  
Transportation  
Phase III - Interstate  
#090303-01

Hanger 5019

INITIALS  
☐

RTATION