

STATE OF VERMONT

DEPARTMENT OF TRANSPORTATION

3-50-0012-03

AIR 03-2027

★ 1984

instruction
has been



According to the following description:

By Daniel D. White Resident Engineer

Date 1-7-87


PROPOSED IMPROVEMENT

TOWN OF: MORRISTOWN

COUNTY OF: LAMOILLE

ROUTE NO: MORRISVILLE - STOWE STATE AIRPORT

ROUTE CLASS: N/A

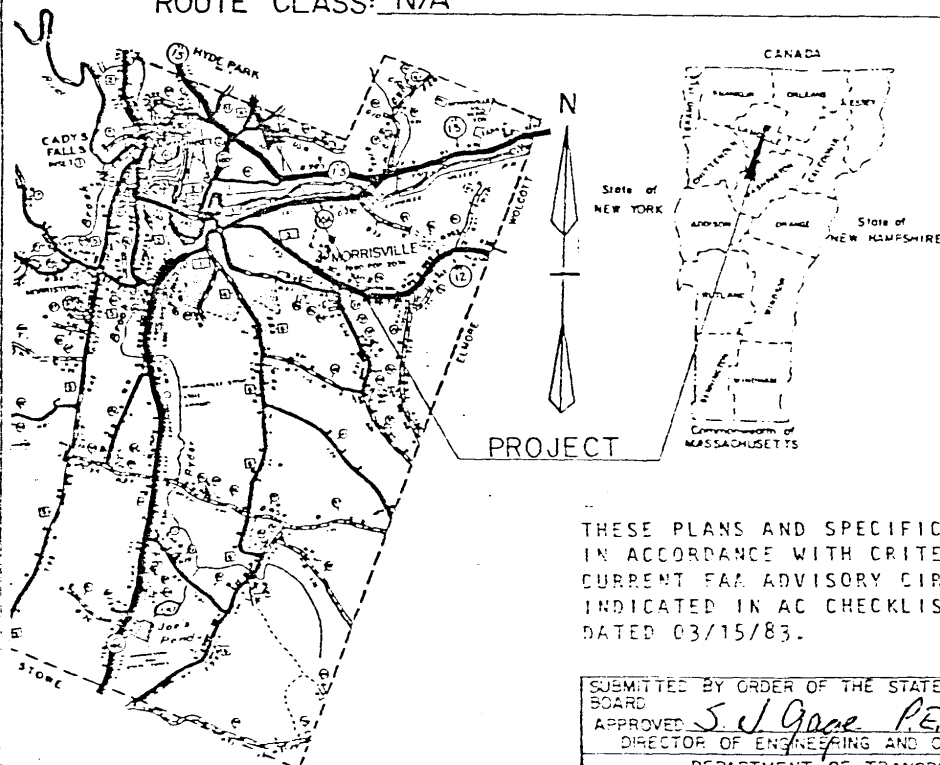

THESE PLANS AND SPECIFICATIONS ARE
IN ACCORDANCE WITH CRITERIA IN
CURRENT FAA ADVISORY CIRCULARS AS
INDICATED IN AC CHECKLIST AC 00-2WW
DATED 03/15/83.

INDEX OF SHEETS

1. TITLE SHEET
2. PROJECT DESCRIPTION AND LOCATION
3. PLAN SHEET

SUBMITTED BY ORDER OF THE STATE TRANSPORTATION BOARD	
APPROVED <u>S. J. Gagne P.E.</u>	DATE <u>8-13-84</u>
DIRECTOR OF ENGINEERING AND CONSTRUCTION	
DEPARTMENT OF TRANSPORTATION FEDERAL HIGHWAY ADMINISTRATION	
APPROVED _____	DATE _____
DIVISION ADMINISTRATOR	

PROJECT NO. AIR 03-2027

STATE OF VERMONT
Department of Administration
PURCHASING DIVISION
MONTPELIER

REPORT OF VENDOR PERFORMANCE

CONTRACT NUMBER	DATE	DEPARTMENT	COMMODITY OR TYPE OF WORK	CONTRACTOR
14775C	10/19/88	Transportation	Aviation Fueling System	The DeCo Corp.

This section to be used for contracts involving labor and material.

DESCRIPTION OF PROJECT: Design and install an aviation fueling system at Franklin
County Stat Airport.

- 1) Completion Date..... January 6, 1989
- 2) Was Workmanship and Progress Satisfactory? Yes
- 3) Should This Contractor Be Invited To Quote On Future Projects? Yes
- Final Approval and Inspection Made By Marvin Pfenning, Roy Nicholson,
John D. Clifford, and Robert McMullin
- Date January 17, 1989


This section to be used for purchase orders or contracts involving commodities.

- 1) Date of Contract Release Order or Purchase Order
- 2) Date Delivery was Promised (If Promise Was Made By Contractor)
- 3) Date Shipment Was Received
- Inspection Made By
- Date

REMARKS:

Please Return This Completed Form To:
Purchasing Director, Montpelier, Vermont

PROJECT DESCRIPTION AND LOCATION

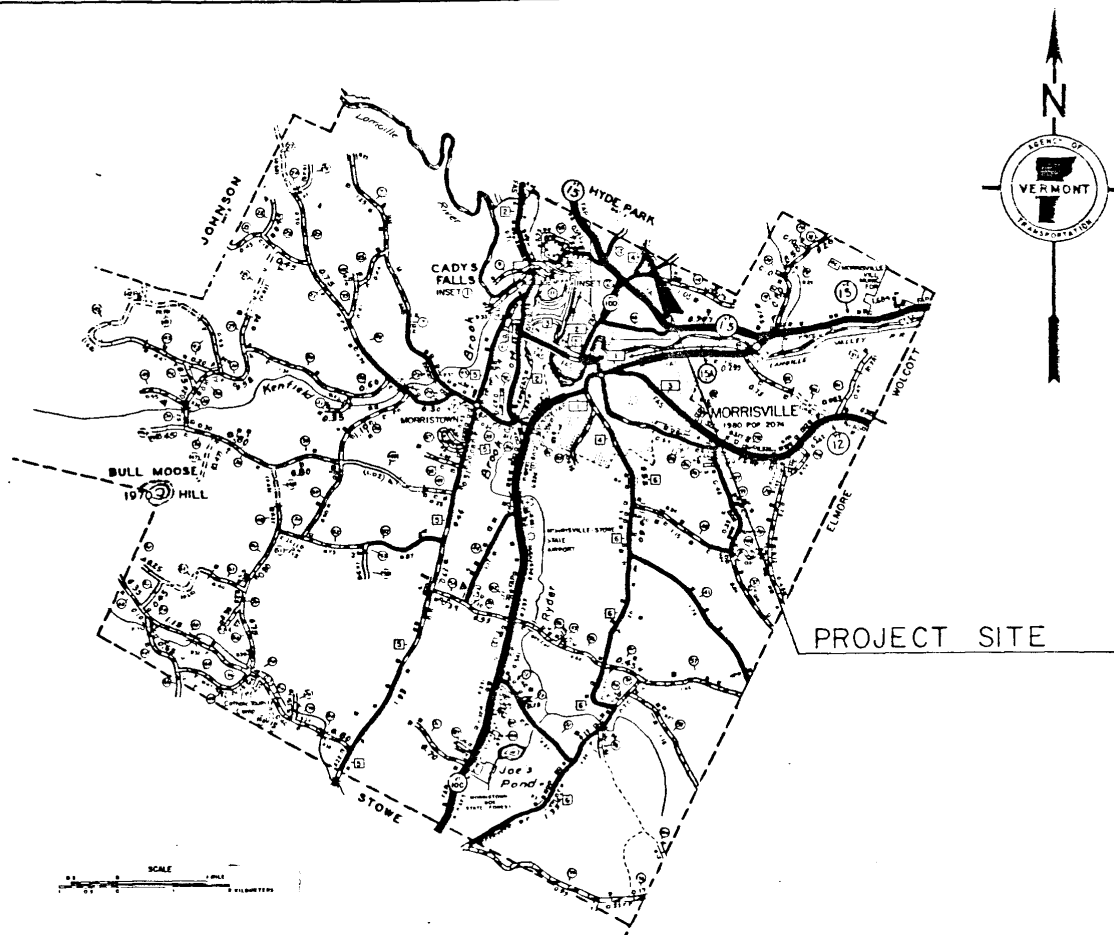

PROJECT DESCRIPTION: REPLACEMENT OF EXISTING, NON-DIRECTIONAL
BEACON AND BUILDING, INCLUDING ANTENNA
AND UNDERGROUND COUNTERPOISE.

AS BUILT PLANS

I hereby certify that the construction
required for this project has been
accomplished as stated herein.

By David W. Hill Resident Engineer

Date 1-2-87

NO. AIR 03-2027

PROJECT MORRISVILLE-STOWE STATE AIRPORT

SHEET 2 OF 3 SHEETS

STATE OF VERMONT

AGENCY OF TRANSPORTATION AS BUILT PLANS

I have examined the construction
required by the drawings has been
accomplished in accordance with the
specifications.

By Donald W. Hill Resident Engineer

Date 1-7-87




PROPOSED IMPROVEMENT

TOWN OF: MORRISTOWN

COUNTY OF: LAMOILLE

ROUTE NO: MORRISVILLE - STOWE STATE AIRPORT

ROUTE CLASS: N/A

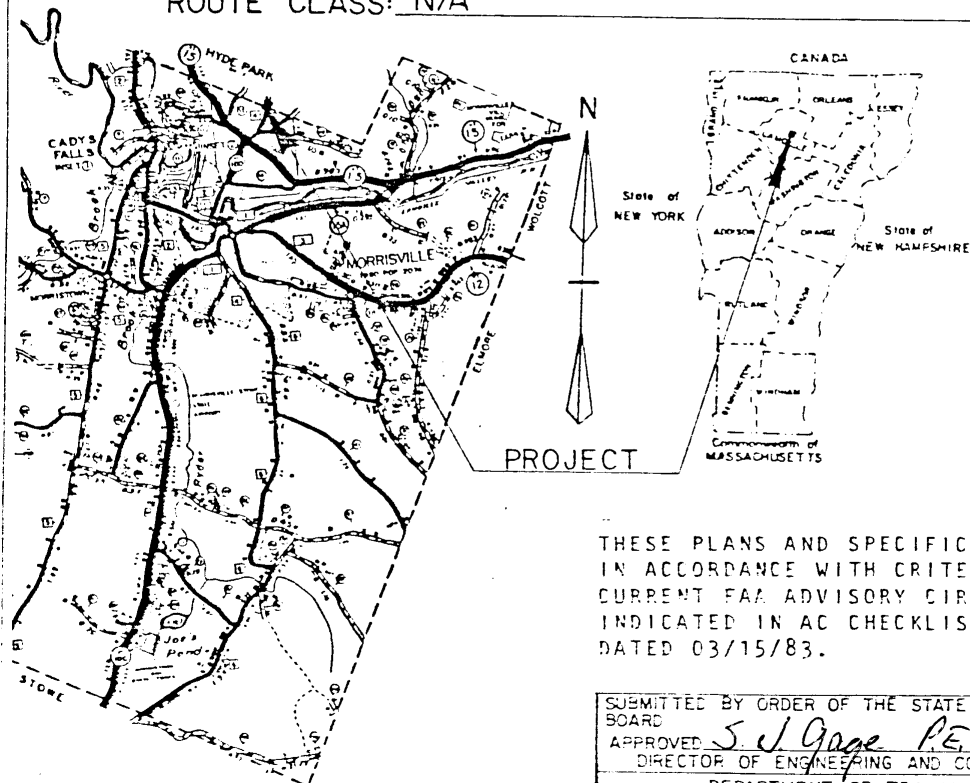

PROJECT

THESE PLANS AND SPECIFICATIONS ARE
IN ACCORDANCE WITH CRITERIA IN
CURRENT FAA ADVISORY CIRCULARS AS
INDICATED IN AC CHECKLIST AC 00-2WW
DATED 03/15/83.

INDEX OF SHEETS


1. TITLE SHEET
2. PROJECT DESCRIPTION AND LOCATION
3. PLAN SHEET

SUBMITTED BY ORDER OF THE STATE TRANSPORTATION
BOARD
APPROVED S. J. Gage P.E. DATE 8-13-84
DIRECTOR OF ENGINEERING AND CONSTRUCTION
DEPARTMENT OF TRANSPORTATION
FEDERAL HIGHWAY ADMINISTRATION
APPROVED _____ DATE _____
DIVISION ADMINISTRATOR

PROJECT NO. AIR 03-2027

SHEET 1 OF 3 SHEETS

PROJECT DESCRIPTION AND LOCATION

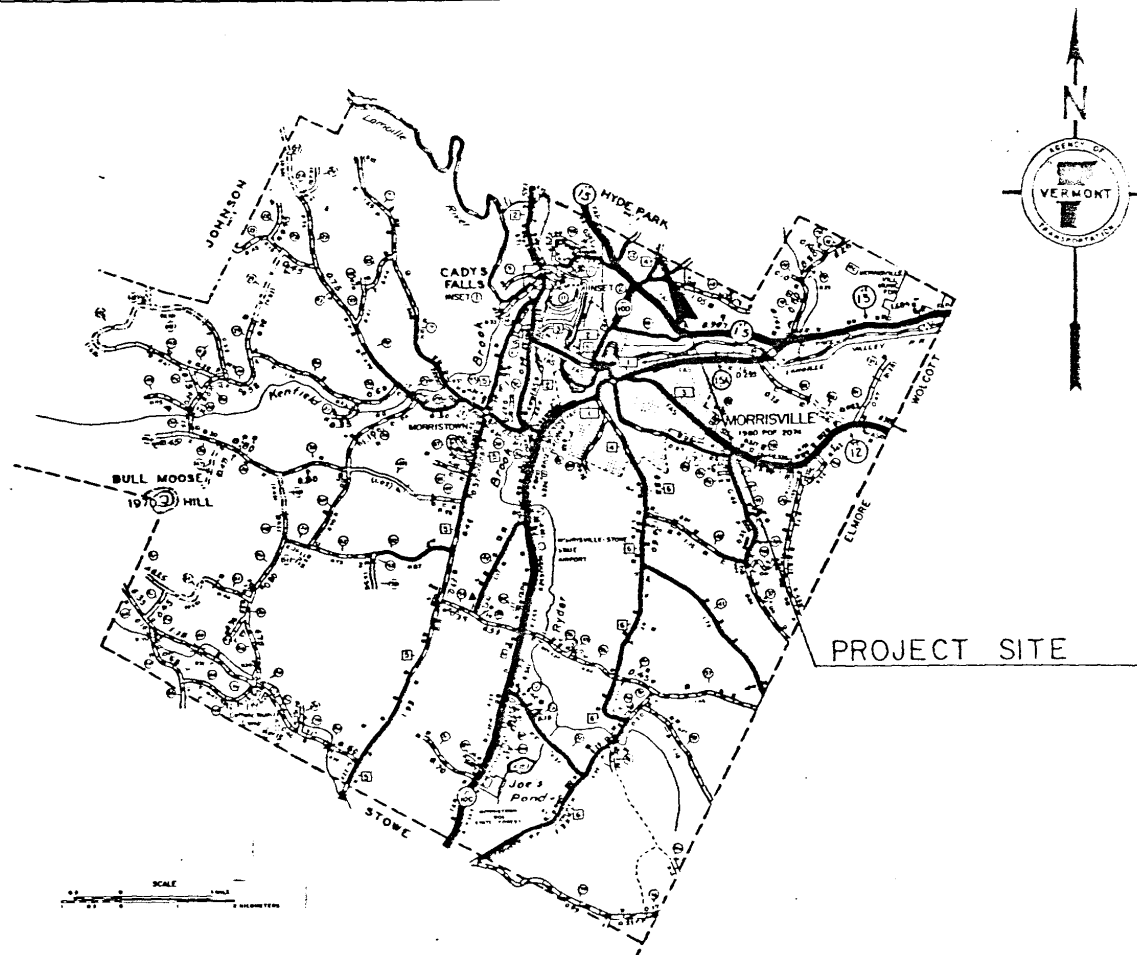

PROJECT DESCRIPTION: REPLACEMENT OF EXISTING, NON-DIRECTIONAL
BEACON AND BUILDING, INCLUDING ANTENNA
AND UNDERGROUND COUNTERPOISE.

AS BUILT PLANS

I hereby certify that the construction
required for the drawings has been
accomplished as located herein.

By Daniel W. Hilly Resident Engineer


Date 1-7-87

STATE OF VERMONT
AGENCY OF TRANSPORTATION



PROPOSED IMPROVEMENT
NON-DIRECTIONAL BEACON REPLACEMENT

TOWN OF DERBY
COUNTY OF ORLEANS
NEWPORT STATE AIRPORT

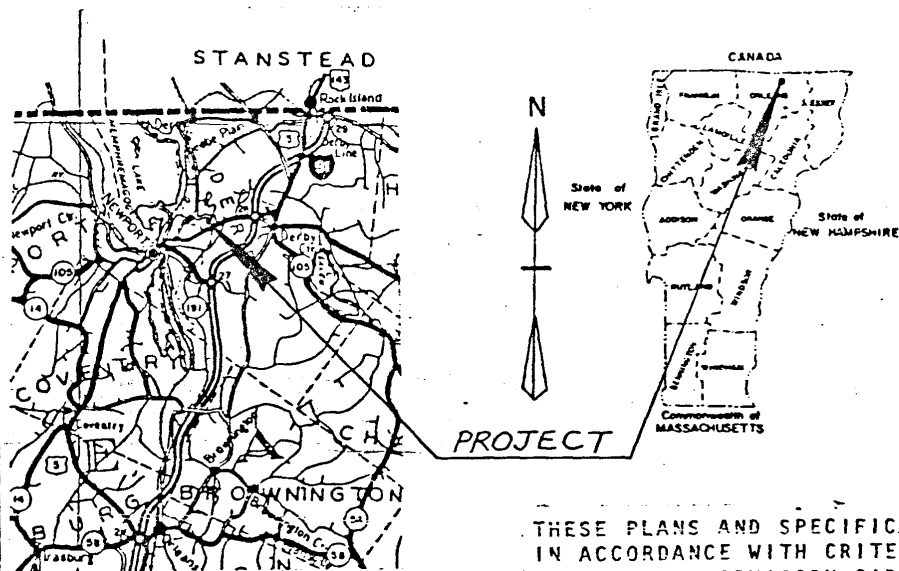

INDEX OF SHEETS

AS BUILT PLANS

1. The construction required by the set of drawings has been accomplished as indicated herein.

By Leon E. Mason Resident Engineer

Date 1/20/87

THESE PLANS AND SPECIFICATIONS ARE
IN ACCORDANCE WITH CRITERIA IN
CURRENT FAA ADVISORY CIRCULARS AS
INDICATED IN AC CHECKLIST AC 00-2WW
DATED 03/15/83.

SUBMITTED BY ORDER OF THE STATE TRANSPORTATION
BOARD


APPROVED _____ DATE _____
DIRECTOR OF ENGINEERING AND CONSTRUCTION

DEPARTMENT OF TRANSPORTATION
FEDERAL AVIATION ADMINISTRATION

APPROVED _____ DATE _____
DIVISION ADMINISTRATOR

PROJECT NO. AIR 03-2028

SHEET 1 OF SHEETS

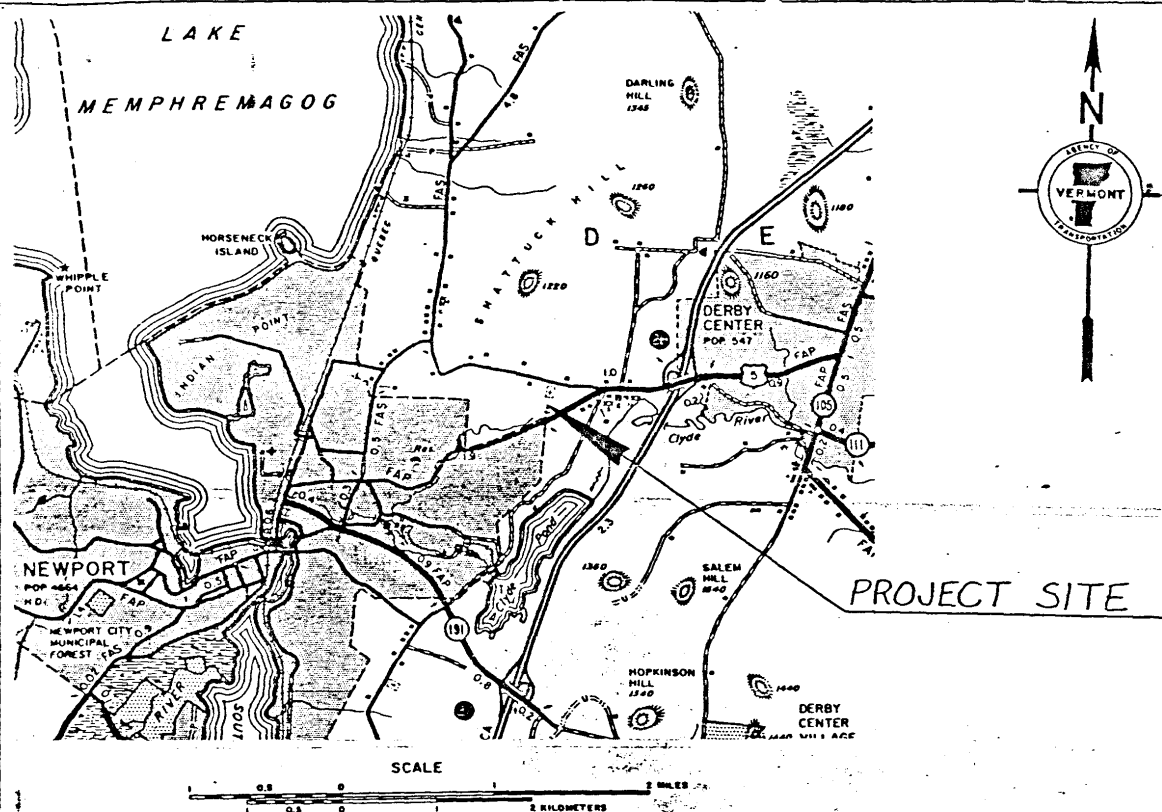

PROJECT DESCRIPTION: Replacement of existing non-directional beacon and building including antenna and underground counterpoise.

AS BUILT PLANS

I hereby certify that all the construction required by the plan of construction has been accomplished to the best of my knowledge.

By Leon E. Mason Resident Engineer

Date 1/20/87

PROJECT NEWPORT STATE AIRPORT

NO. AIR 03-2028


SHEET 2 OF 2 SHEETS

AS BUILT PLANS

I hereby certify that all the construction required by the set of drawings has been accomplished as indicated herein.

By Leon E. Mason Resident Engineer

Date 1/20/87

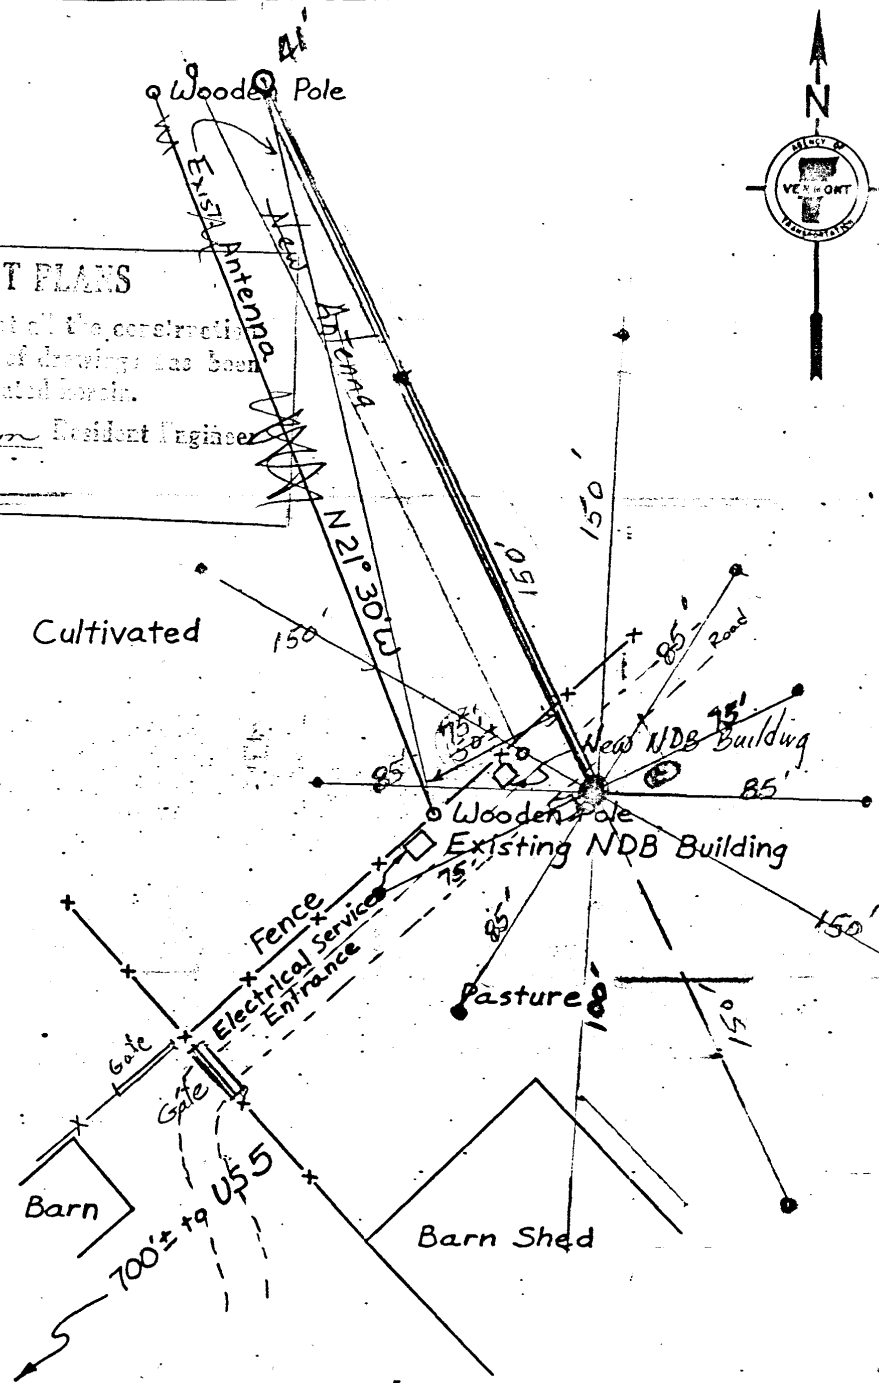

AS BUILT PLANS

I hereby certify that all the construction
required for this set of drawings has been
accomplished as indicated on this.

By John E. Mason Resident Engineer


Date 1/20/87

16' x 16' embased area

NEWPORT
STATE AIRPORT

NON-DIRECTIONAL
BEACON

12/84 EHI 1"=4'-0"

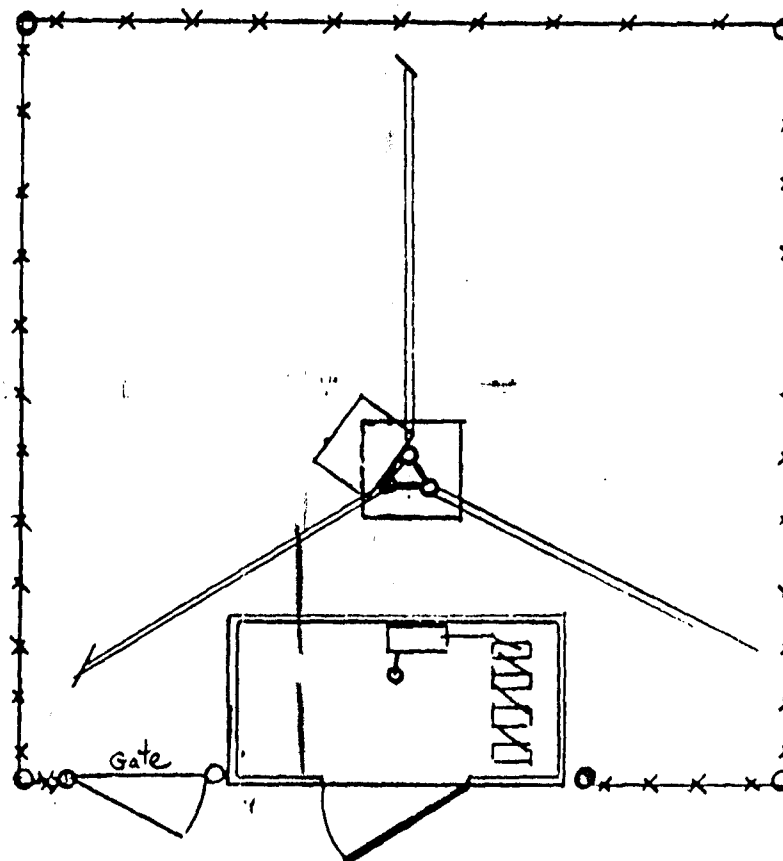

note: fence should be
grounded on 3 sides.
Antenna mast needs
warning sign for electric
charge.

"No Trespassing" signs
on fence and building.
Gate may be moved
to Rt side of building

Guy Anchor
40' from
Antenna


Alum. Building 7' x 3 1/2' x 7' high
concrete foundation

SOUTHERN AVIONICS COMPANY

MANUFACTURERS OF LOW FREQUENCY RADIOBEACONS AND ASSOCIATED PRODUCTS



INVERTED "L" ANTENNA


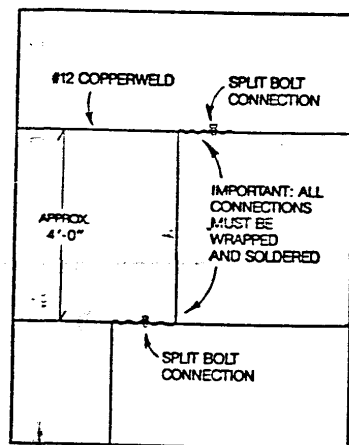


AS BUILT PLANS


I hereby certify that all the construction required by the specifications has been accomplished as indicated.

By Don E. Mason Resident Engineer

1/20/87

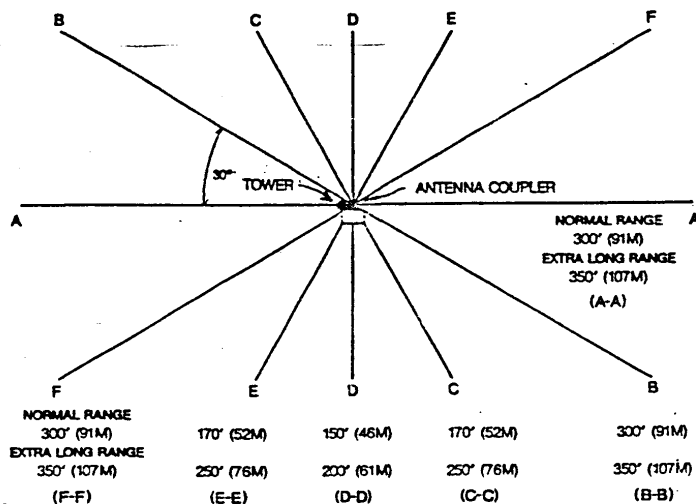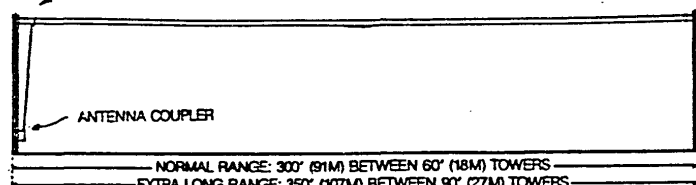

TOWER

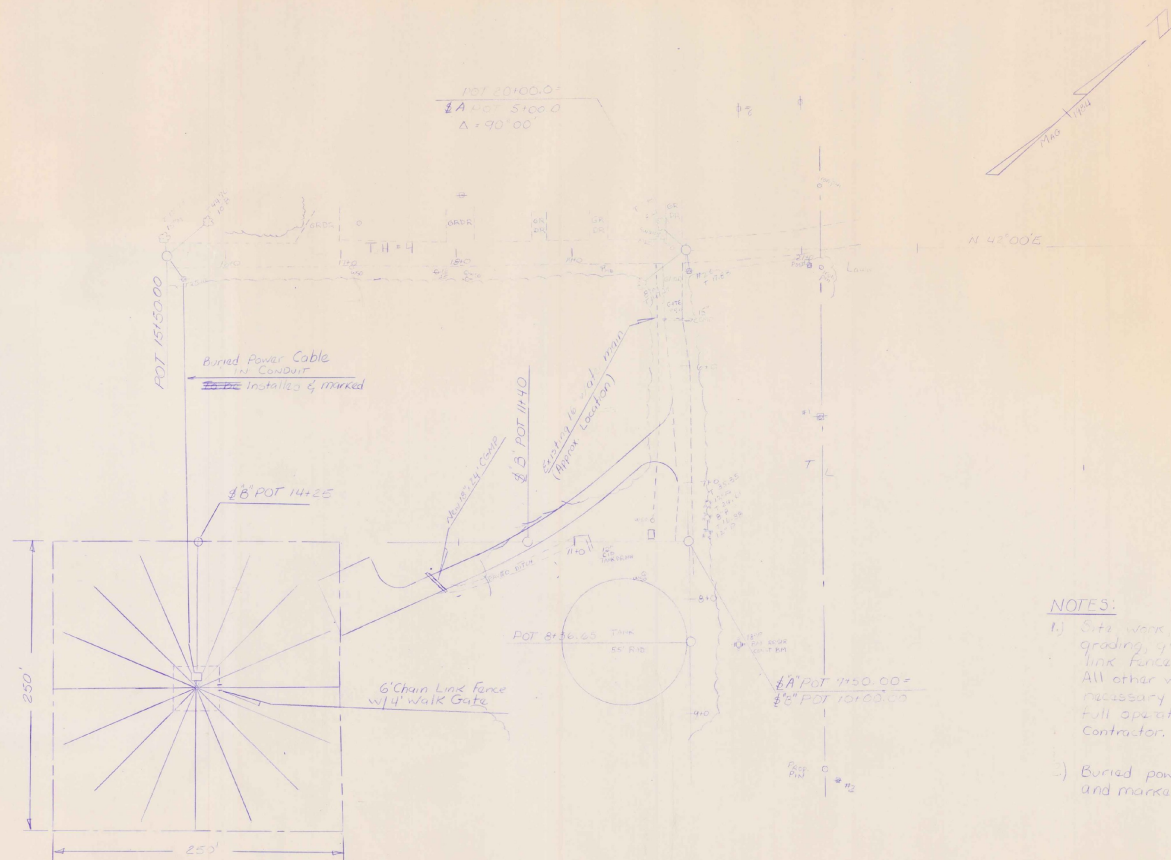

NOTES:


- 1) Site work, including clearing of trees and rough grading, ~~gravel~~ drive, buried power cable & chain link fence, ~~will be~~ accomplished by State Forces. All other work of furnishing and installing all necessary equipment, Complete and in place, in full operating condition ~~will be~~ done by the Contractor.
- 2) Buried power cable ~~will be~~ run in conduit and marked with appropriate safety warnings.

DATUM
VERTICAL _____
HORIZONTAL _____

MISSOURI STATE HIGHWAY
RD. NO. 100-000-000
Installation of the New American Bridge
at the intersection of the
RD. NO. 100-000-000

SURVEYED BY <u>CapTech</u> DATE <u>1/14</u>	
DRAWN BY <u>J. Atkins</u>	DATE <u>1/14</u>
TRACED BY <u>J. Atkins</u>	DATE <u>1/14</u>
PROJ. AIR NO. 03-2027	
SHEET 3	OF 3

50'x 50'
CONCRETE PAD

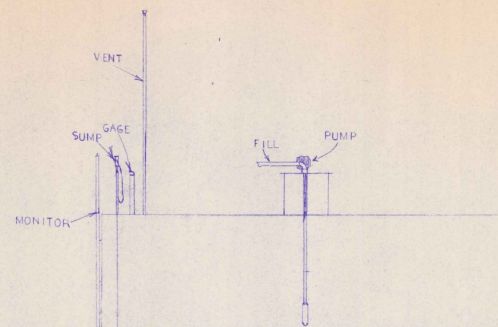

NORTH

10000 GAL. TANK


PAVMENT

GRASS

UNDERGROUND ELECTRICAL CONDUIT



FENCE

STONE

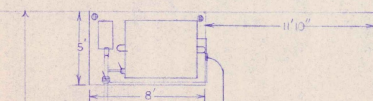


31'

FILL

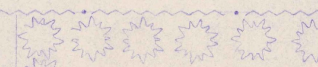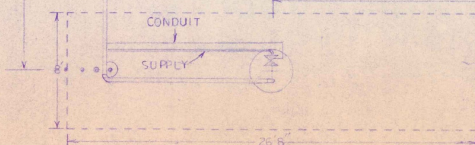

OFFICE

FOR FRANKLIN COUNTY AIRPORT		
SCALE: 1/4" = 1'	APPROVED BY:	DRAWN BY: B.A.H.
DATE: 1/5/89	REVISED:	
DECO CORP		
AS BUILT	DRAWING NUMBER	

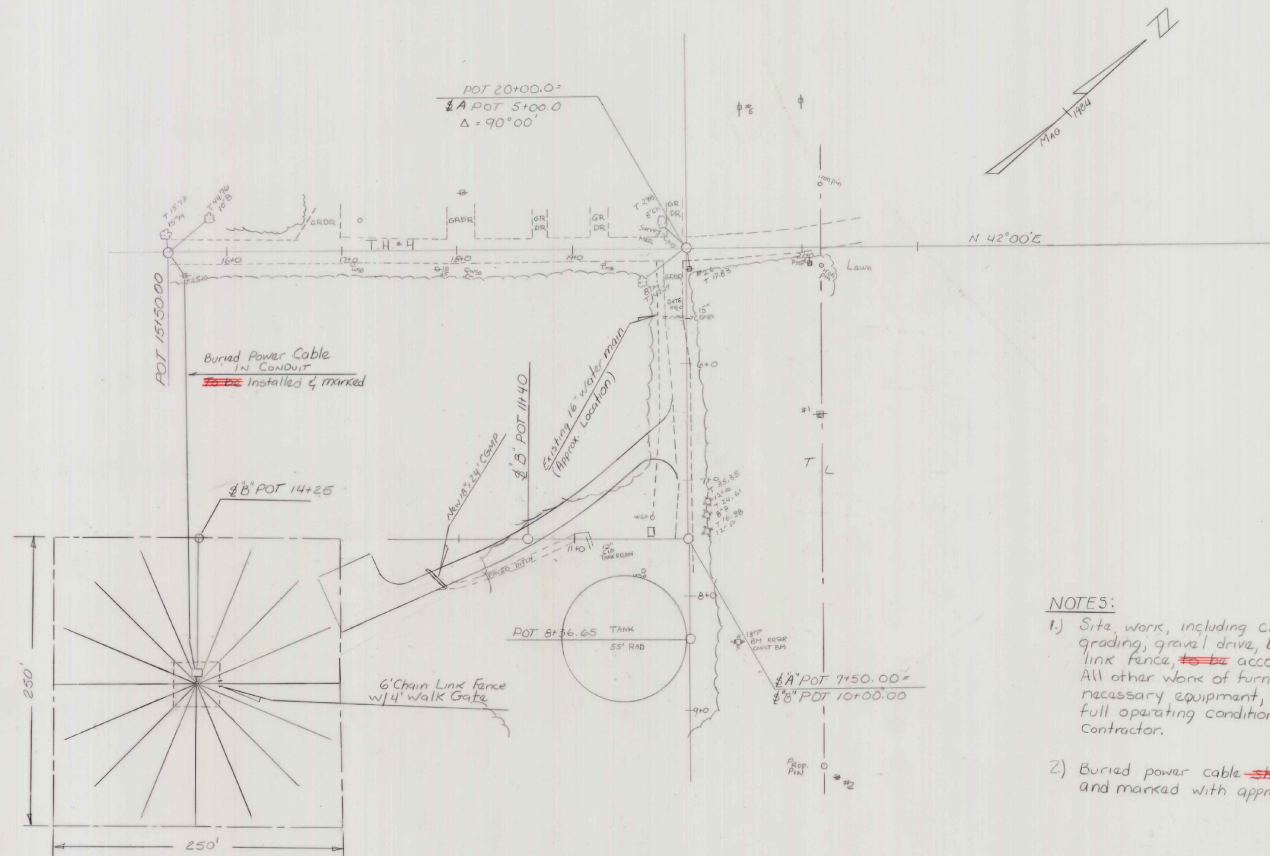

NOTES:

- 1) Site work, including clearing of trees and rough grading, gravel drive, buried power cable & chain link fence, ~~to be~~ accomplished by State Forces. All other work of furnishing and installing all necessary equipment, complete and in place, in full operating condition ~~shall be~~ done by the Contractor.
- 2) Buried power cable ~~shall be~~ run in conduit and marked with appropriate safety warnings.

AS BUILT PLANS

I hereby certify that all the construction required by this set of drawings has been accomplished as indicated herein.

By Donald W. Jelf Resident Engineer
 Date 1-7-57

Scale in feet
 0 20 40

MORRISVILLE STATE AIRPORT

Proj. No. 3-50-0012-03

Installation of New Non-Directional Beacon

EE. Modified Nov. 1958

DATUM
 VERTICAL _____
 HORIZONTAL _____

SURVEYED BY FANTONI DATE 7/54
 DRAWN BY S. A. TRINIS DATE 7/54
 TRACED BY S. A. TRINIS DATE 7/54

PROJ. AIR NO. 03-2027
 SHEET 3 OF 3

MORRISVILLE

VERMONT AGENCY
PLANNING DIVISION

Vermont Agency of
Transportation
Phase III - Interstate
#090303-01

Hanger 5019

INITIALS
☐

RTATION