


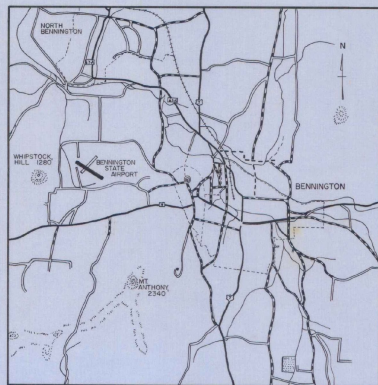


LOCATION MAP

BENNINGTON STATE AIRPORT BENNINGTON, VERMONT

ACCESS ROAD & PARKING LOT CONSTRUCTION

PARKING LOT DELETED FROM PROJECT

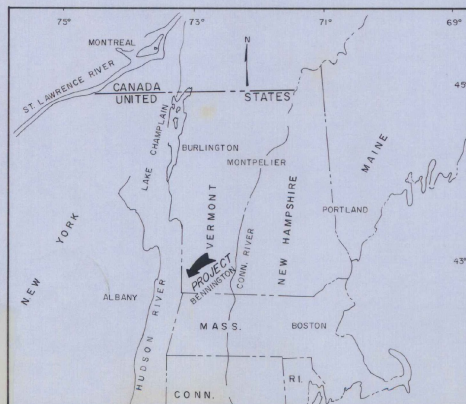

VICINITY MAP

REVISIONS	
DESCRIPTION	DATE

U.S. DEPARTMENT OF TRANSPORTATION

FEDERAL AVIATION ADMINISTRATION

APPROVED _____ DATE _____
CHIEF, AIRPORTS BRANCH
AIRPORTS DIVISION

BENNINGTON STATE AIRPORT
BENNINGTON, VT.

VERMONT AERONAUTICS BOARD

APPROVED _____ DATE _____
COMMISSIONER

APPROVED _____ DATE _____
AIRPORT ENGR.

PREPARED BY
VERMONT AERONAUTICS BOARD

MONTPELIER, VERMONT

VAIL O. LEACH — ENGR.
DATE _____



ADAP 7-50-0033-03

AS BUILT PLANS

I HEREBY CERTIFY THAT ALL CONSTRUCTION
REQUIRED BY THIS SET OF DRAWINGS HAS BEEN
ACCOMPLISHED AS INDICATED HEREIN.



BY Opell W. D'Amico PROJECT ENGINEER

DATE Dec. 3, 1974



ESTIMATED QUANTITIES OF MAJOR ITEMS				
ITEM NO.	ITEM	UNIT	EST. QUANTITY	FINAL QUANT.
SCHEDULE A — ACCESS ROAD CONSTRUCTION				
1A	COMMON EXCAVATION	C.Y.	2800	1489
2A	SOLID ROCK EXCAVATION (EST)	C.Y.	10	0
3A	MUCK EXCAVATION	C.Y.	1600	1913
4A	BORROW	C.Y.	8500	10,371
5A	UNCRUSHED AGGREGATE BASE COURSE	C.Y.	2700	2700
6A	BITUMINOUS PRIME COAT	GAL.	1600	1466
7A	BITUMINOUS CONCRETE PAV'T.	TON	380	361
8A	STRUCTURAL PORTLAND CEMENT CONCRETE	C.Y.	1.8	1.9
9A	STEEL REINFORCEMENT	LB.	12.5	12.5
10A	ACCOMP — ARCH	L.F.	42	42
11A	METAL END SECTION FOR ACCOMP — ARCH	EACH	2	2
12A	18" ACCOMP	L.F.	82	82
13A	STONE FILL, TYPE 1	C.Y.	3.5	3.5
14A	STEEL MARKER POST	EACH	4	4
15A	TOPSOILING	C.Y.	270	270
16A	SEEDING, LIMING, FERTILIZING & MULCHING	M.S.F.	42.5	42.5
SCHEDULE B — AUTOMOBILE PARKING LOT				
1B	COMMON EXCAVATION	C.Y.	500	DELETED FROM PROJECT
2B	SOLID ROCK EXCAVATION (EST)	C.Y.	1	DELETED FROM PROJECT
3B	BORROW	C.Y.	1000	DELETED FROM PROJECT
4B	UNCRUSHED AGGREGATE BASE COURSE	C.Y.	1350	DELETED FROM PROJECT
5B	BITUMINOUS PRIME COAT	GAL.	1000	DELETED FROM PROJECT
6B	BITUMINOUS CONCRETE PAVEMENT	TON	230	DELETED FROM PROJECT
7B	TOPSOILING	C.Y.	55	DELETED FROM PROJECT
8B	SEEDING, LIMING, FERTILIZING & MULCHING	M.S.F.	8.8	DELETED FROM PROJECT

SOIL TEST DATA			
TEST HOLE	PERCOLATION RATE	4" BORINGS	SOIL DESCRIPTION
1	18.47 MIN./IN.	"A"	0-1' TOPSOIL
2	30.00 MIN./IN.		1-10' SANDY SILT
3	2400 MIN./IN.		10-14' SILT & BLDRS.
4	26.66 MIN./IN.	"B"	0-1' TOPSOIL
			1-4' SILTY CLAY
			4-9' SILT & BLDRS.
			9-105' SMALL BLDRS.
			105' LEDGE OR BLDRS.

NOTE:
ALL ELEVATIONS REFER TO MEAN SEA LEVEL.

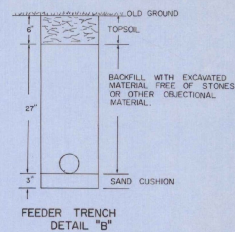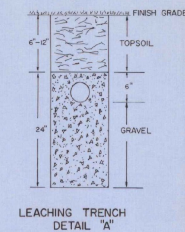

SUMMARY OF QUANTITIES				
ITEM	DESCRIPTION	UNIT	EST. QUANTITY	FINAL QUANTITY
1	1,000 GAL. SEPTIC TANK	EACH	1	
2	FEEDER TRENCH WITH 4" CAST IRON PIPE	L. F.	57'	
3	FEEDER TRENCH WITH 4" PLASTIC PIPE	L. F.	220'	
4	LEACHING FIELD WITH 4" PERFORATED PLASTIC PIPE	L. S.	1	

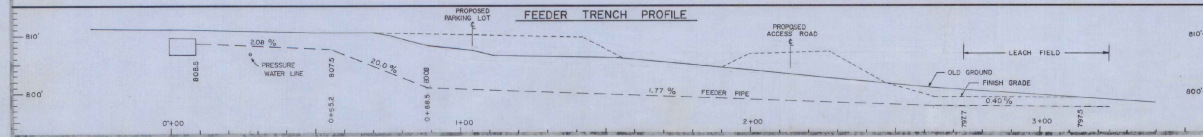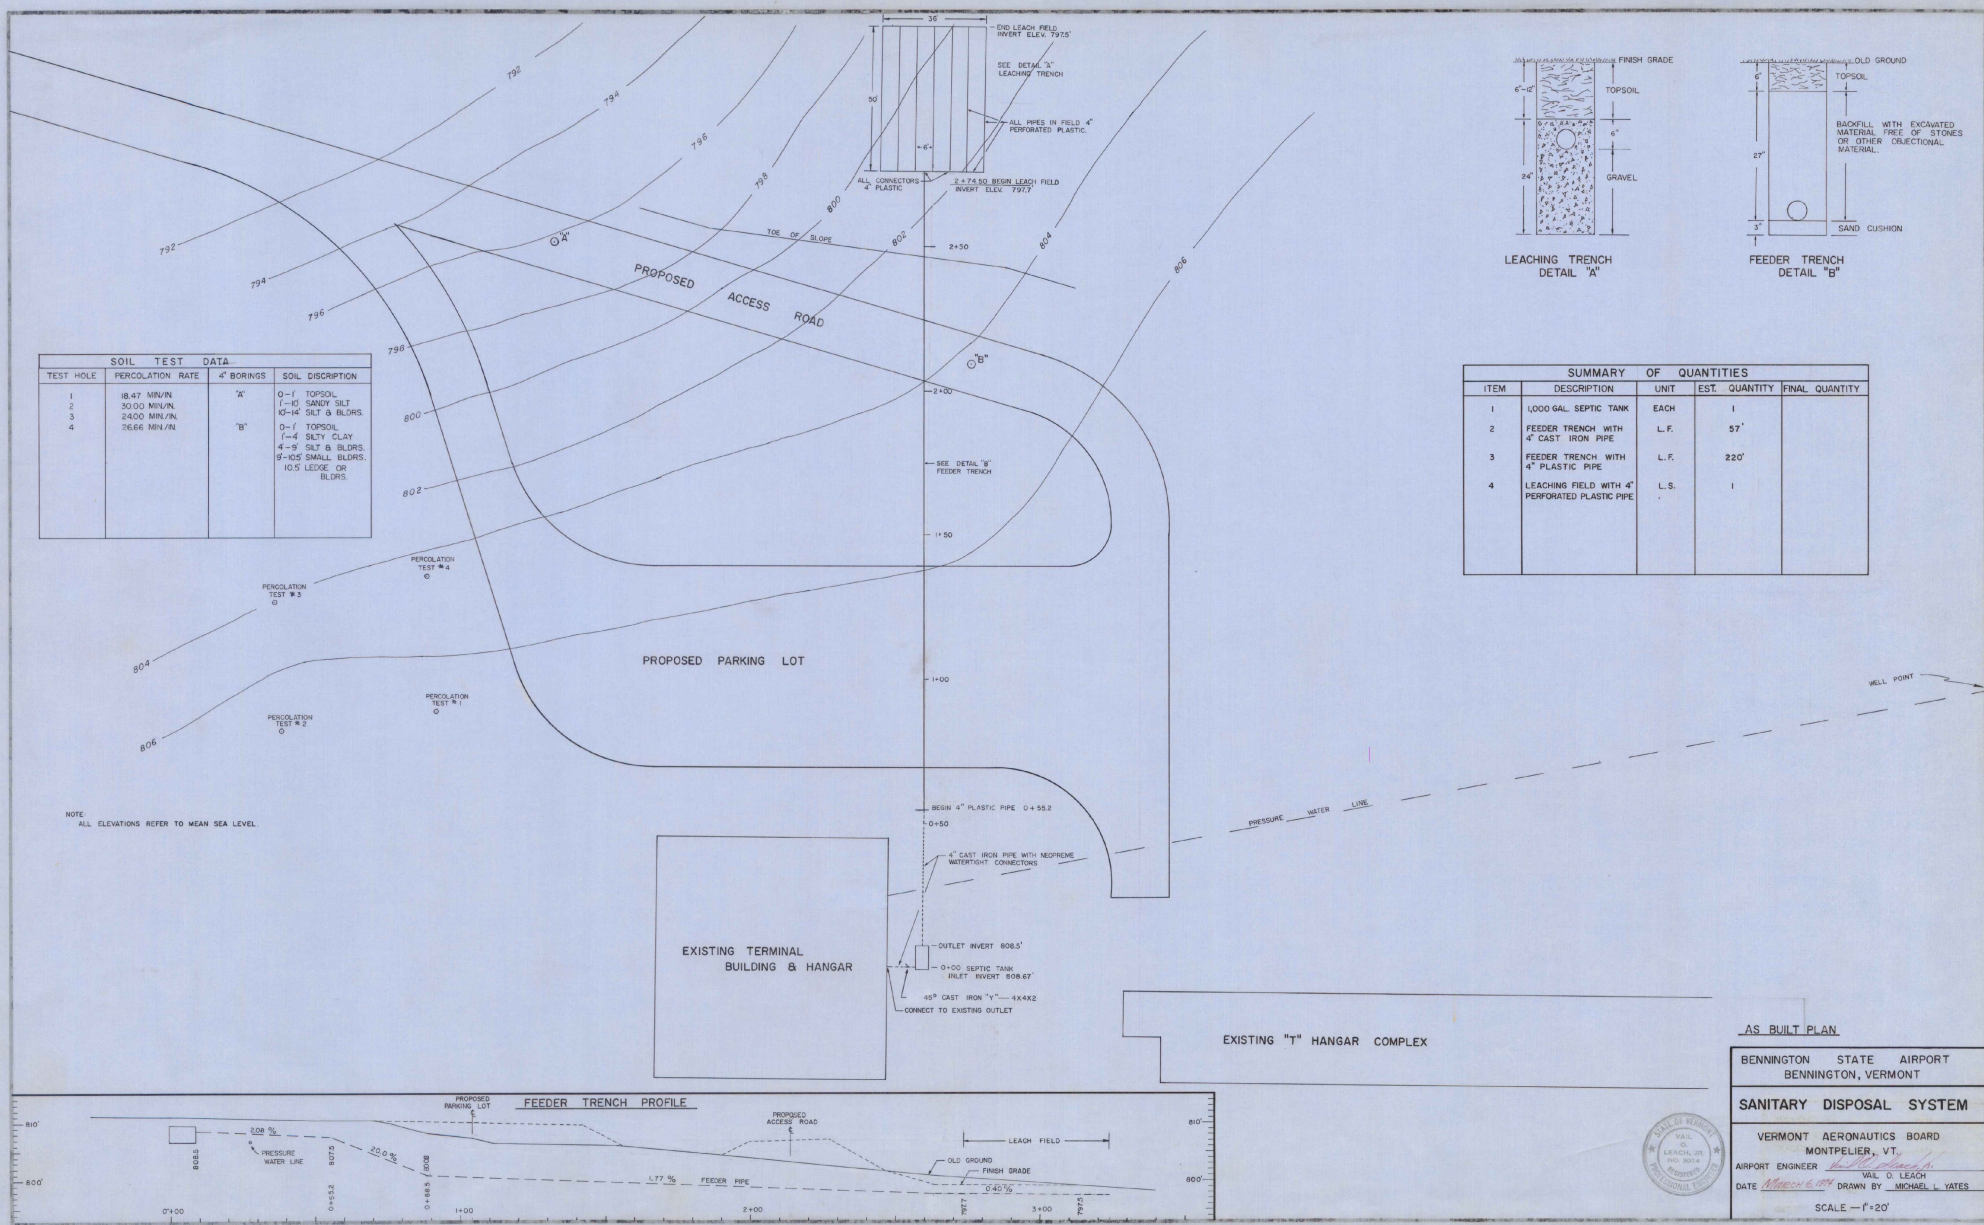

AS BUILT PLAN

BENNINGTON STATE AIRPORT
BENNINGTON, VERMONT





SANITARY DISPOSAL SYSTEM

VERMONT AERONAUTICS BOARD
MONTPELIER, VT.

AIRPORT ENGINEER: *W. D. Leach*
DATE: *March 6, 1971* DRAWN BY: *MICHAEL L. YATES*

SCALE - 1"=20'



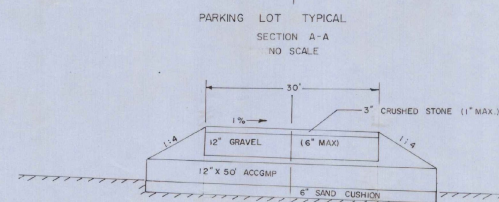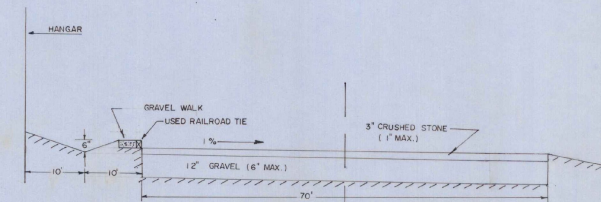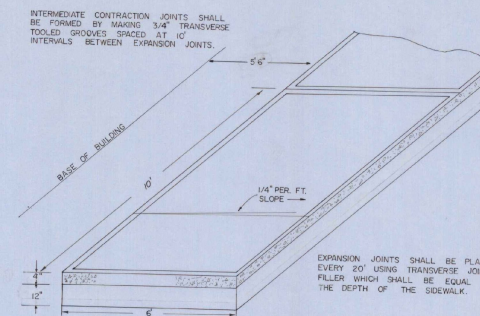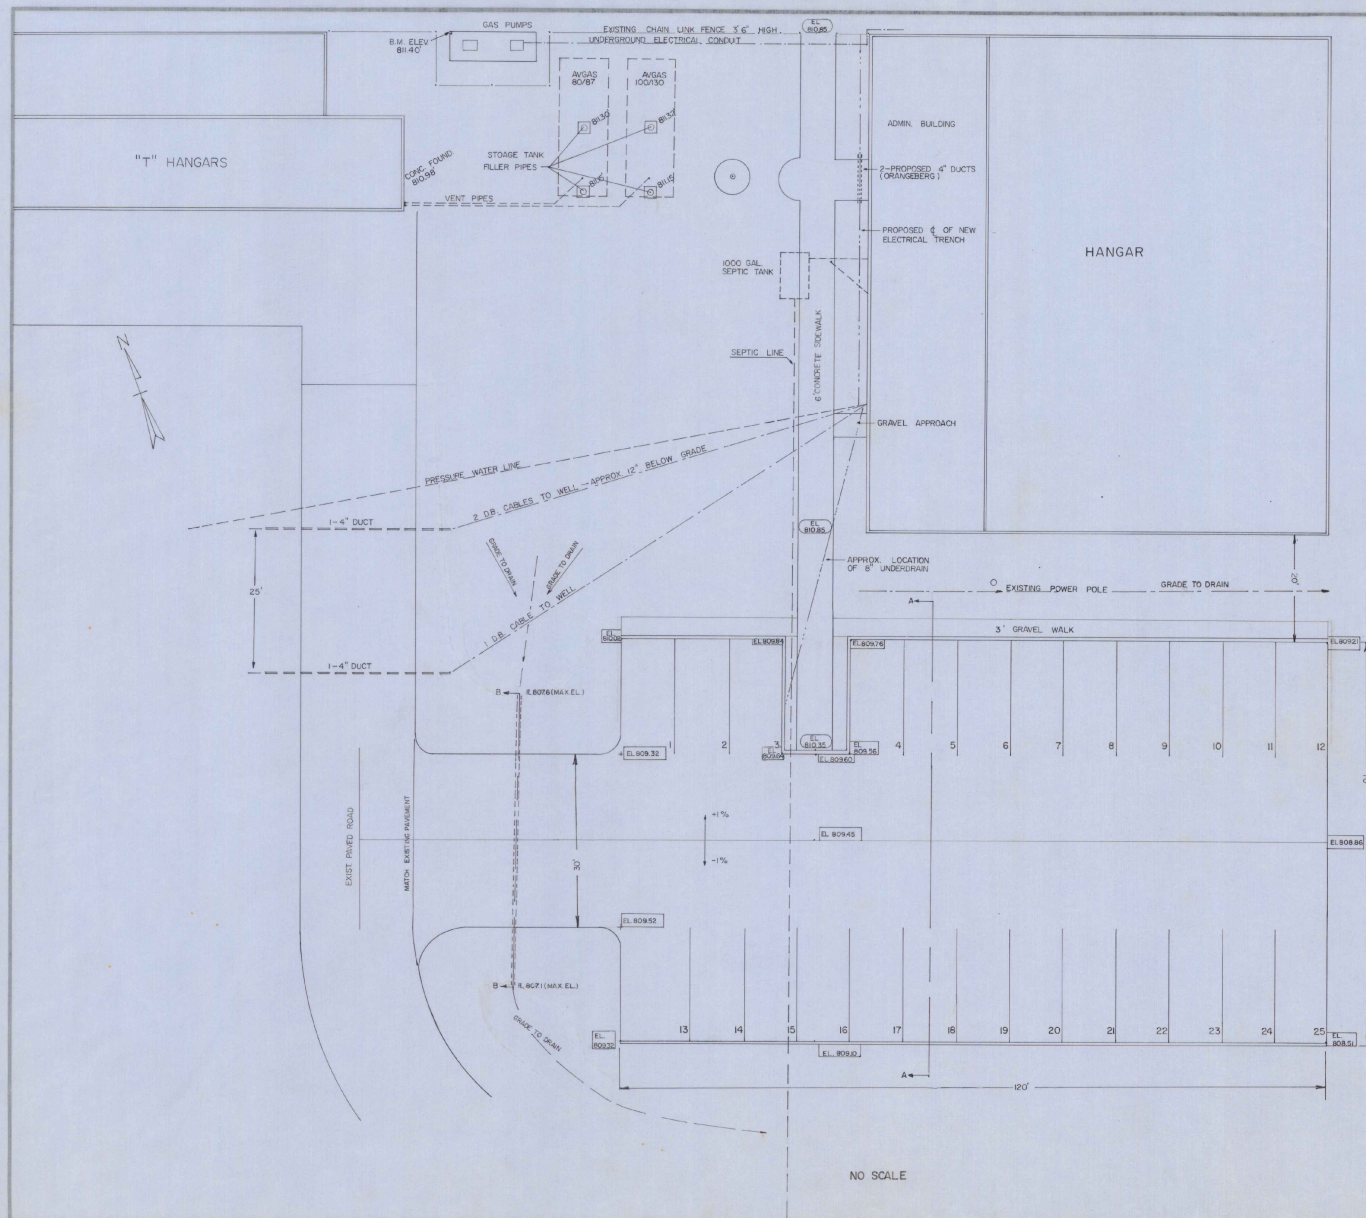

EL.809.43 PARKING LOT FINISH GRADE ELEVATION
EL.810.05 SIDEWALK FINISH GRADE ELEVATION

SECTION B-B
NO SCALE

BENNINGTON STATE AIRPORT
BENNINGTON, VERMONT
TERMINAL AREA
IMPROVEMENTS
VERMONT AERONAUTICS BOARD
APRIL, 1975



See book Q-108, Page 61, recorded
Aug. 19, 1948 in the town of Dennington
for description of easement.

Iron Pin - Not
found in 1st survey

SCALE 1" = 100'
100 0 50 100

BENNINGTON STATE AIRPORT
PROPOSED DEVELOPMENT AREA
VERMONT AERONAUTICS BOARD
G. SHEPARDSON, AIRPORT ENGR. 2/72

Curve #1	Curve #2	Curve #3	Curve #4	Curve #5
L 364'10.00"	L 73'21.90"	L 30'10.00"	L 73'21.90"	L 56'21.90"
D 10'10.00"	D 14'35.24"	D 14'35.24"	D 14'35.24"	D 49'56.32"
L 366.67'	L 64.15'	L 78.85'	L 63.91'	L 188.26'
E 578.94'	E 50.00'	E 50.00'	E 180.39'	E 180.39'
T 188.86'	T 37.31'	T 30.00'	T 37.00'	T 70.00'
PC 15+40.30	PC 22+58.96	PC 0+00.00	PC 1+98.55	PC 3+25.52
PT 17+16.37	PT 22+58.96	PT 0+78.85	PT 2+42.59	PT 4+45.01

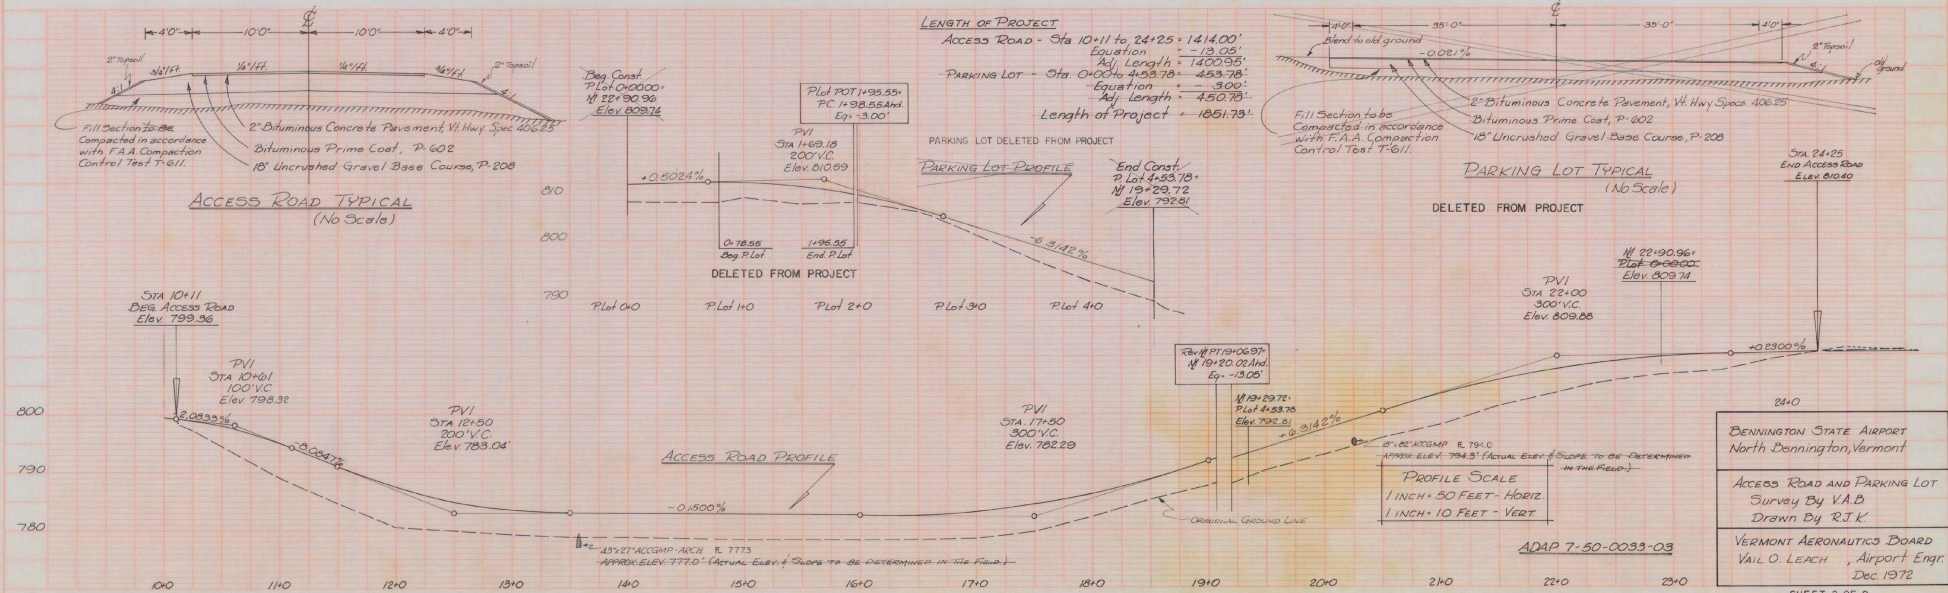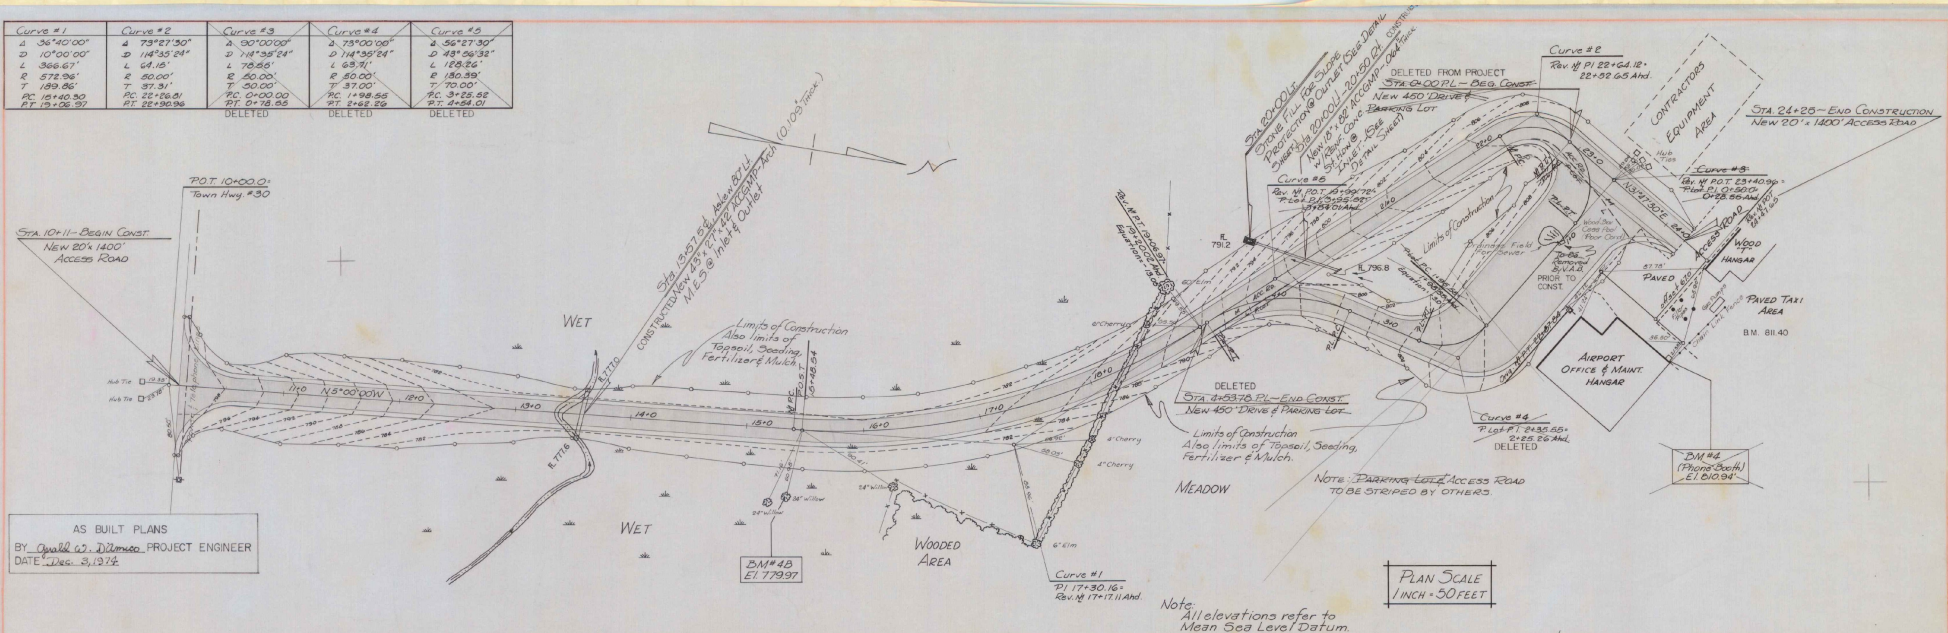

AS BUILT PLANS
 BY *G. D. Dames* PROJECT ENGINEER
 DATE *Dec. 3, 1974*



NOTE
 ALL ELEVATIONS REFER TO MEAN
 SEA LEVEL DATUM



ADAP 7-50-0035-03


BENNINGTON STATE
 AIRPORT

ACCESS ROAD AND PARKING
 DELETED LOT LOCATION


VERMONT AERONAUTICS BOARD

MONTPELIER, VERMONT


VILL. LOCH AIRPORT ENGINEER

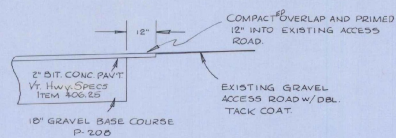


TYPICAL BUTT SECTION
(EXISTING ACCESS ROAD)

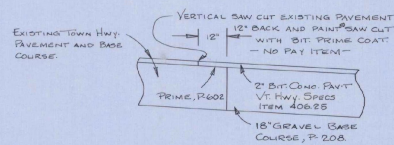

TYPICAL BUTT SECTION
(TOWN HWY. #30)

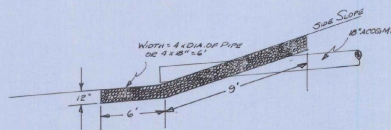


STONE FILL FOR SLOPE
PROTECTION @ 10' ACCOMP
OUTLET.
(NO SCALE.)

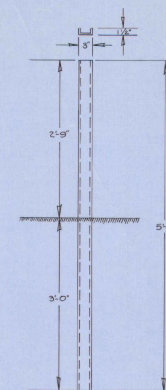

ALL STEEL MARKER POSTS TO
BE GALVANIZED.
STEEL MARKER POSTS TO BE
PLACED AS DIRECTED BY THE
ENGINEER.
POSTS ARE TO BE AMERICAN
STANDARD CHANNEL
5'-9" x 3" (4.1 LBS PER FT.)

STEEL MARKER POSTS

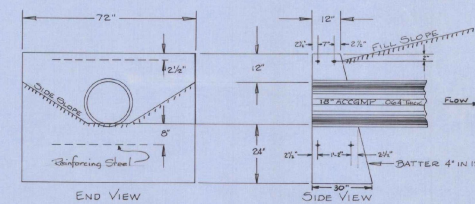

REINFORCED CONCRETE STRAIGHT HEADWALL
All reinforcing steel to be 1/2" dia. deformed bars.
(NO SCALE)

AS BUILT PLANS
BY *Charles D. D'Amico* PROJECT ENGINEER
DATE Dec. 3, 1979

ADAP 7-50-0033-03

BENNINGTON STATE AIRPORT
NORTH BENNINGTON, VERMONT

DETAIL SHEET


VERMONT AERONAUTICS BOARD
VAIL O. LEACH, AIRPORT ENGINEER
JAN. 74, RJK

STATE OF VERMONT
DEPARTMENT OF HIGHWAYS

FED ROAD DIVISION NO.	STATE	PROJECT NO.	FISCAL YEAR	SHEET NO.	TOTAL SHEET
1	VT.		POST		

[illegible]

AS BUILT PLANS
 BY Opal W. D'Amico PROJECT ENGINEER
 DATE Dec. 8, 1974

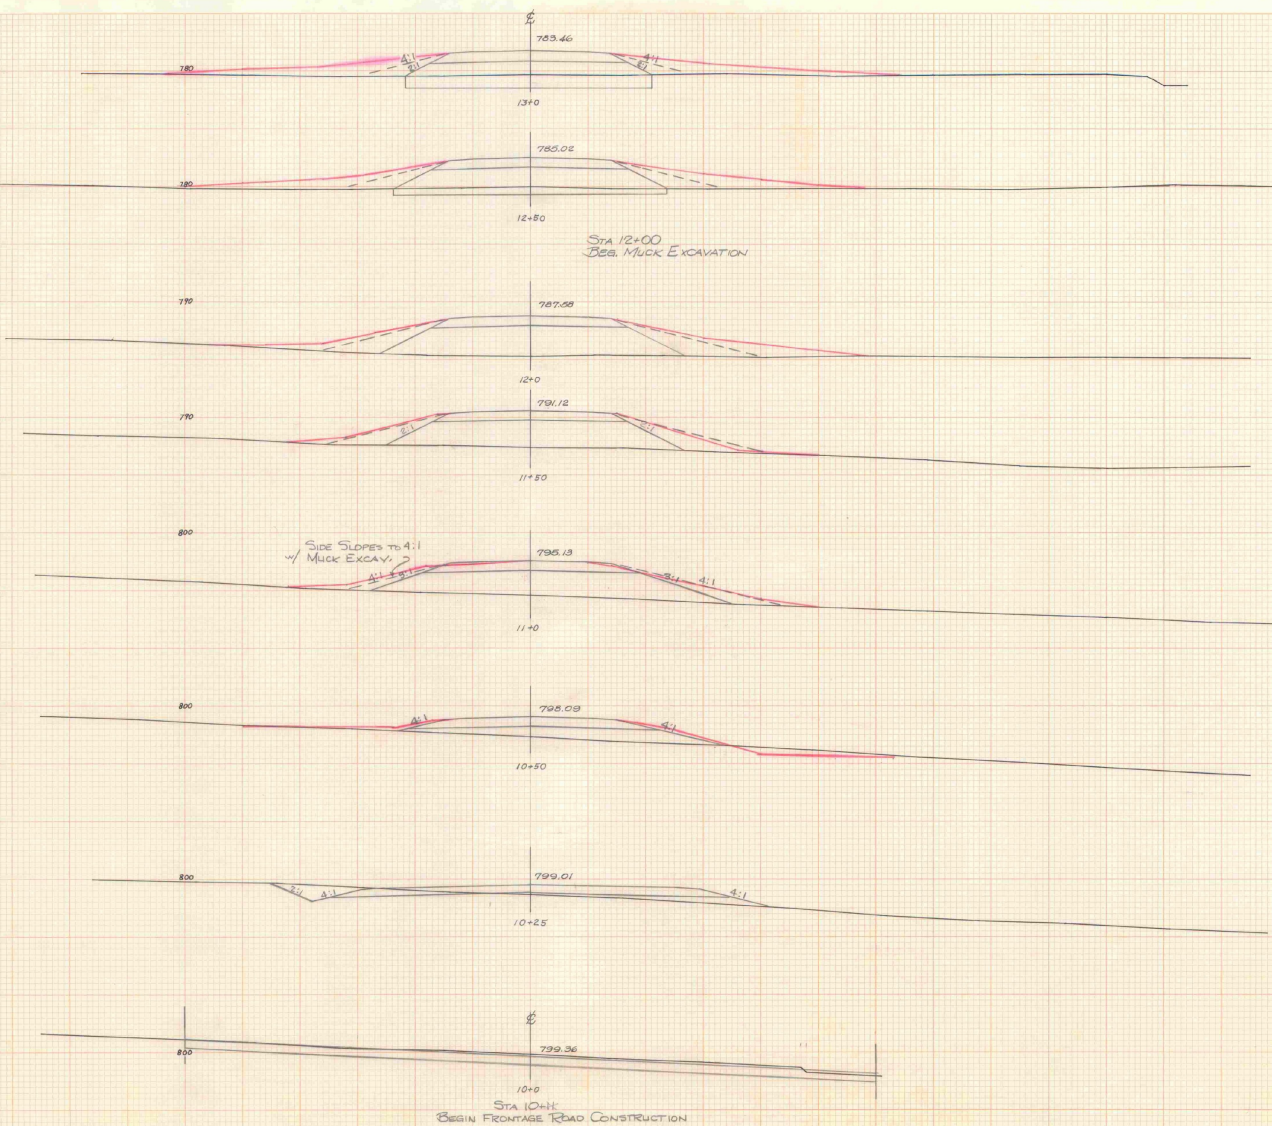

STA 10+0
 BEGIN FRONTAGE ROAD CONSTRUCTION

ADAP 7-50-0033-03
 BENNINGTON STATE AIRPORT
 FRONTAGE ROAD 10+00-13+00
 CROSS SECTIONS
 SCALE 1"=10' VERT.
 " " " HORIZ.
 VERMONT AERONAUTICS BOARD
 V.O. LEACH, AIRPORT ENGR.
 4-74 RPK


AS BUILT PLANS
 BY Opelle & Darnes PROJECT ENGINEER
 DATE Dec. 8, 1974

FOR THE USE OF THE
 CONTRACTOR IN CONSTRUCTION



FOR THE USE OF THE
 CONTRACTOR IN CONSTRUCTION

FOR THE USE OF THE
 CONTRACTOR IN CONSTRUCTION

FOR THE USE OF THE
 CONTRACTOR IN CONSTRUCTION

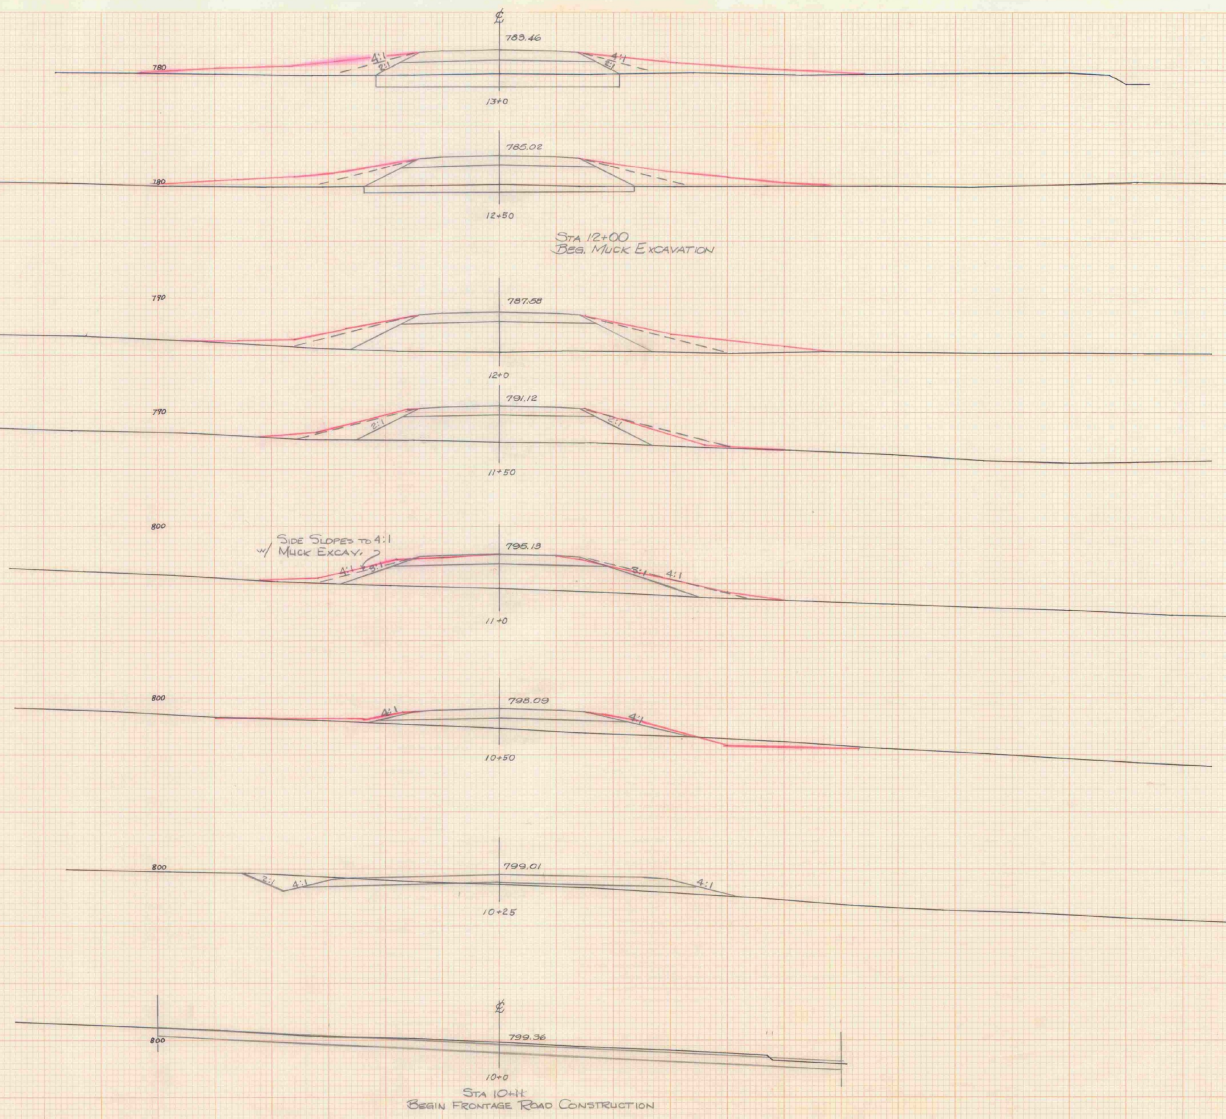

ADAP 7-50-0033-03
 BENNINGTON STATE AIRPORT
 FRONTAGE ROAD 10+00-13+00
 CROSS SECTIONS
 SCALE 1" = 10' VERT.
 " " HORIZ.
 VERMONT AERONAUTICS BOARD
 V.O. LEACH, AIRPORT ENGINEER
 4-74 RTR

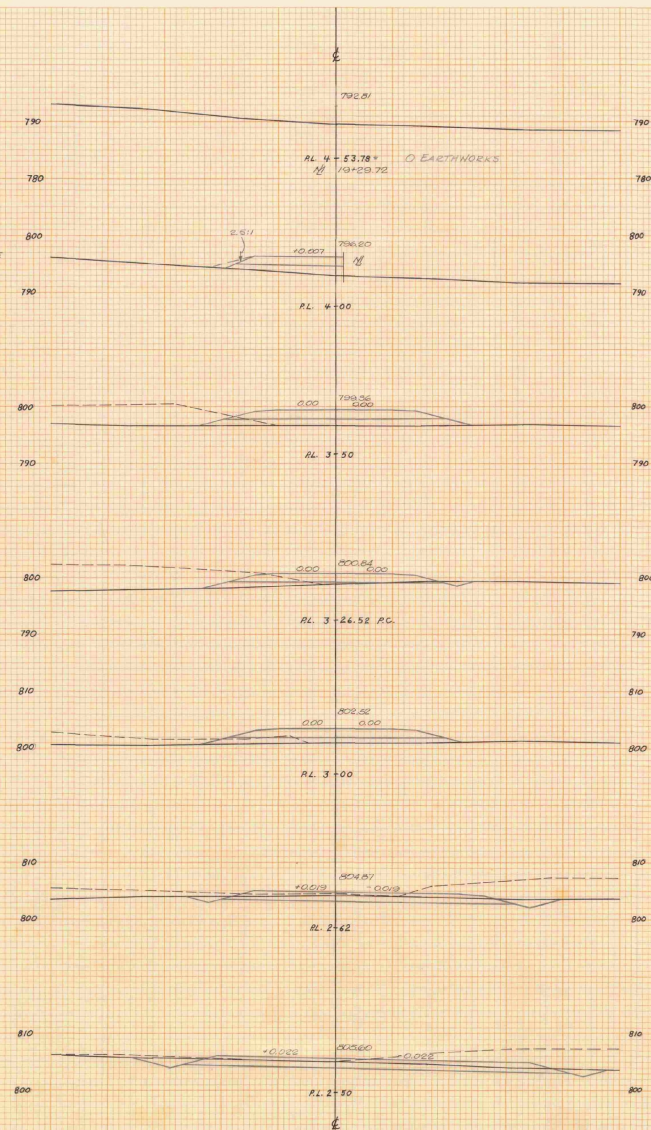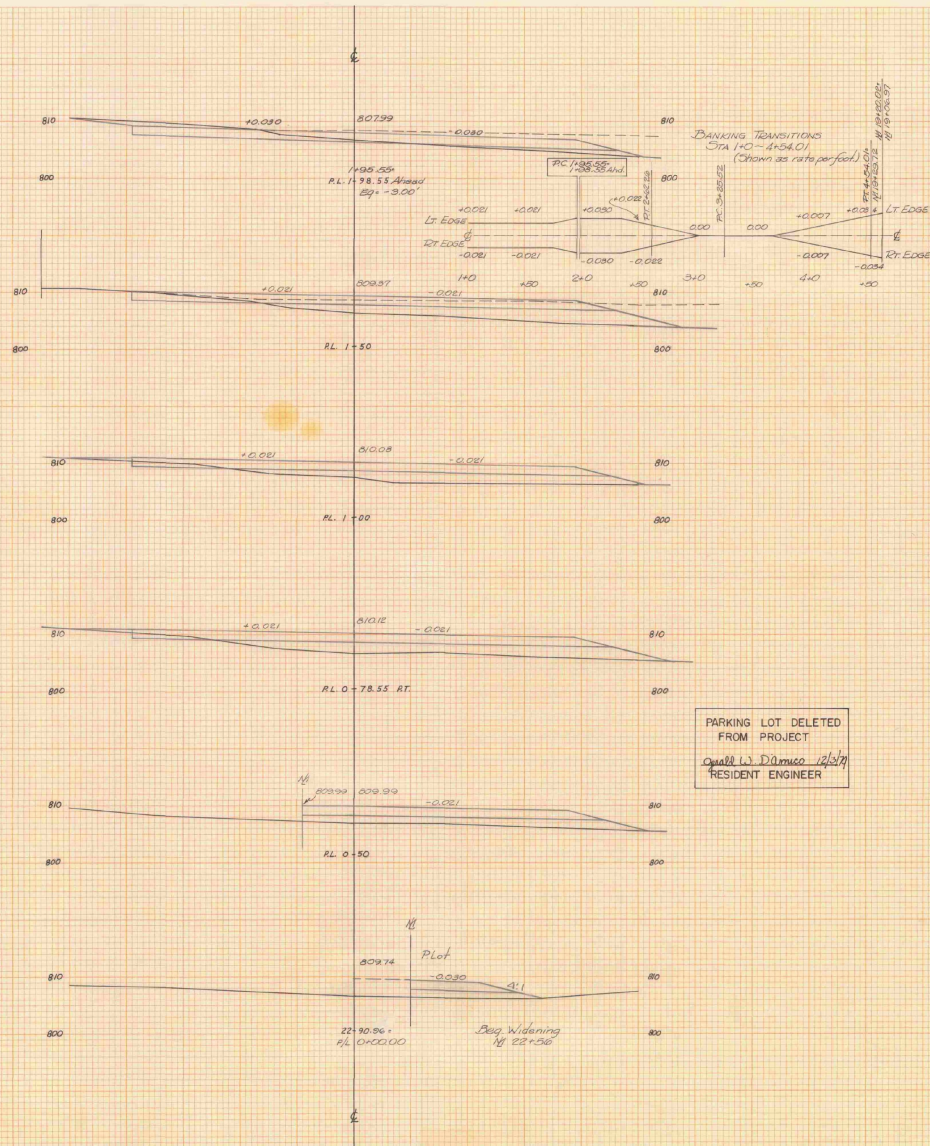

LEGEND
 - Old Ground
 - Waste Material Deposited From Prior Construction

ADAP 7-50-0033-03
 BENNINGTON STATE AIRPORT
 BENNINGTON, VERMONT
 PARKING LOT X-SECTIONS
 SCALE: 1" = 10' VERT.
 " " = 1' HORIZ.
 VERMONT AERONAUTICS BOARD
 V.O. LEACH, AIRPORT ENGR
 4-74, RTK