



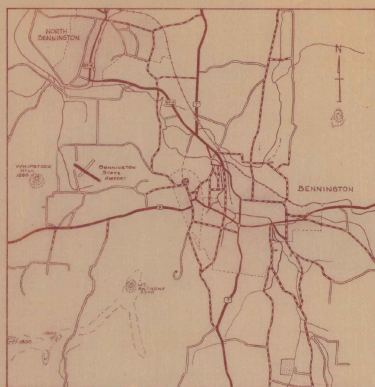

LOCATION MAP

BENNINGTON STATE AIRPORT BENNINGTON, VERMONT

TAXIWAY CONSTRUCTION

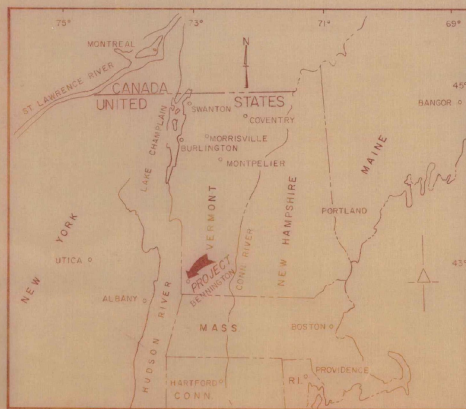

VICINITY MAP

INDEX OF SHEETS	
PAGE	DESCRIPTION
1	TITLE SHEET
2	PROPOSED TAXIWAY LOCATION
3	DETAILS OF TAXIWAY CONSTRUCTION
4	TAXIWAY CROSS-SECTIONS

MARCH, 1973

U.S. DEPARTMENT OF TRANSPORTATION
FEDERAL AVIATION ADMINISTRATION

APPROVED: _____ DATE: _____
CHIEF, AIRPORTS BRANCH
AIRPORTS DIVISION

BENNINGTON STATE AIRPORT
BENNINGTON, VERMONT
VERMONT AERONAUTICS BOARD
APPROVED: _____ DATE: _____
COMMISSIONER
APPROVED: _____ DATE: _____
AIRPORT ENGR

PREPARED BY
VERMONT AERONAUTICS BOARD
MONTPELIER, VERMONT
G.H. SHEPARDSON - ENGR.
DATE: SEPT. 1972

ESTIMATED QUANTITIES OF MAJOR ITEMS

TAXIWAY CONSTRUCTION	ESTIMATED QUANTITIES	FINAL QUANTITIES
II-1 UNCLASSIFIED EXCAVATION AND EMBANKMENT	1800 C.Y.	1801 C.Y.
II-2 SUBBASE COURSE	600 C.Y.	700 C.Y.
II-3 CRUSHED AGGREGATE BASE COURSE	350 C.Y.	232 C.Y.
II-4 BITUMINOUS SURFACE COURSE	220 TON	236 TONS
II-5 BITUMINOUS PRIME COAT	100 GAL	1000 GAL.
II-6 SEEDING, LIMING, FERTILIZING	20 NSF	DELETED
II-7 MULCH	2222 SF	DELETED
II-8 TWO-WAY ELECTRICAL DUCT	176 L.F.	168 L.F.

AS BUILT PLANS

I HEREBY CERTIFY THAT ALL CONSTRUCTION REQUIRED BY THIS SET OF DRAWINGS HAS BEEN ACCOMPLISHED AS INDICATED HEREIN.
BY: _____ PROJECT ENGR.
DATE: 10/2/73

