




UPPER CHORD:

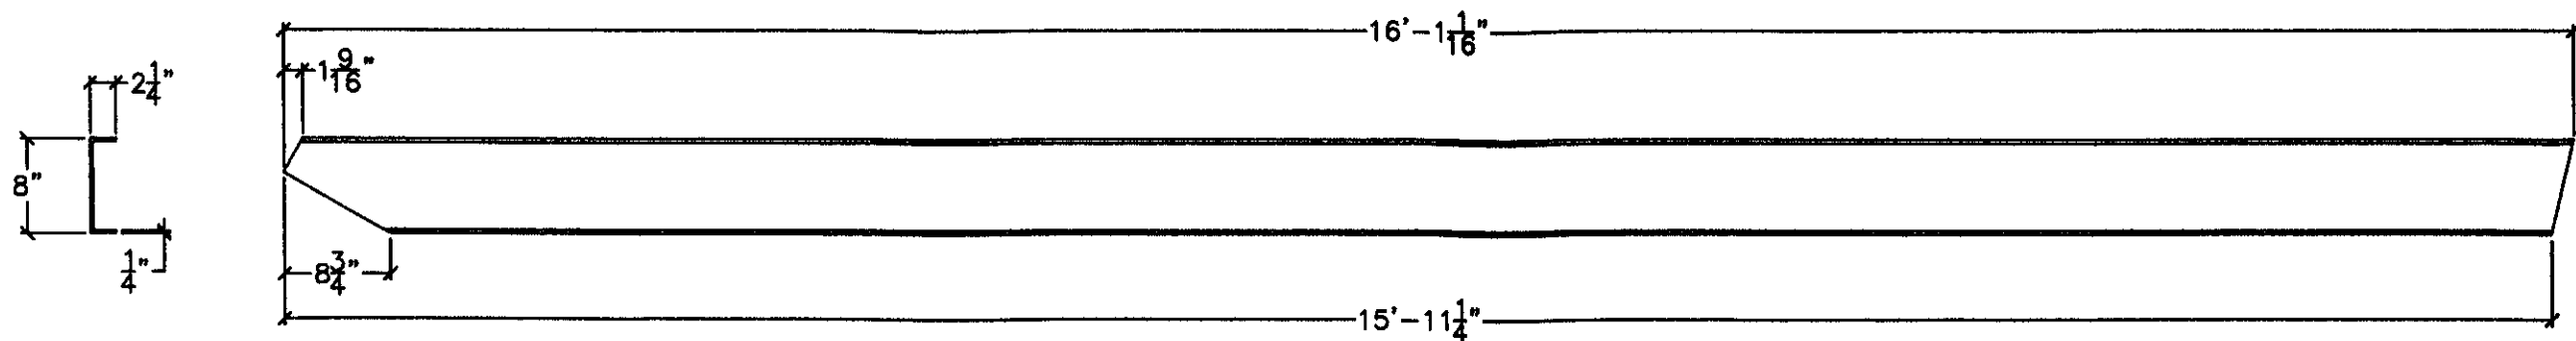

2L8U7-CHANNEL
1-1/2" = 1'-0"

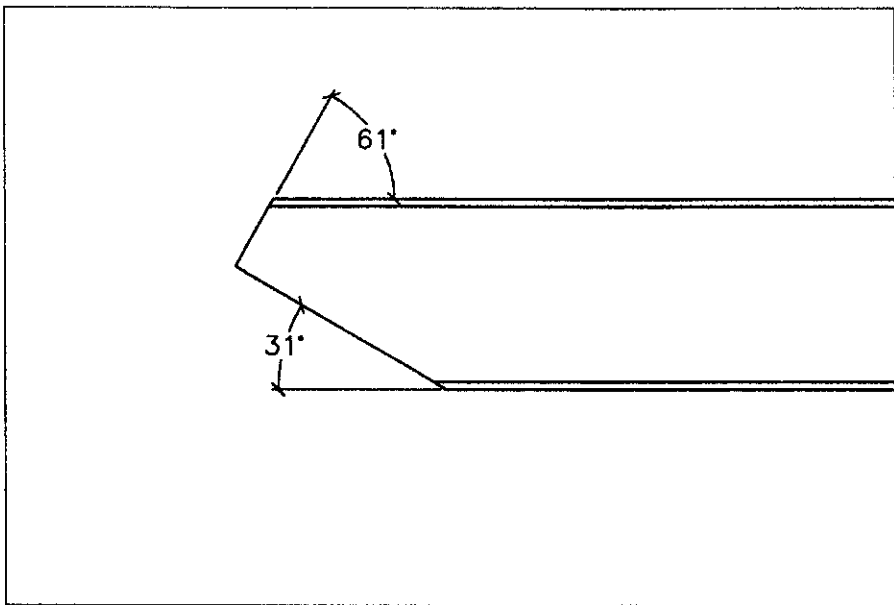

2L8U7-END DETAIL
3" = 1'-0"

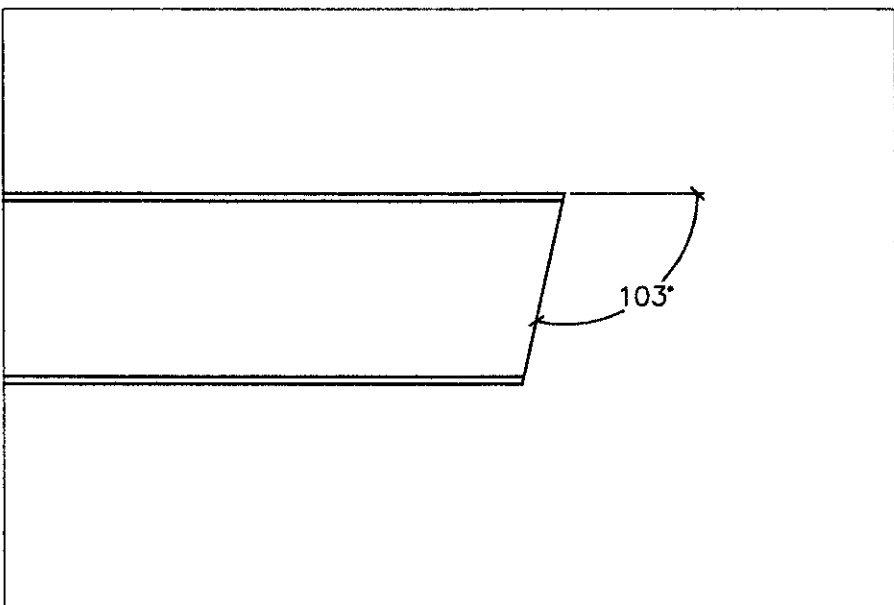

2L8U7-END DETAIL
3" = 1'-0"

RECEIVED
OK'D BY CHB OK'D BY _____
MAY 11 2009
BY WY DATE 5/11/09
APPROVED AS
DATE 5/11/09

FILE	Wallingford Bridge Rehab	Renard Bros. Construction
LOCATION	Wallingford, VT	Renard Bros. Construction
DRAWING TITLE	Drawings Truss Type 2 Drawings	Renard Bros. Construction
DRAWN BY	JED	Renard Bros. Construction
CHECKED BY	JED/AD	Renard Bros. Construction
DATE	4 30 09	Renard Bros. Construction
JOB CONTACT	Erick Foster State of VT	Renard Bros. Construction
DATE	4 30 09	Renard Bros. Construction
DRAWING NO.	T-2	Renard Bros. Construction
SHEET NO.	5 OF 18	Renard Bros. Construction