
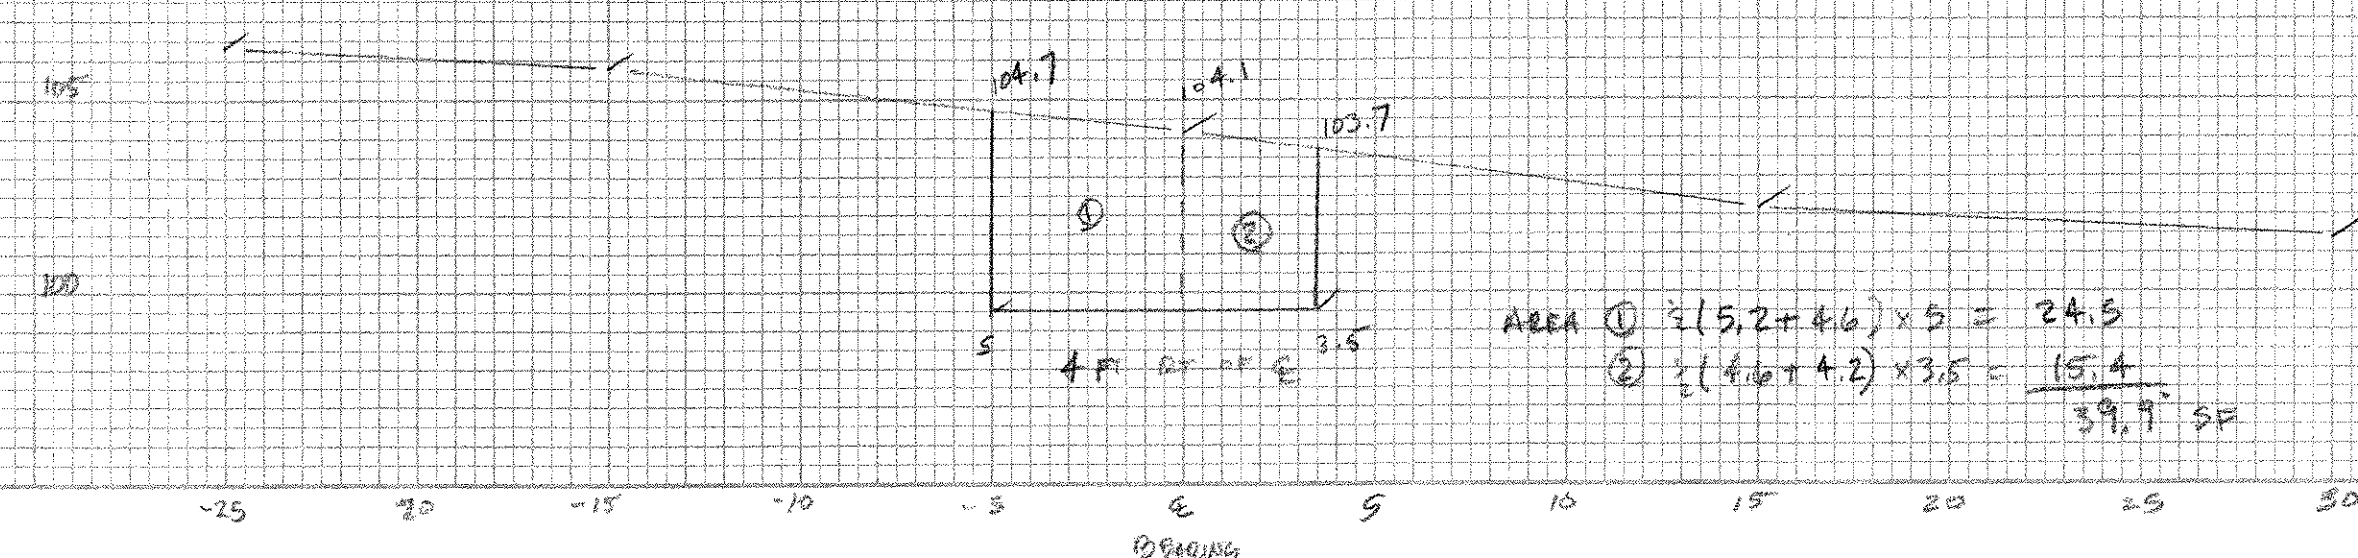
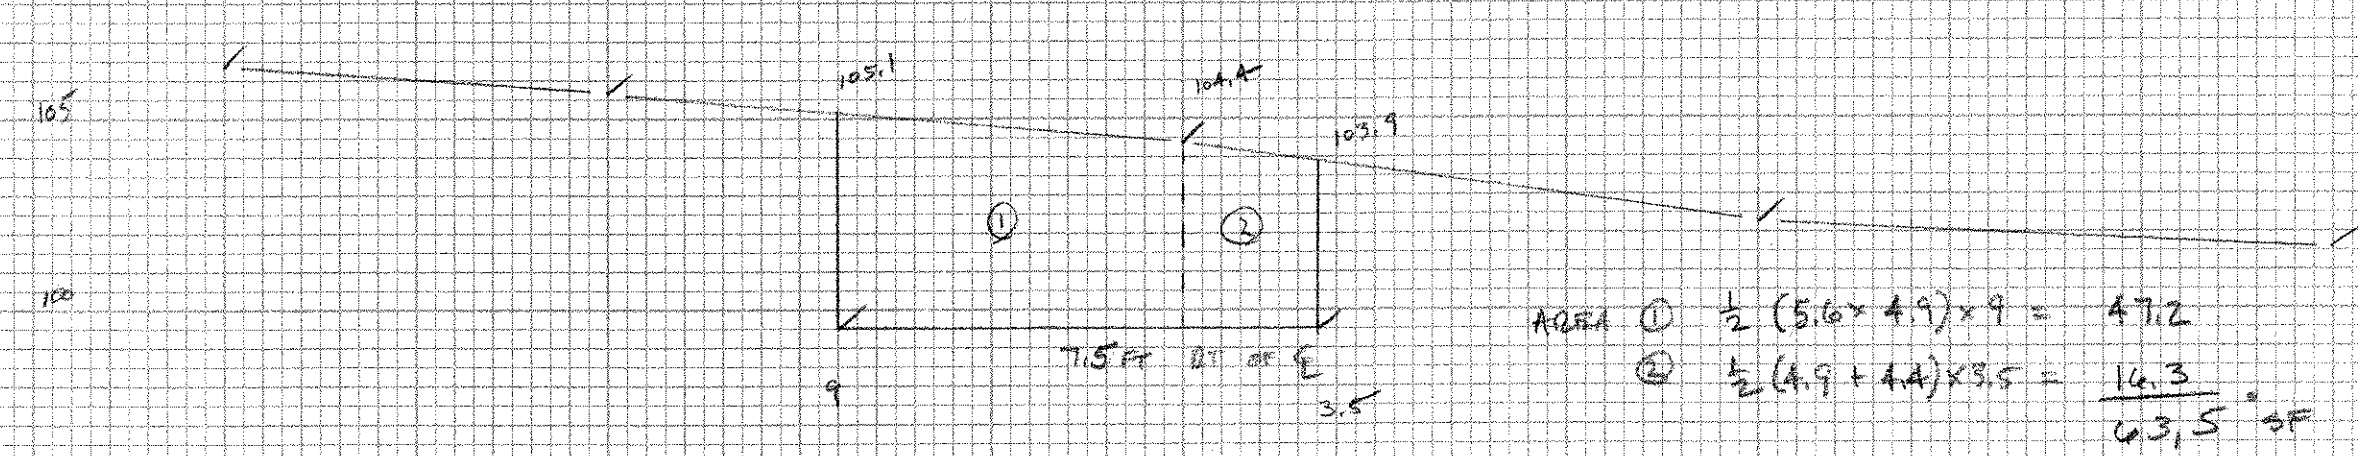
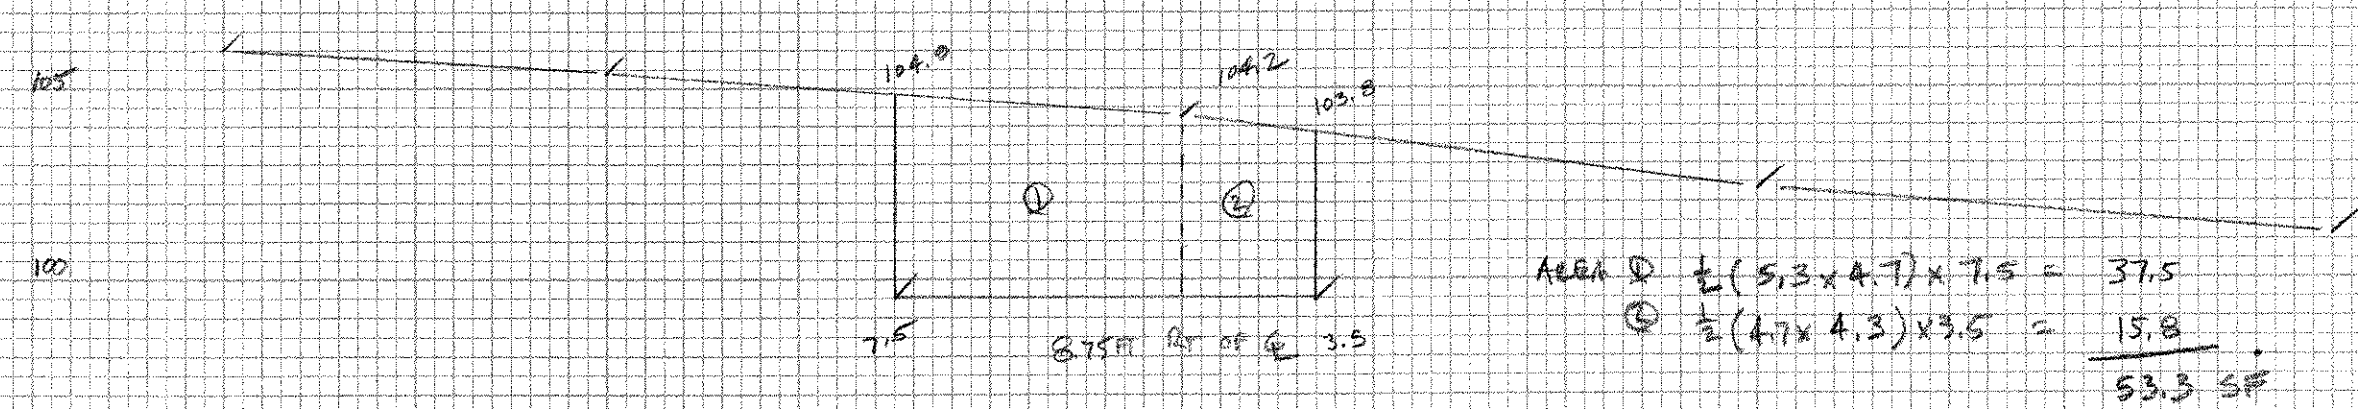
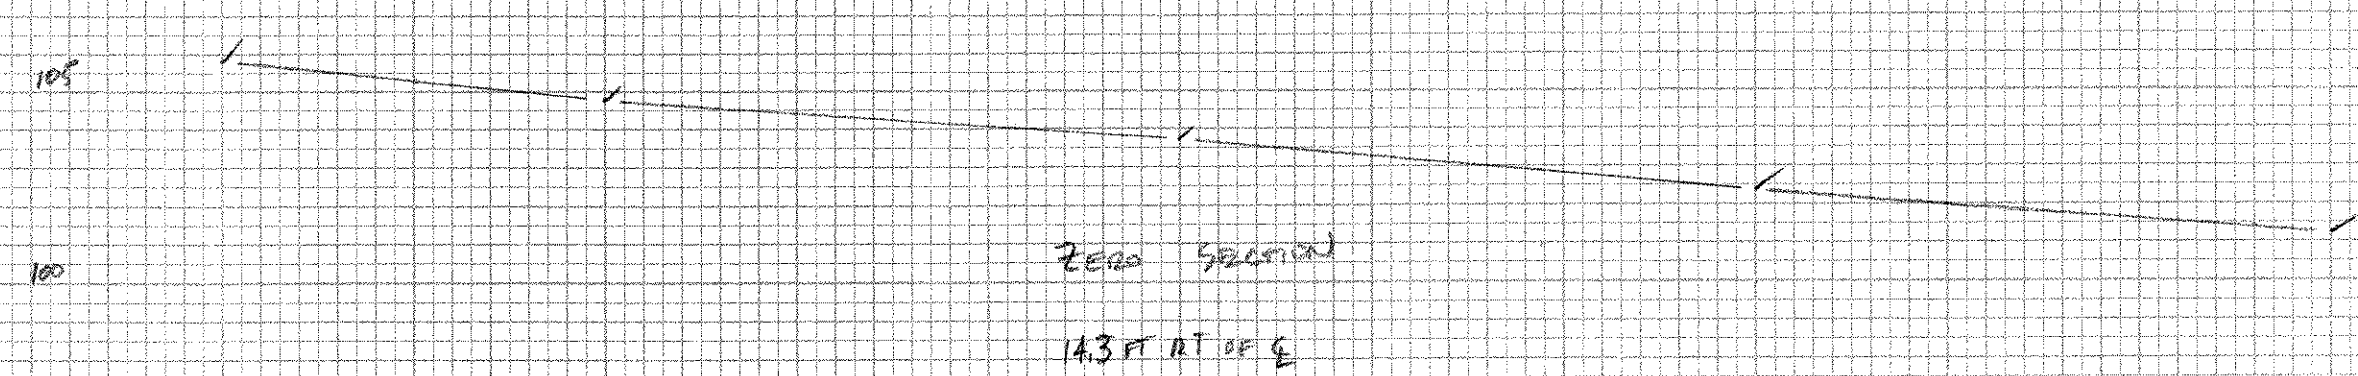
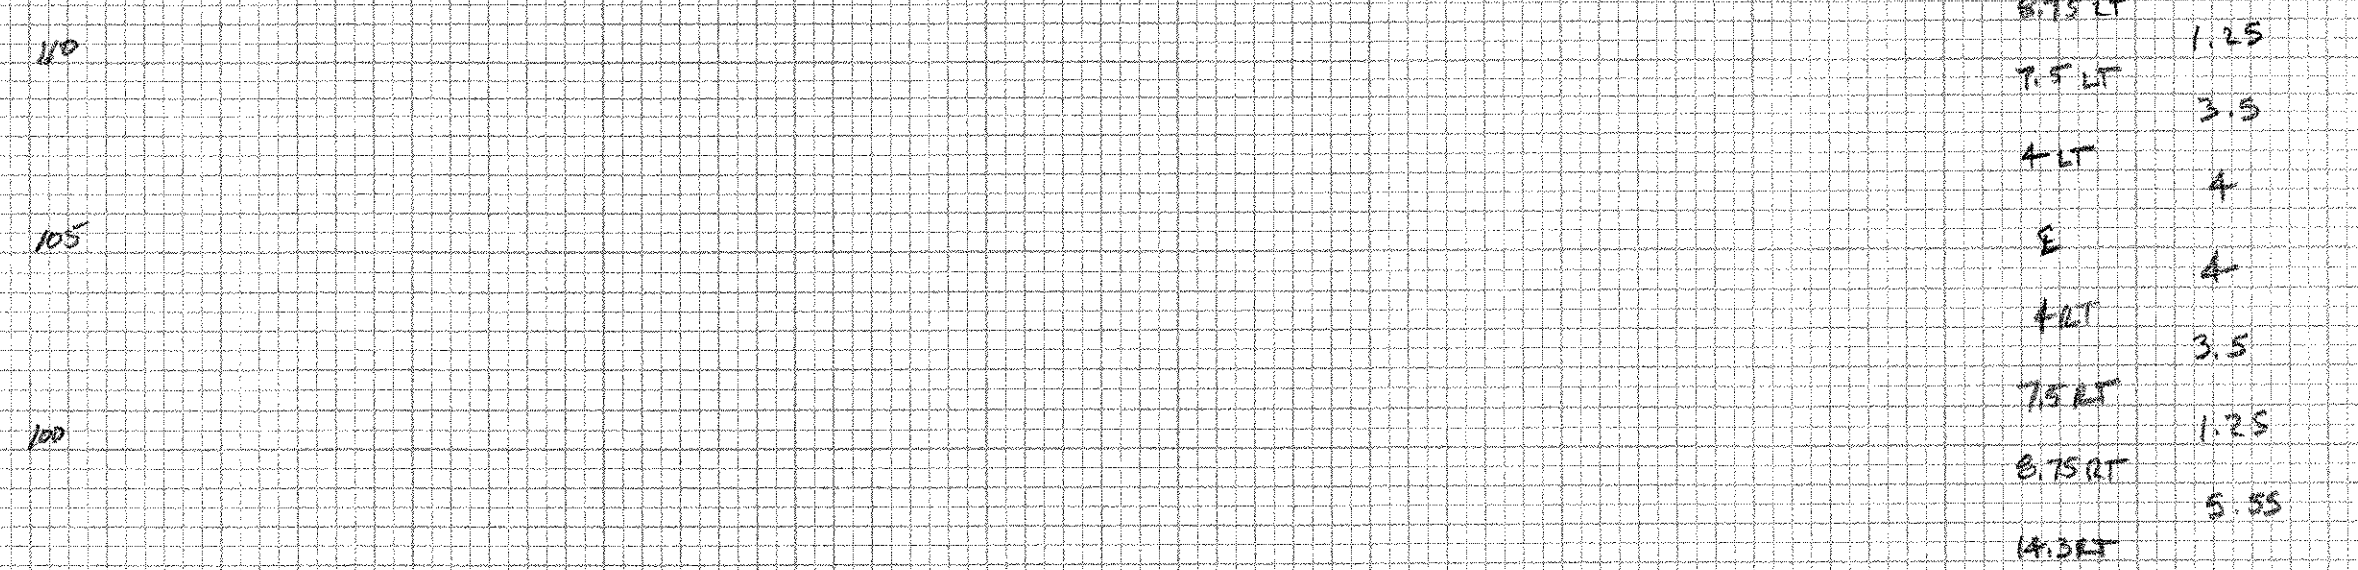
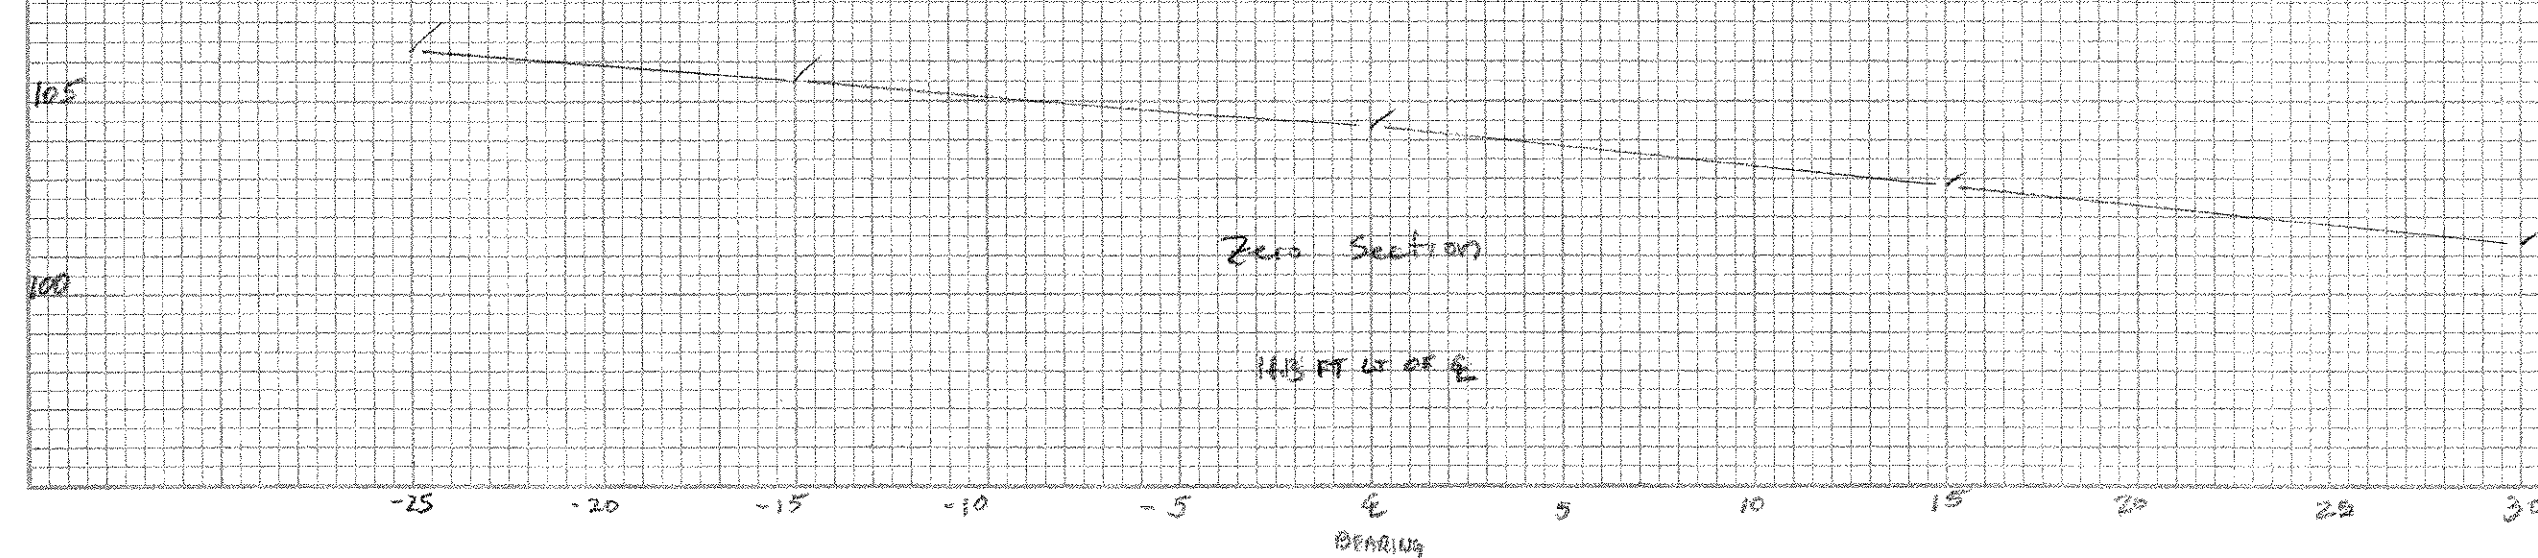
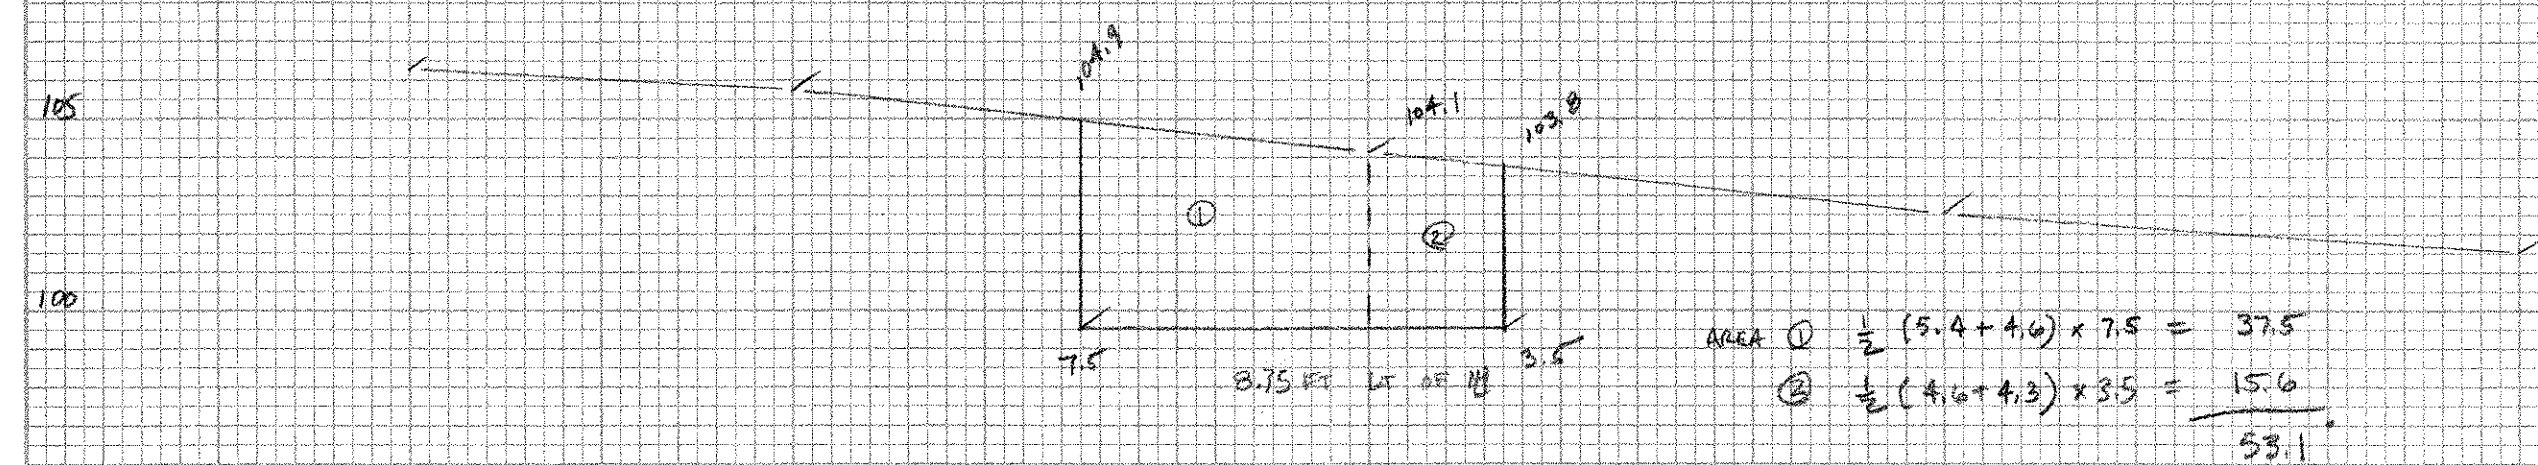
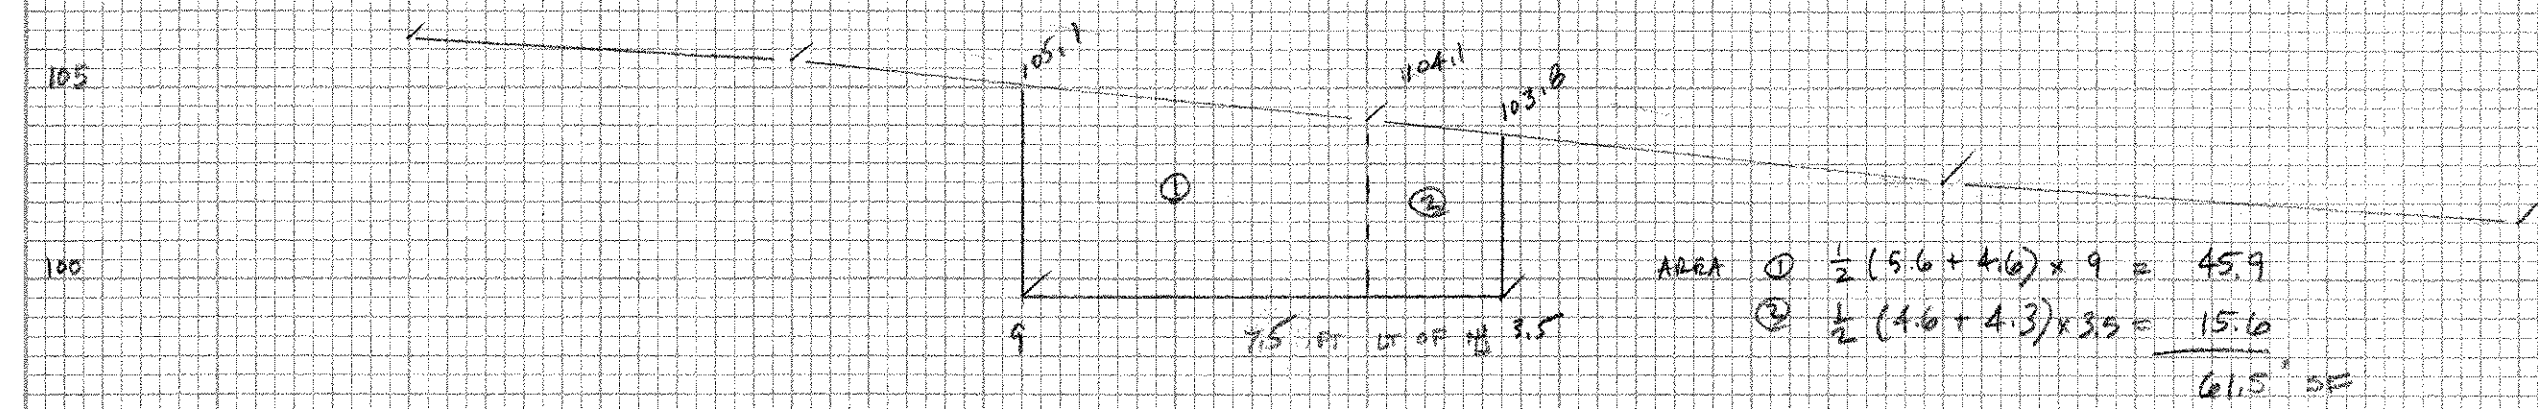
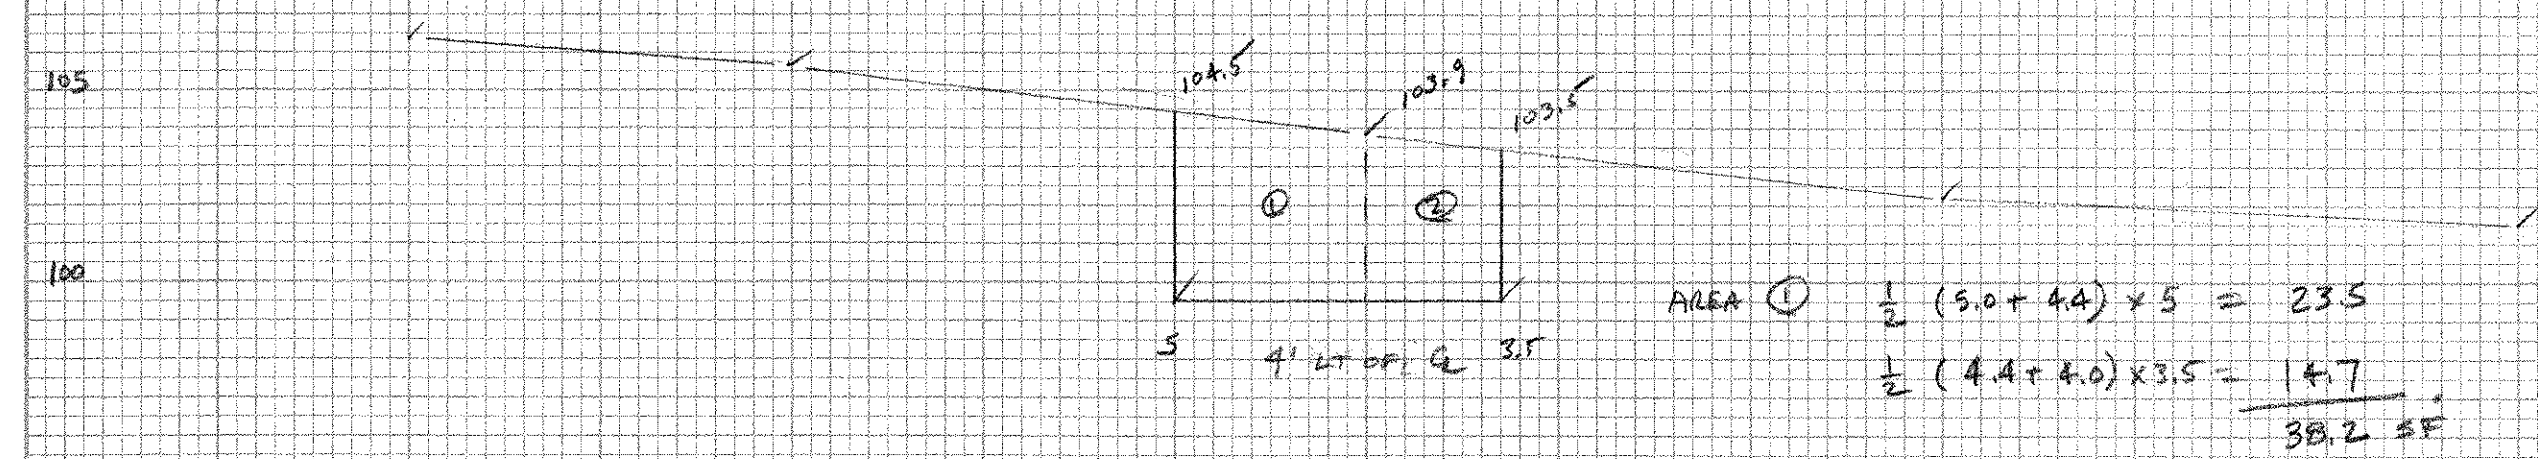


| NO. | DATE    | BY | CHKD. | APP'D. |
|-----|---------|----|-------|--------|
| 101 | 10/1/01 | BA |       |        |
| 102 | 10/1/01 | BA |       |        |
| 103 | 10/1/01 | BA |       |        |
| NO. | DATE    | BY | CHKD. | APP'D. |
|-----|---------|----|-------|--------|
| 101 | 10/1/01 | BA |       |        |
| 102 | 10/1/01 | BA |       |        |
| 103 | 10/1/01 | BA |       |        |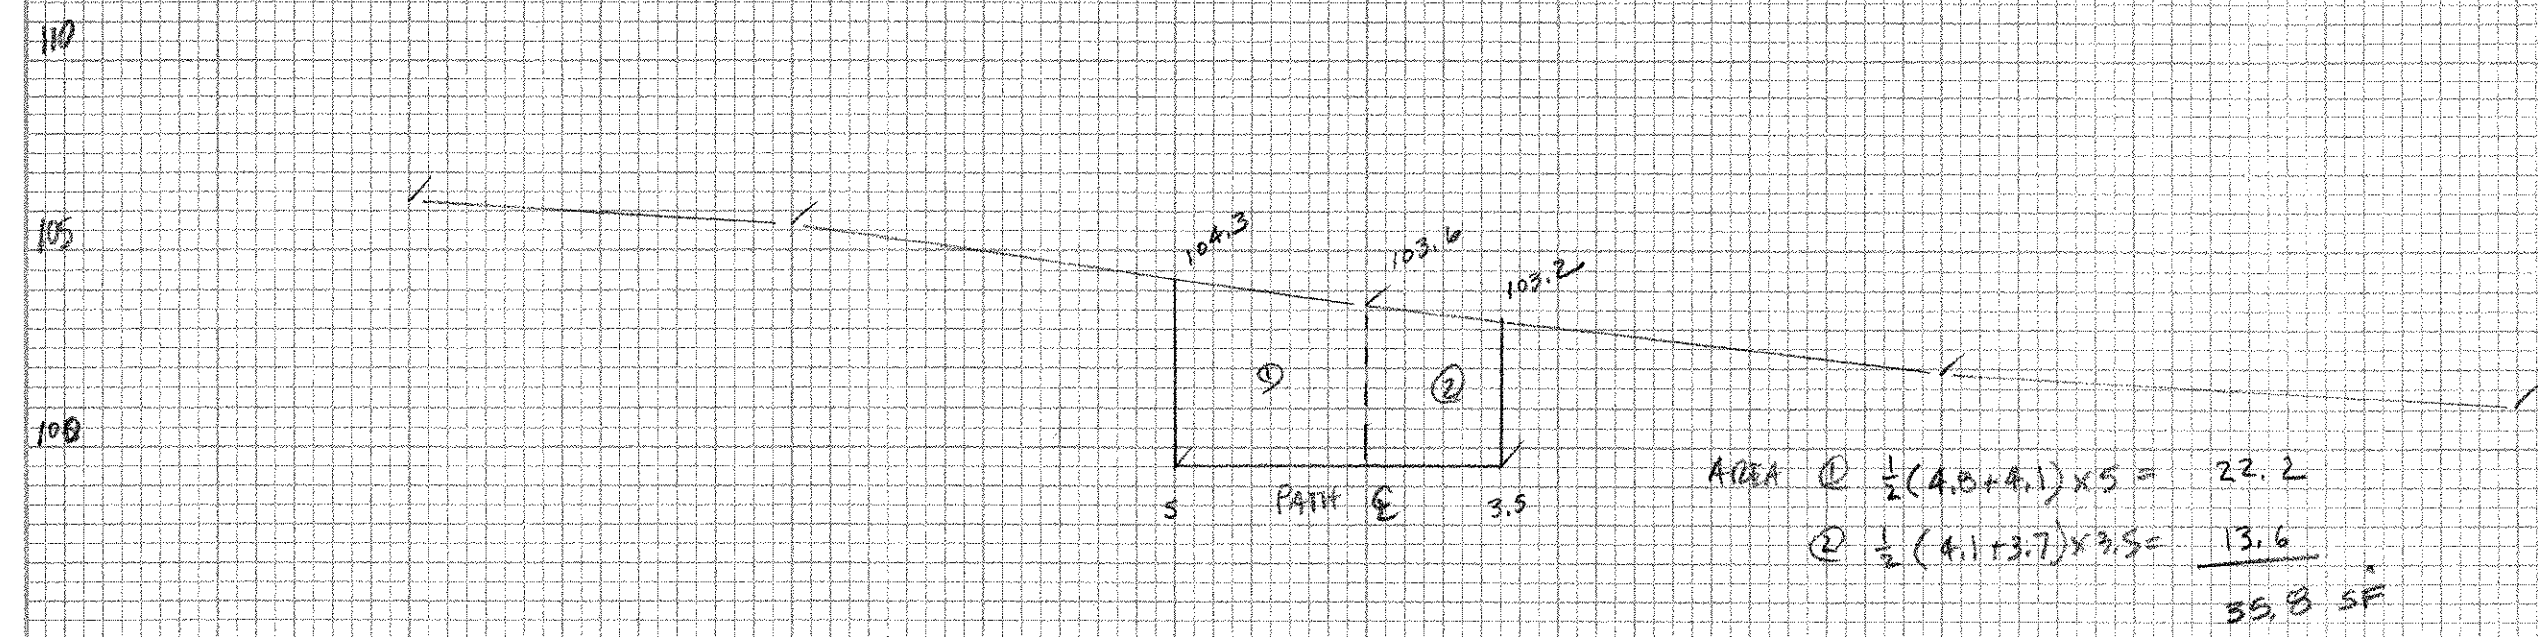
| POSITION | Dist | AREA, SF | AVERAGE AREA, SF | VOLUME, CF |
|----------|------|----------|------------------|------------|
| 19.2 LT  | 5.55 | 0        | 26.55            | 147.4      |
| 8.75 LT  | 1.25 | 93.1     | 57.3             | 71.6       |
| 7.5 LT   | 3.5  | 61.8     | 49.85            | 174.5      |
| 4 LT     | 4    | 38.6     | 37.0             | 148.0      |
| E        | 4    | 35.8     | 37.85            | 151.4      |
| 4 RT     | 3.5  | 39.9     | 51.7             | 180.0      |
| 7.5 RT   | 1.25 | 69.5     | 58.4             | 73.0       |
| 8.75 RT  | 5.55 | 53.3     | 26.65            | 147.9      |
| 14.3 RT  |      | 0        |                  |            |

$1094.8 \text{ CF} + 27 = 1121.8 \text{ CF}$   
 $1121.8 \text{ CF} \div 27 = 41.5 \text{ CY}$   
 $1121.8 \text{ CF} \div 27 = 41.5 \text{ CY}$