



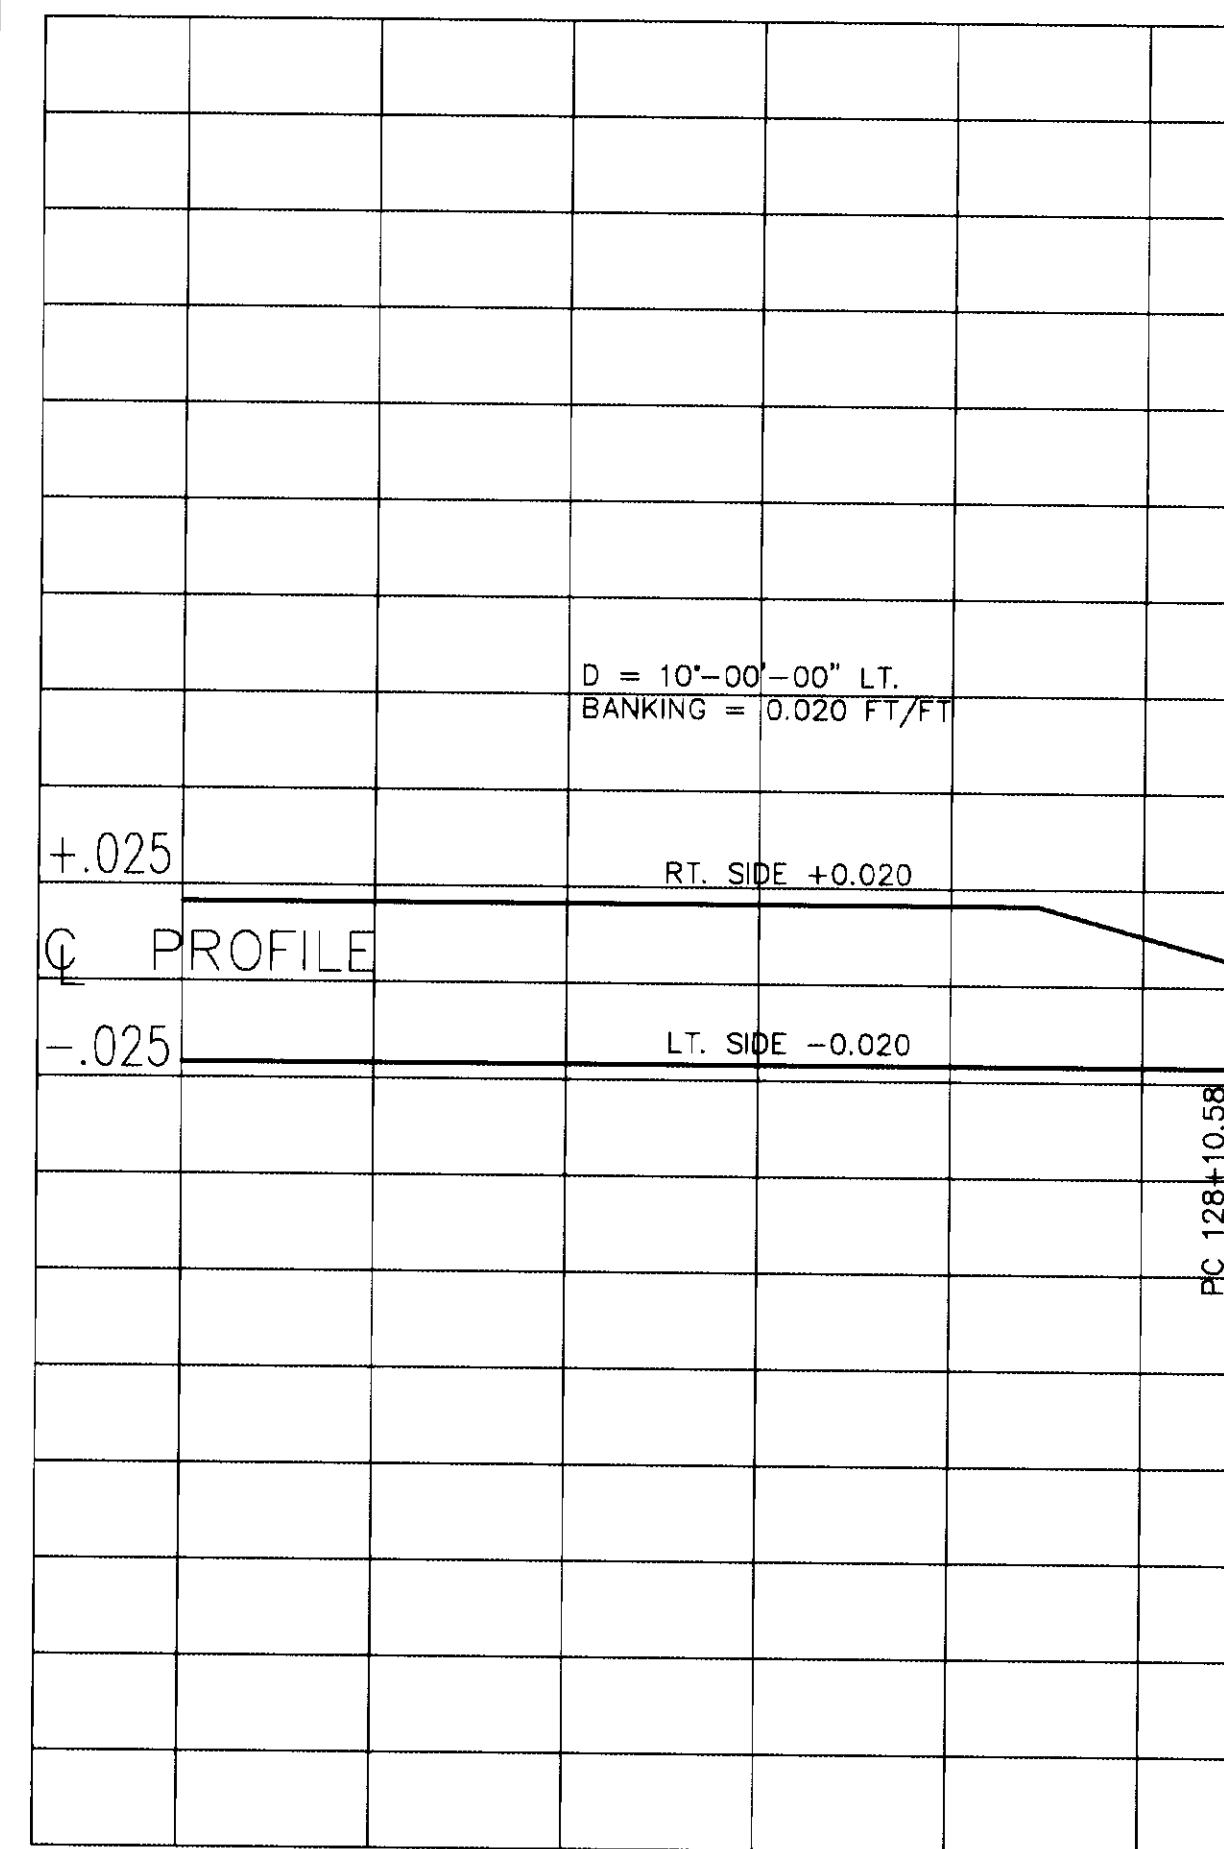

129+00

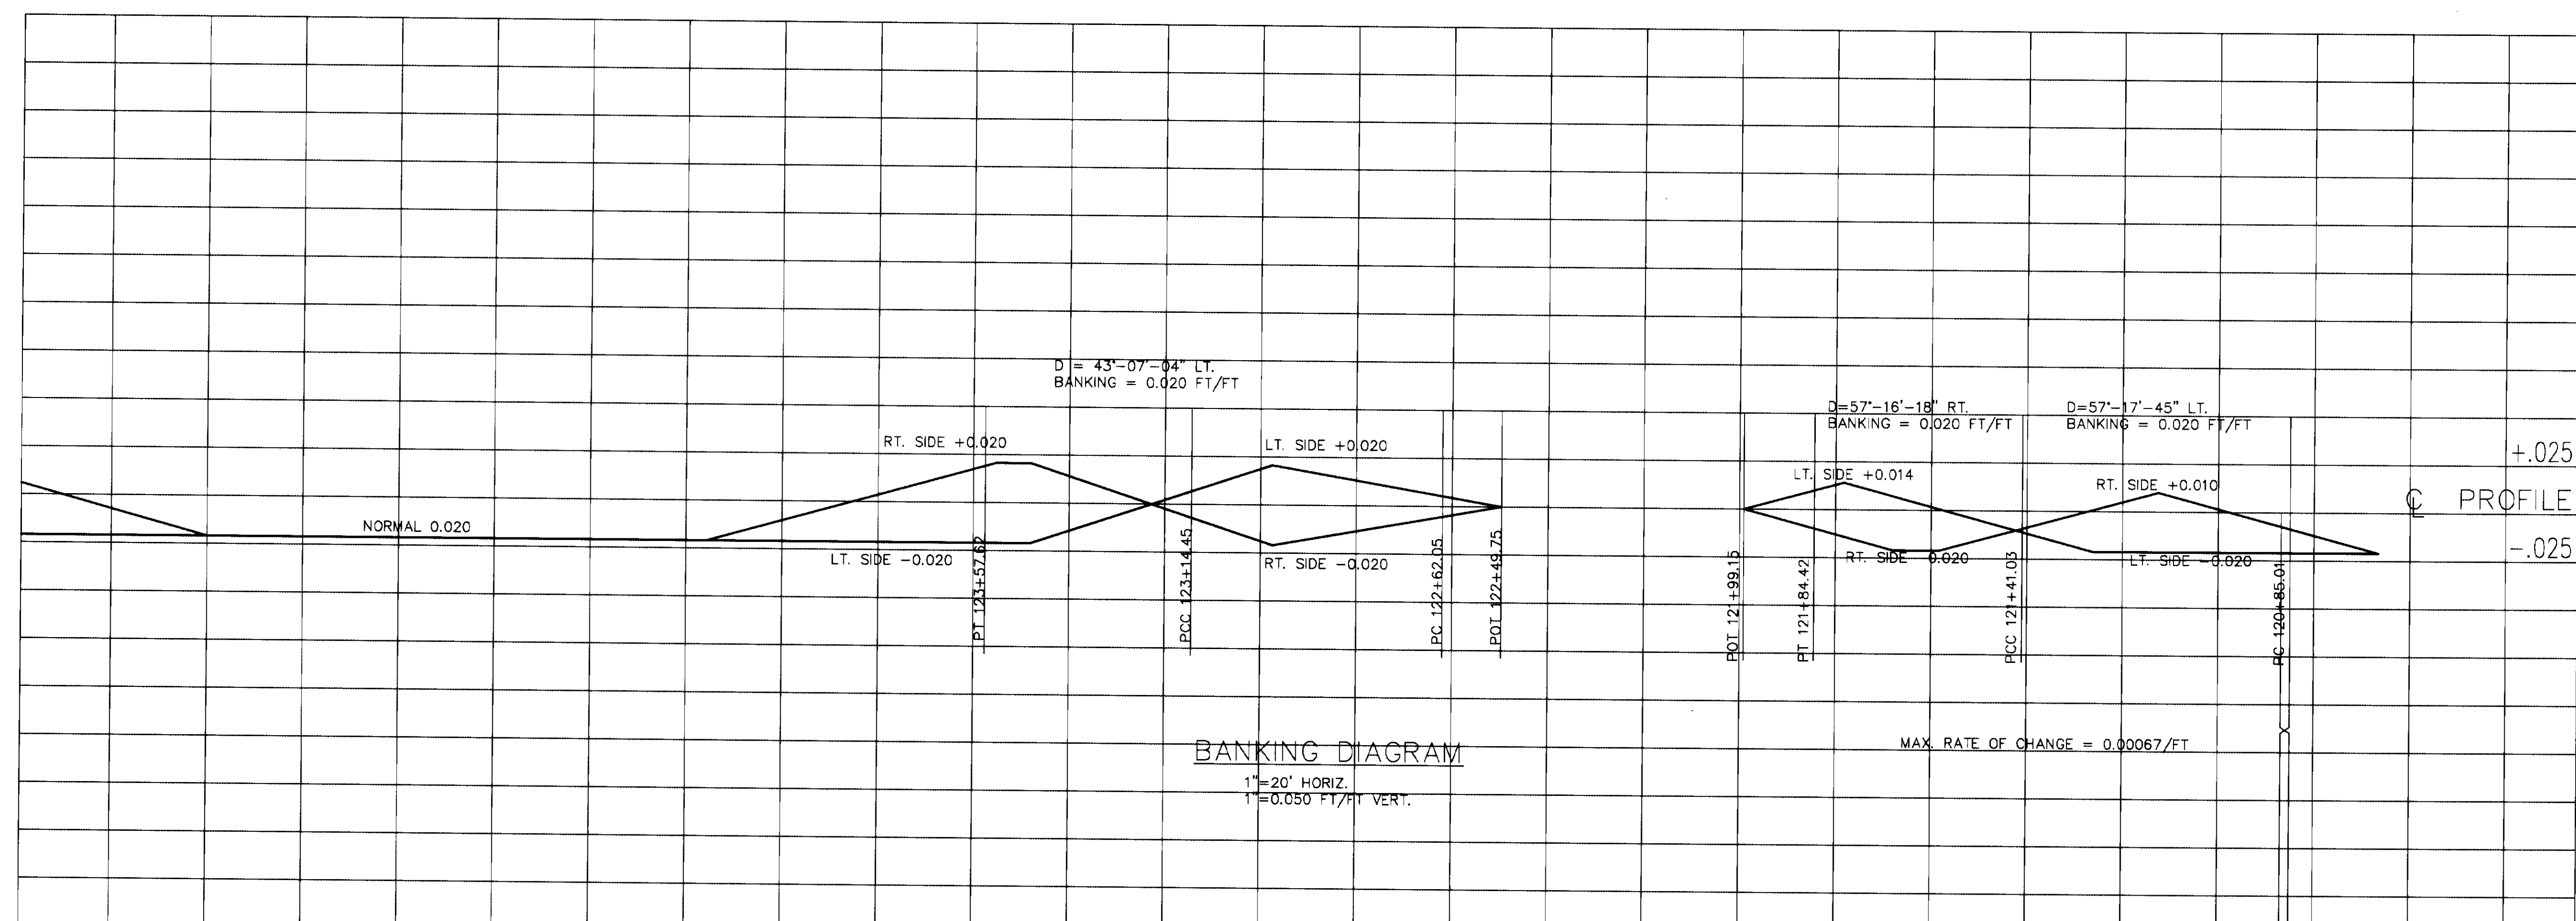

125+00


124+00

123+00


122+00

121+00

PC 120+86.86 BK  
=PC 120+85.01 AHD  
EQ = +1.85

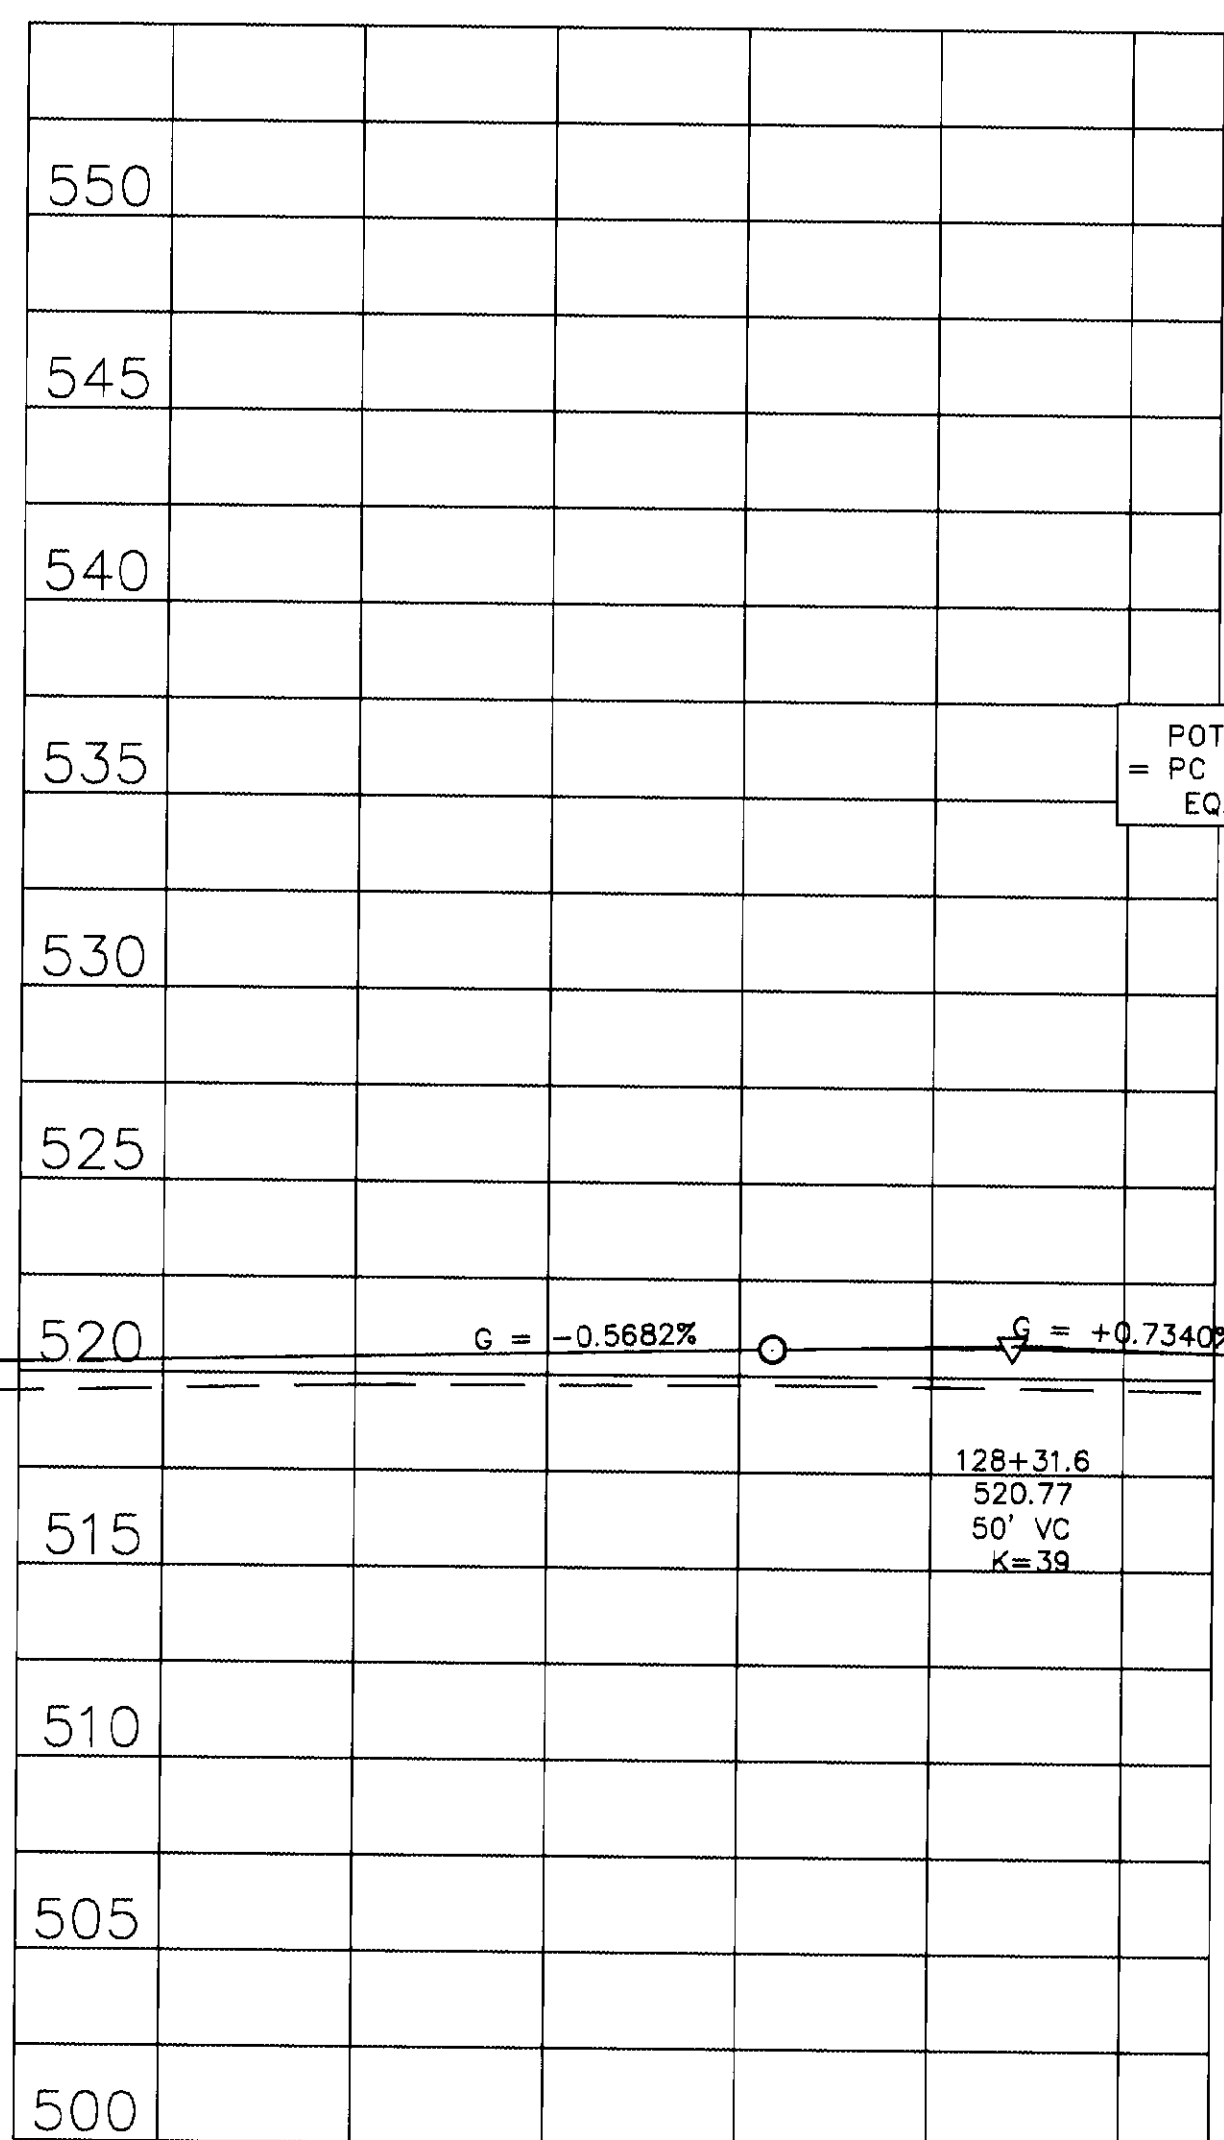

129+00

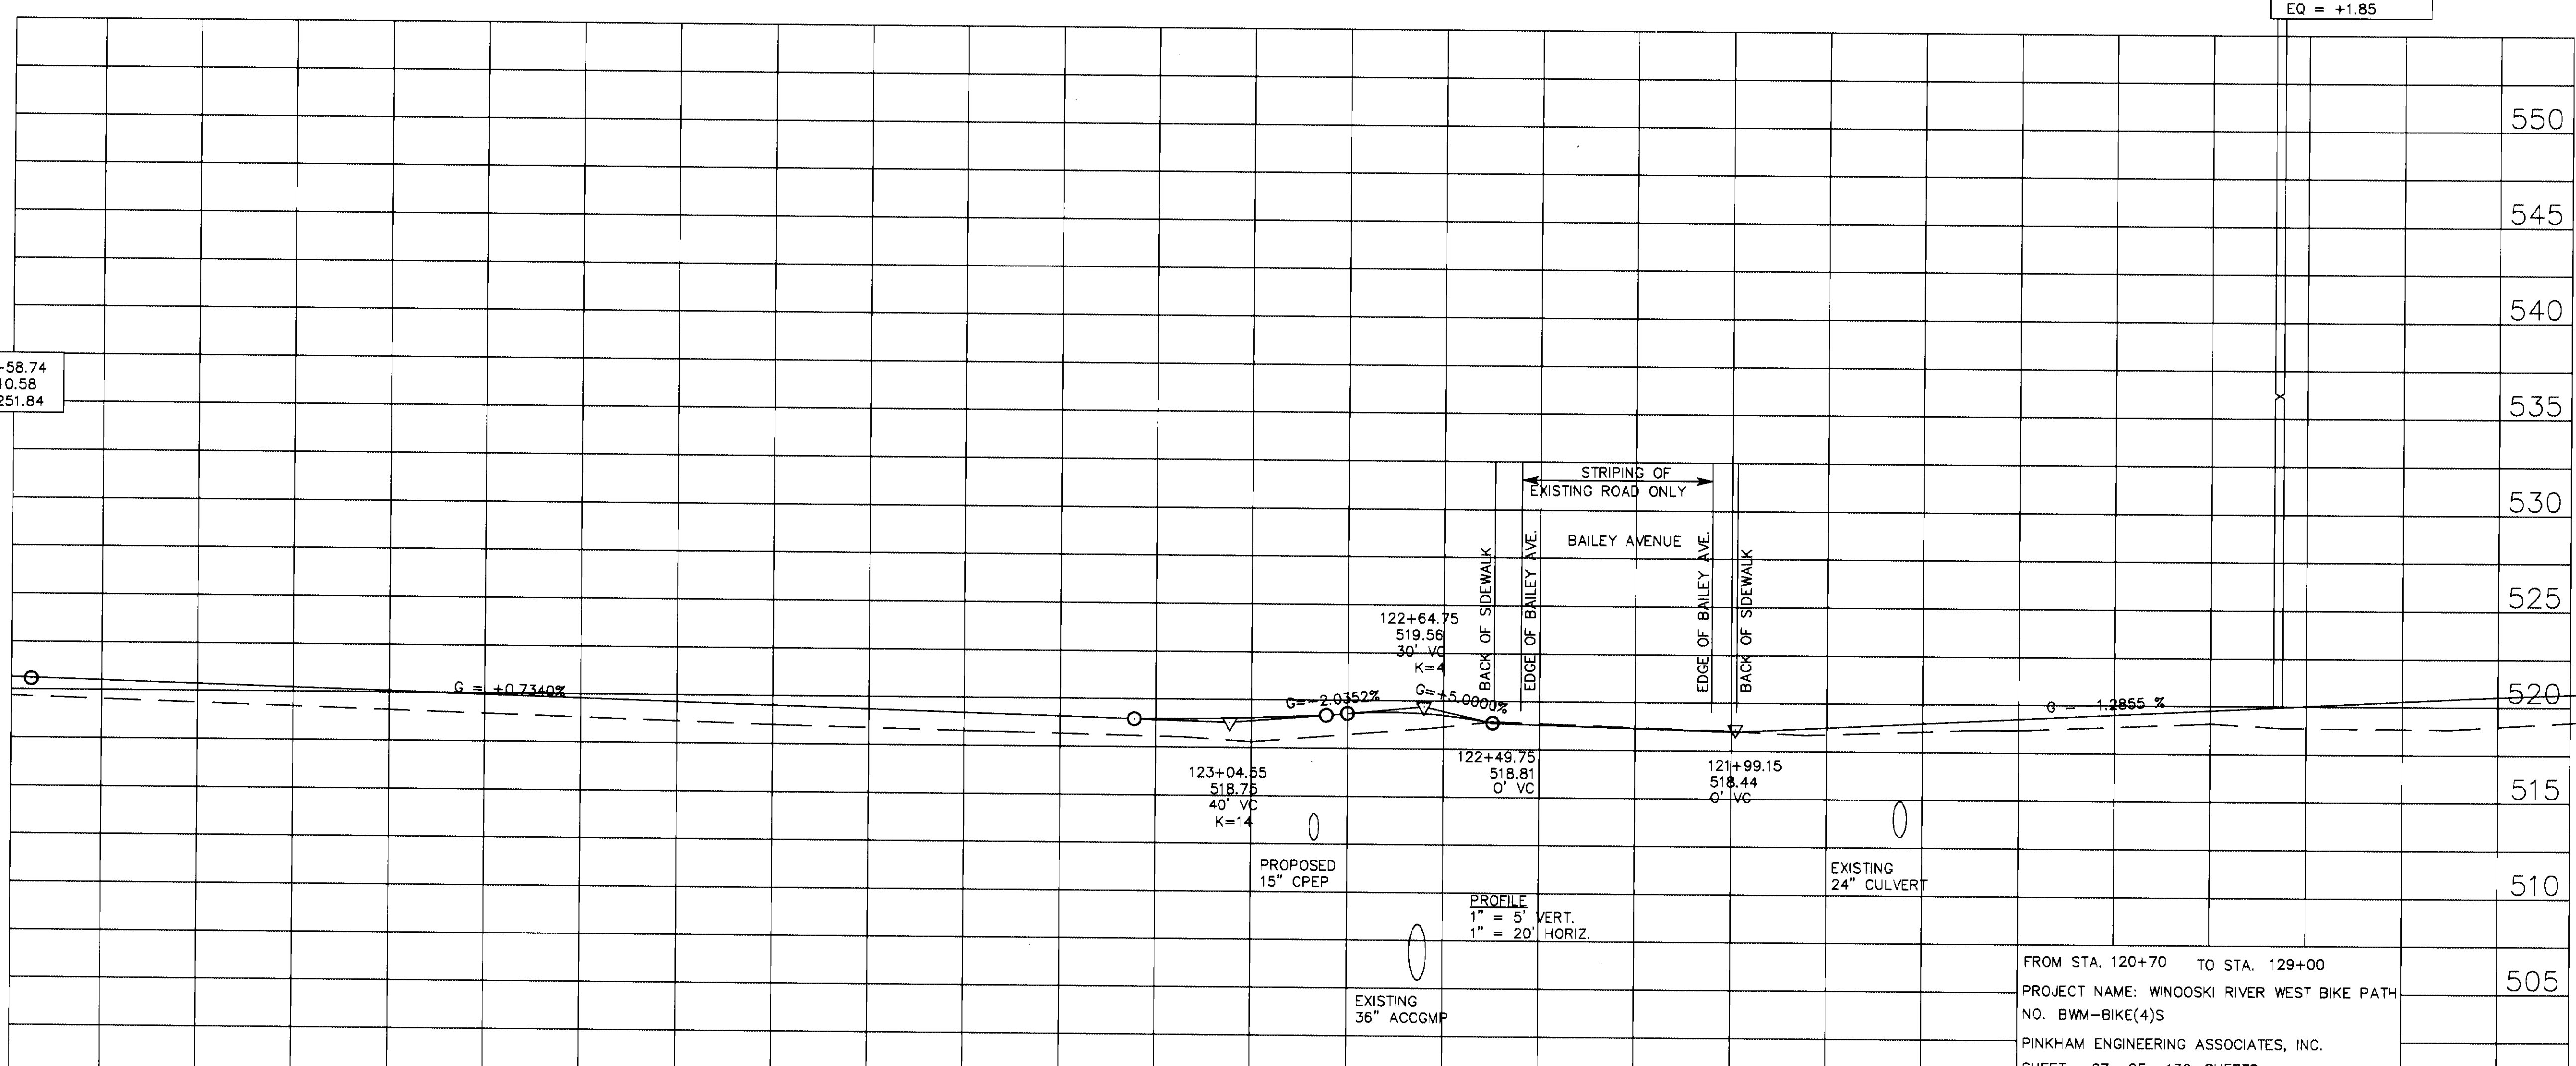

125+00

124+00

123+00

122+00

121+00

FROM STA. 120+70 TO STA. 129+00  
PROJECT NAME: WINOOSKI RIVER WEST BIKE PATH  
NO. BMW-BIKE(4)S  
PINKHAM ENGINEERING ASSOCIATES, INC.  
SHEET 27 OF 132 SHEETS

P.E. 000000-3