

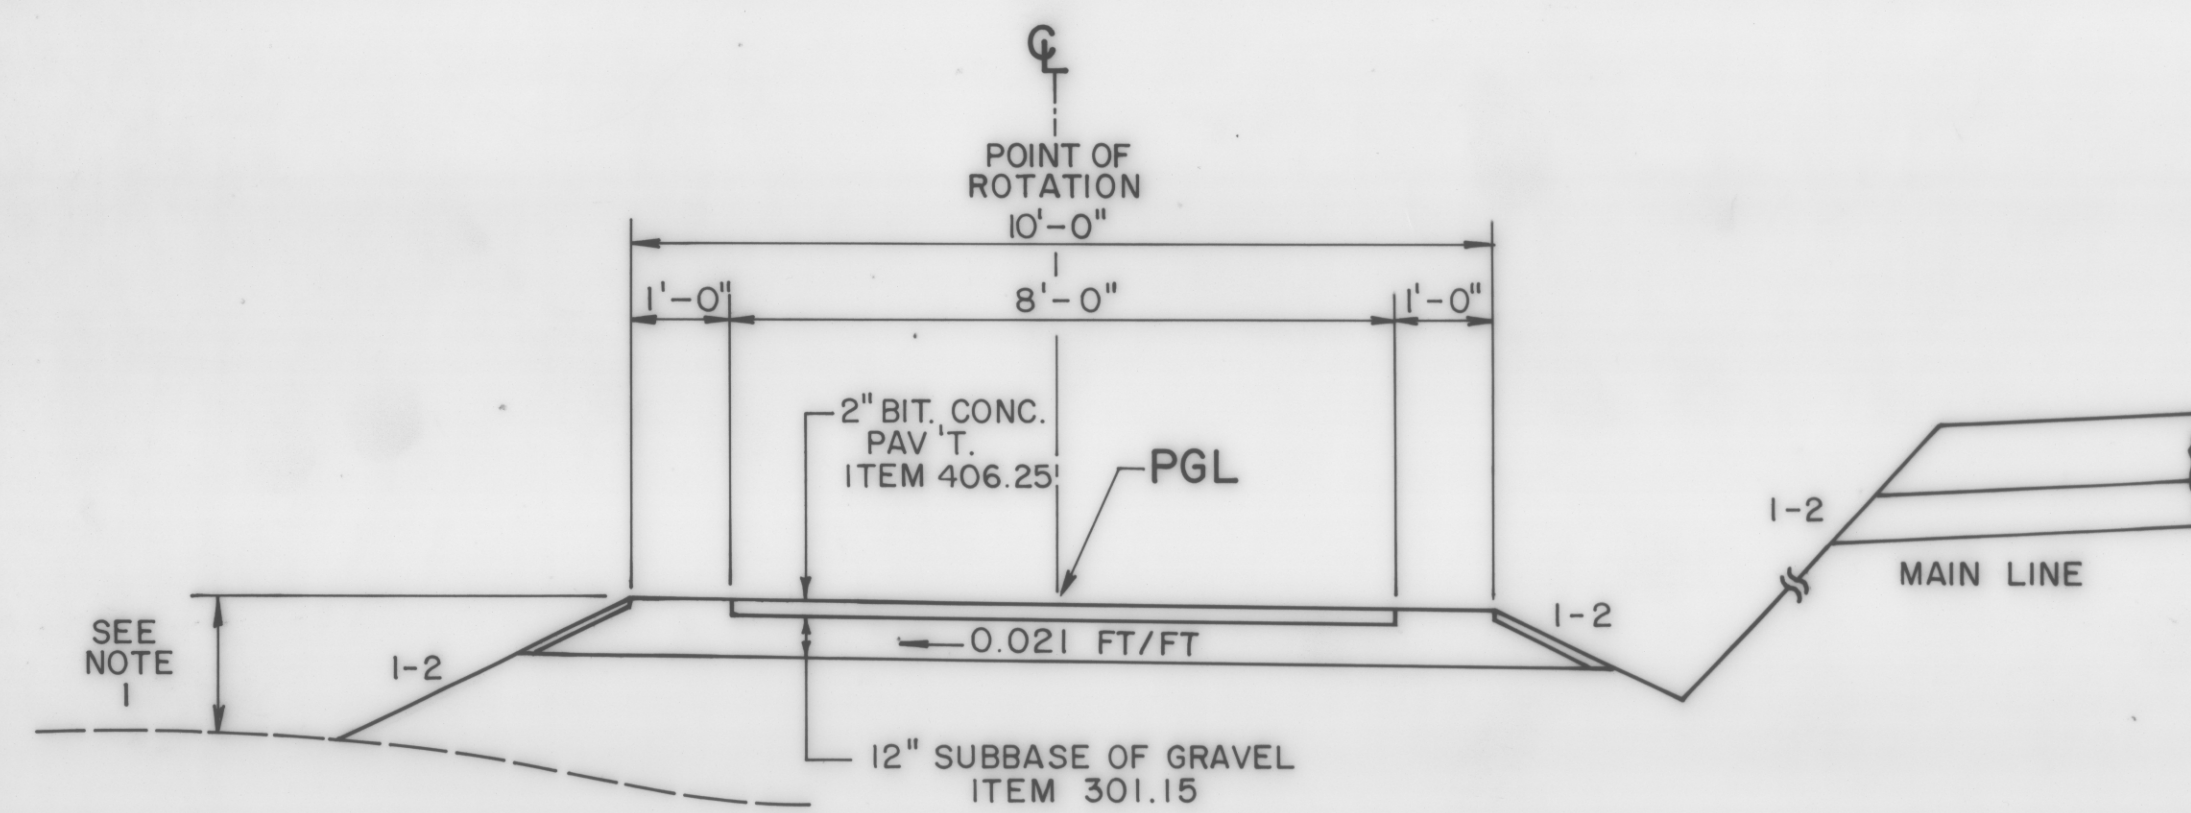




# TYPICAL SEC

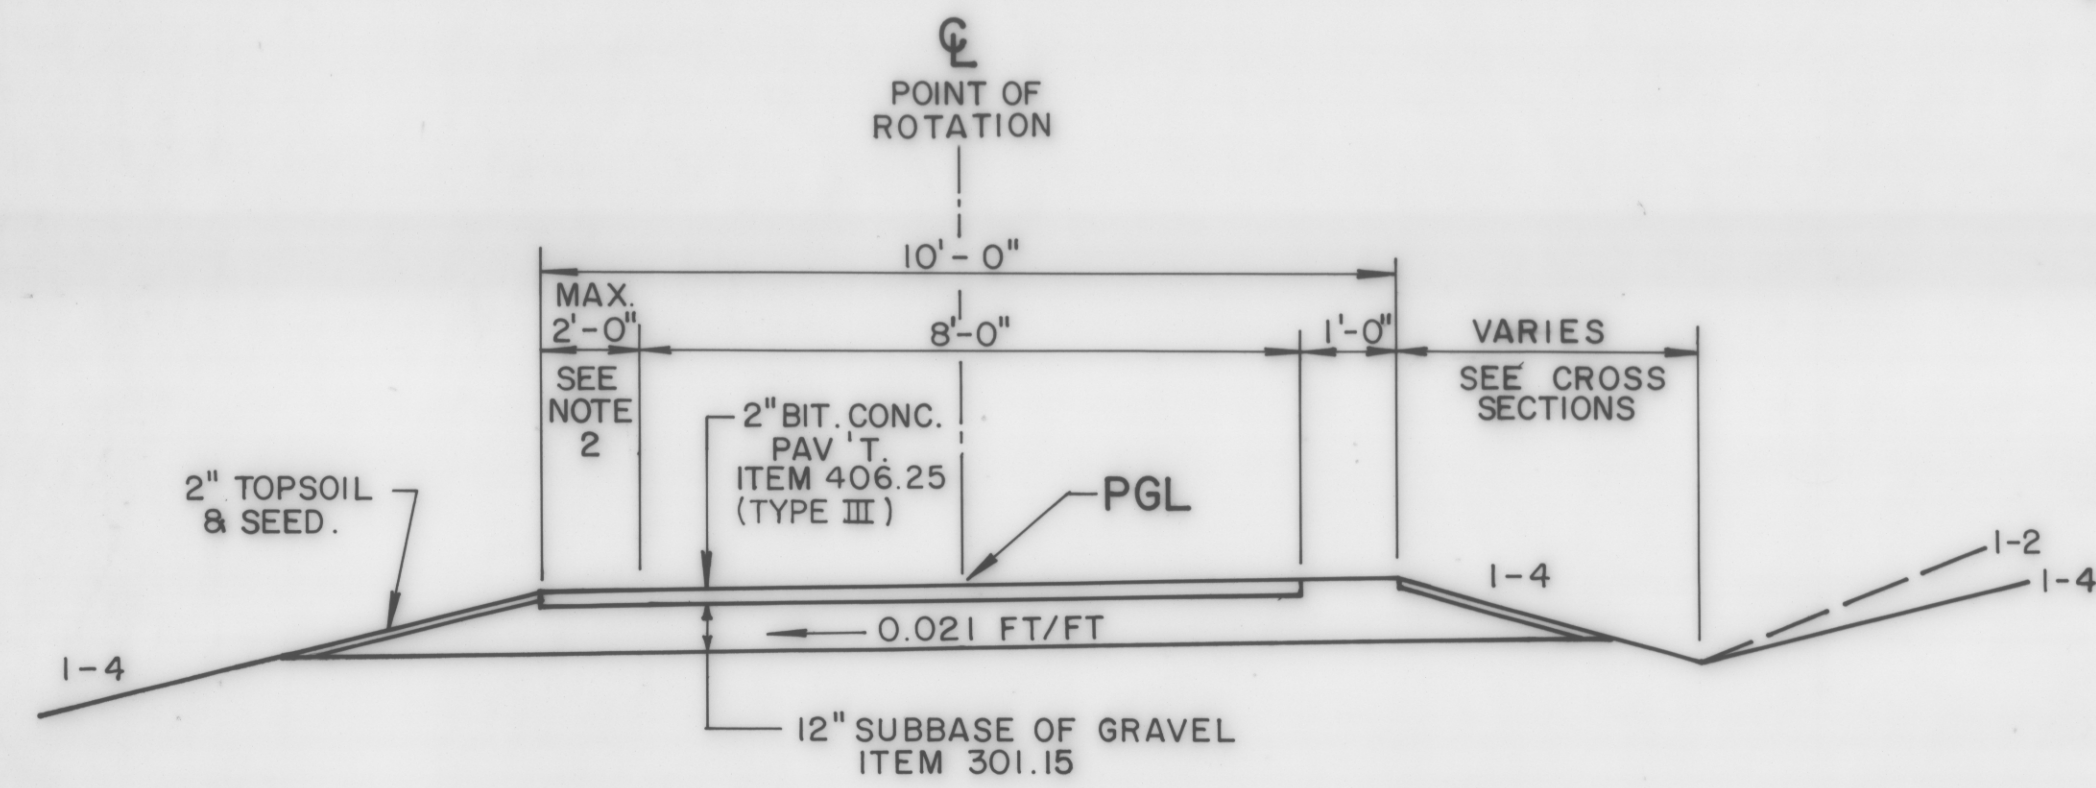


## BIKEWAY N.T.S.

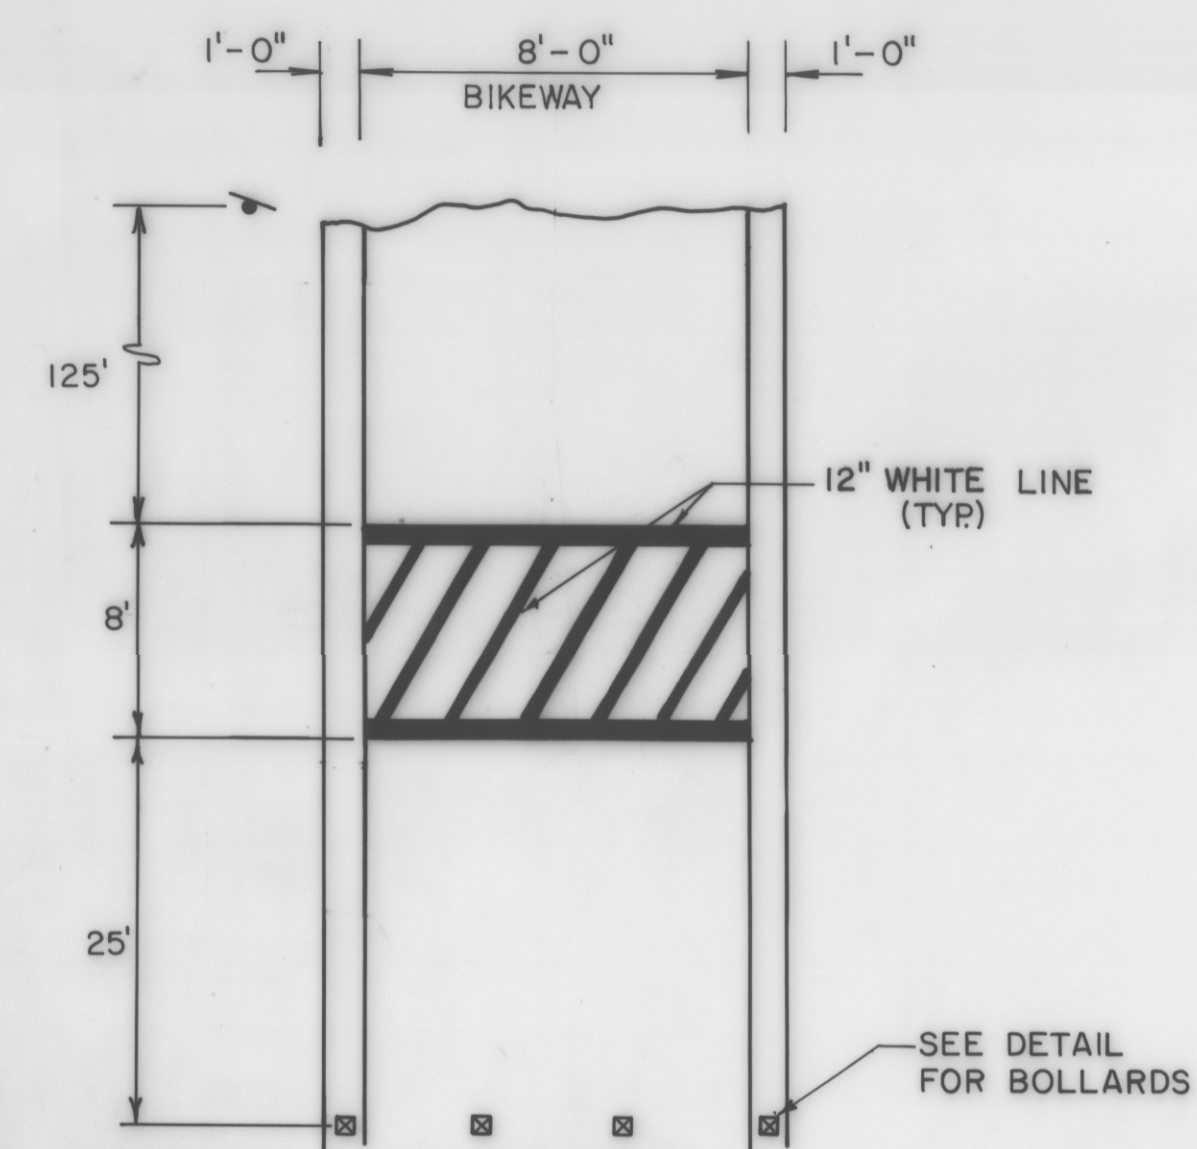

## PAVEMENT MARKING DETAIL FOR BOLLARDS N.T.S.

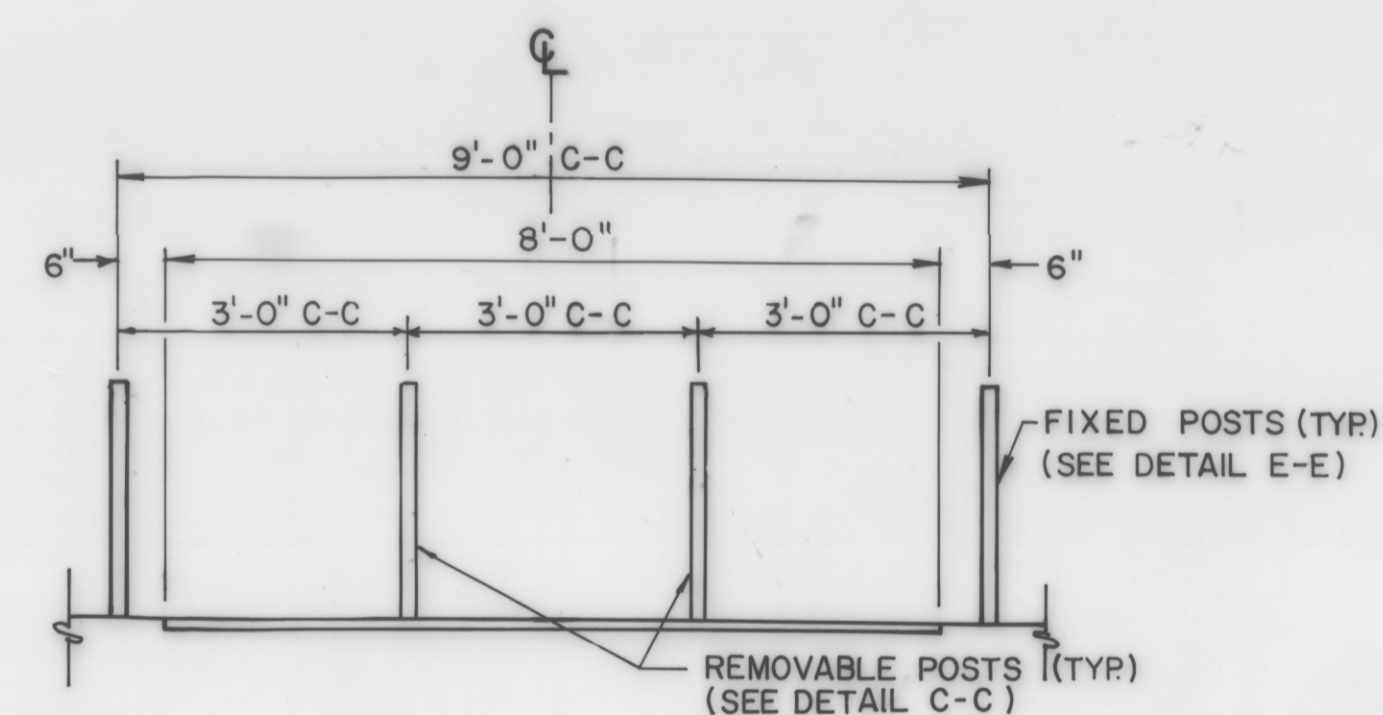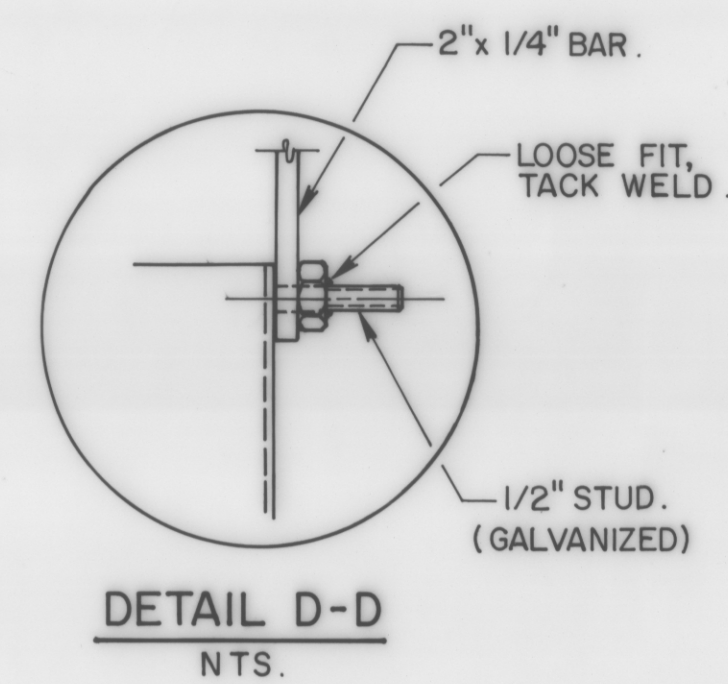

## BOLLARD DETAIL N.T.S.

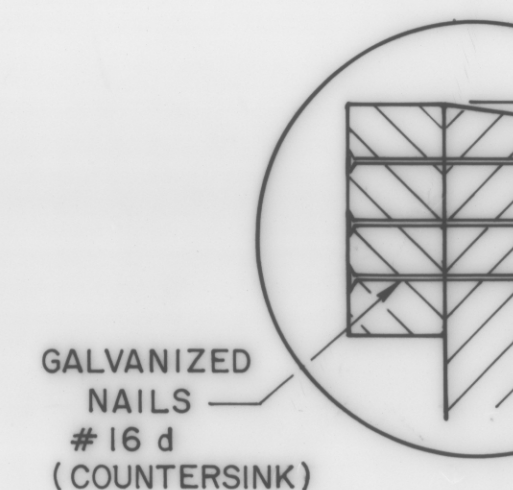

## DETAIL N.T.S.

9 1/2" x 3/4" UNTHREADED BOLT

5 1/2" x 7 1/2" S4S WOOD.

3'-6 1/2"