



TYPICAL SECTIONS - P


1-1/2" BITUMINOUS CONCRETE PAVEMENT
 3" BASE COURSE, BITUMINOUS CON
 18" SUBBASE OF DENSE GRADED CR
 12" SAND BORROW
 SHOULDERS: 1-1/2" BITUMINOUS CONCRETE PAVEMENT

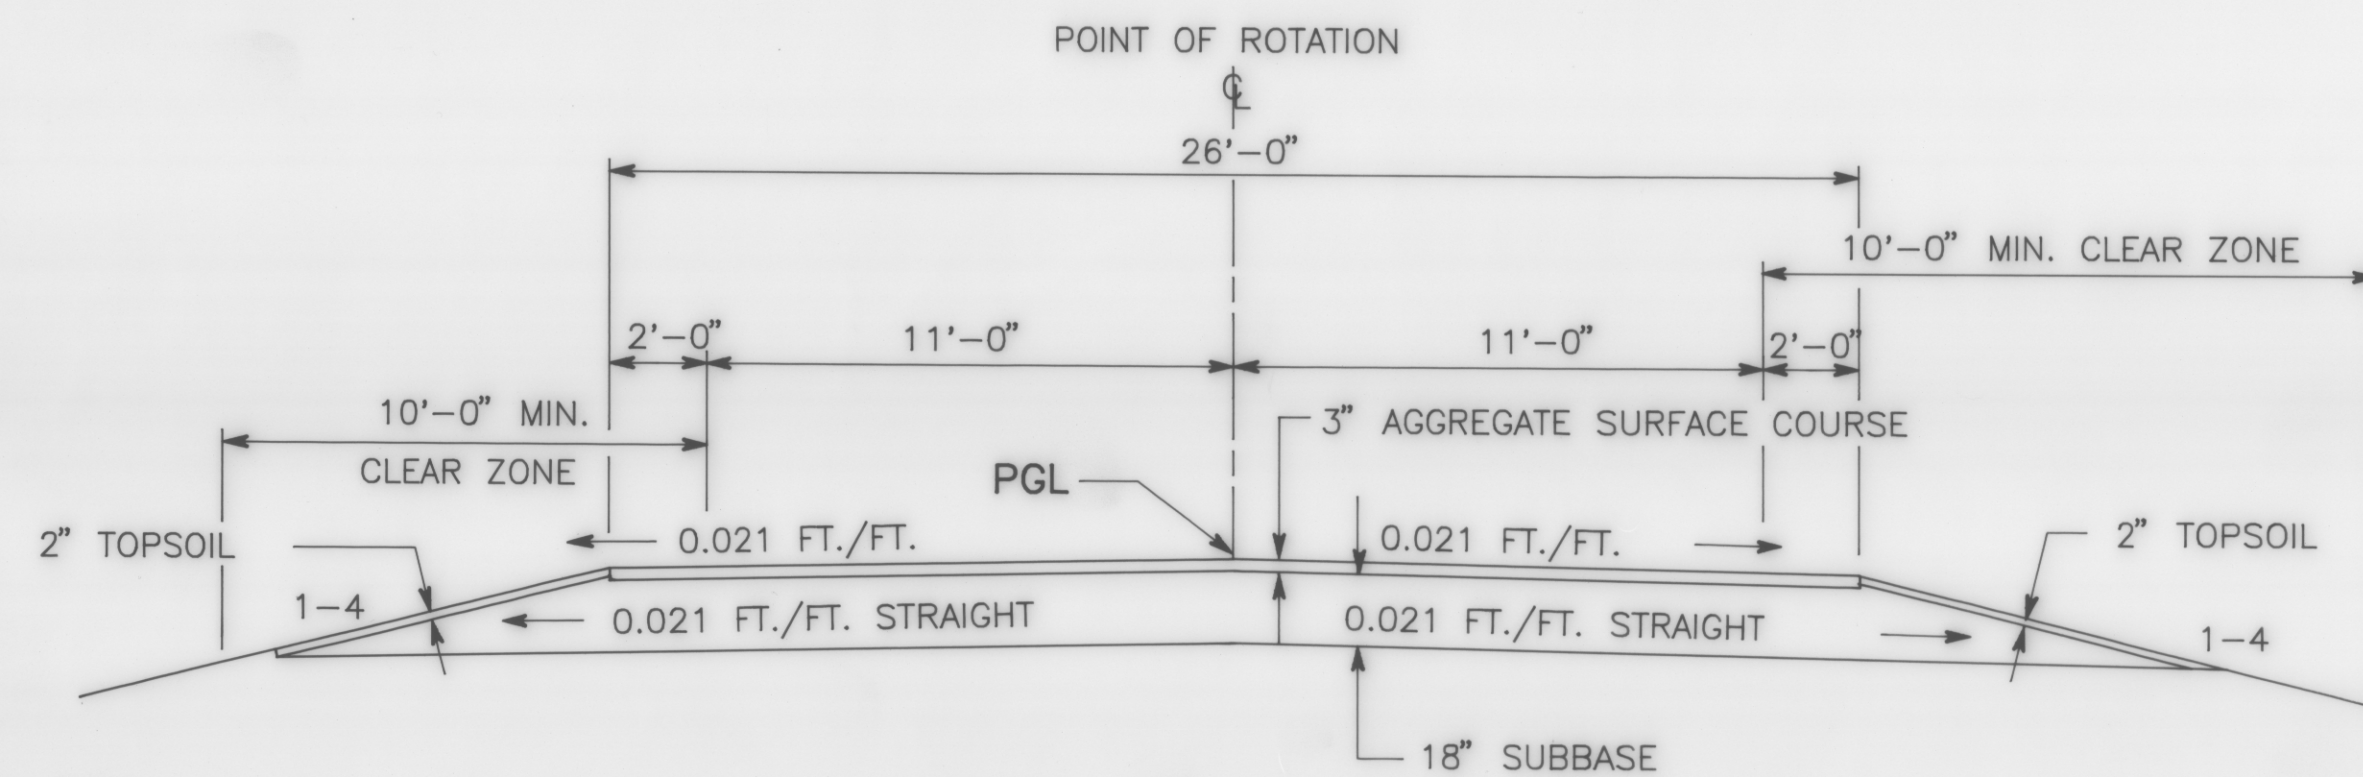

PARK SERVICE ROAD
 APPROACH TO BRIDGE

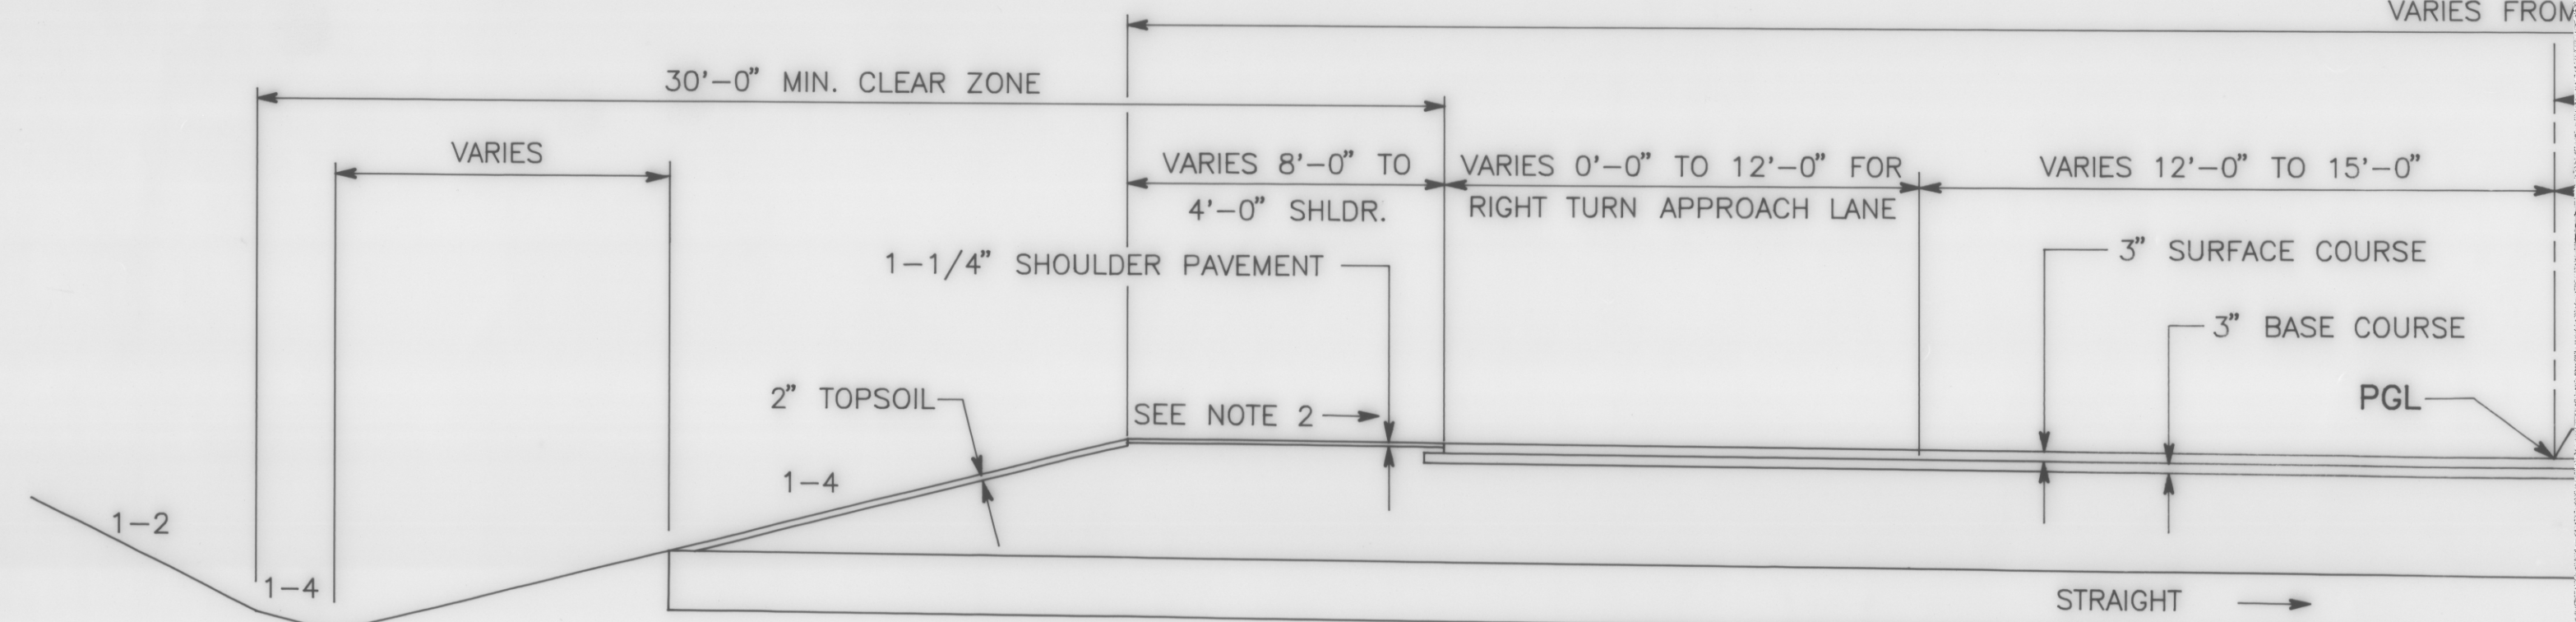

RTE 289 TYPICAL
 APPROACHING PARKSIDE DRIVE

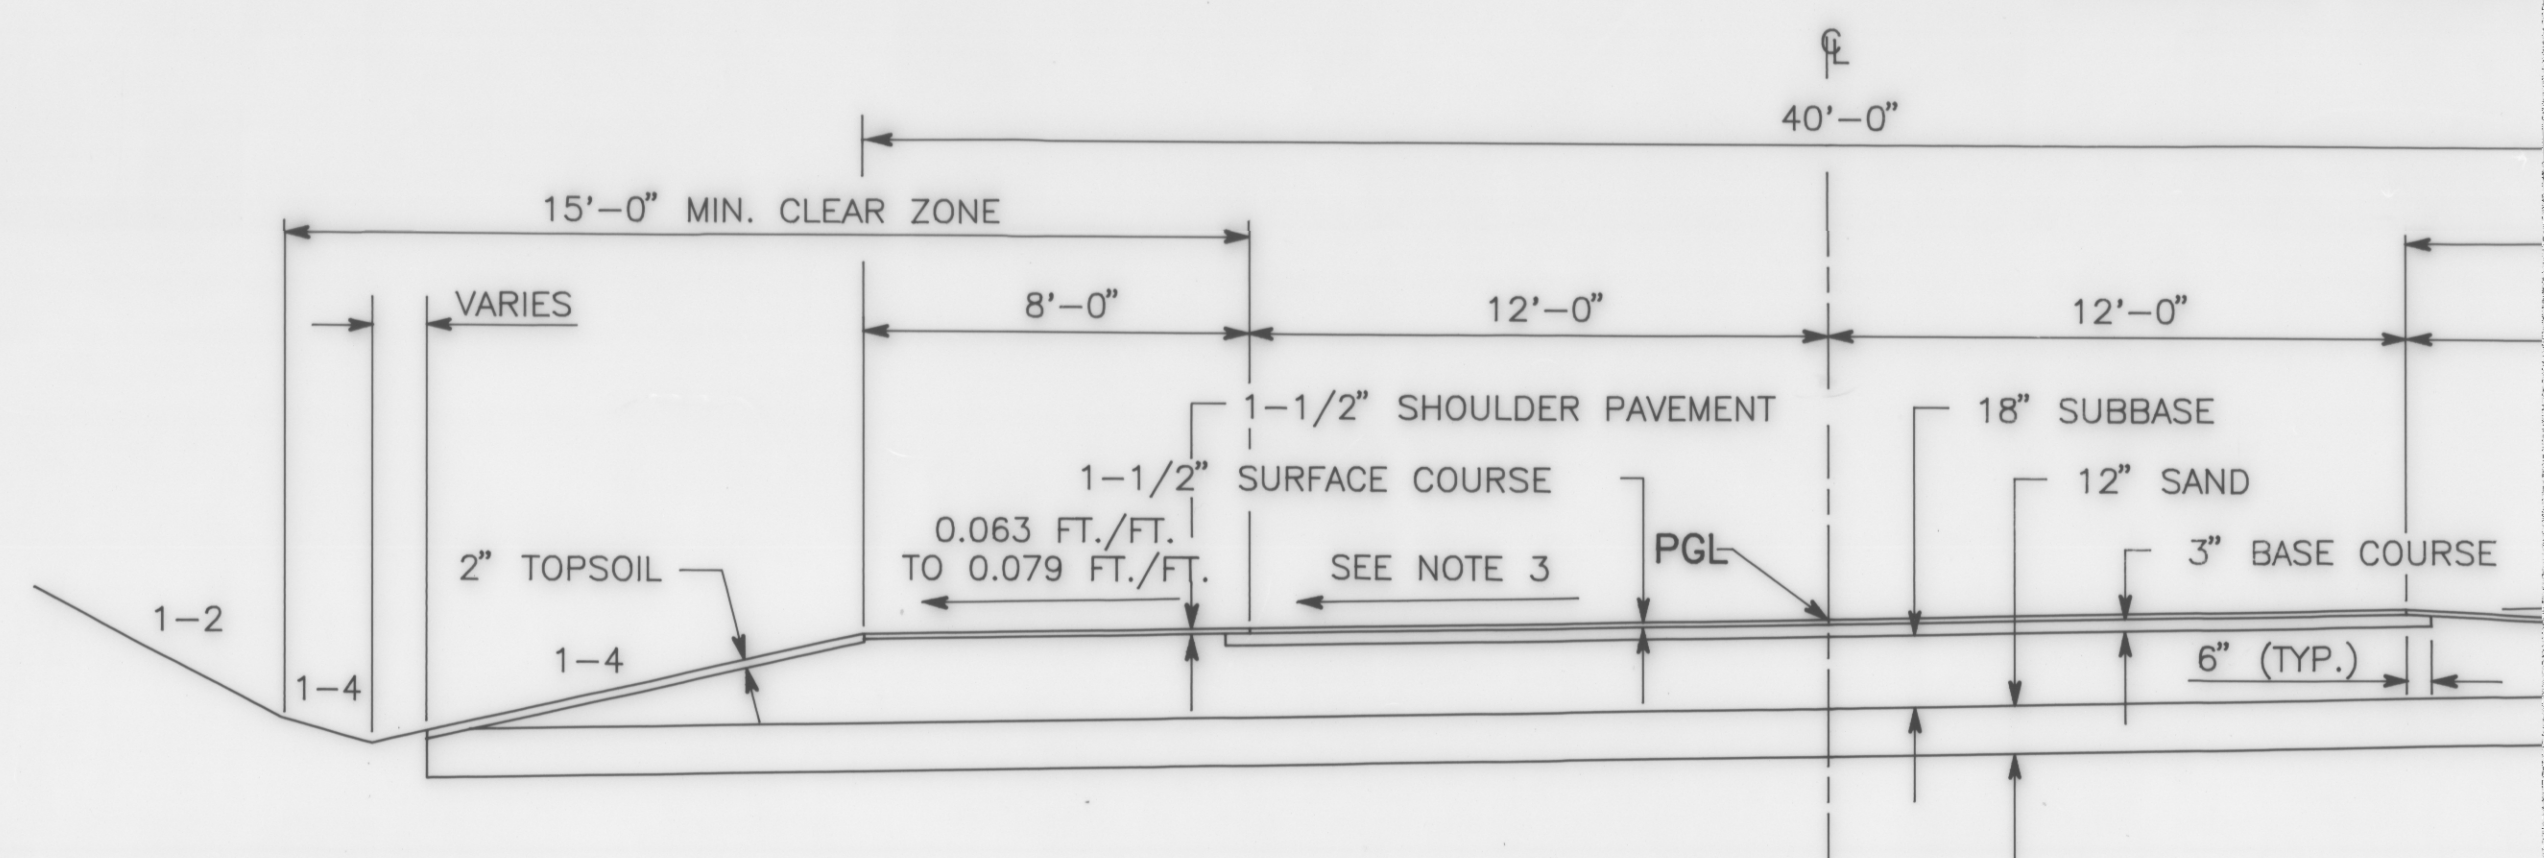


PARKSIDE DRIVE
 TYPICAL BANKED SECTION
 MAX. BANK 0.079 FT./FT.

PARKSIDE DRIVE
 TYPICAL BANKED SECTION
 MAX. BANK 0.079 FT./FT.


TYPICAL SECTIONS - PARKSIDE DRIVE

1-1/2" BITUMINOUS CONCRETE PAVEMENT, TYPE III 406.25
 3" BASE COURSE, BITUMINOUS CONCRETE, TYPE I (1 LIFT) 406.25
 18" SUBBASE OF DENSE GRADED CRUSHED STONE 301.35
 12" SAND BORROW 203.31
 SHOULDERS: 1-1/2" BITUMINOUS CONCRETE PAVEMENT, TYPE III (1 LIFT) 406.25

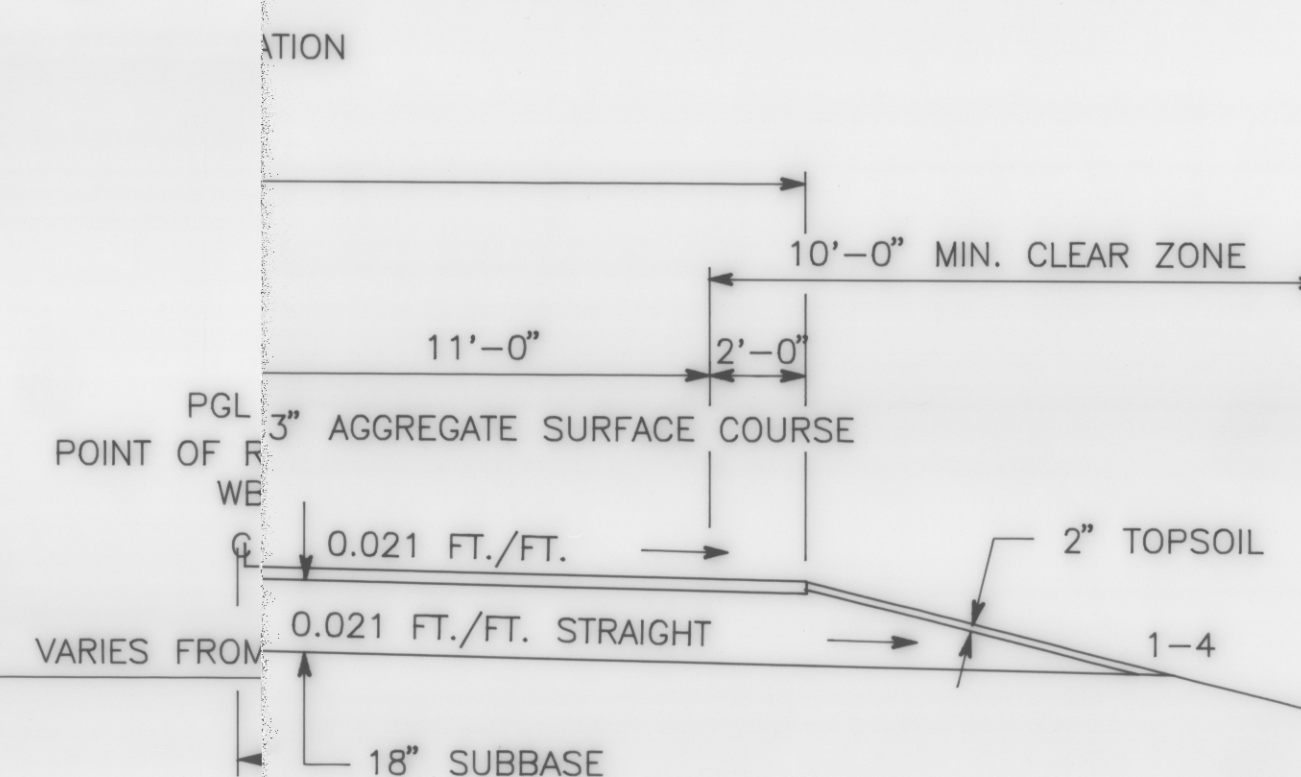


FLUSH CONCRETE MEDIAN SEE
 DETAIL SHT. NO.

8" PORT. CEM. CONC.
 ITEM 618.11

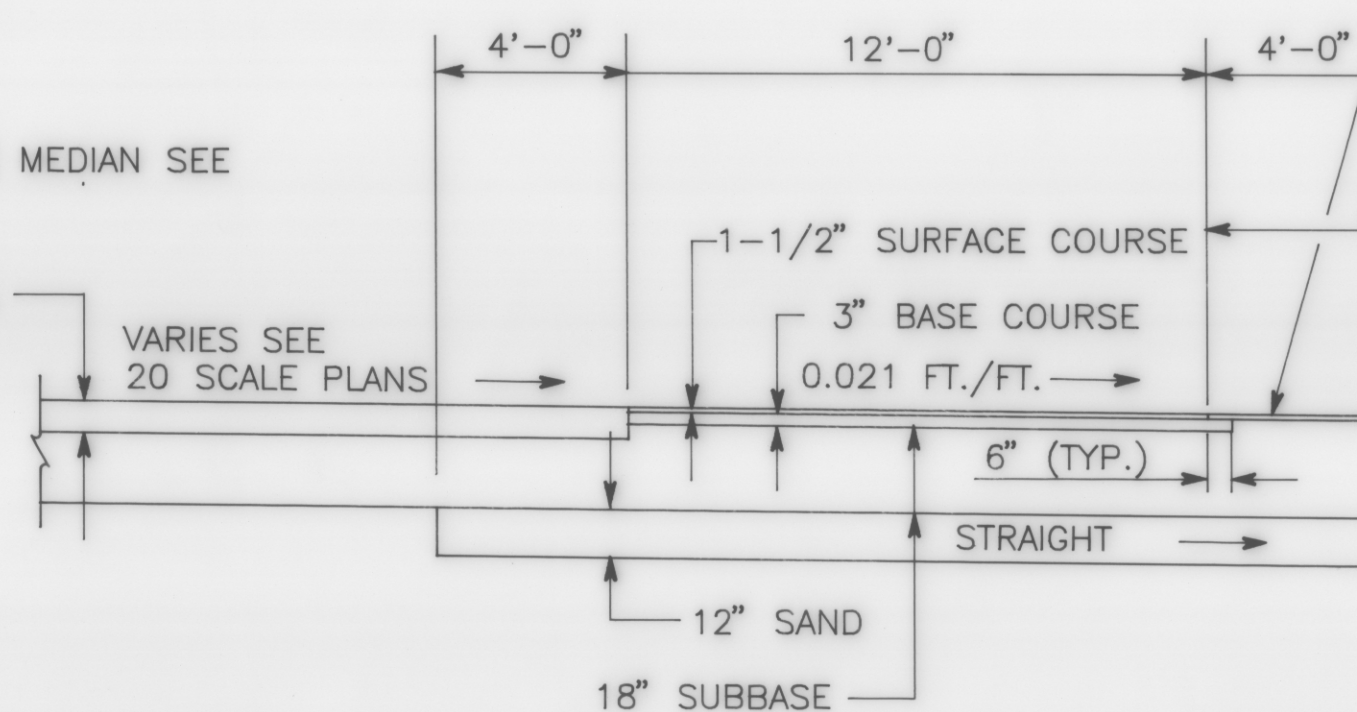

RIGHT TURN LANE
 VT. RTE. 289 TO PARKSIDE

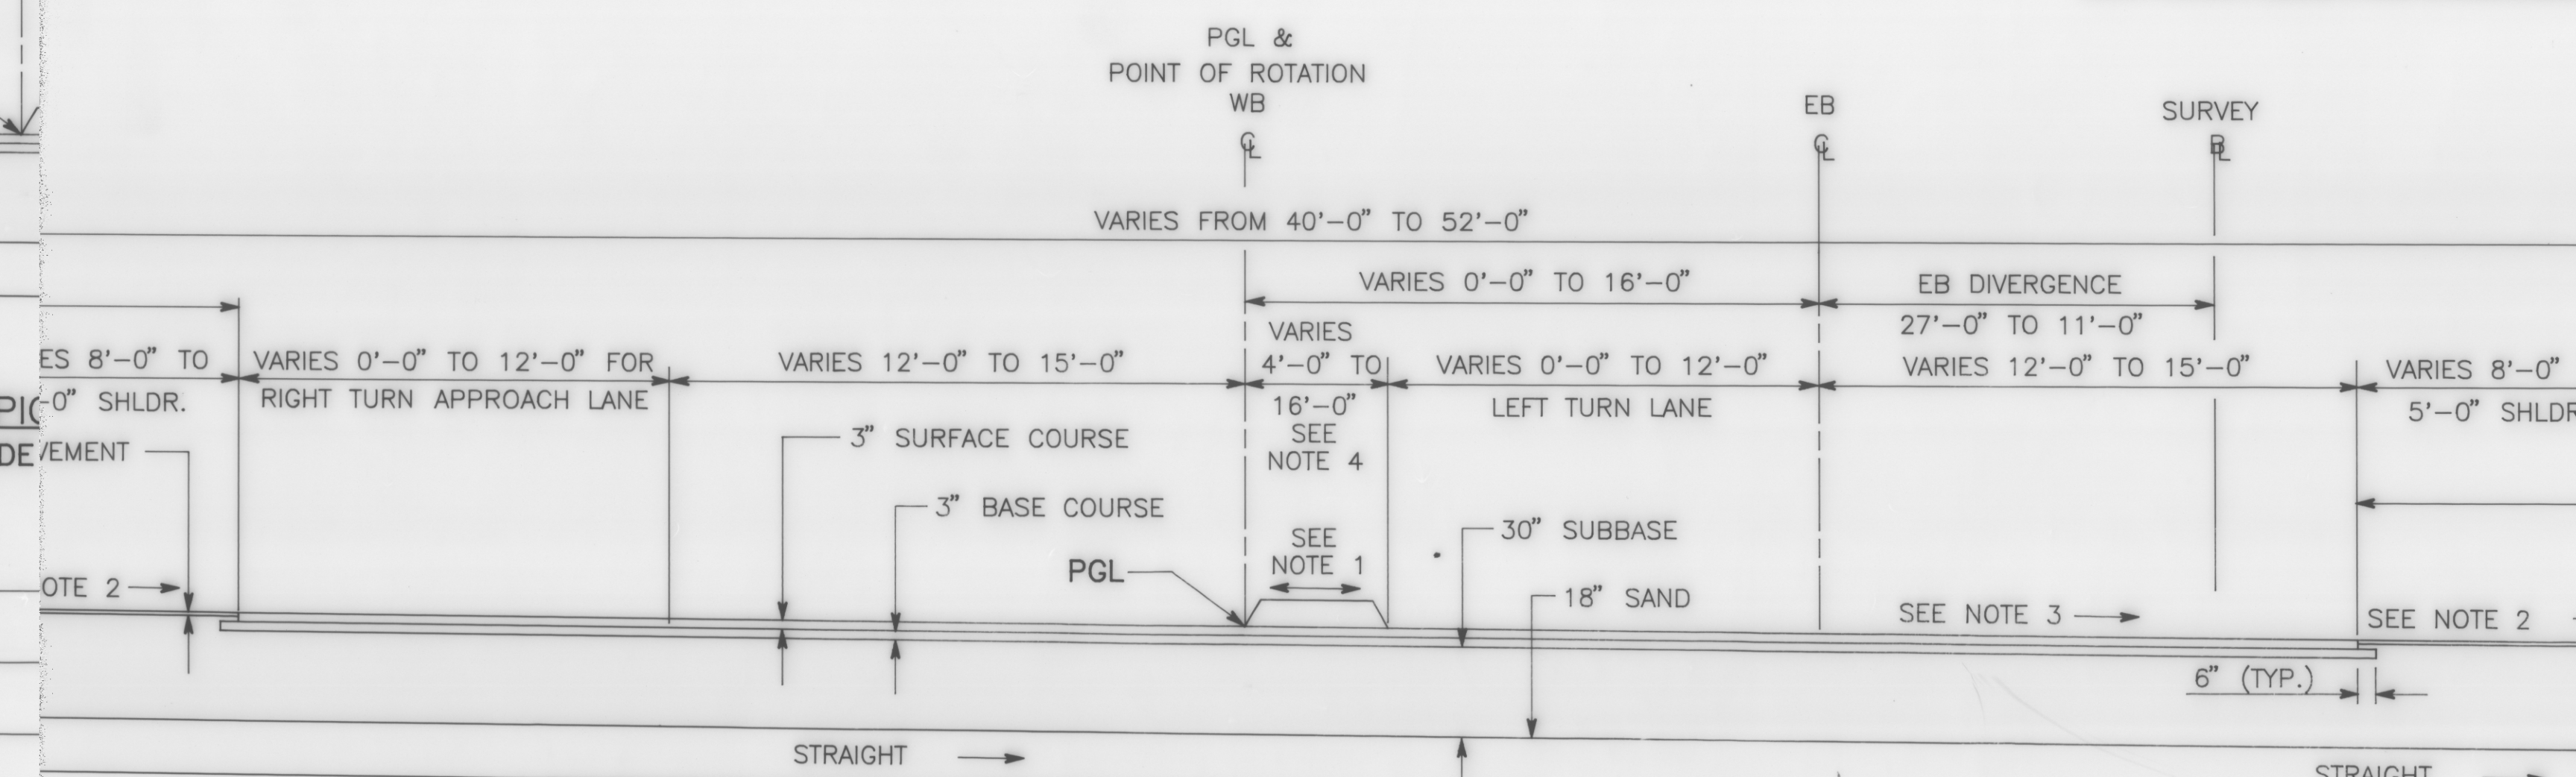

RTE 289 TYPICAL SECTION
 APPROACHING PARKSIDE DRIVE INTERSECTION

