



TYPICAL SECTION

1-1/2" BITUMINOUS CO
3" BASE COURSE,
18" SUBBASE OF
12" SAND BORROW
SHOULDERS: 1-1/2" BITUMINOUS CO

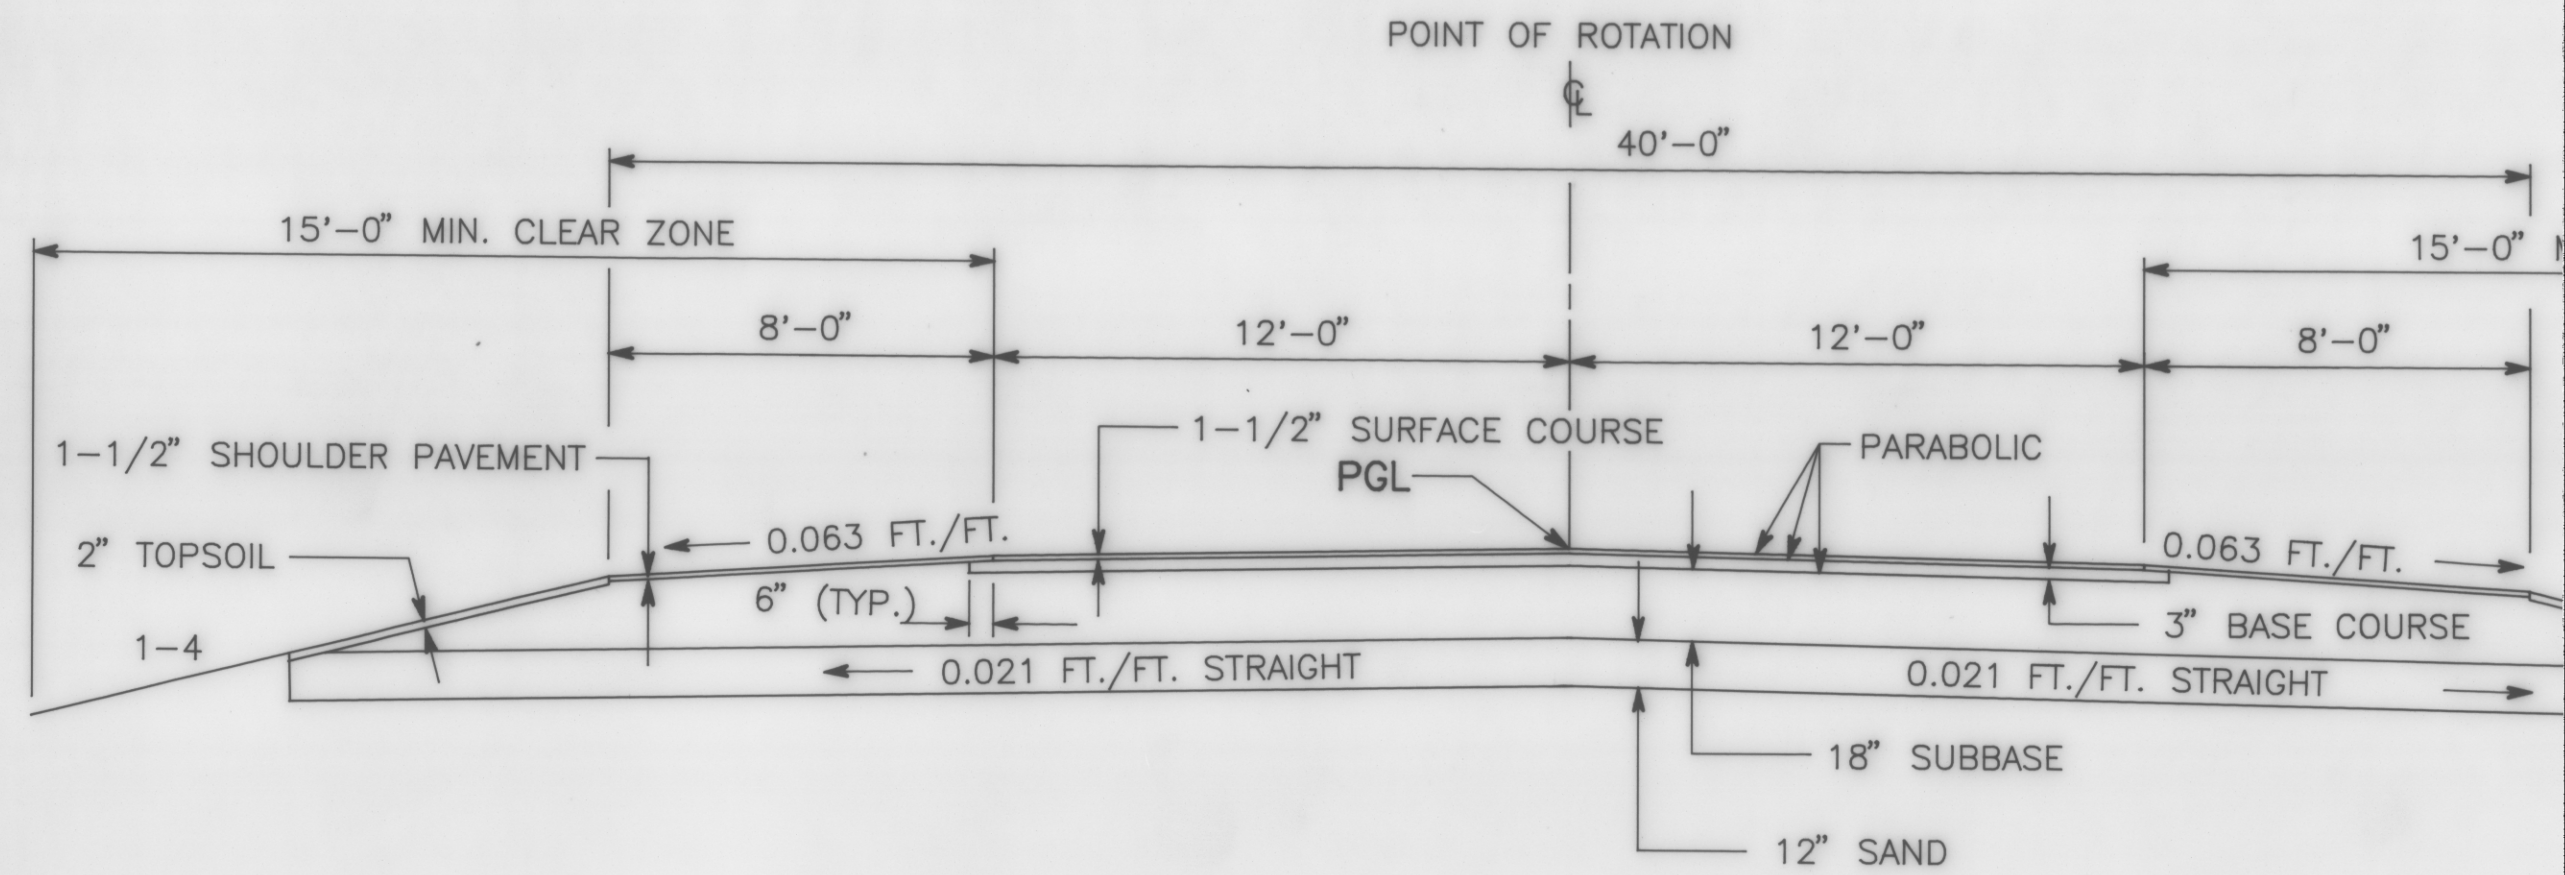


NORMAL SECTION

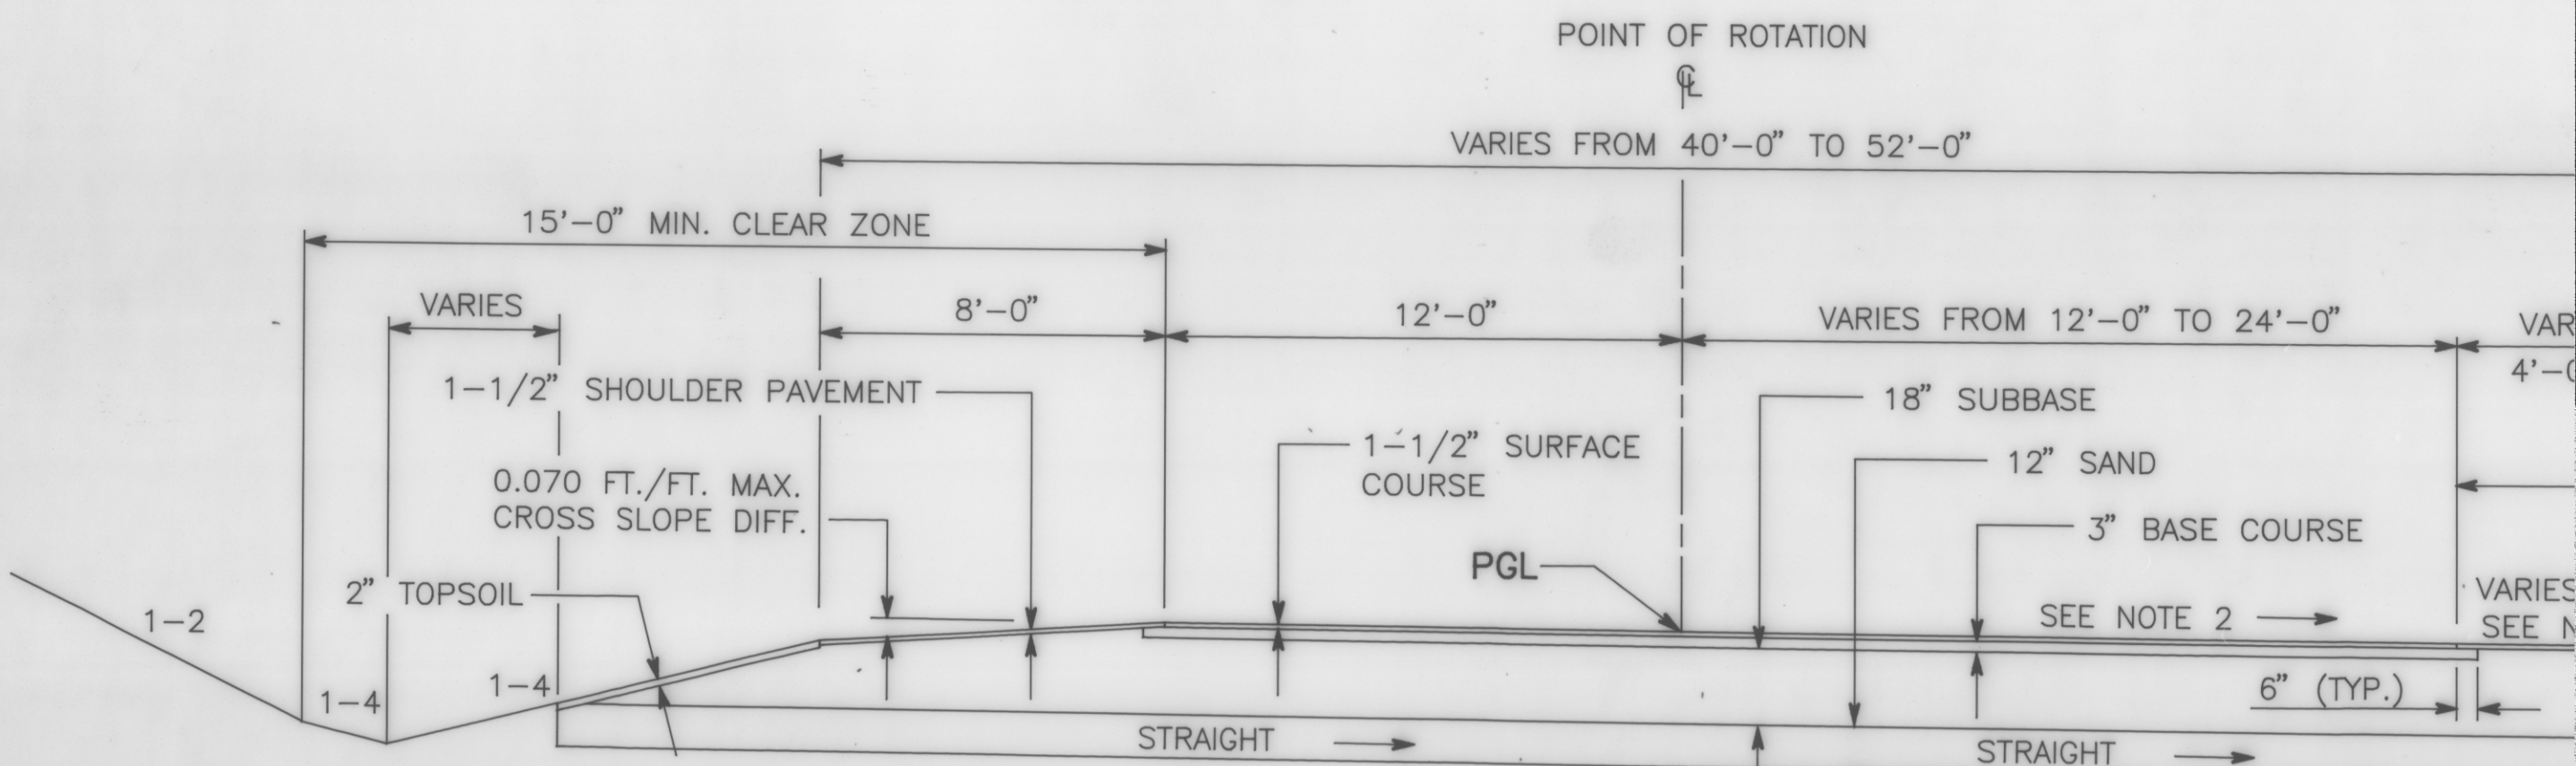

TRANSITION SECTION

STA. 63+00 TO STA. 67+00
STA. 81+65.41 TO STA. 85+00

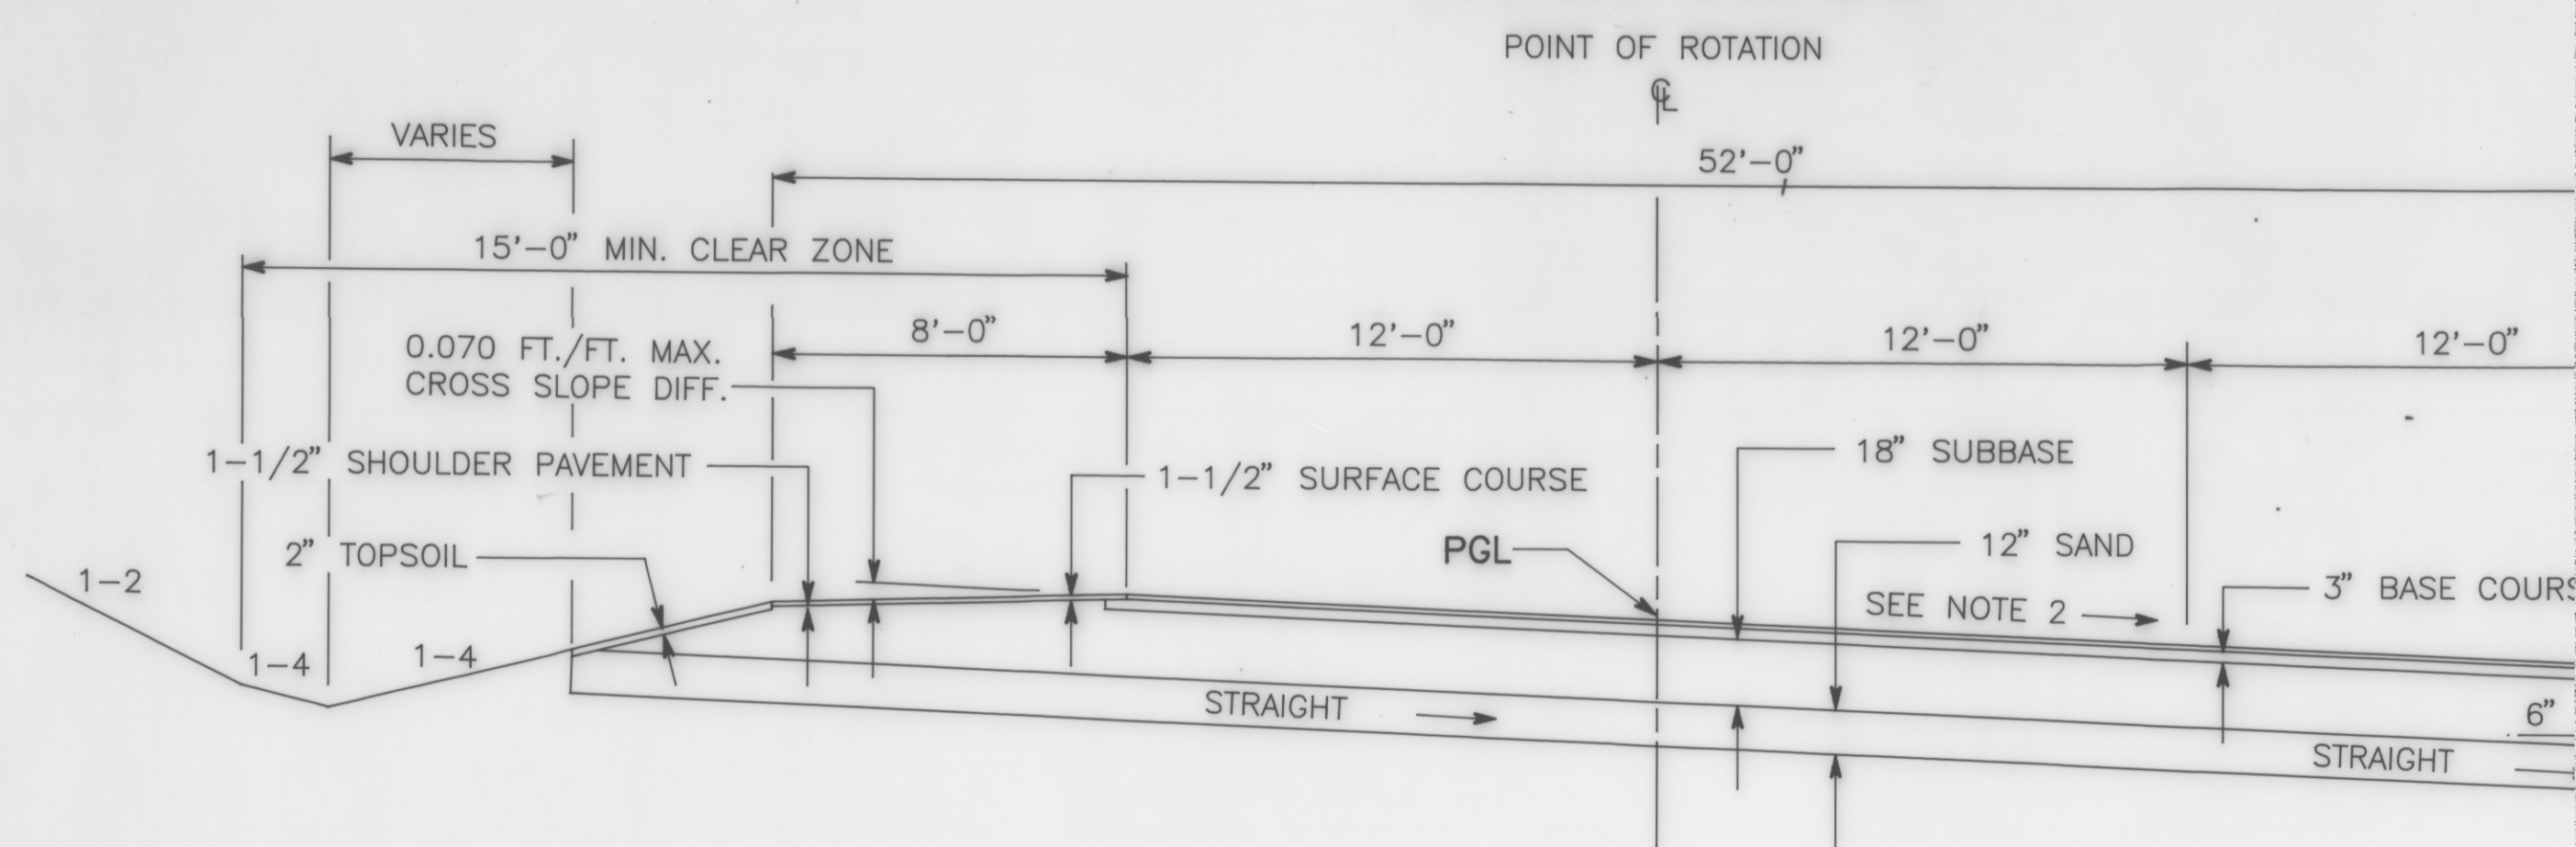

TYPICAL SECTION

STA. 61+00 TO STA. 63+00
STA. 85+00 TO STA. 88+00