




MISCELLANEOUS DETAIL

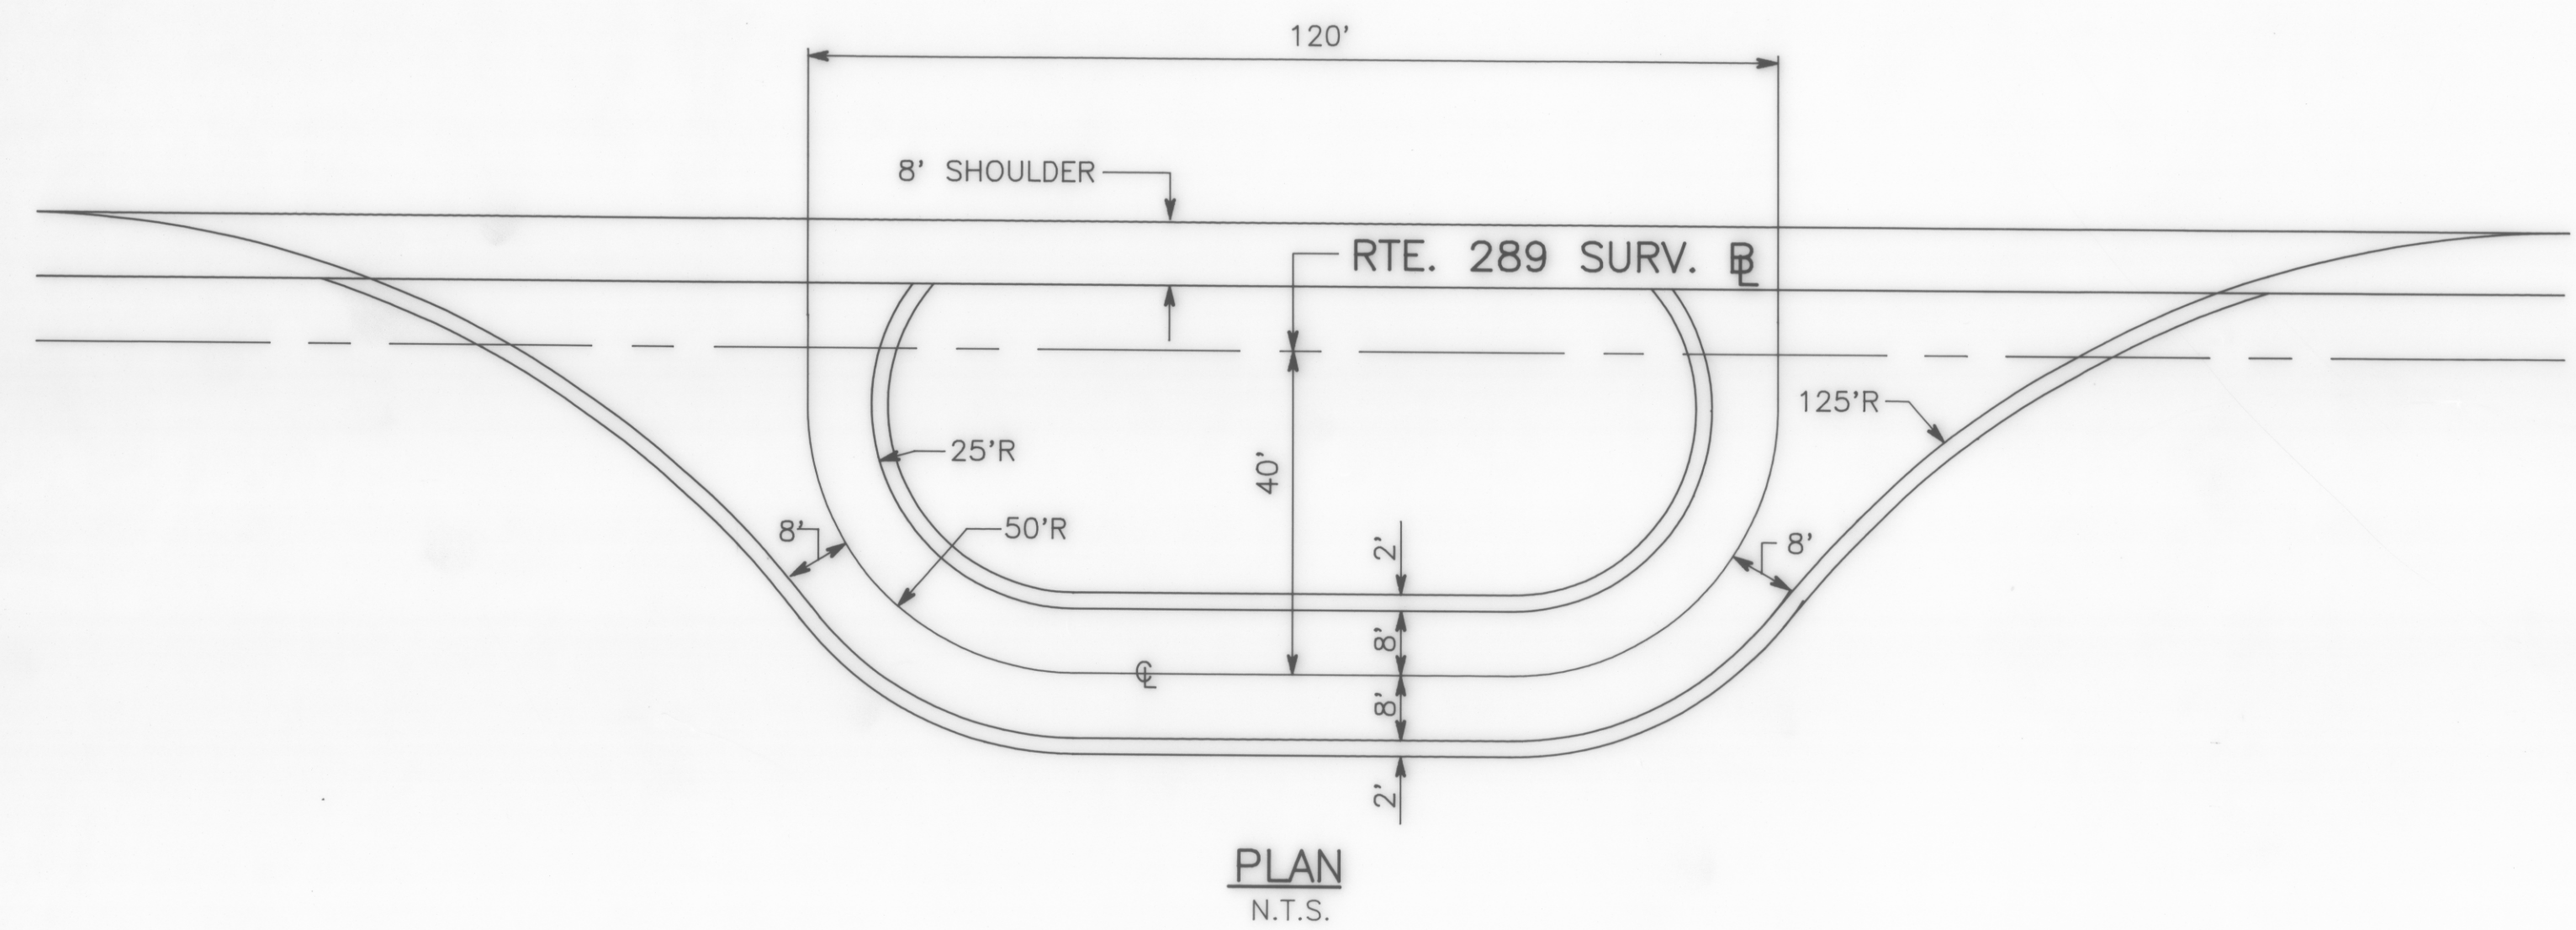

SNOWPLOW TURNAROUND
STA. 217+50 TO 219+50 RT

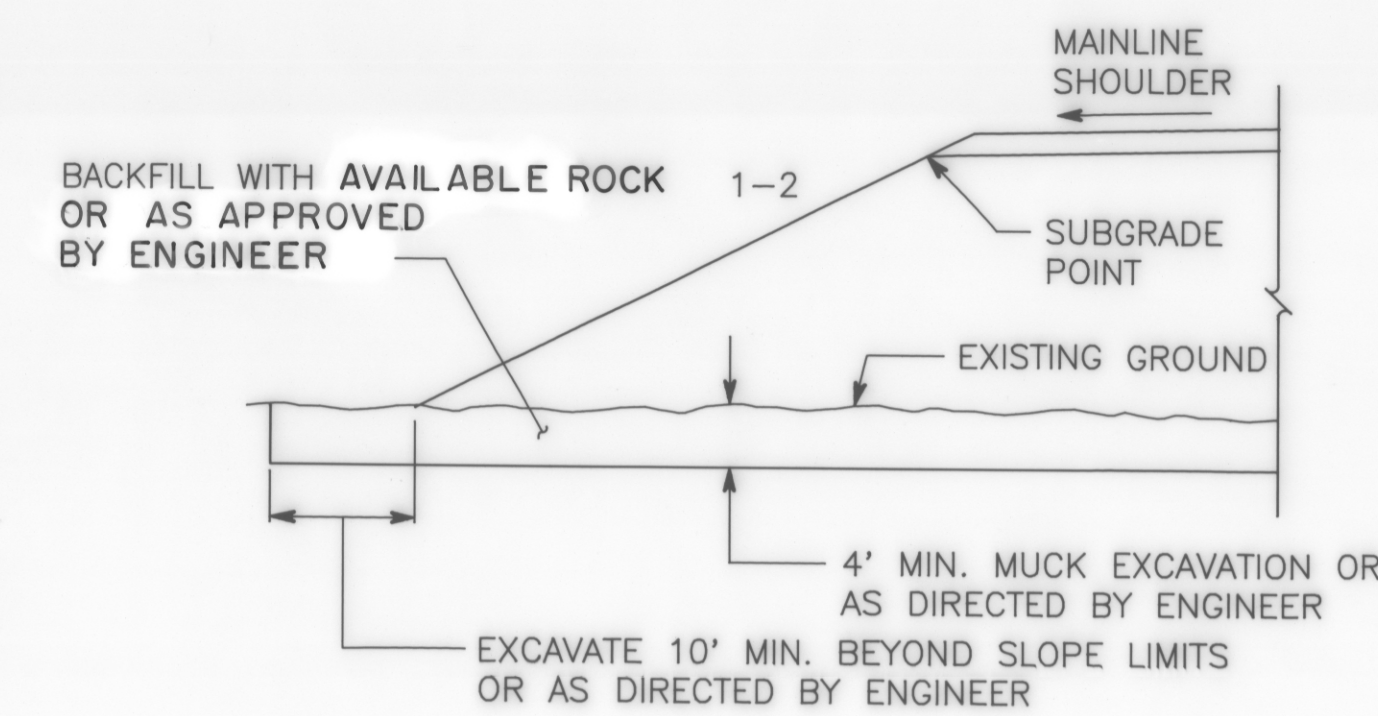

MUCK EXCAVATION
N.T.S.

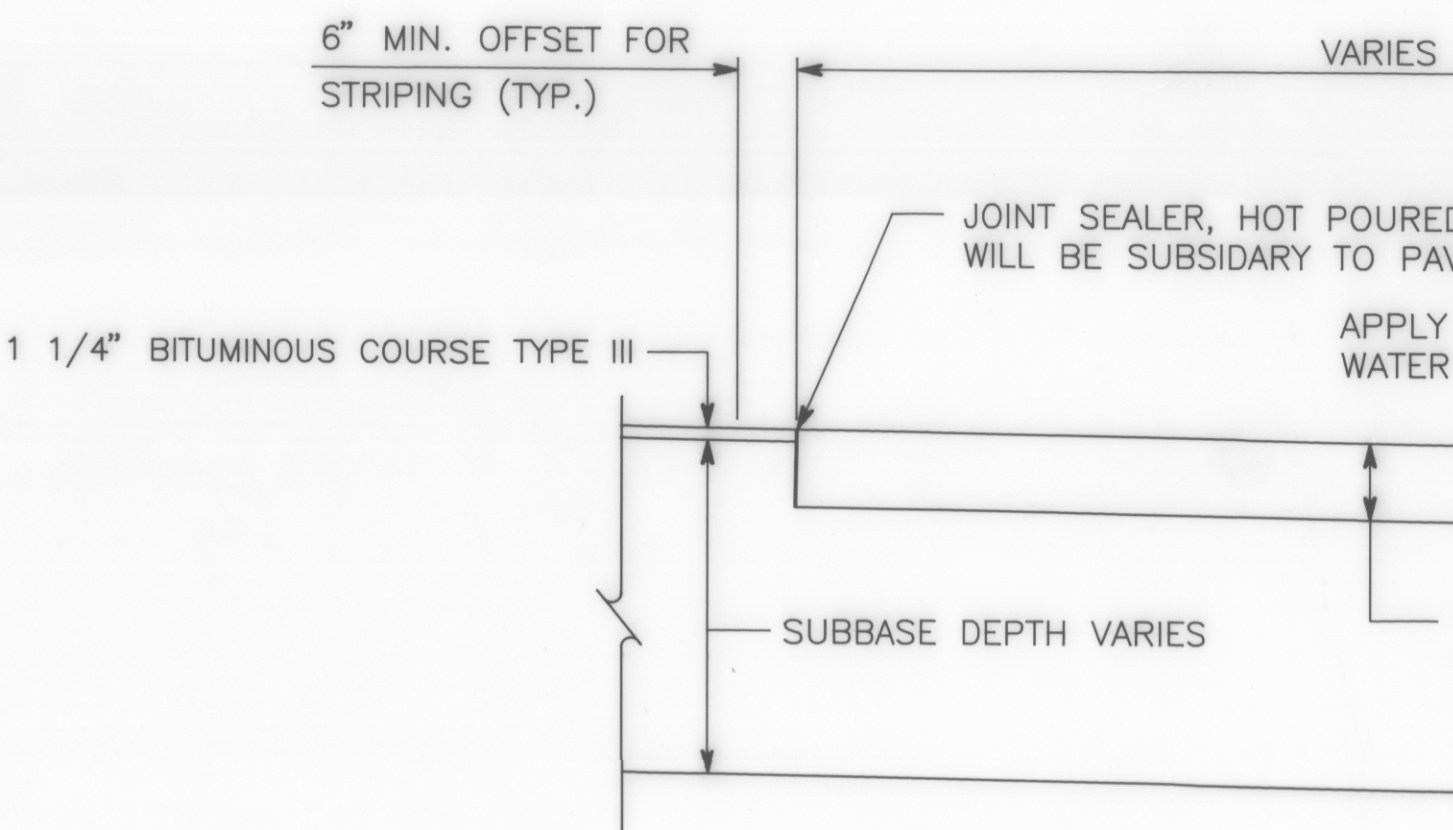

FLUSH CONCRETE
N.T.S.