



PLAN	DATE	
	BY	
NOTE BOOK	SURVEYED	
	PLANNED	
No.	ADJUSTMENT CHECKED	
	RT. OF WAY CHECKED	

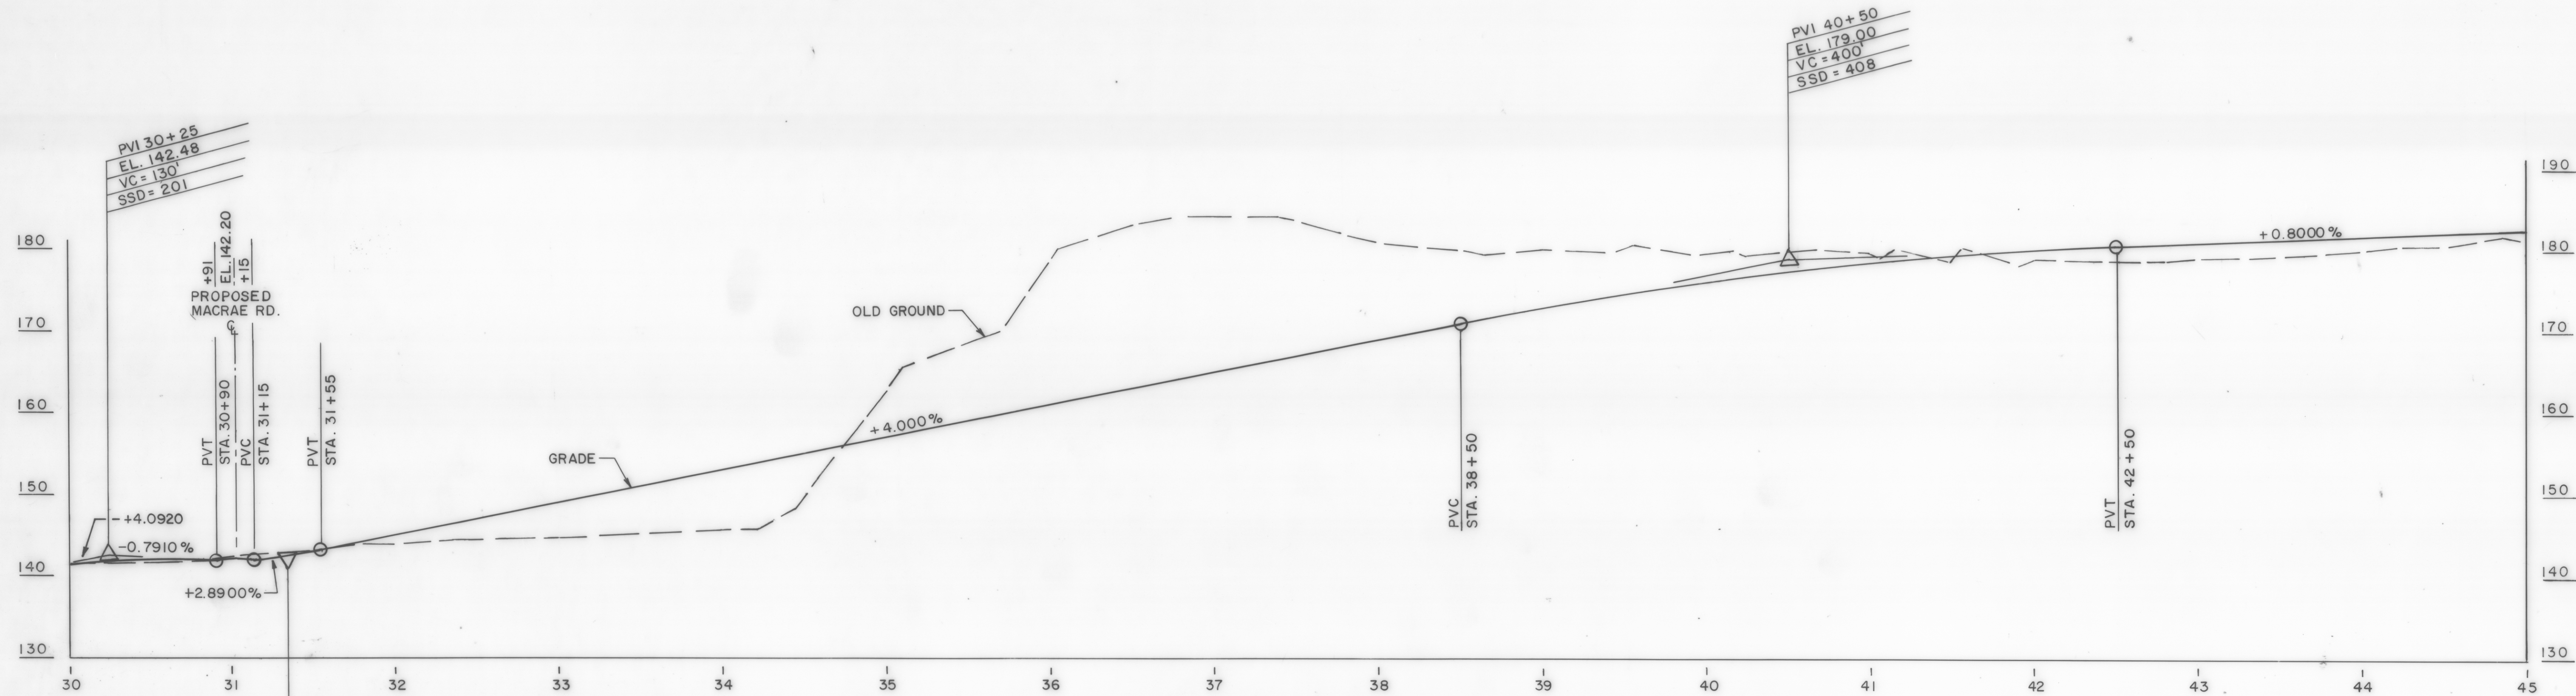

BIKEWAY PROFILE

SCALE: 1"=50' H
1"=10' V

PROFILE	DATE	
	BY	
NOTE BOOK	SURVEYED	
	PLANNED	
No.	ADJUSTMENT CHECKED	
	STRUCTURE NOTATIONS CHECKED	

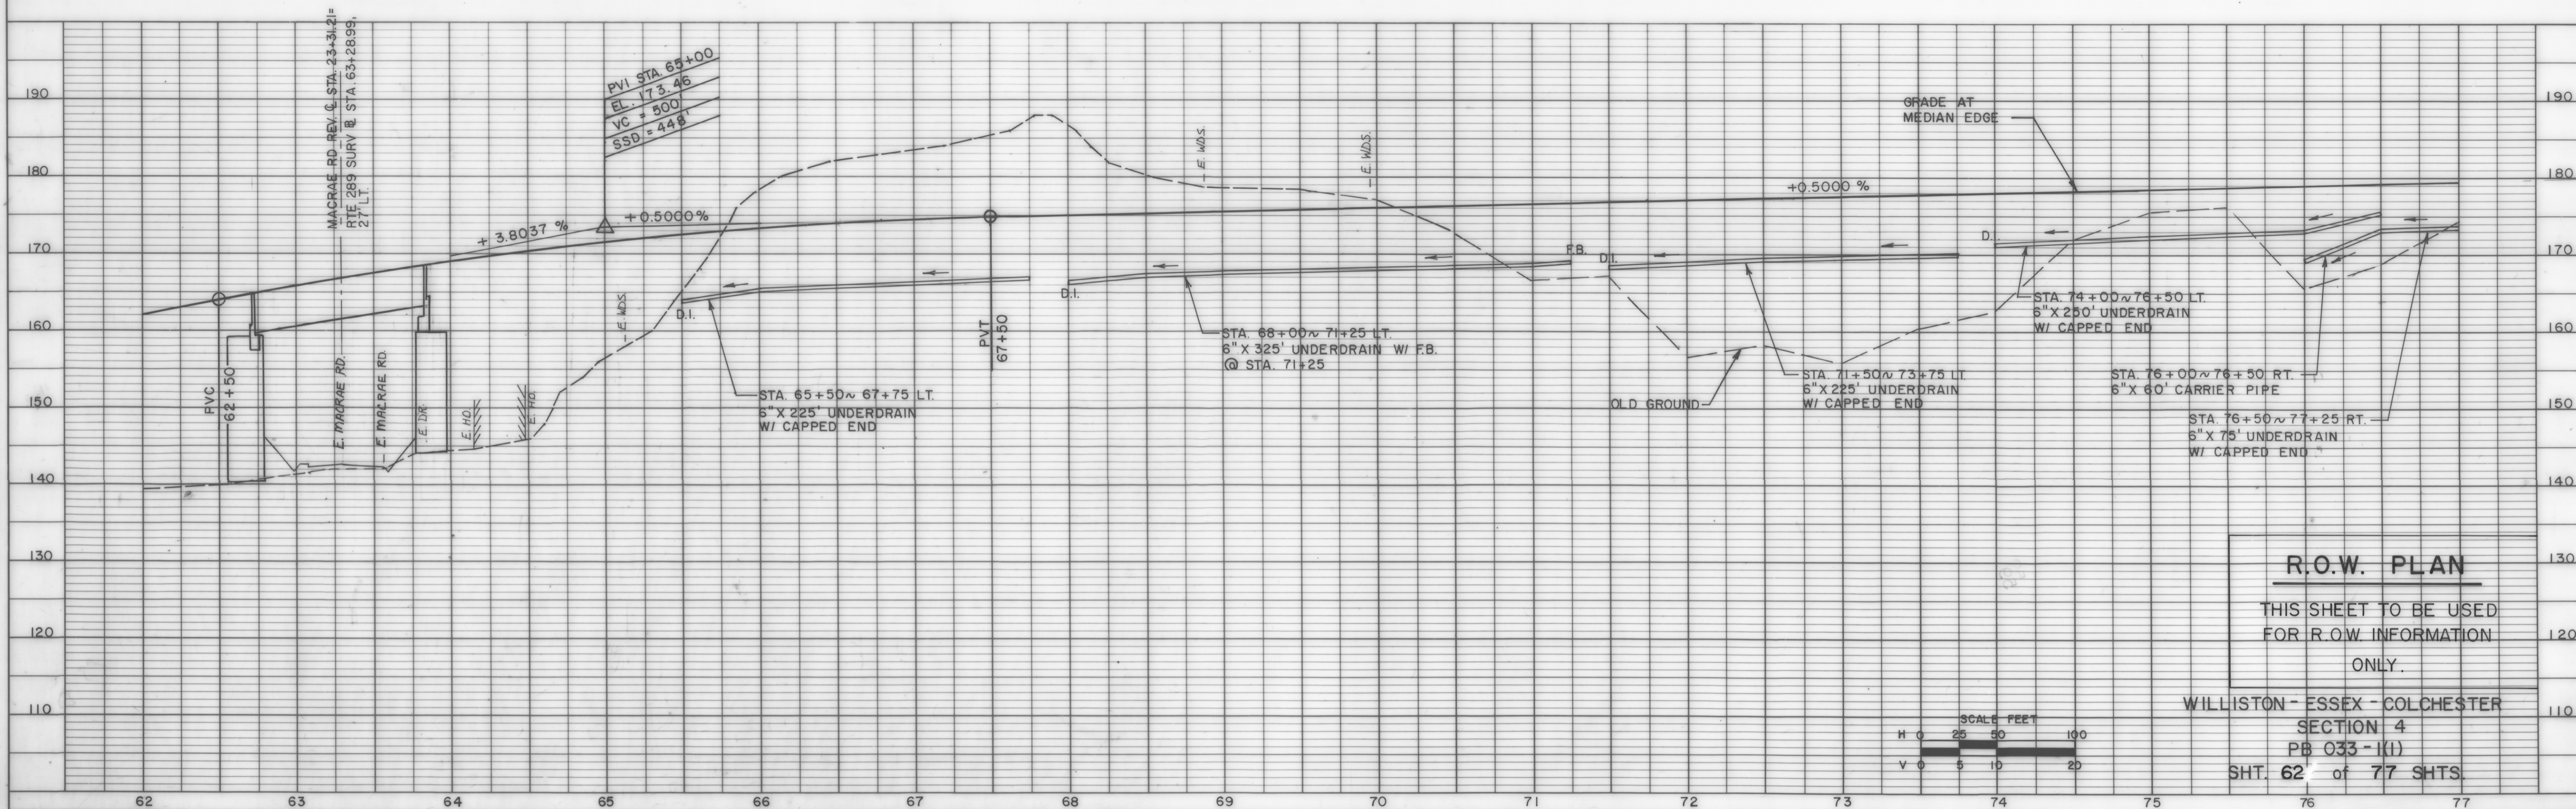

R.O.W. PLAN

THIS SHEET TO BE USED
FOR R.O.W. INFORMATION
ONLY.

WILLISTON - ESSEX - COLCHESTER

SECTION 4

PB 033-1(1)

SHT. 62 of 77 SHTS.

