


PLAN	SURVEYED NOTED BY	DATE	BY	DATE
NOTE BOOK No.	SURVEYED NOTED BY	DATE	BY	DATE
No.	SURVEYED NOTED BY	DATE	BY	DATE



PROFILE	SURVEYED NOTED BY	DATE	BY	DATE
NOTE BOOK No.	SURVEYED NOTED BY	DATE	BY	DATE
No.	SURVEYED NOTED BY	DATE	BY	DATE

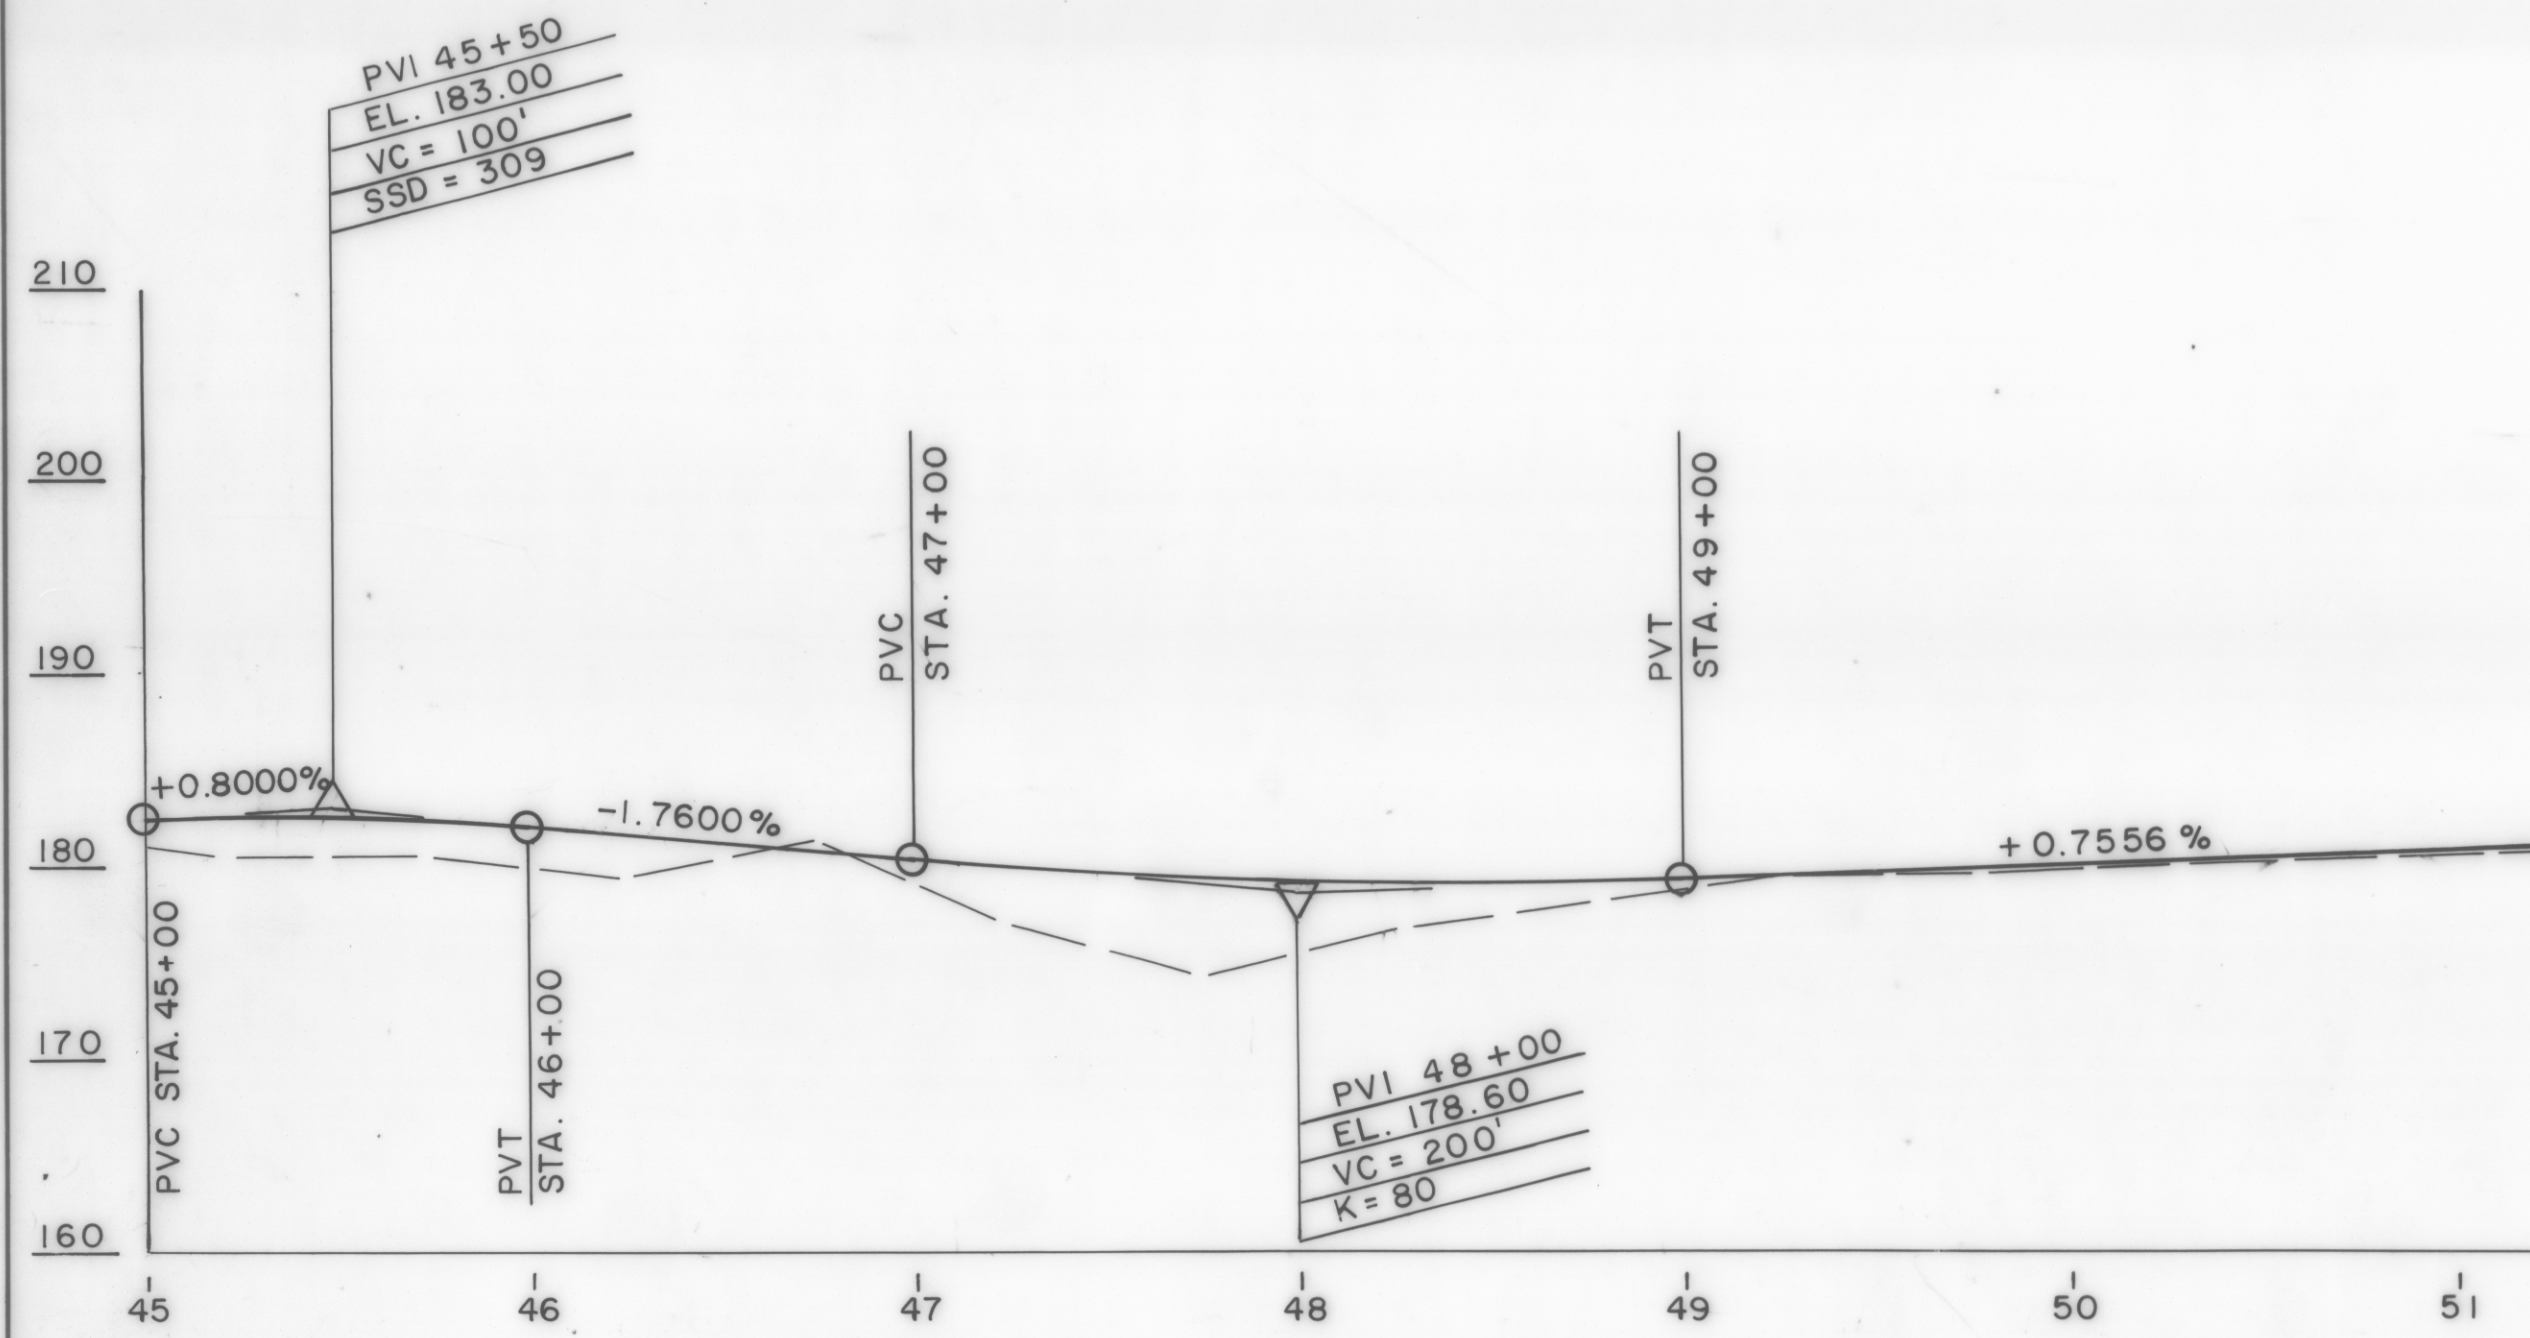