



PLAN	DATE	
	BY	
	SURVEYED	
	PLOTTED	
NOTE BOOK		
No.		

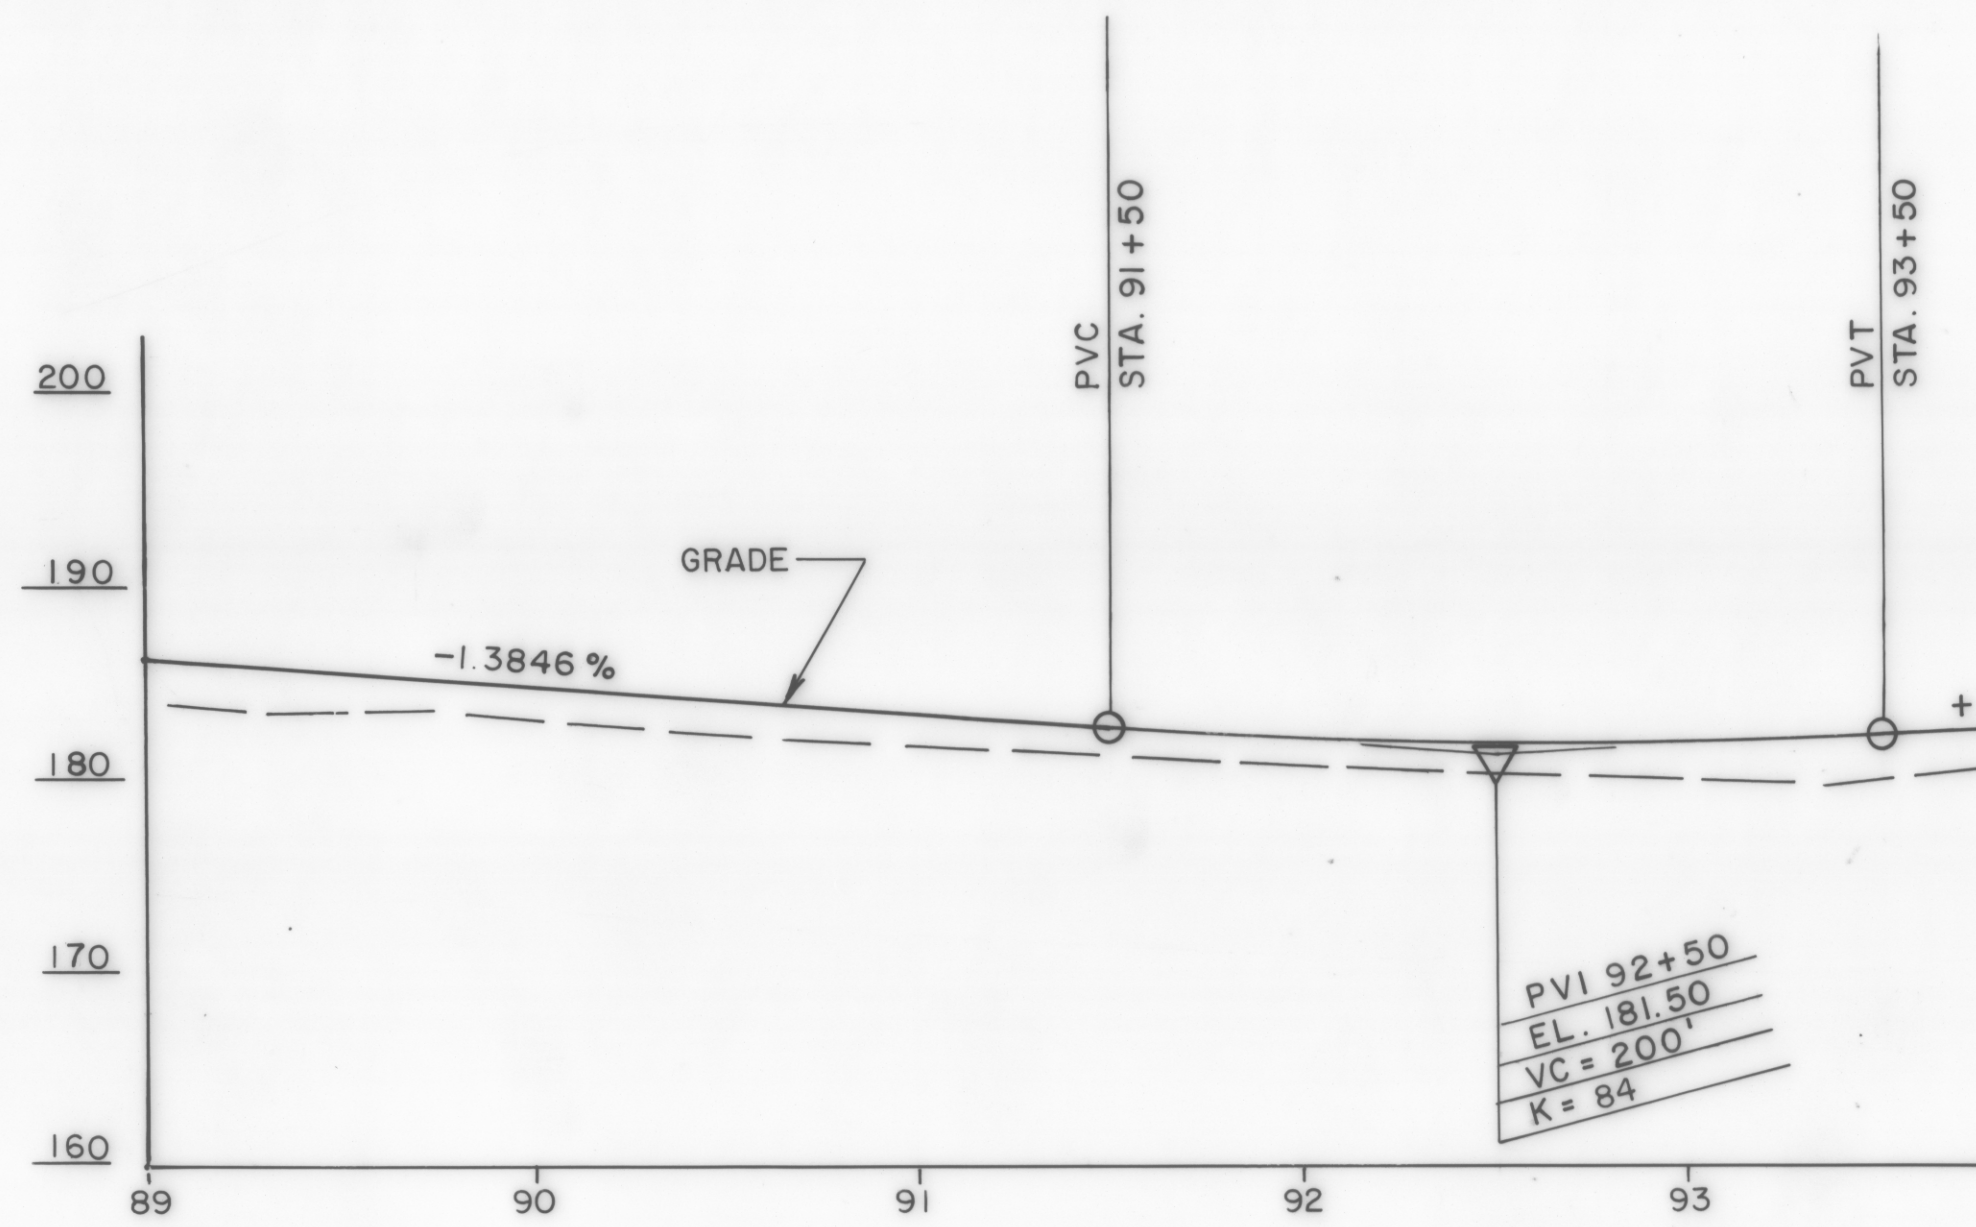

BIKEWAY PR
SCALE: 1" = 10'
1" = 10'

PROFILE	DATE	
	BY	
	SURVEYED	
	PLOTTED	
NOTE BOOK		
No.		

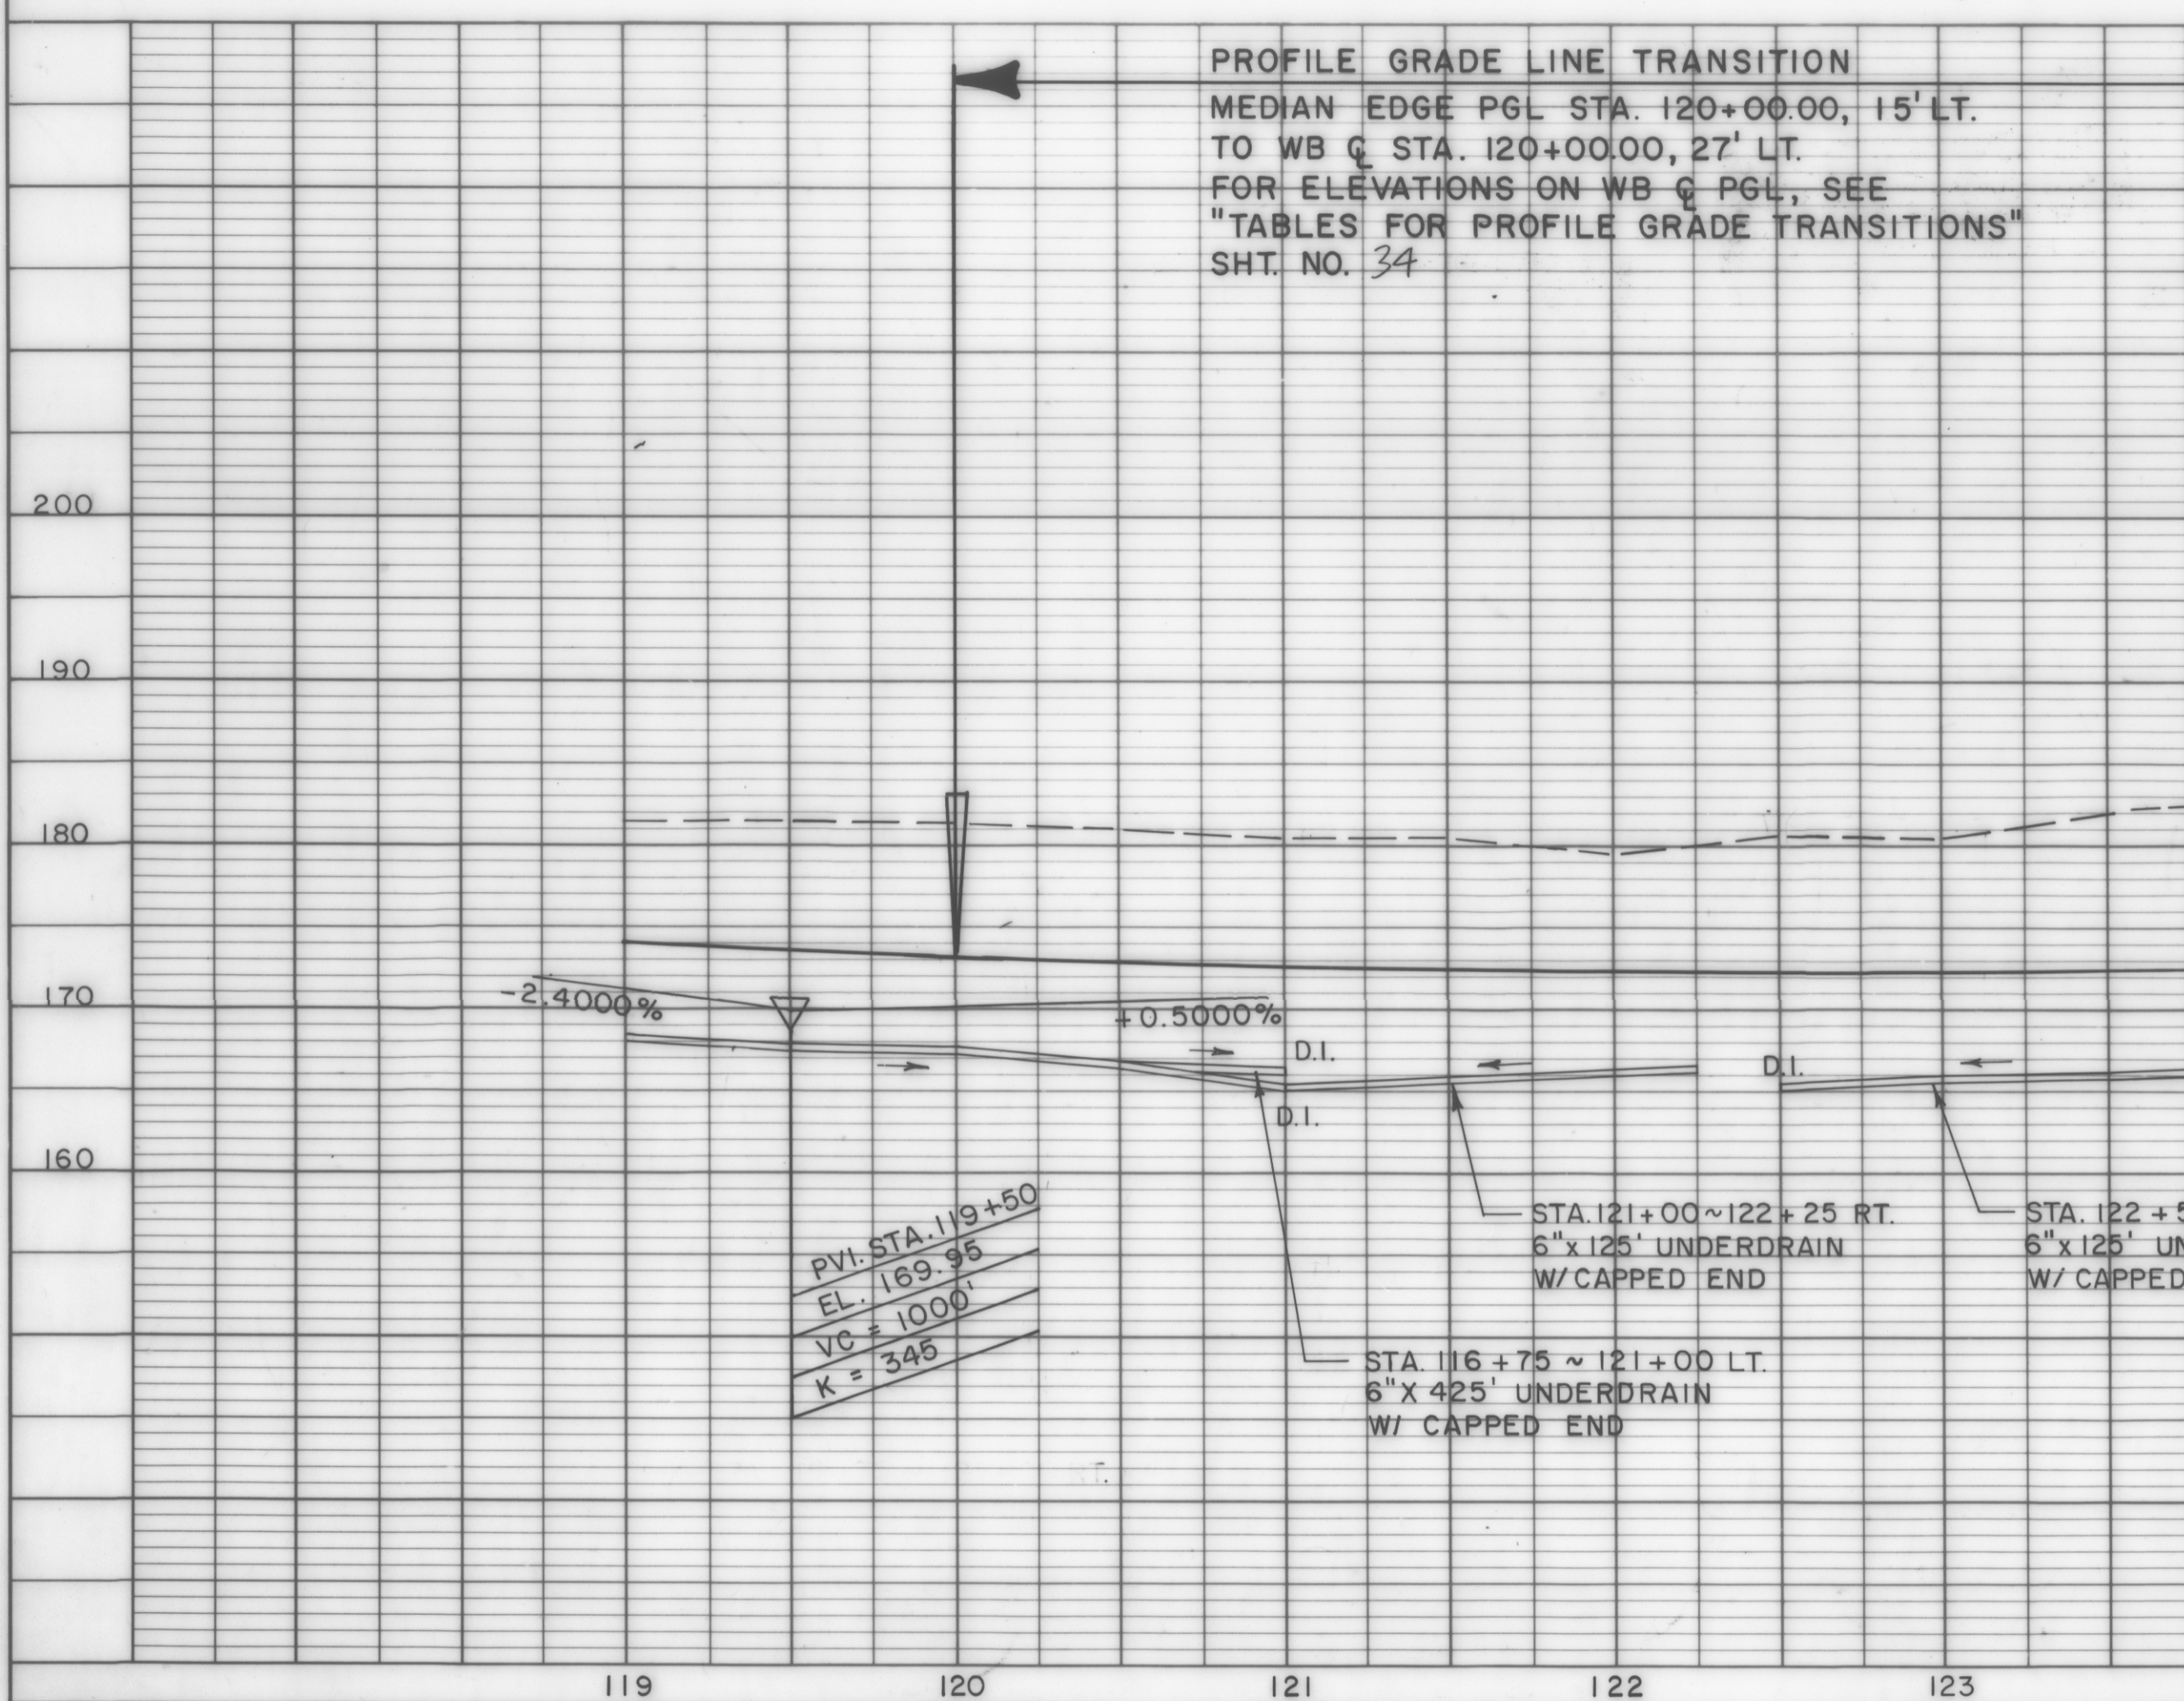

PROFILE GRADE LINE TRANSITION
MEDIAN EDGE PGL STA. 120+00.00, 15' LT.
TO WB C STA. 120+00.00, 27' LT.
FOR ELEVATIONS ON WB C PGL, SEE
"TABLES FOR PROFILE GRADE TRANSITIONS"
SHT. NO. 34