



PLAN	DATE	
	BY	
NOTE BOOK	SURVEYED	
	ALIGNED CHECKED	
No.	RT. OF WAY CHECKED	

PROFILE	DATE	
	BY	
NOTE BOOK	SURVEYED	
	ALIGNED CHECKED	
No.	RT. OF WAY CHECKED	

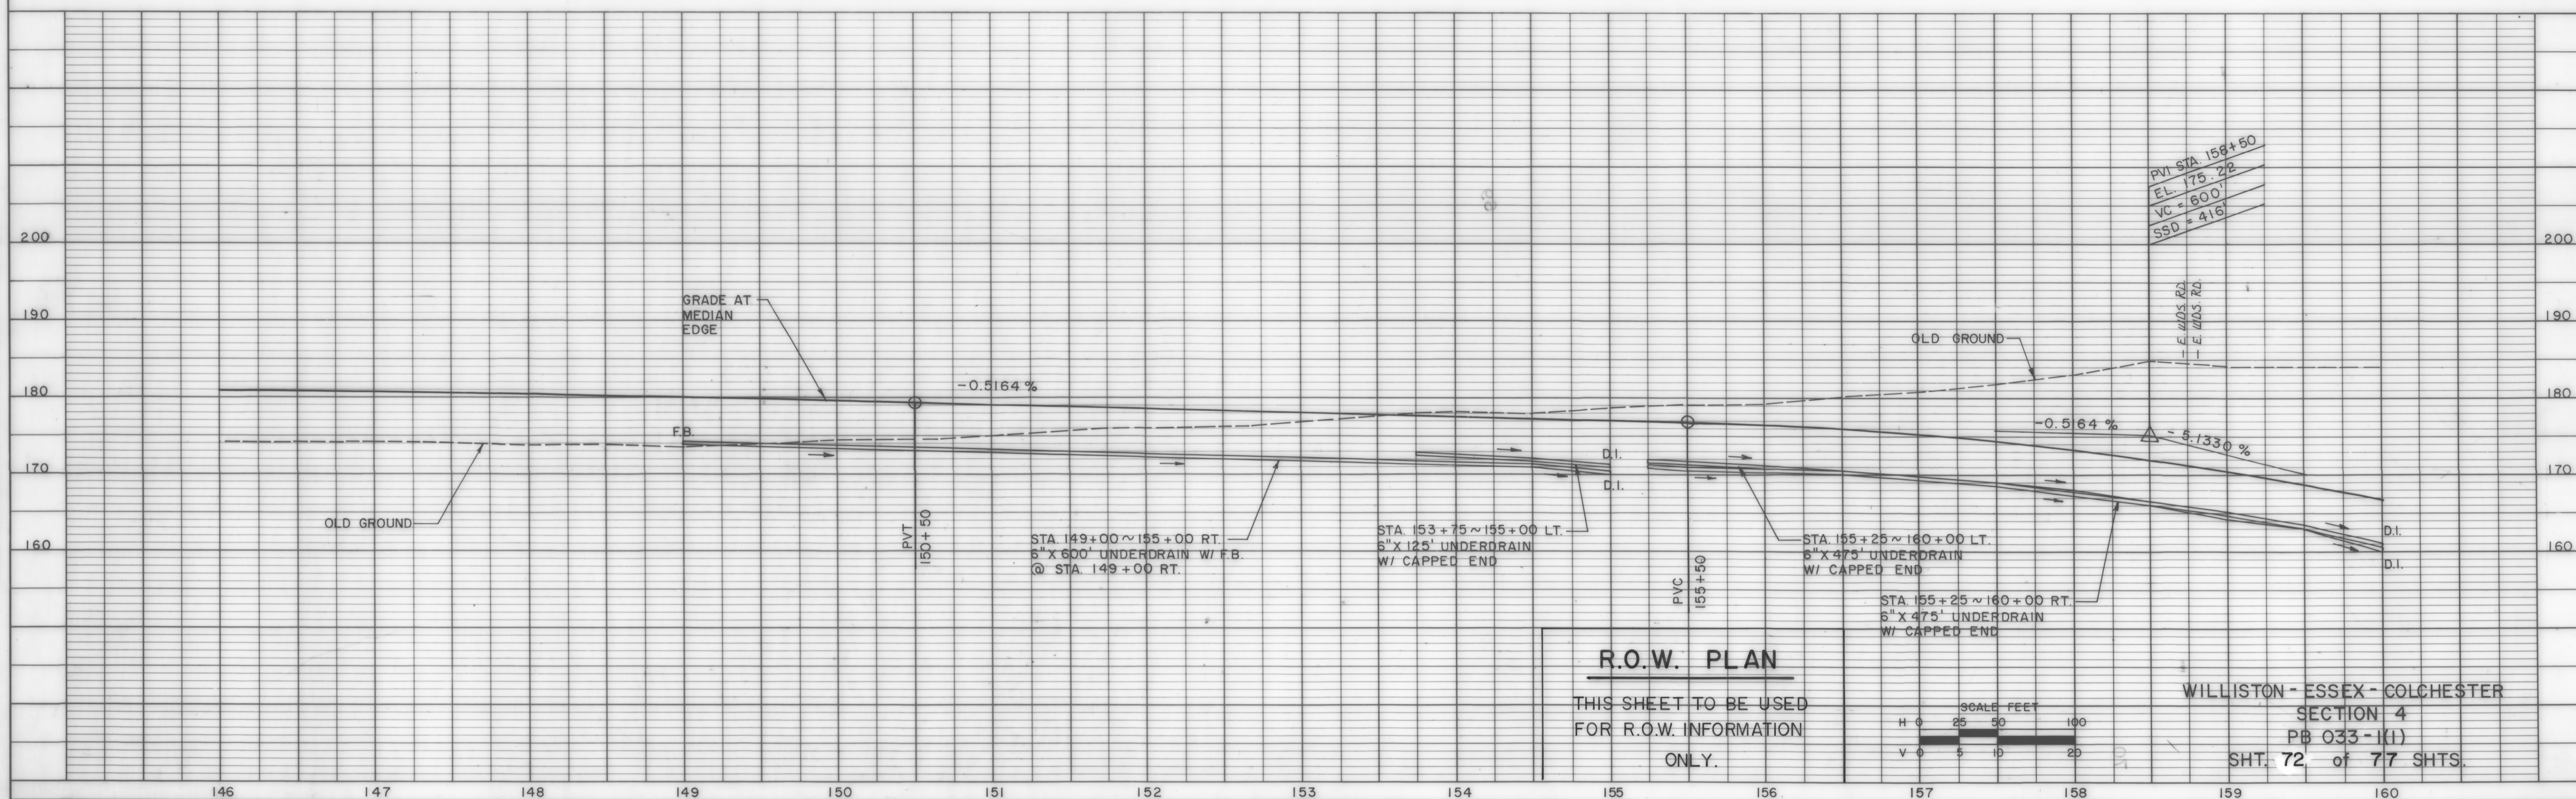

R.O.W. PLAN

THIS SHEET TO BE USED
FOR R.O.W. INFORMATION
ONLY.

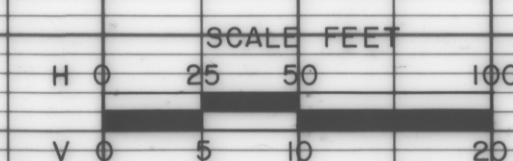

WILLISTON - ESSEX - COLCHESTER
SECTION 4
PB 033-1(1)
SHT. 72 of 77 SHTS.