
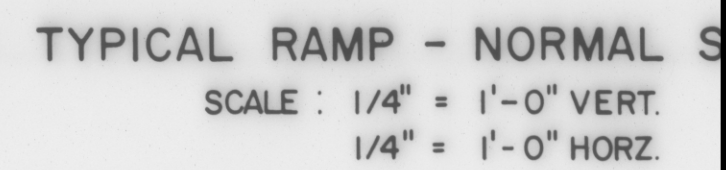


3" BITUMINOUS CONCRETE PAVEMENT - 1 1/4" TYPE III WEAR
3" BITUMINOUS CONCRETE PAVEMENT, TYPE I - BASE CO
30" SUBBASE OF DENSE GRADED CRUSHED STONE
SHOULDERS 1 1/4" BITUMINOUS CONCRETE PAVEMENT
18" SAND BORROW

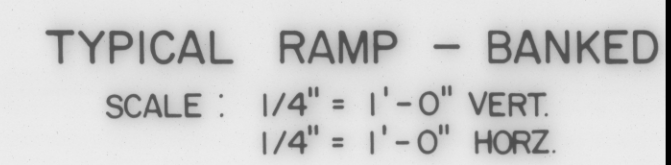

DATUM _____

VERTICAL _____

HORIZONTAL _____