


4' HIGH WOVEN WIRE FENCE

RTE 289 STA 732+00, 115' RT TO RTE 289 S
 RTE 289 STA 738+76, 115' RT TO RAMP D S
 RAMP D STA 3+30, 60' RT TO RAMP D STA
 RTE 289 STA 732+00, 110' LT TO RTE 289 S
 RTE 289 STA 733+82, 112' LT TO RTE 289 S
 RTE 289 STA 737+00, 165' LT TO RTE 289 S

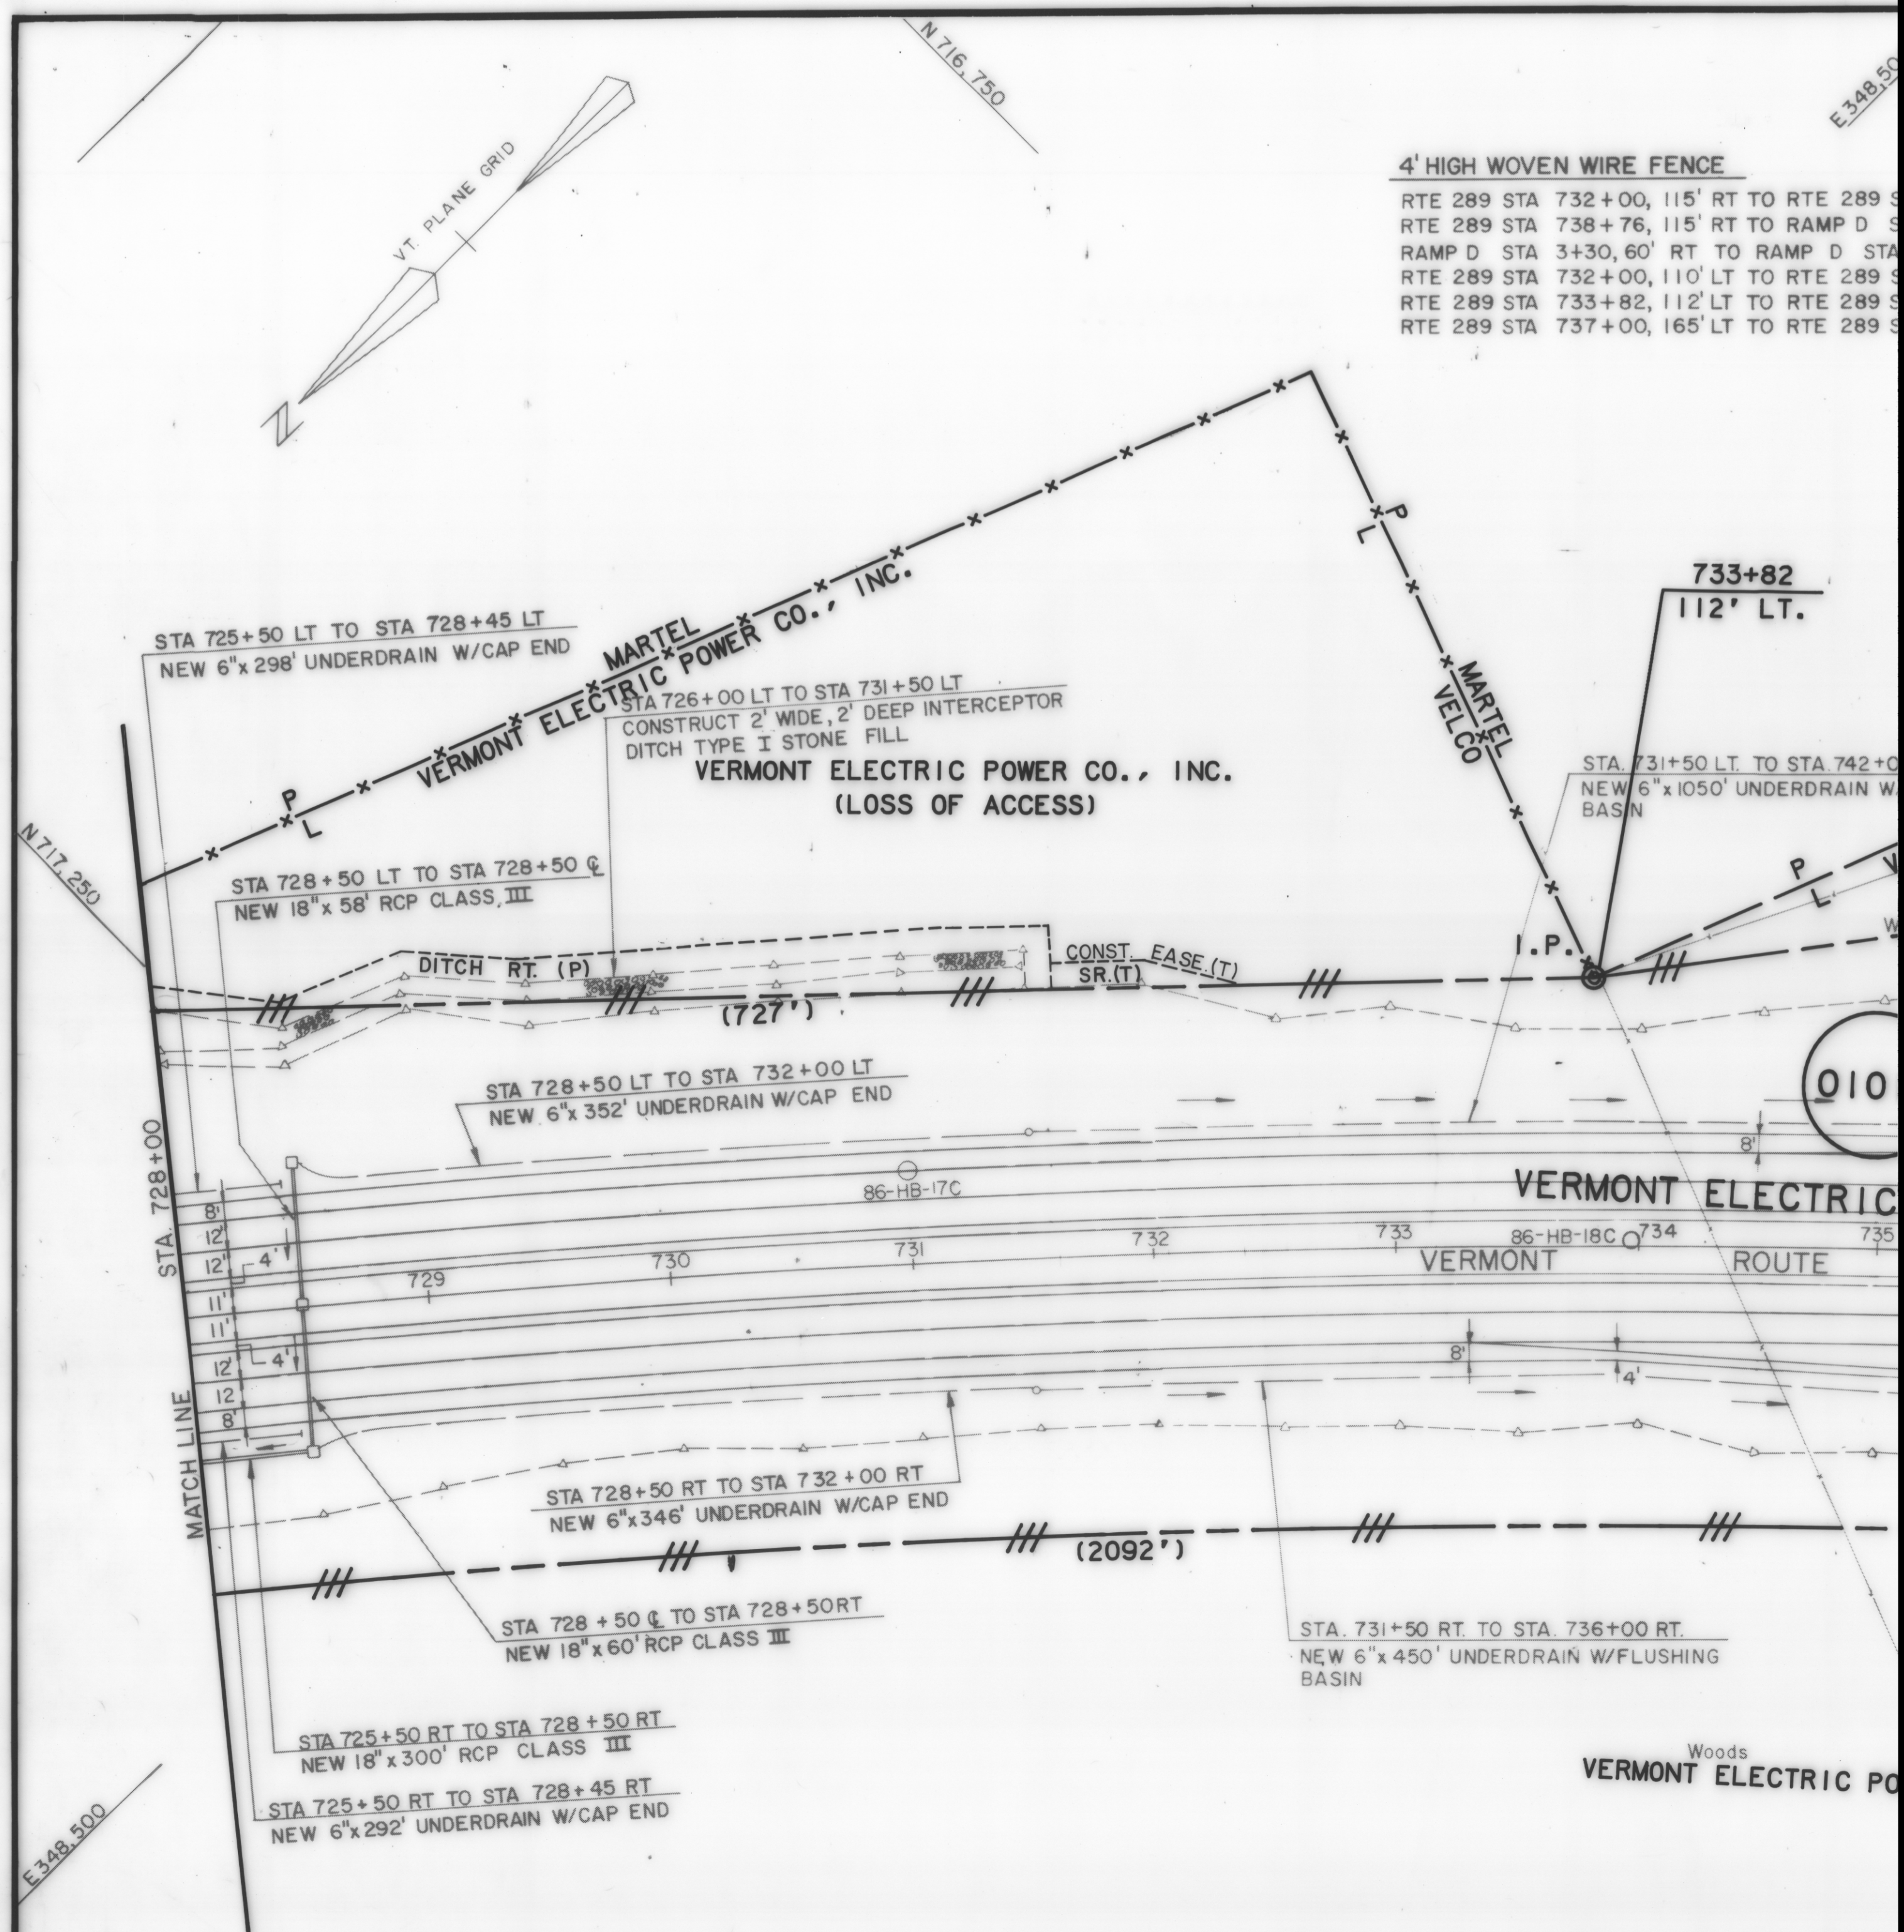

CURVE # 8 DATA RTE 289
 R = 6000'
 Δ = 29° 10' 11.04"
 L = 3054.65'
 T = 1561.19'
 E = 199.78'
 D = 0° 57' 17.75"

DATUM
 VERTICAL _____
 HORIZONTAL _____