


PROFILE	SURVEYED	DATE
	NOTED	
	GRADES CHECKED	
	B.M. # NOTED	
NO.	STRUCTURE	NOTATION CHNO



PROFILE	SURVEYED	DATE
	NOTED	
	GRADES CHECKED	
	B.M. # NOTED	
NO.	STRUCTURE	NOTATION CHNO

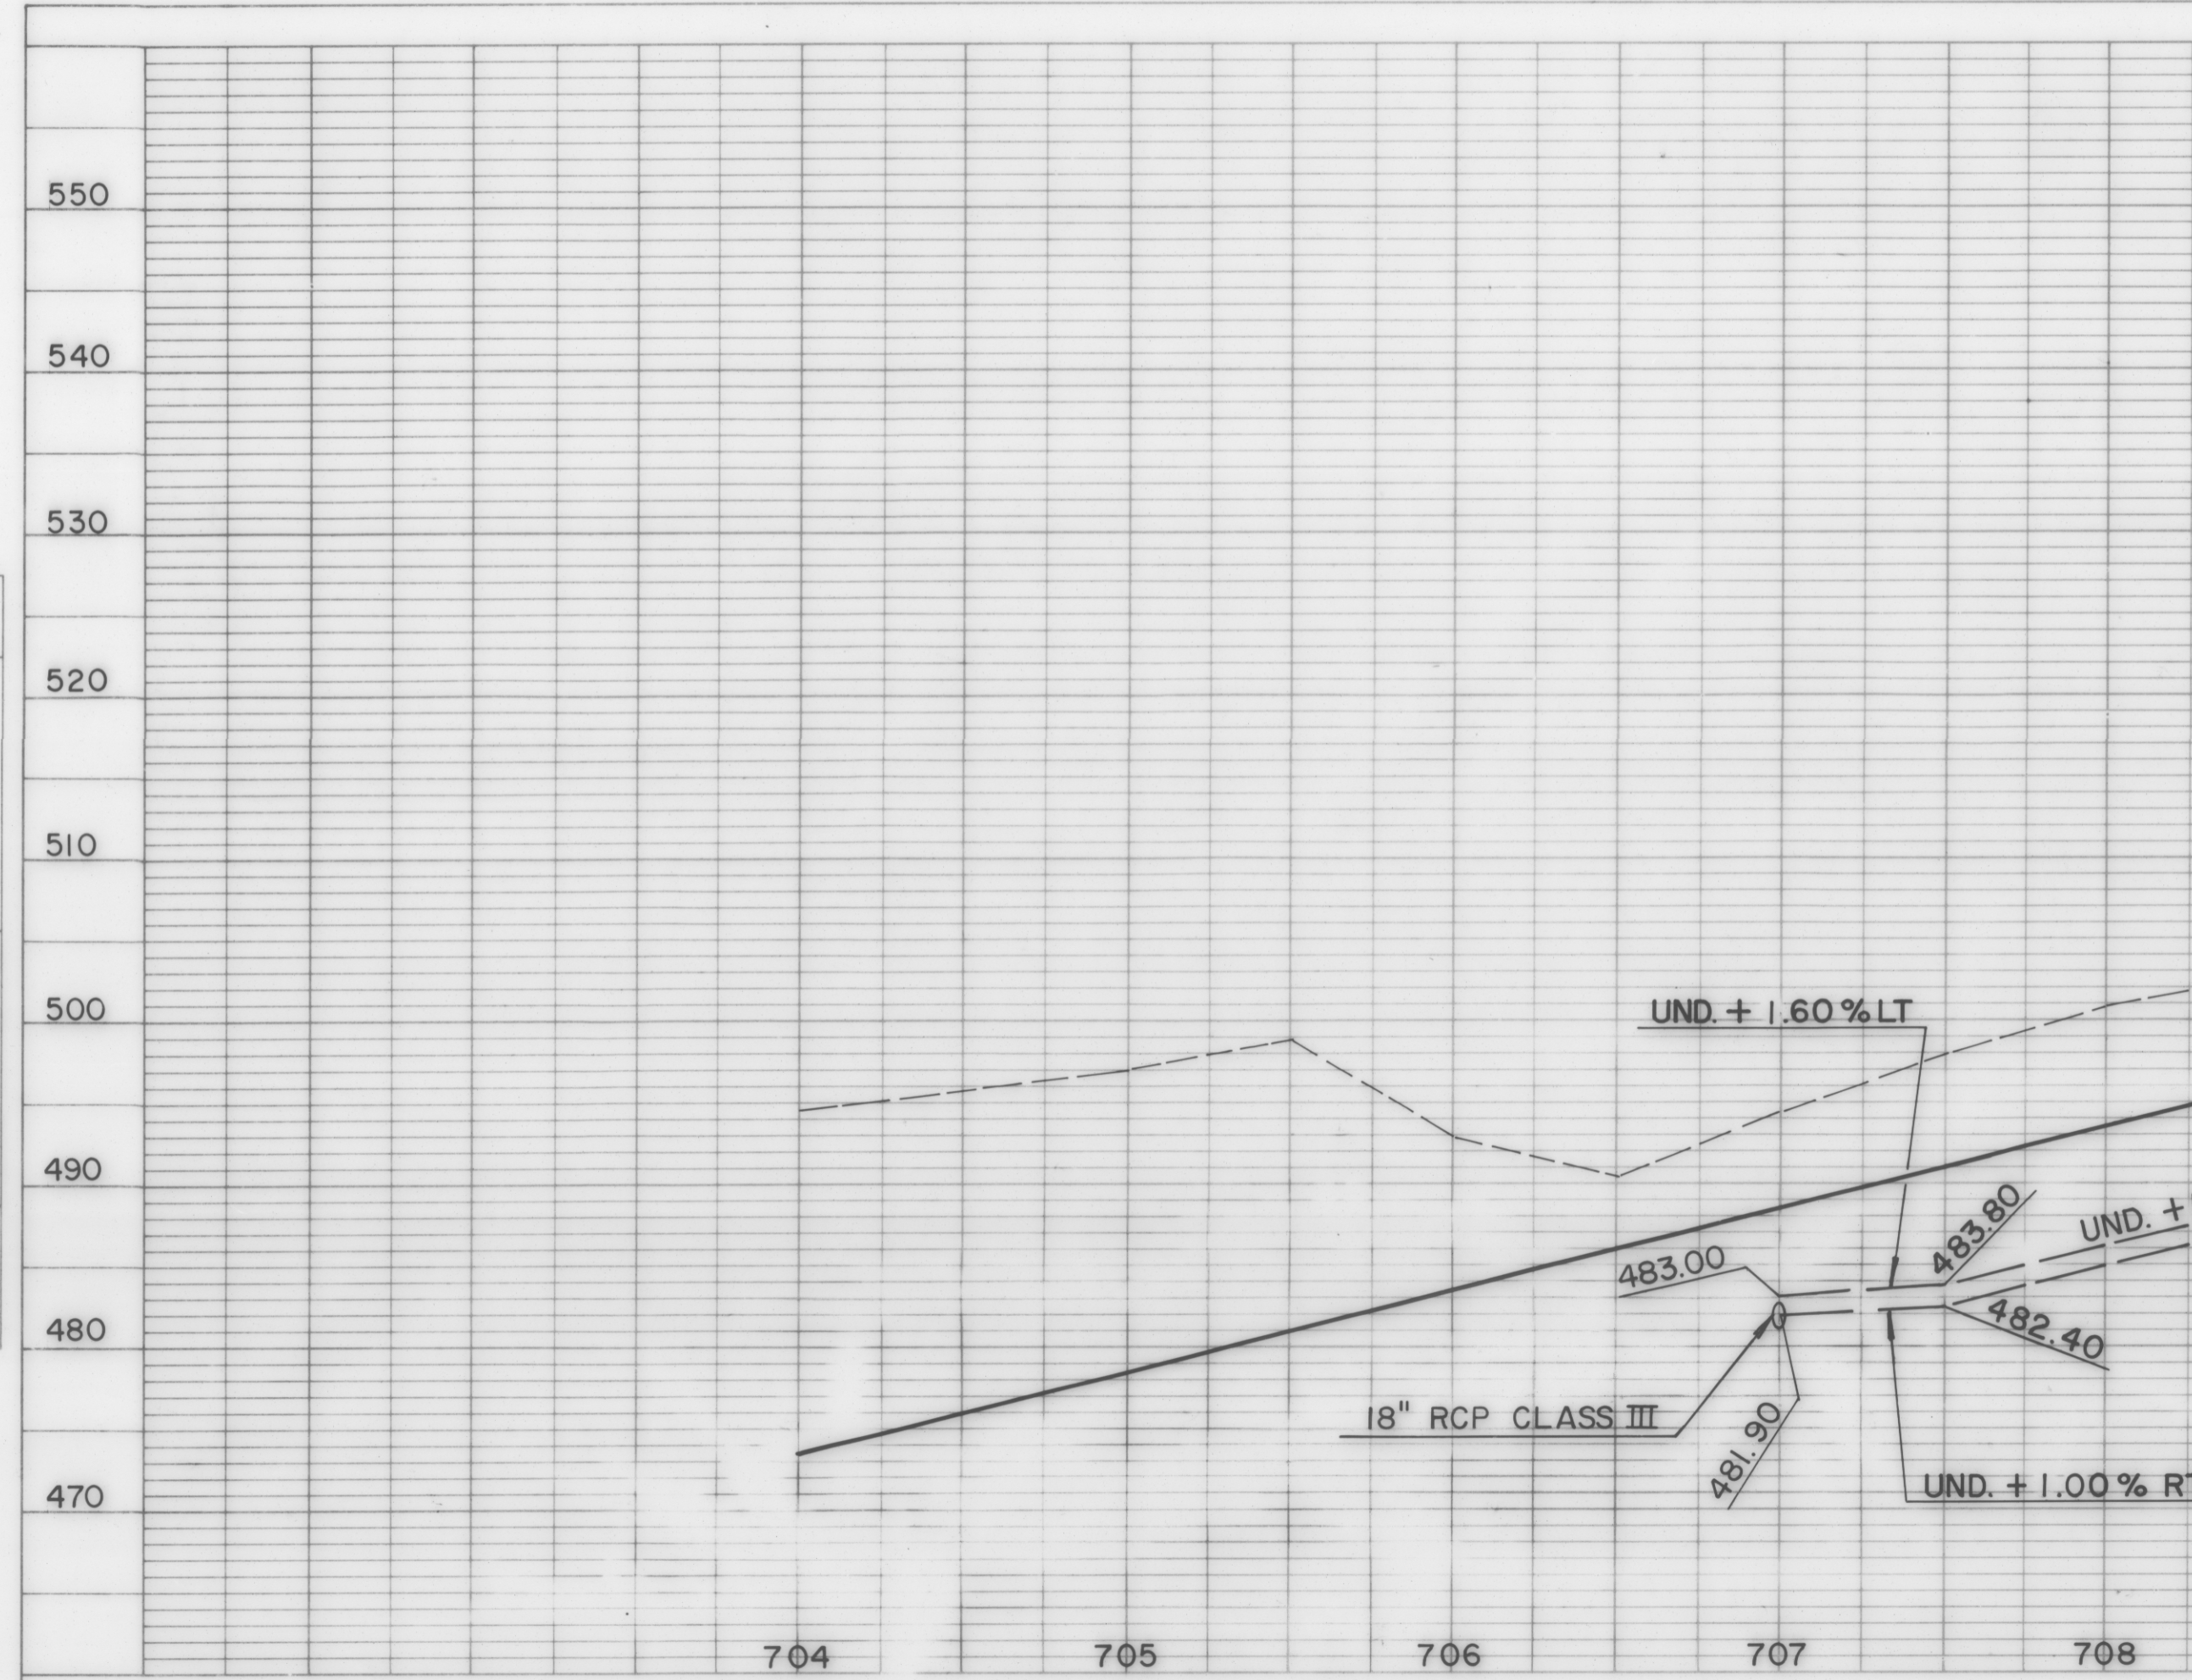