


PROFILE		DATE
SURVEYED	BY	
NOTED		
GRADES CHECKED		
B.M.'s NOTED		
NO.	STRUCTURE	NOTATION CH'VD



PROFILE		DATE
SURVEYED	BY	
NOTED		
GRADES CHECKED		
B.M.'s NOTED		
NO.	STRUCTURE	NOTATION CH'VD

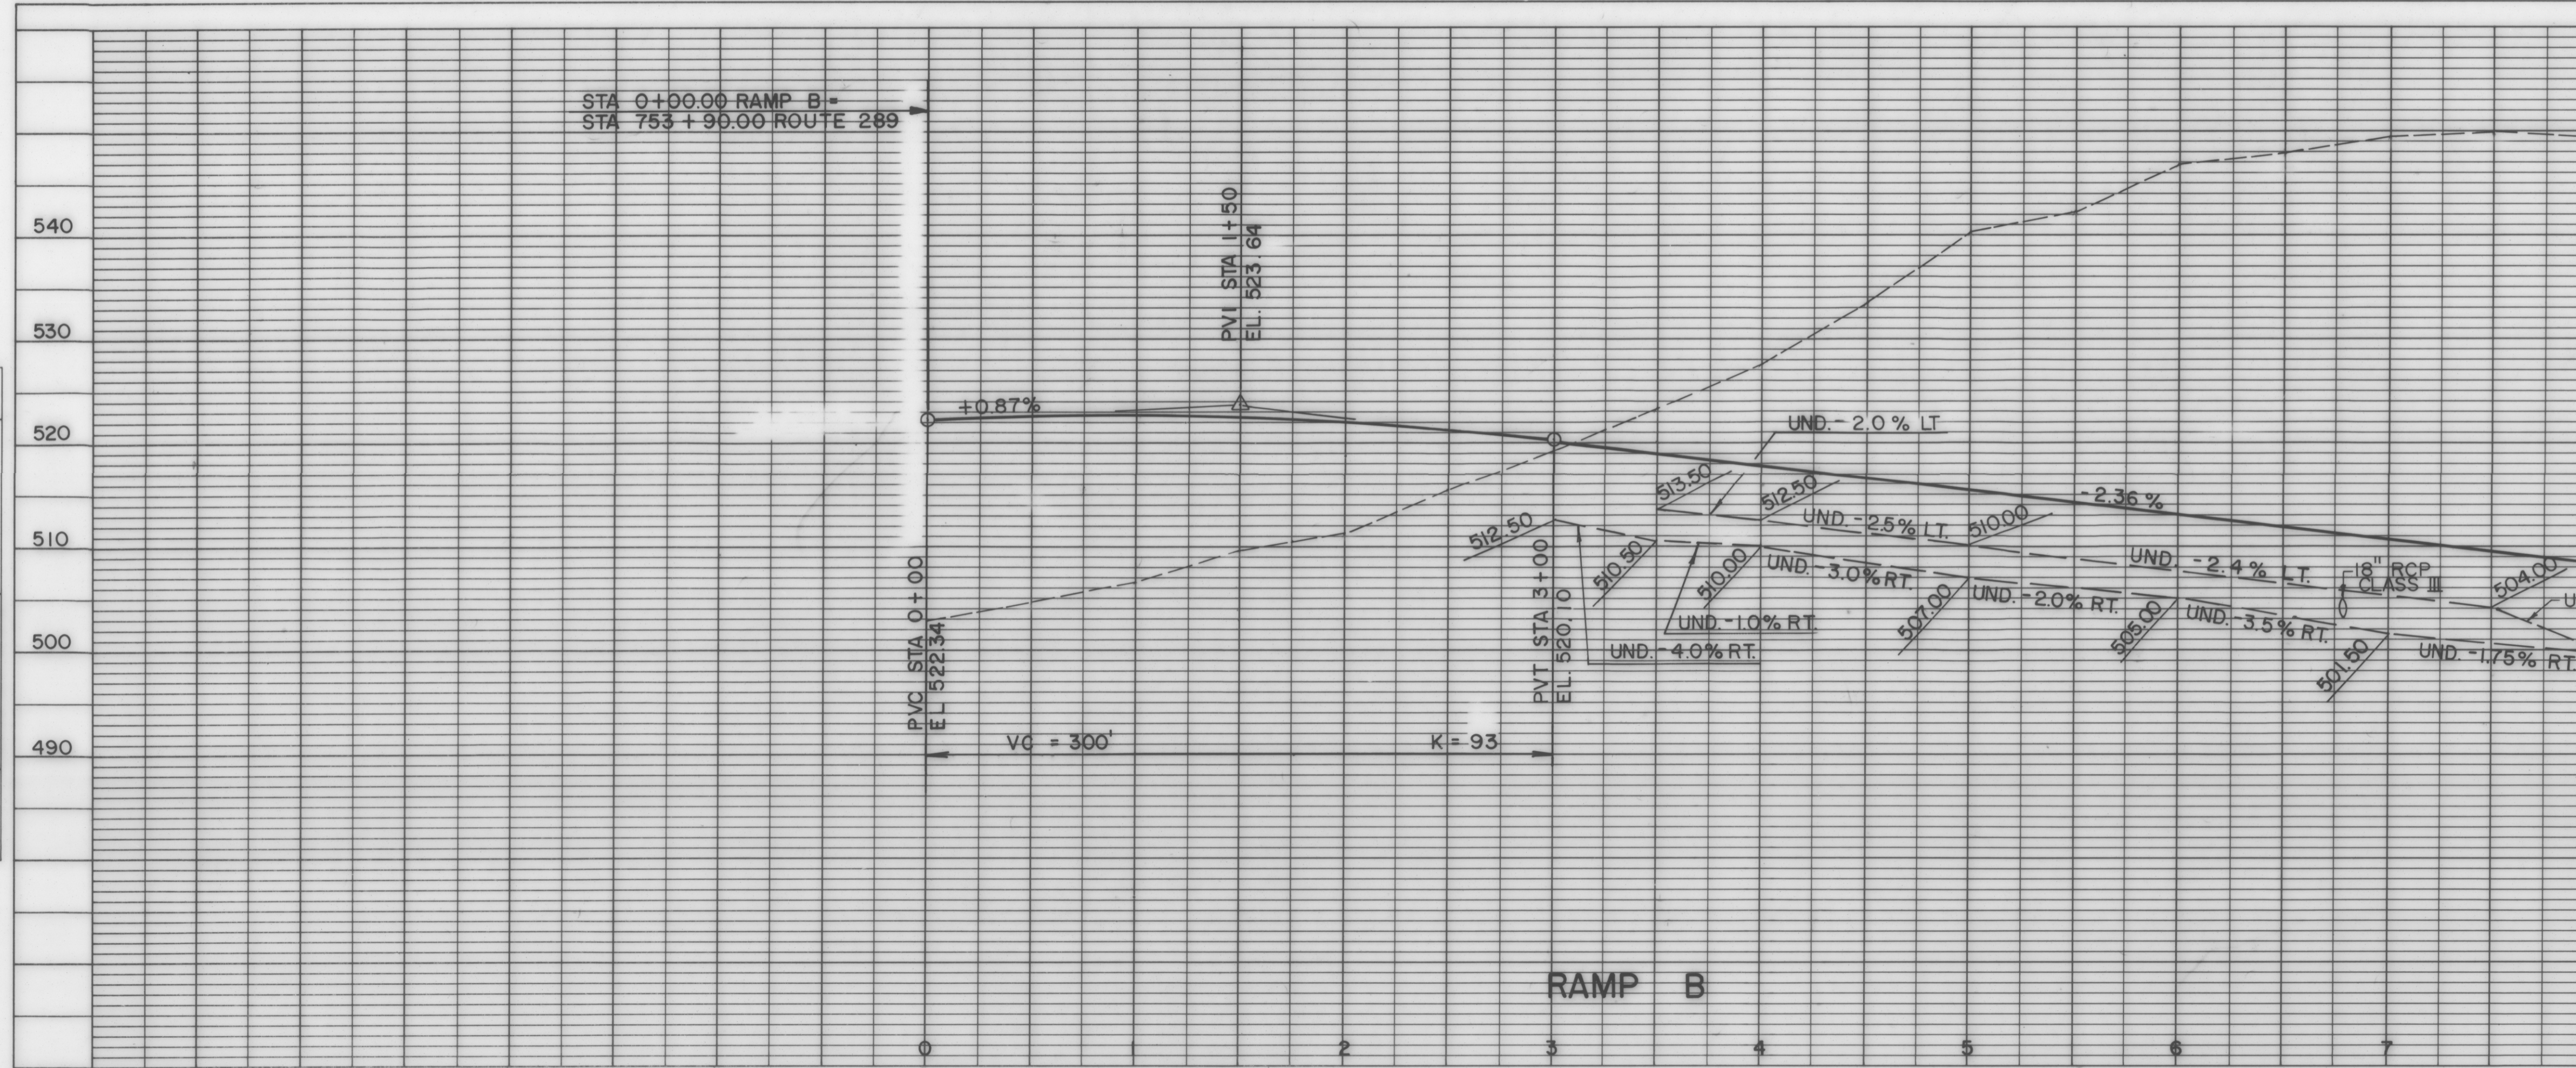