



TYPICAL SECT

3" BITUMINOUS CONCRETE PAVEMENT - 1 1/4" TYPE III WEARING
 3" BITUMINOUS CONCRETE PAVEMENT, TYPE I - BASE COURSE
 36" SUBBASE OF DENSE GRADED CRUSHED STONE
 SHOULDERS 1 1/4" BITUMINOUS CONCRETE PAVEMENT EXCEPT
 12" SAND BORROW

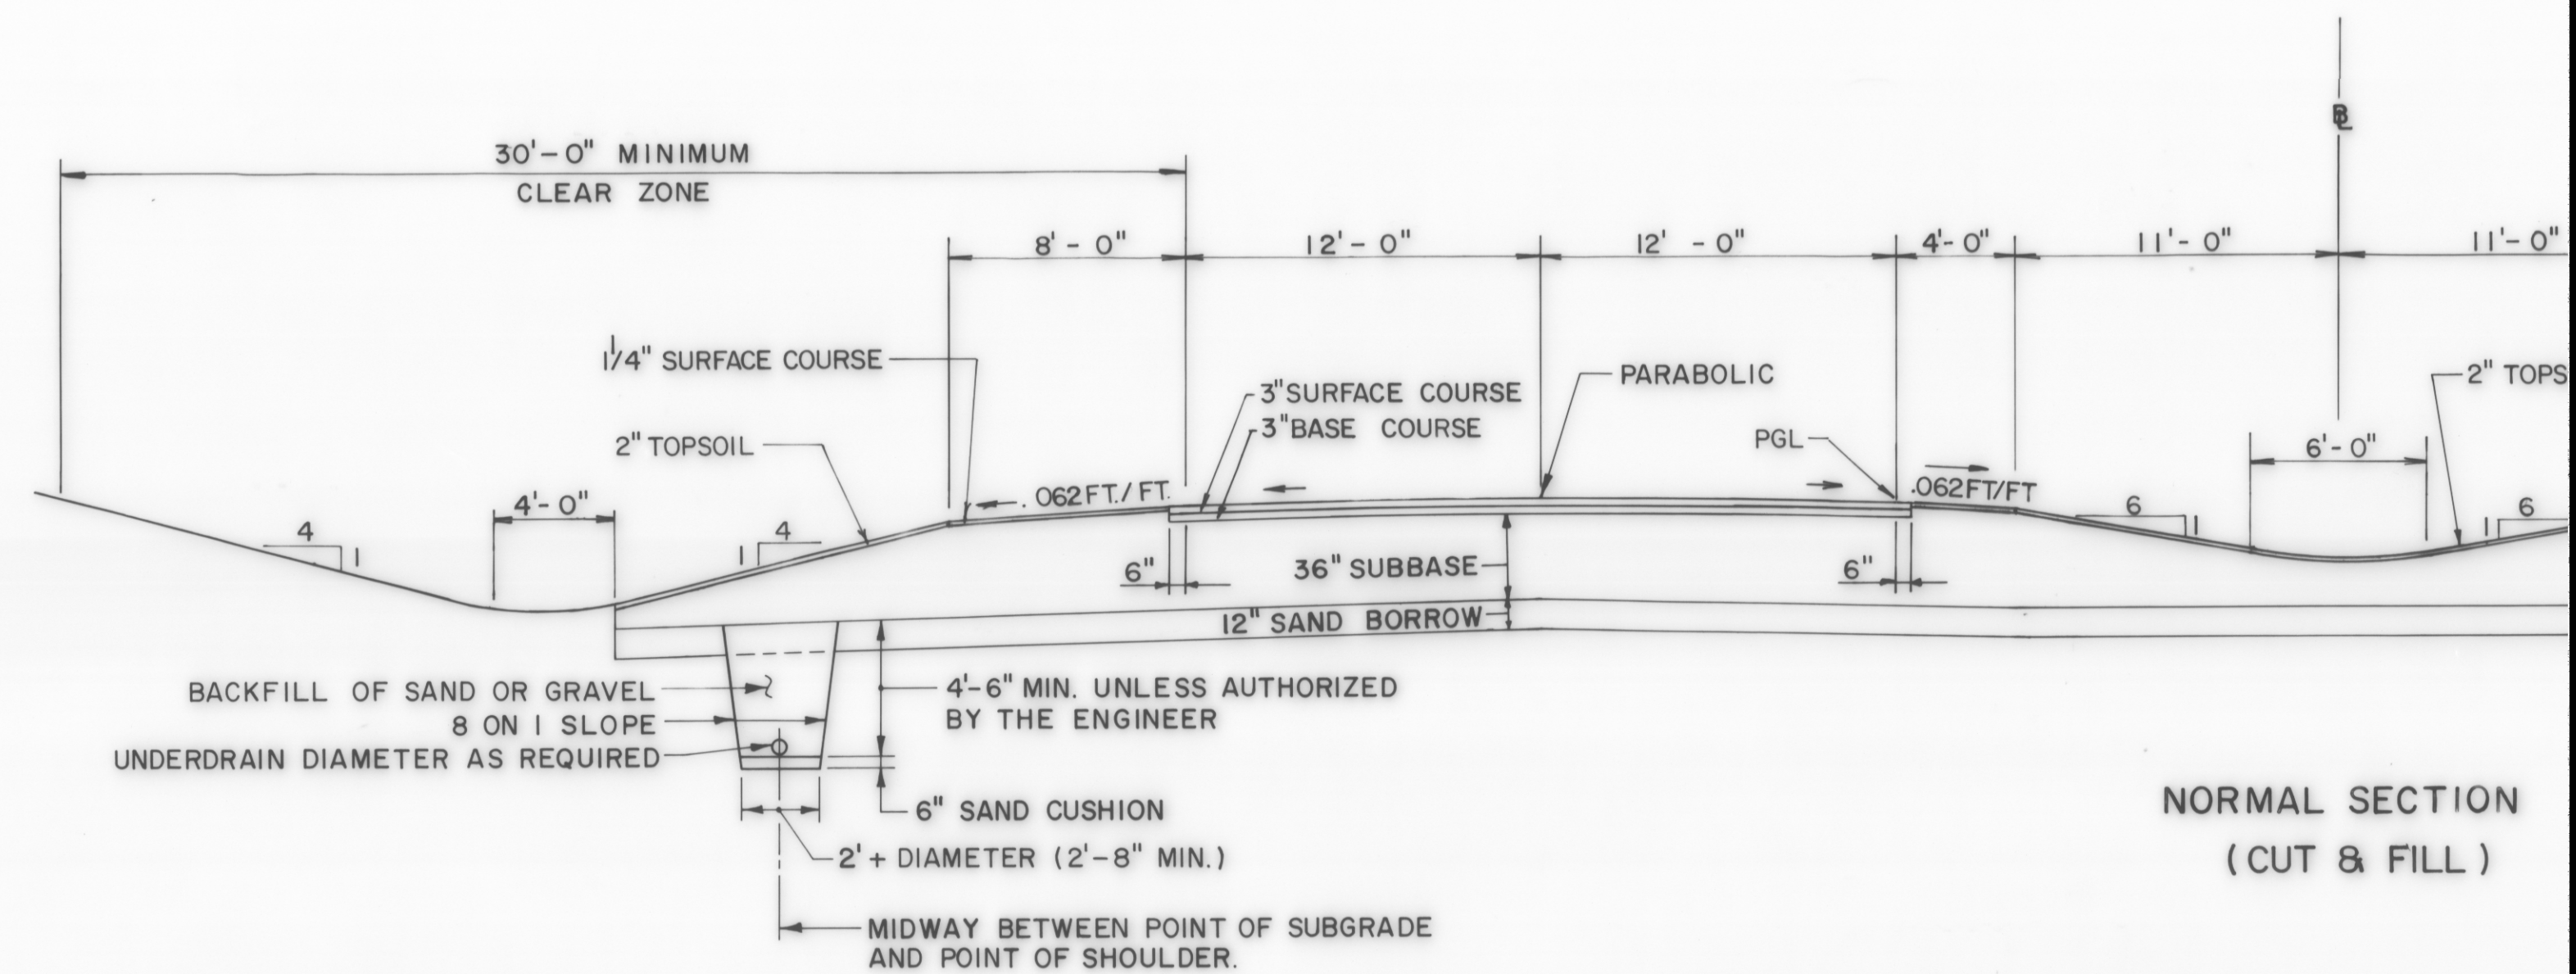

NORMAL SECTION
(CUT & FILL)

NOTE:
 UNDERDRAIN SHOULD BE PROVIDED WHERE THE SAND BORROW IS IN A BOX CUT, OR AS DIRECTED BY THE ENGINEER.

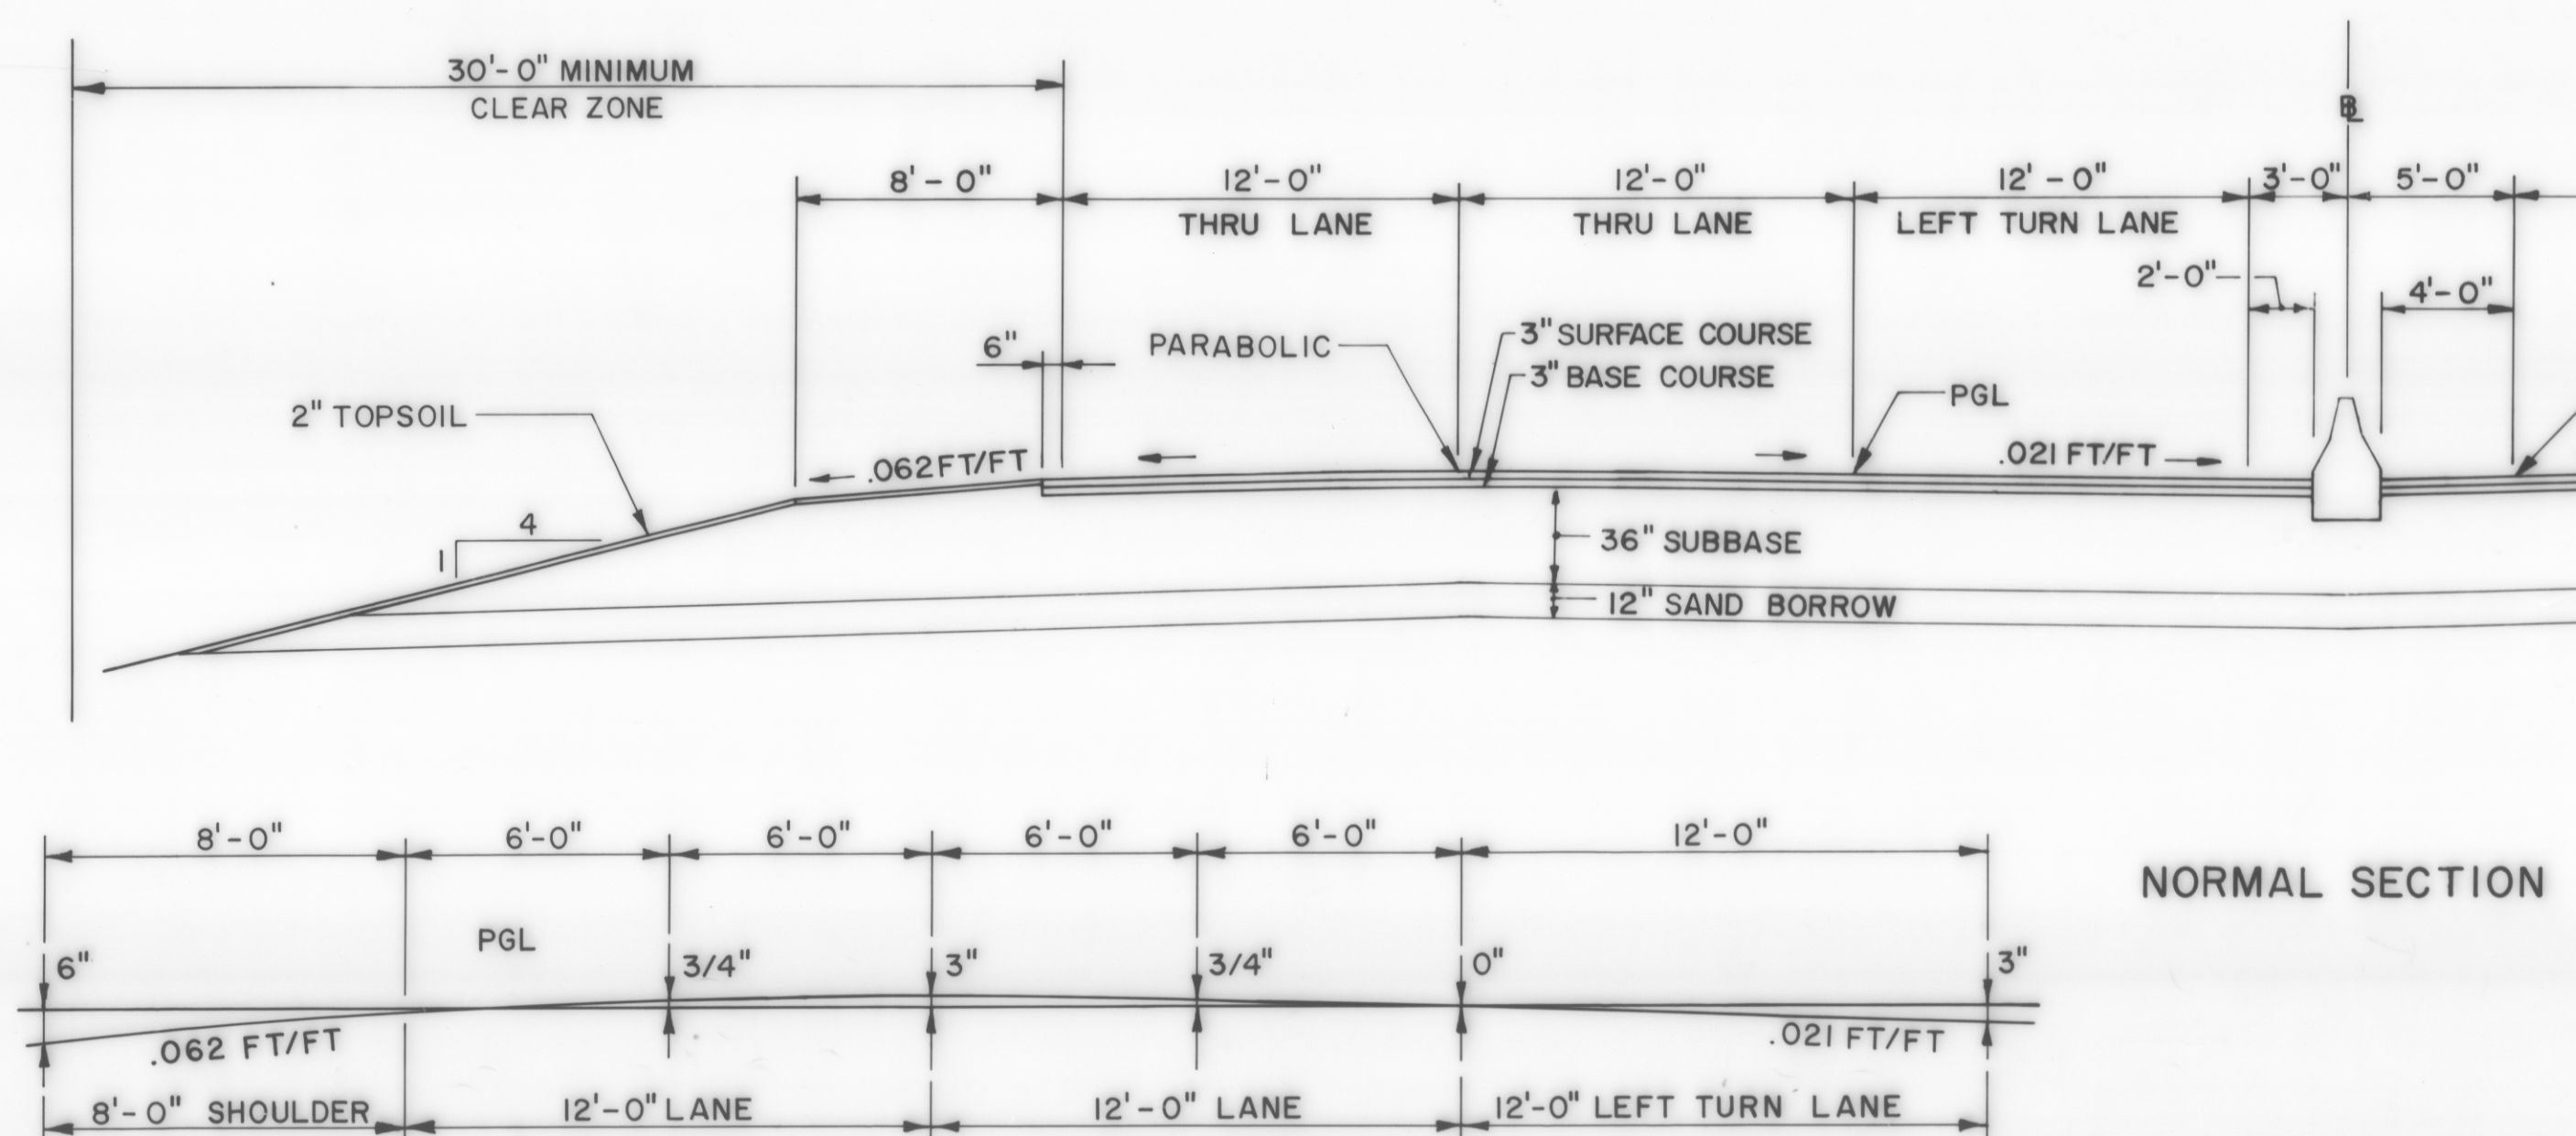

NORMAL SECTION

CROSS-SLOPE & PARABOLIC DETAIL

DATUM
 VERTICAL _____
 HORIZONTAL _____