



430
410
390
370

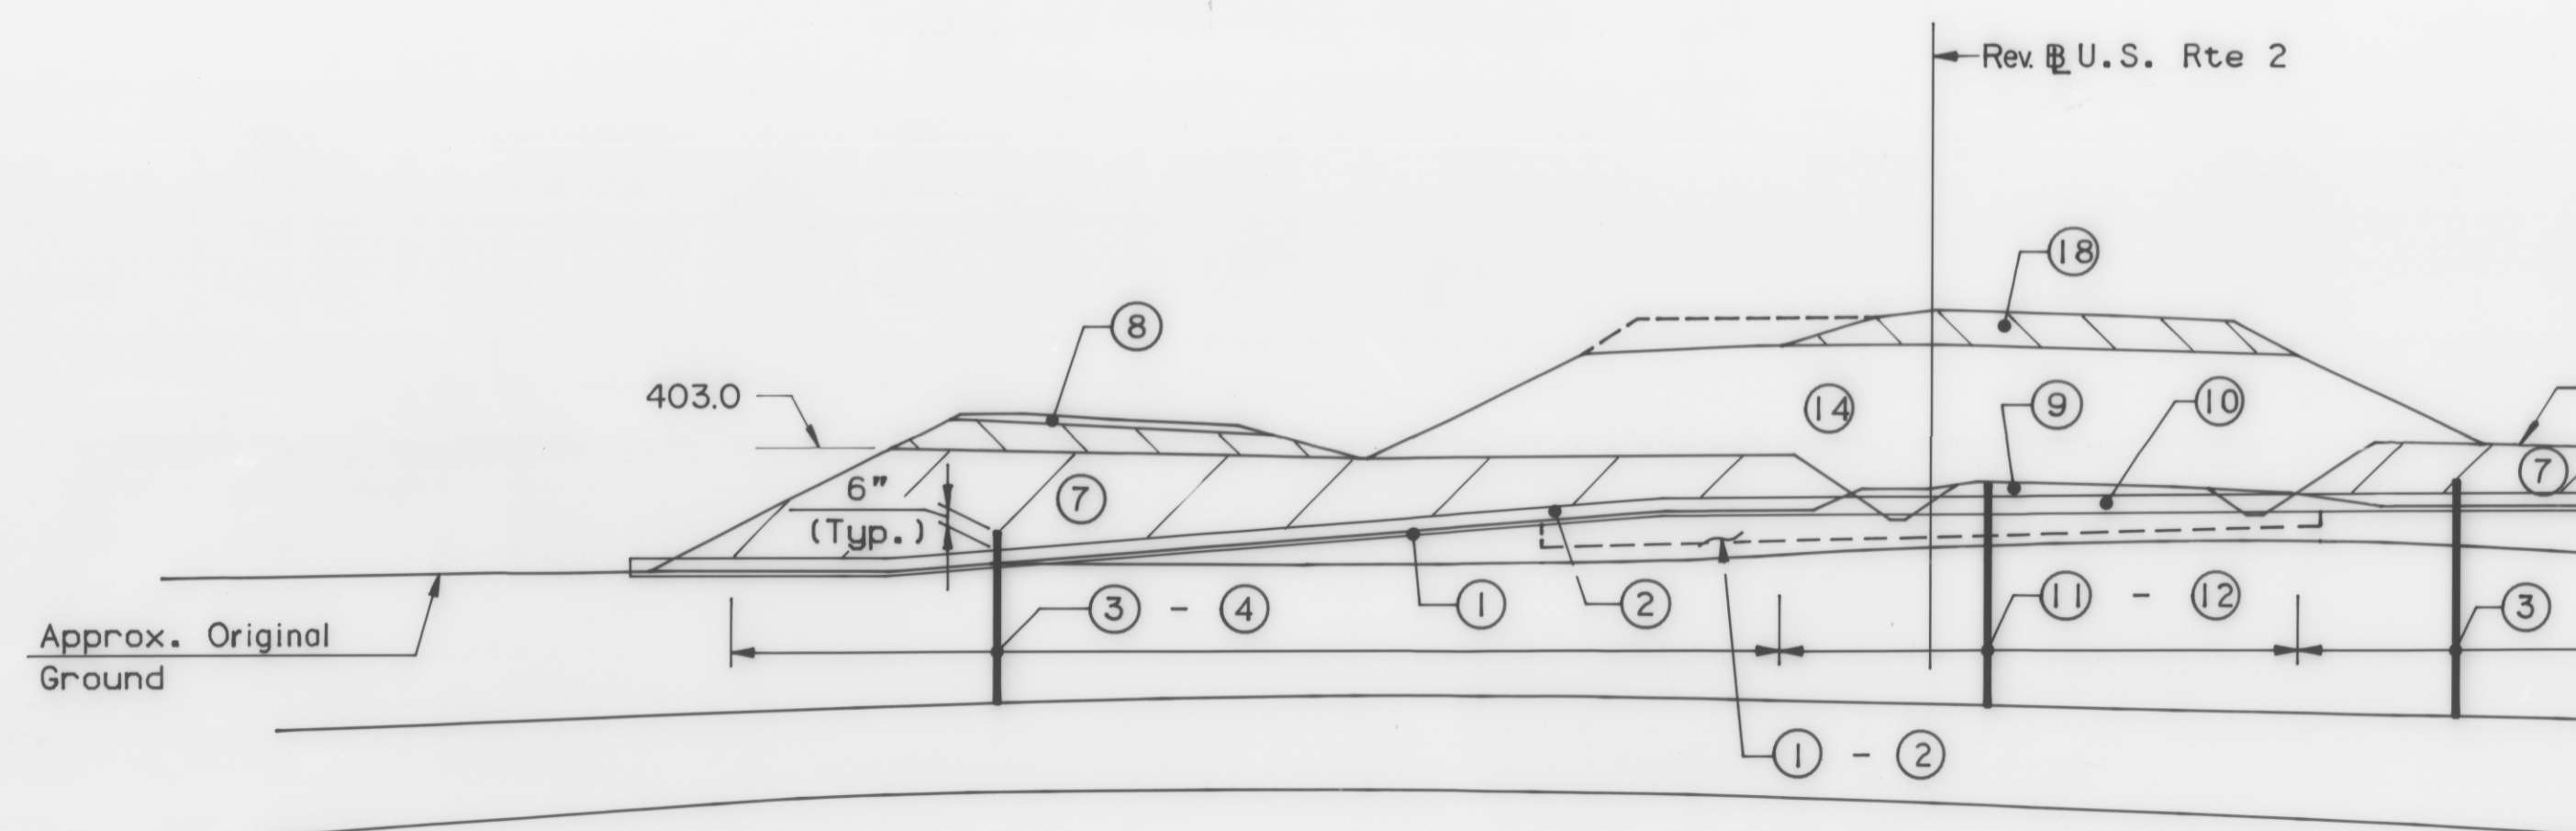

SECTION at STA. 22+00
1" = 20'

430
410
390
370
350
330
310

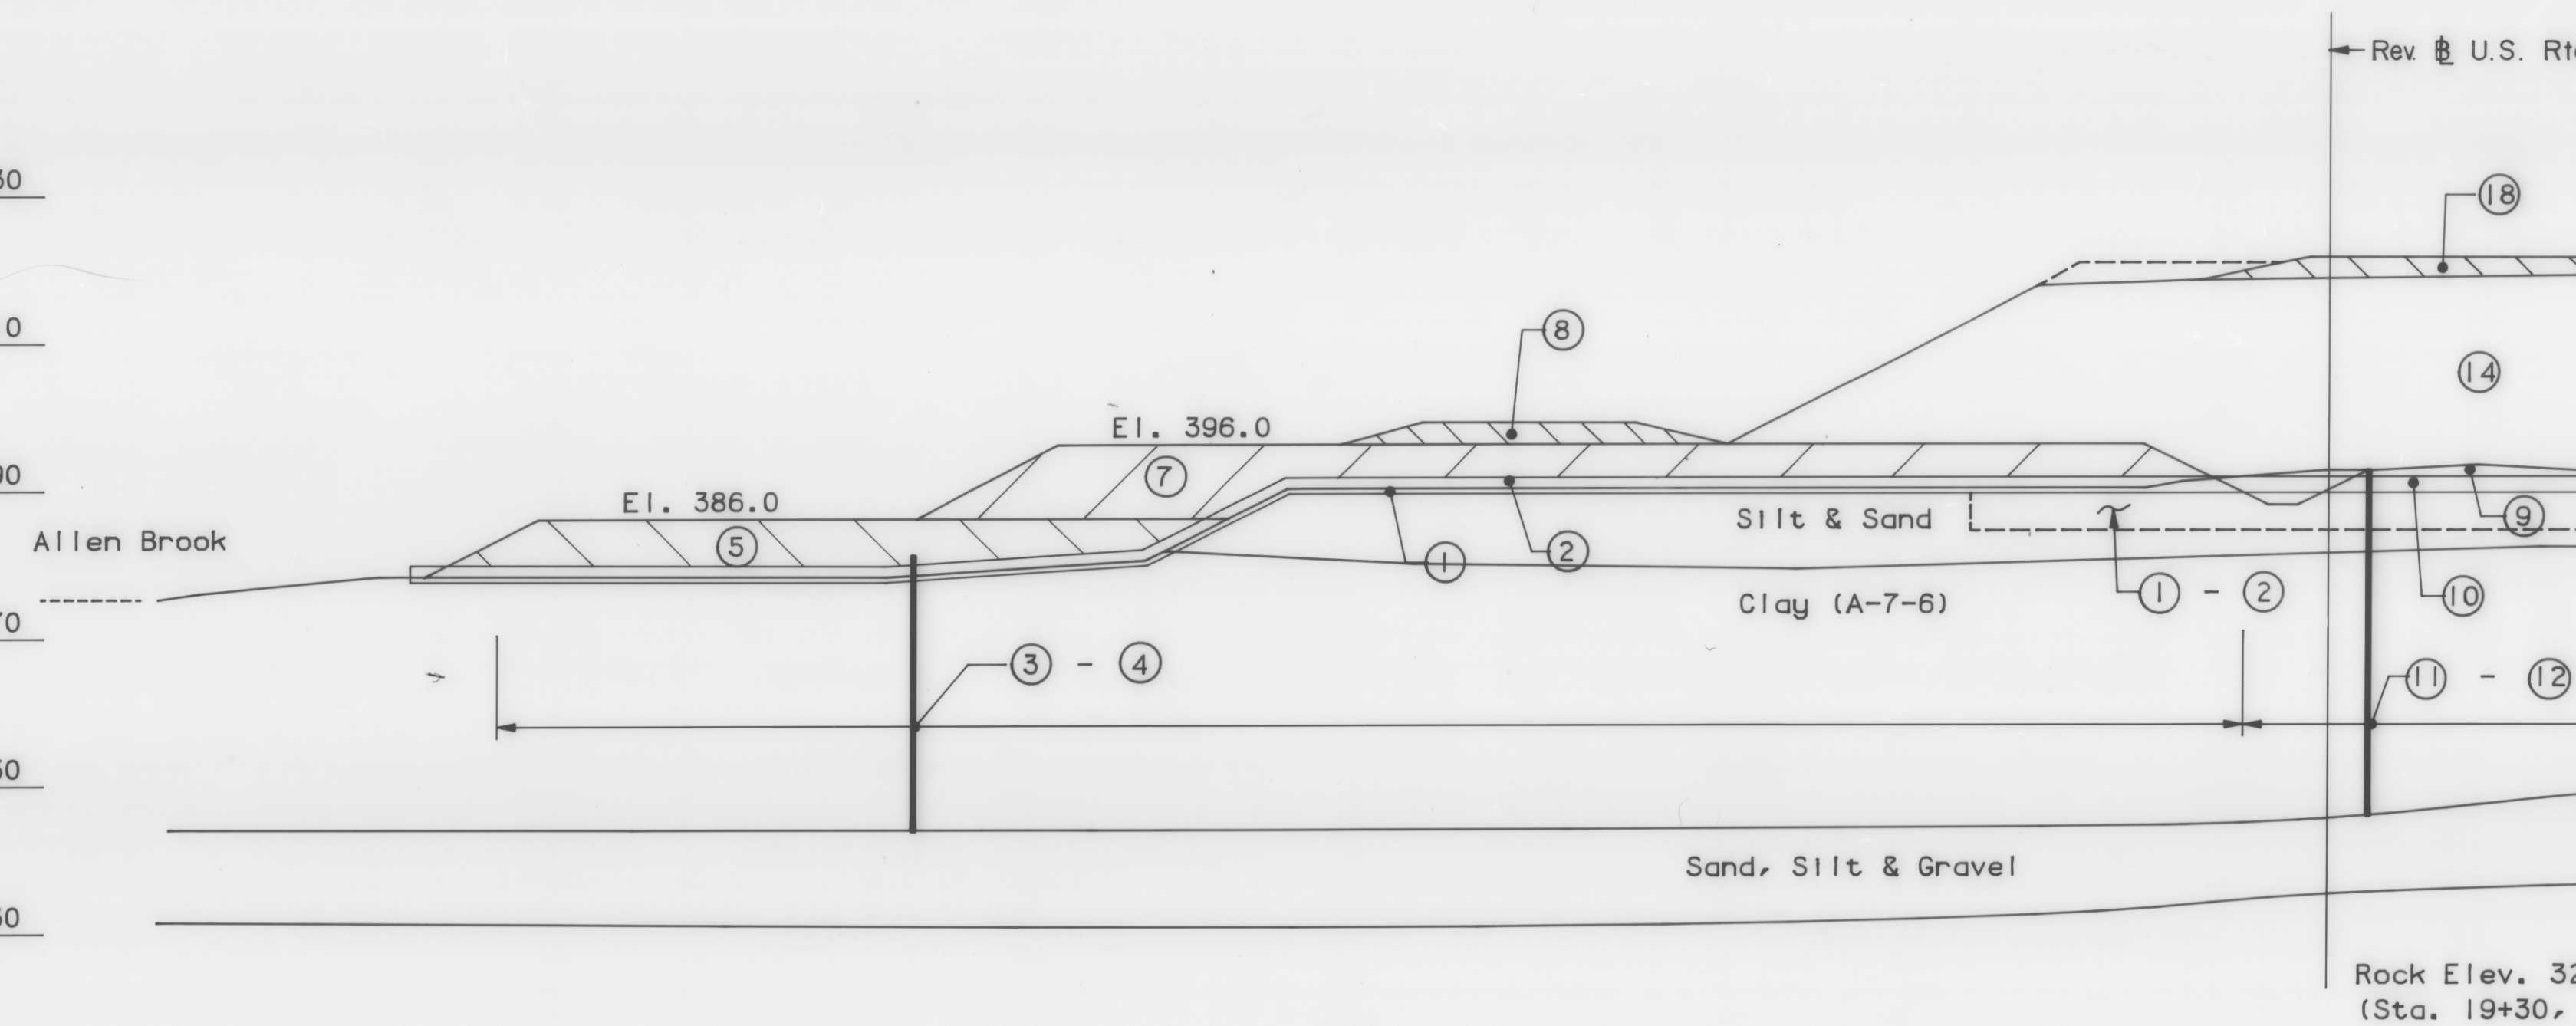

SECTION at STA. 18+50
1" = 20'

DATUM
VERTICAL _____
HORIZONTAL _____