


PROFILE	SURVEYED	DATE
	PLOTTED	BY
	GRADES CHECKED	
	NO.	STRUCTURE NOTATIONS CH'VD



PROFILE	SURVEYED	DATE
	PLOTTED	BY
	GRADES CHECKED	
	NO.	STRUCTURE NOTATIONS CH'VD

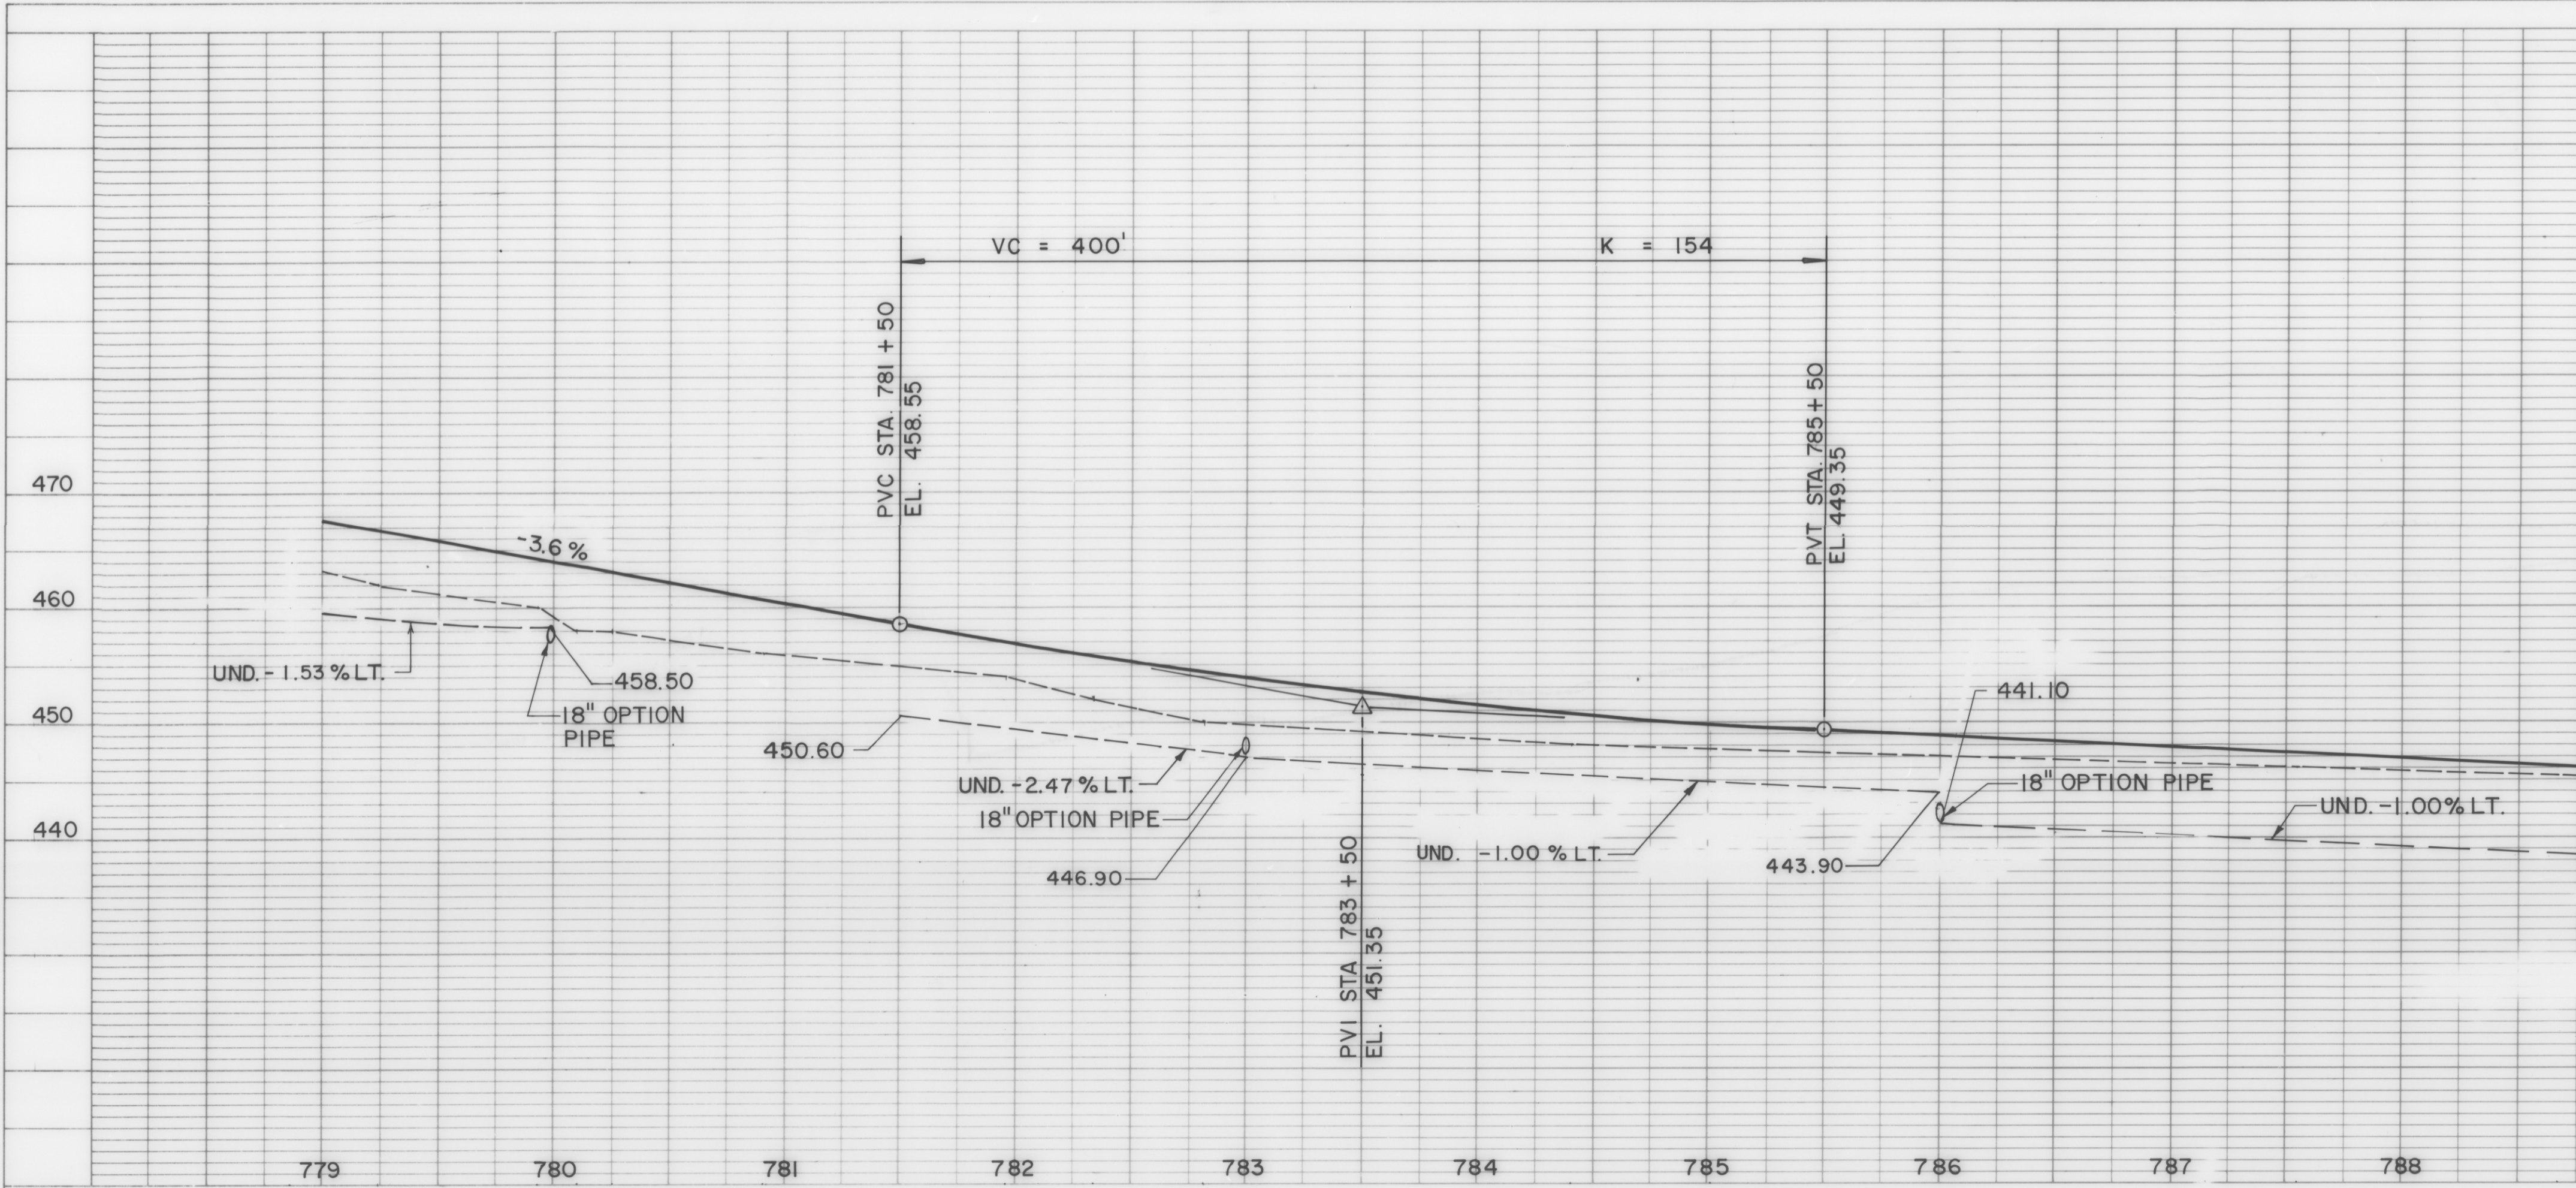