
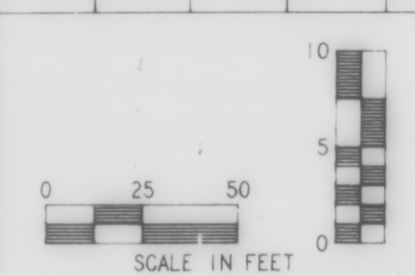


PROFILE  
 SURVEYED  
 PLANNED  
 NOTE BOOK  
 NO.

PROFILE  
 SURVEYED  
 PLANNED  
 NOTE BOOK  
 NO.

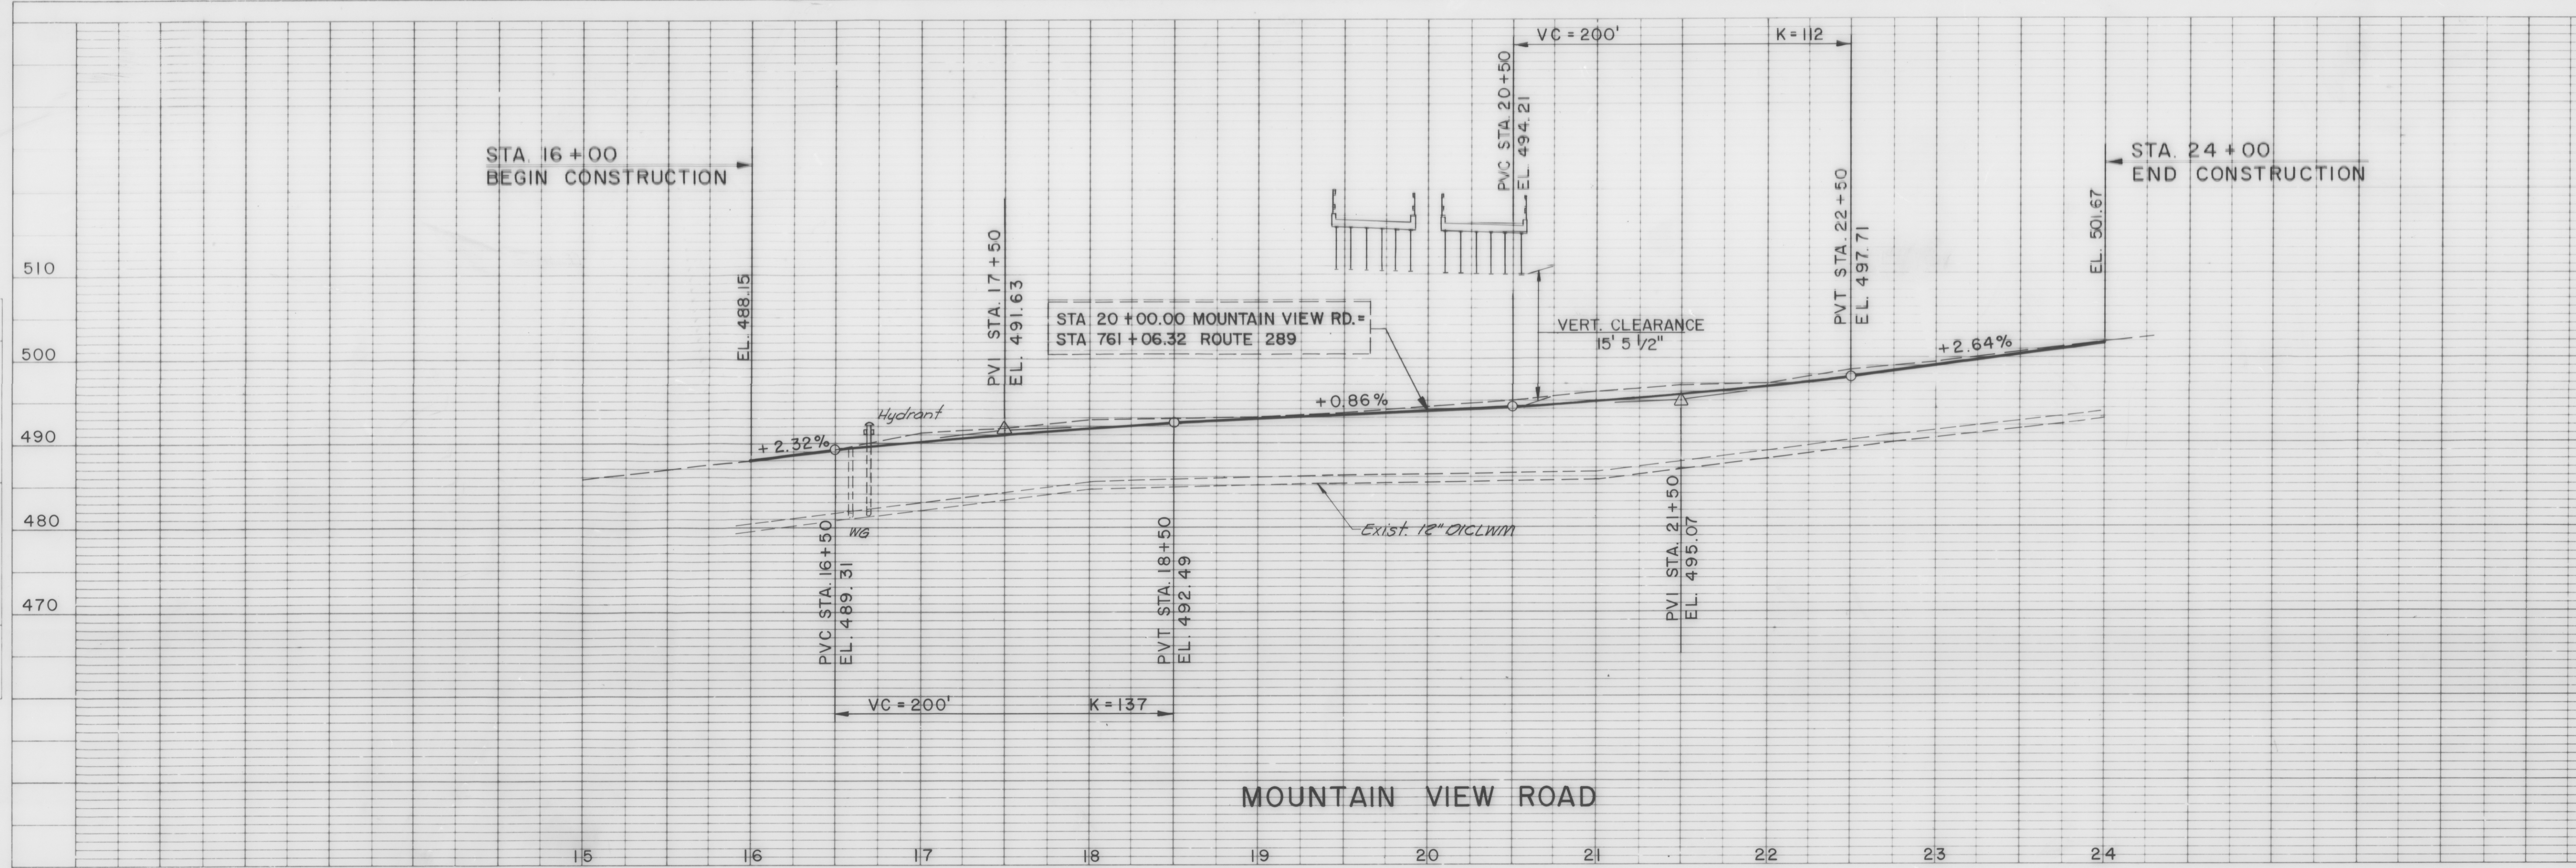

R.O.W.  
 SURVEYED  
 DRAWN BY  
 TRACED BY  
 VERI  
 PROJ. WIL  
 COLU  
 SHEET 2