


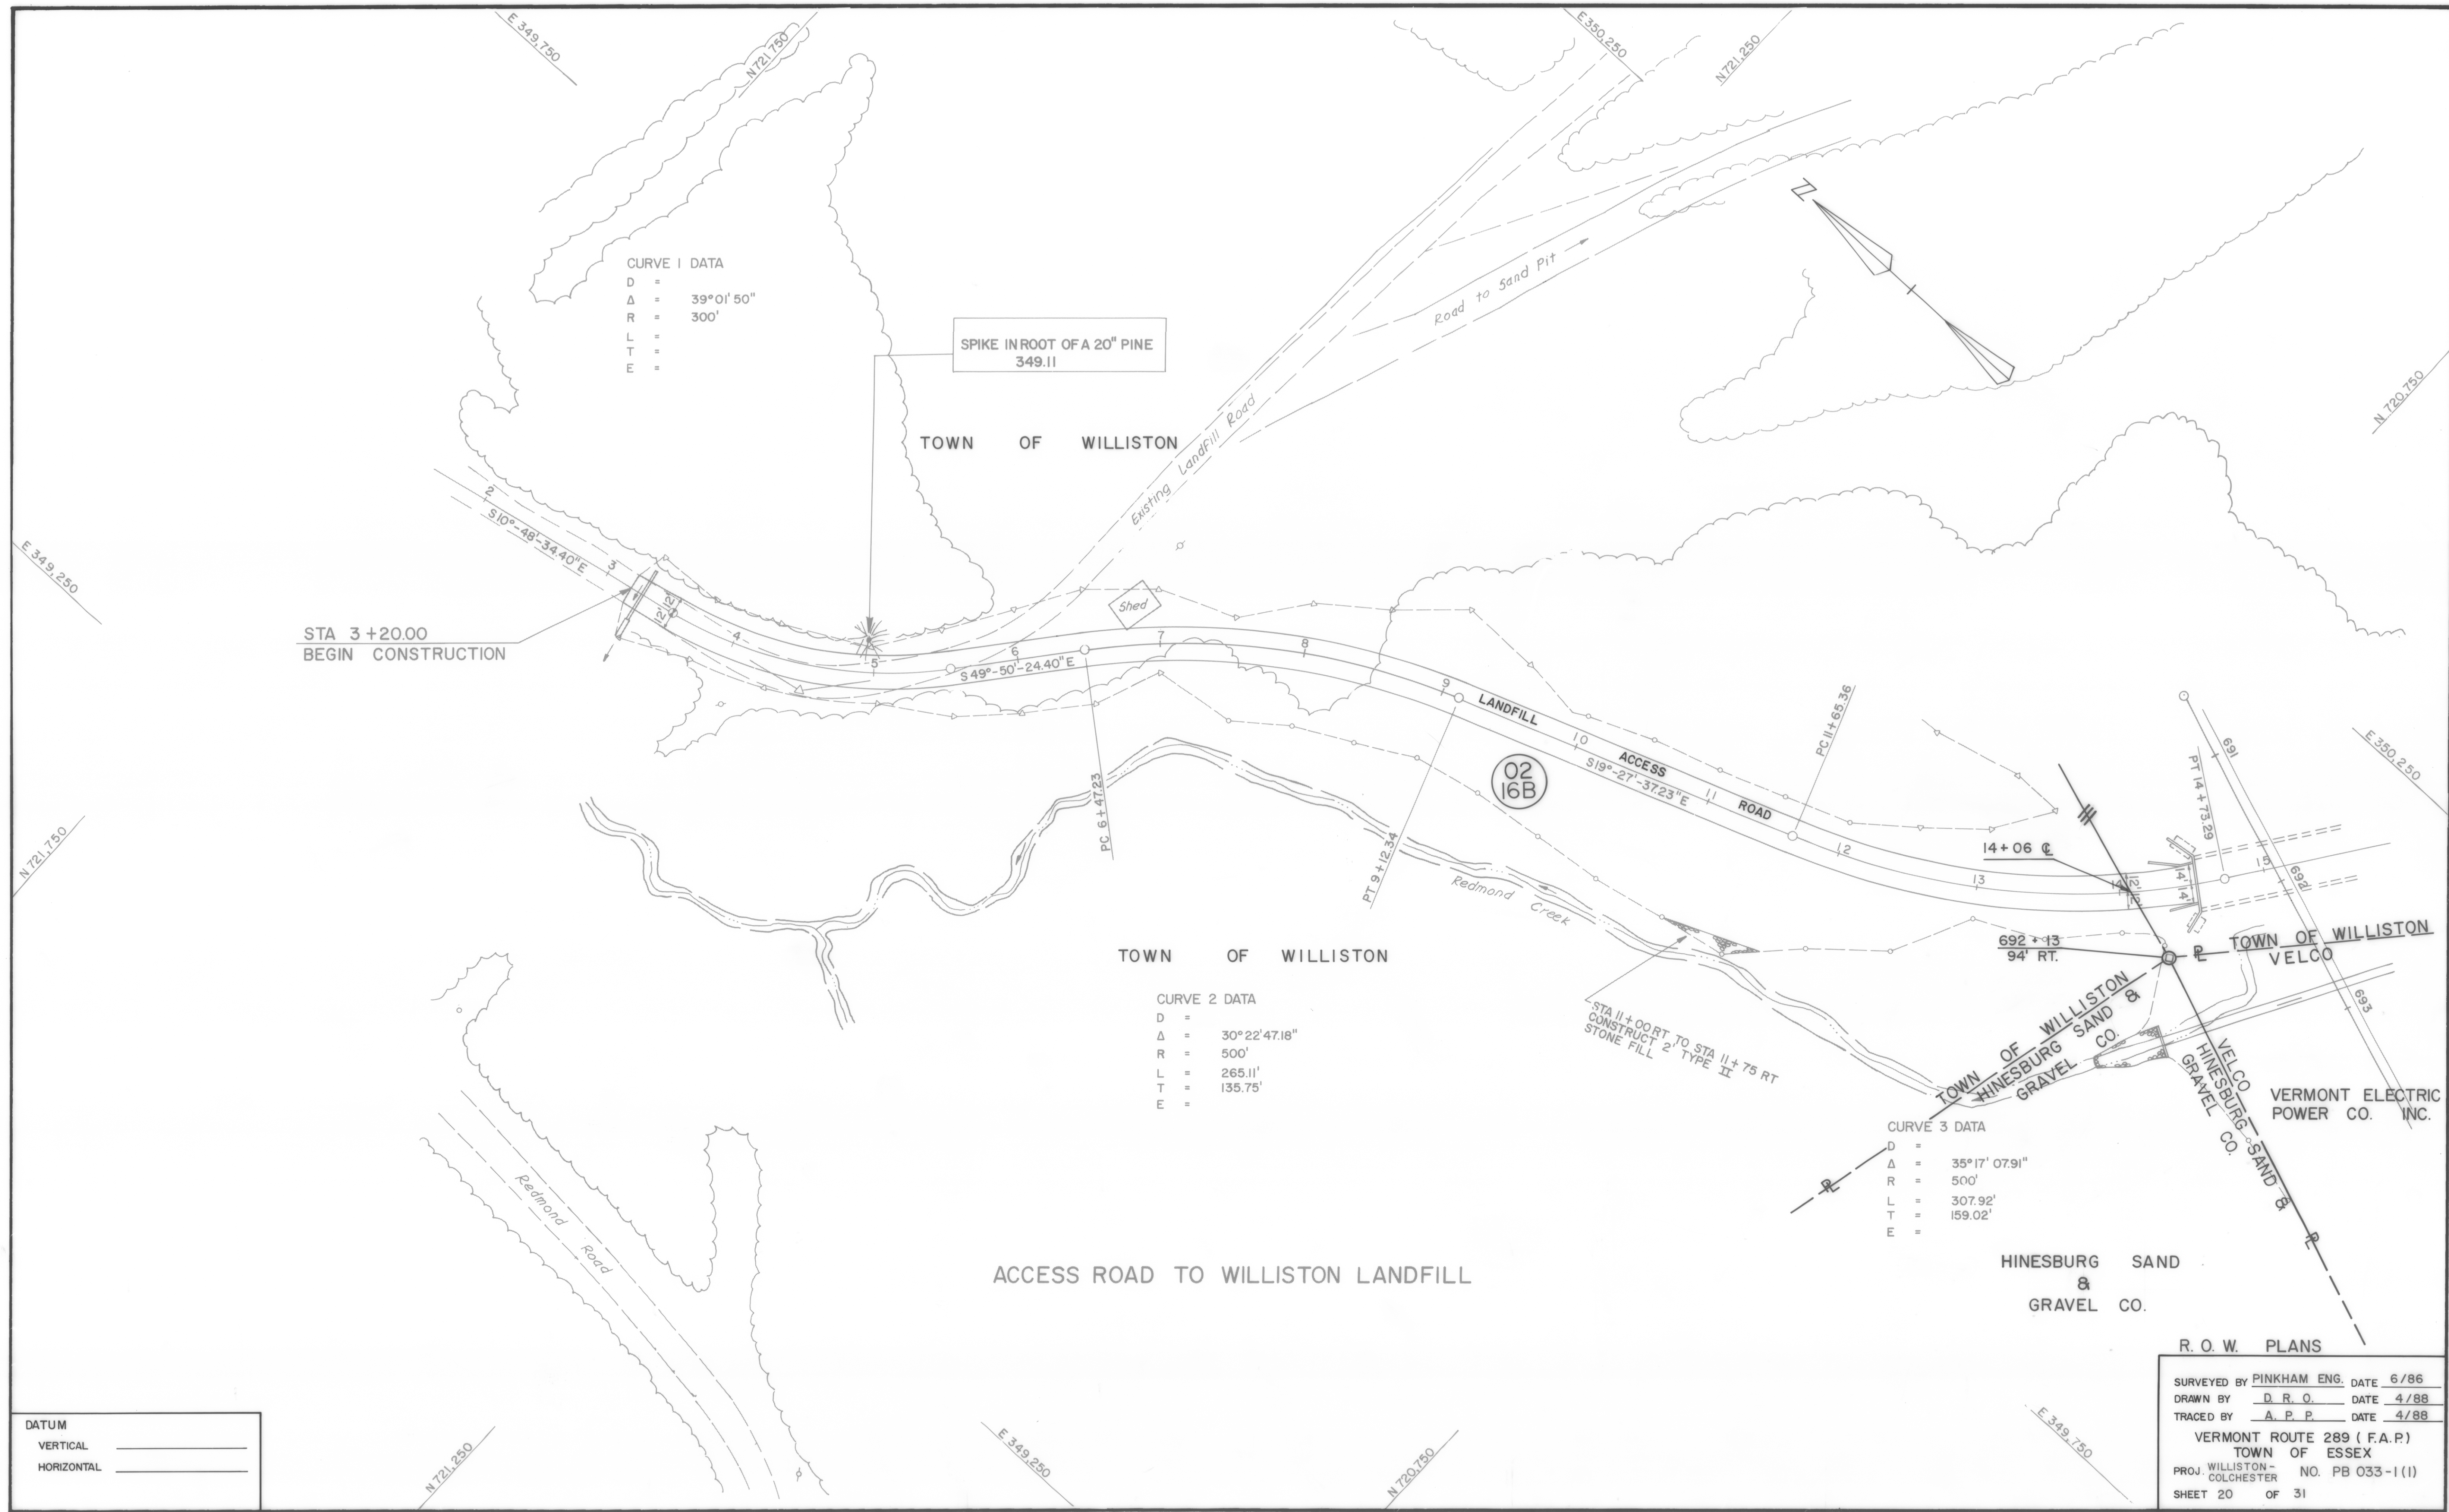

SURVEYED BY PINKHAM ENG. DATE 6/86
 DRAWN BY D. R. O. DATE 4/88
 TRACED BY A. P. P. DATE 4/88
 VERMONT ROUTE 289 (F.A.P.)
 TOWN OF ESSEX
 PROJ. WILLISTON - COLCHESTER NO. PB 033-1(1)
 SHEET 20 OF 31