



PROFILE
 SURVEYED BY _____ DATE _____
 PLOTTED BY _____
 NOTE BOOK GRADES CHECKED BY _____
 NO. _____ STRUCTURE NOTATIONS CH'VD

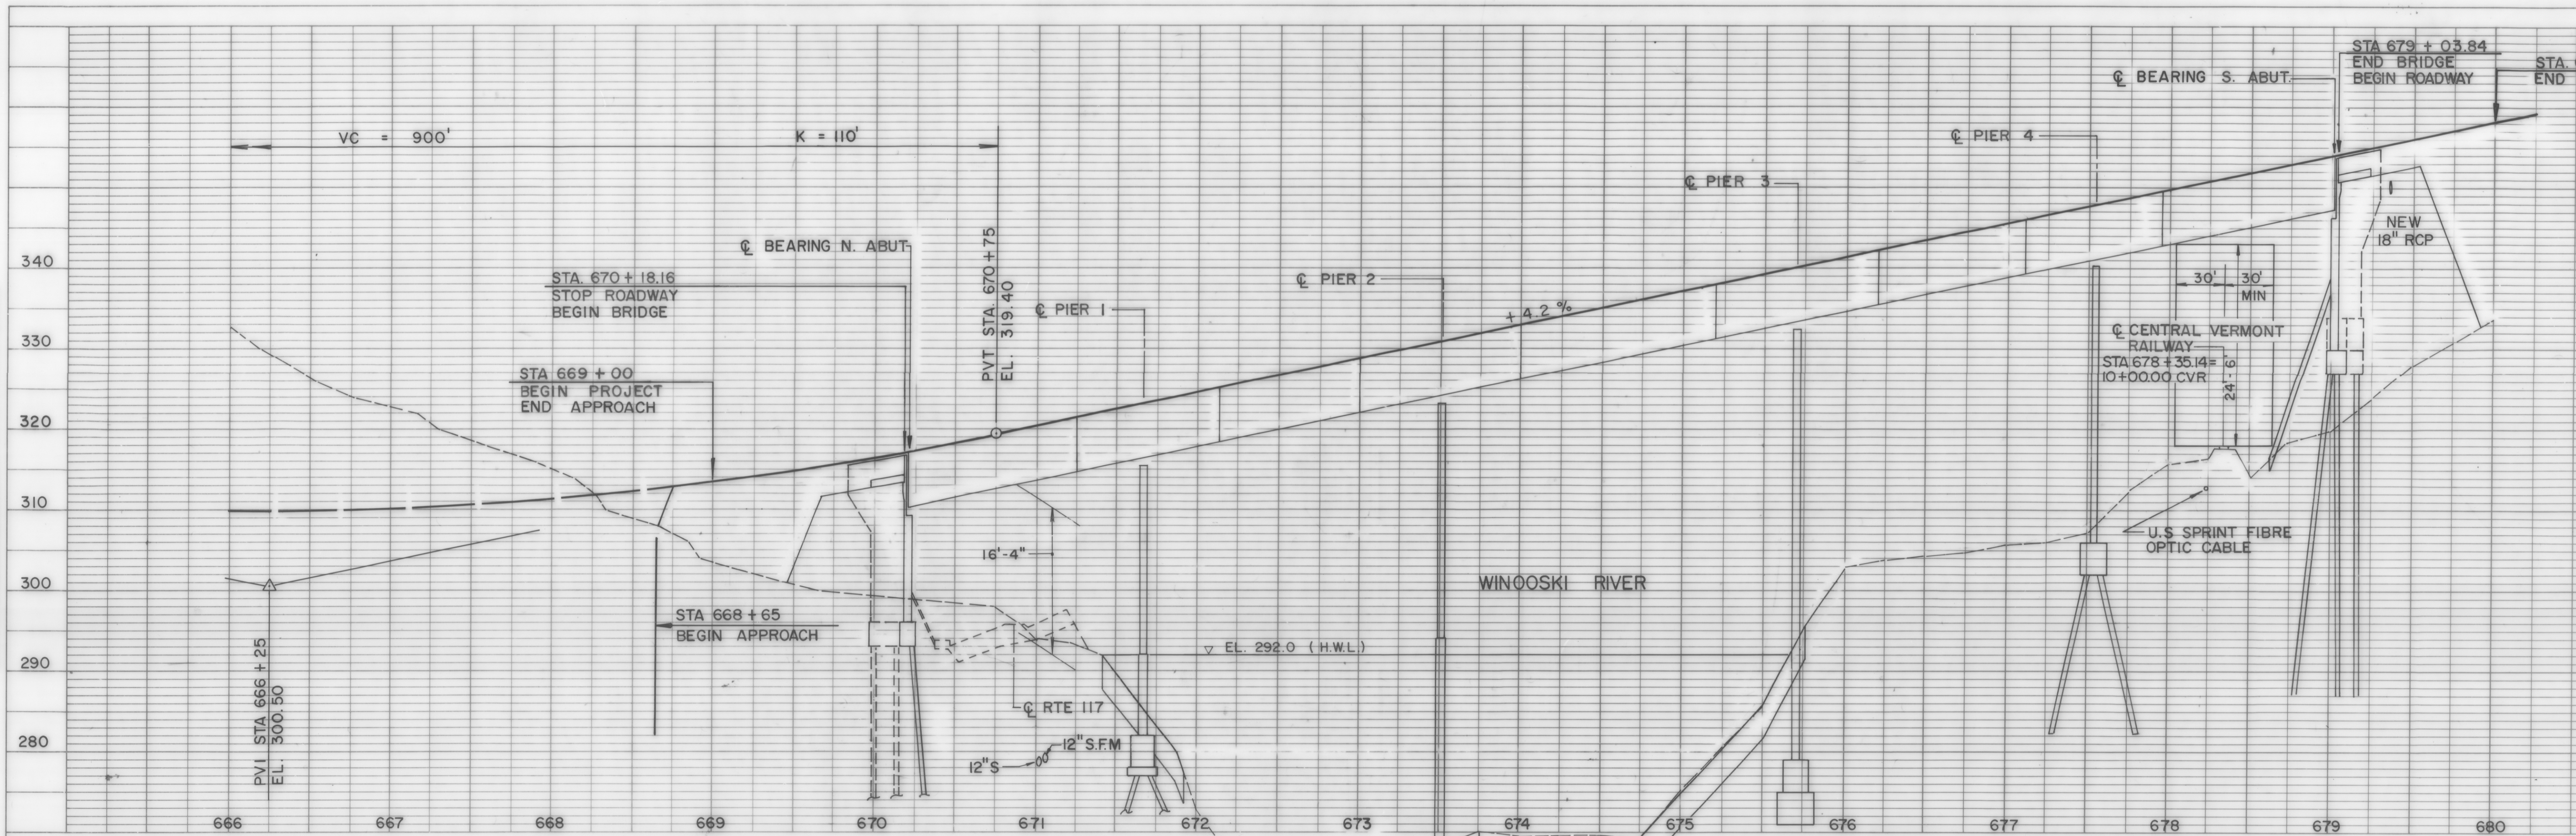

PROFILE
 SURVEYED BY _____ DATE _____
 PLOTTED BY _____
 NOTE BOOK GRADES CHECKED BY _____
 NO. _____ STRUCTURE NOTATIONS CH'VD

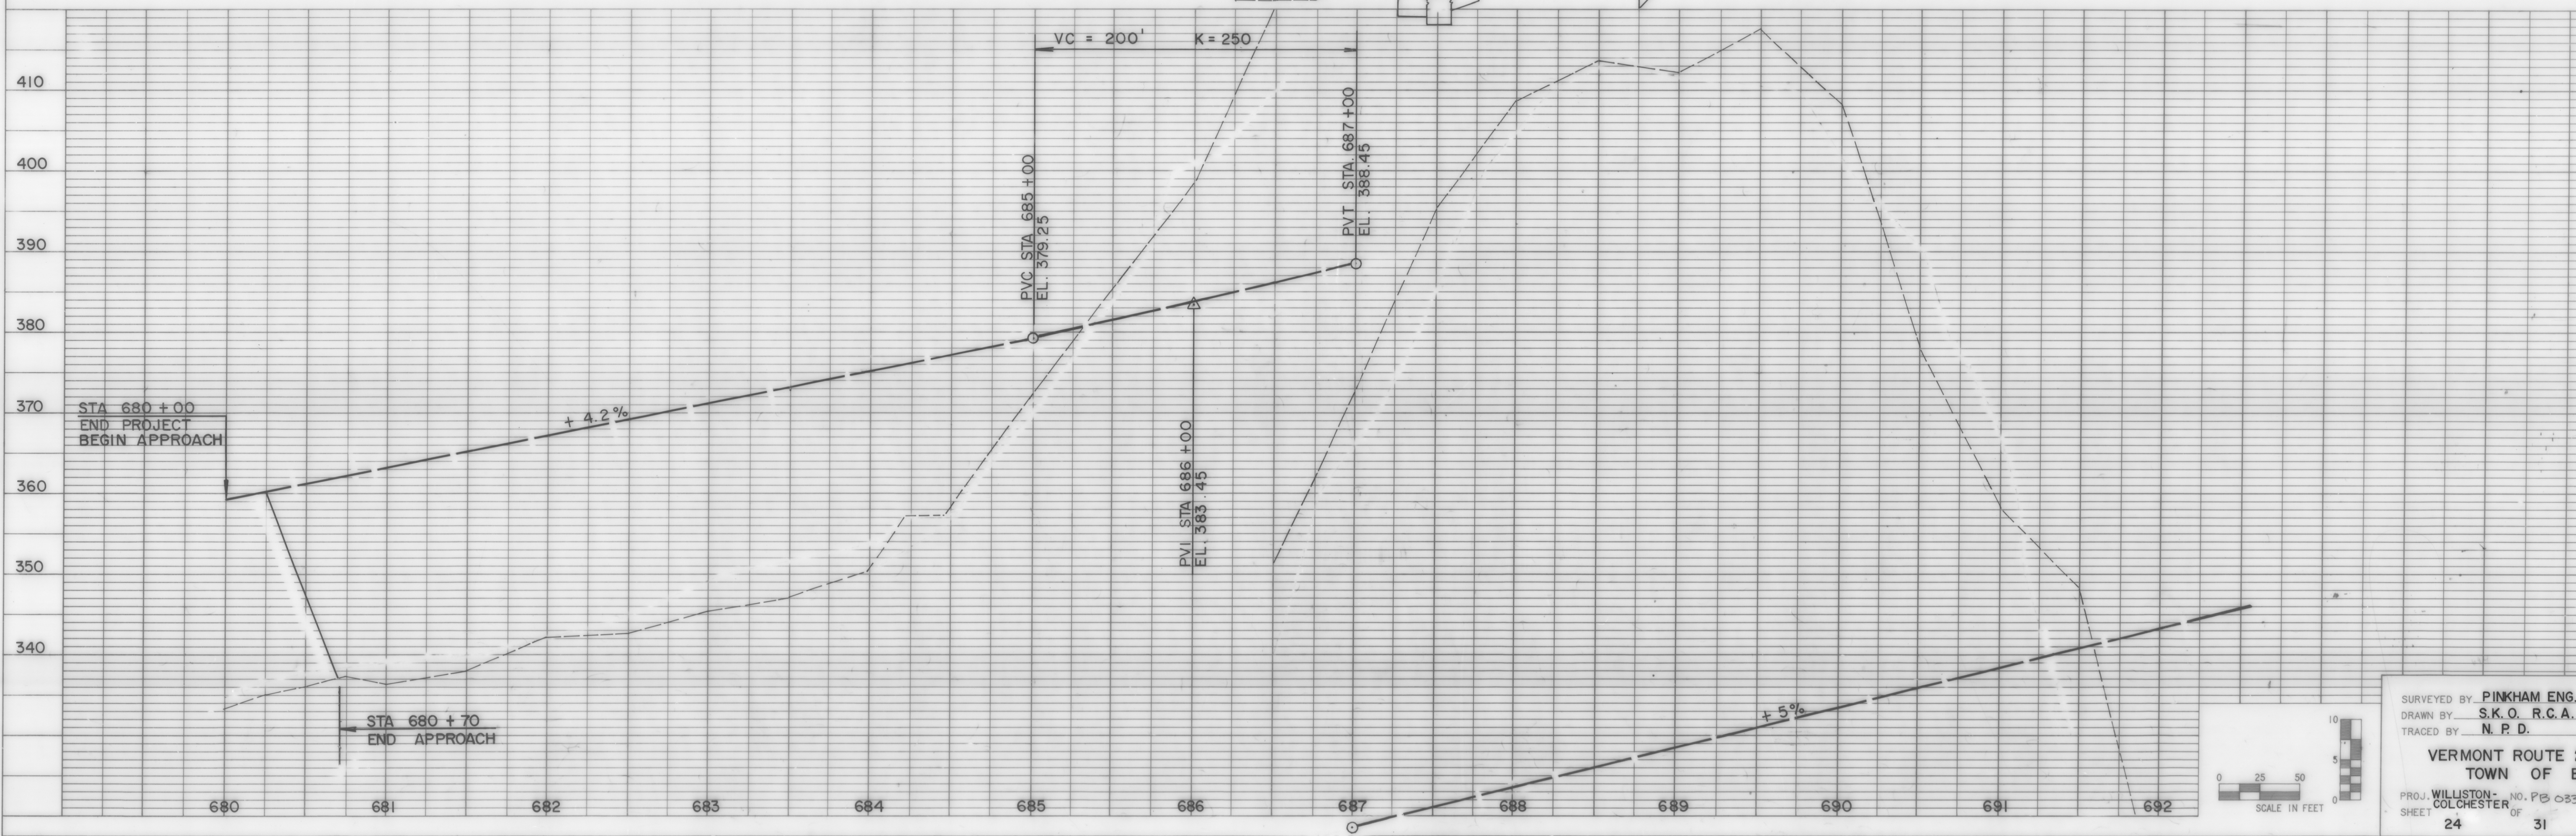

SURVEYED BY PINKHAM ENG.
 DRAWN BY S.K.O. R.C.A.
 TRACED BY N.P.D.
 VERMONT ROUTE 2
 TOWN OF B
 PROJ. WILLISTON- NO. P.B. 033
 SHEET COLCHESTER OF
 24 31