


PROFILE		DATE	
SURVEYED	BY	SURVEYED	BY
NOTE BOOK		NOTE BOOK	
GRADES CHECKED		GRADES CHECKED	
S.M. NOTED		S.M. NOTED	
NO.		NO.	
STRUCTURE NOTATIONS CHFD		STRUCTURE NOTATIONS CHFD	



PROFILE		DATE	
SURVEYED	BY	SURVEYED	BY
NOTE BOOK		NOTE BOOK	
GRADES CHECKED		GRADES CHECKED	
S.M. NOTED		S.M. NOTED	
NO.		NO.	
STRUCTURE NOTATIONS CHFD		STRUCTURE NOTATIONS CHFD	

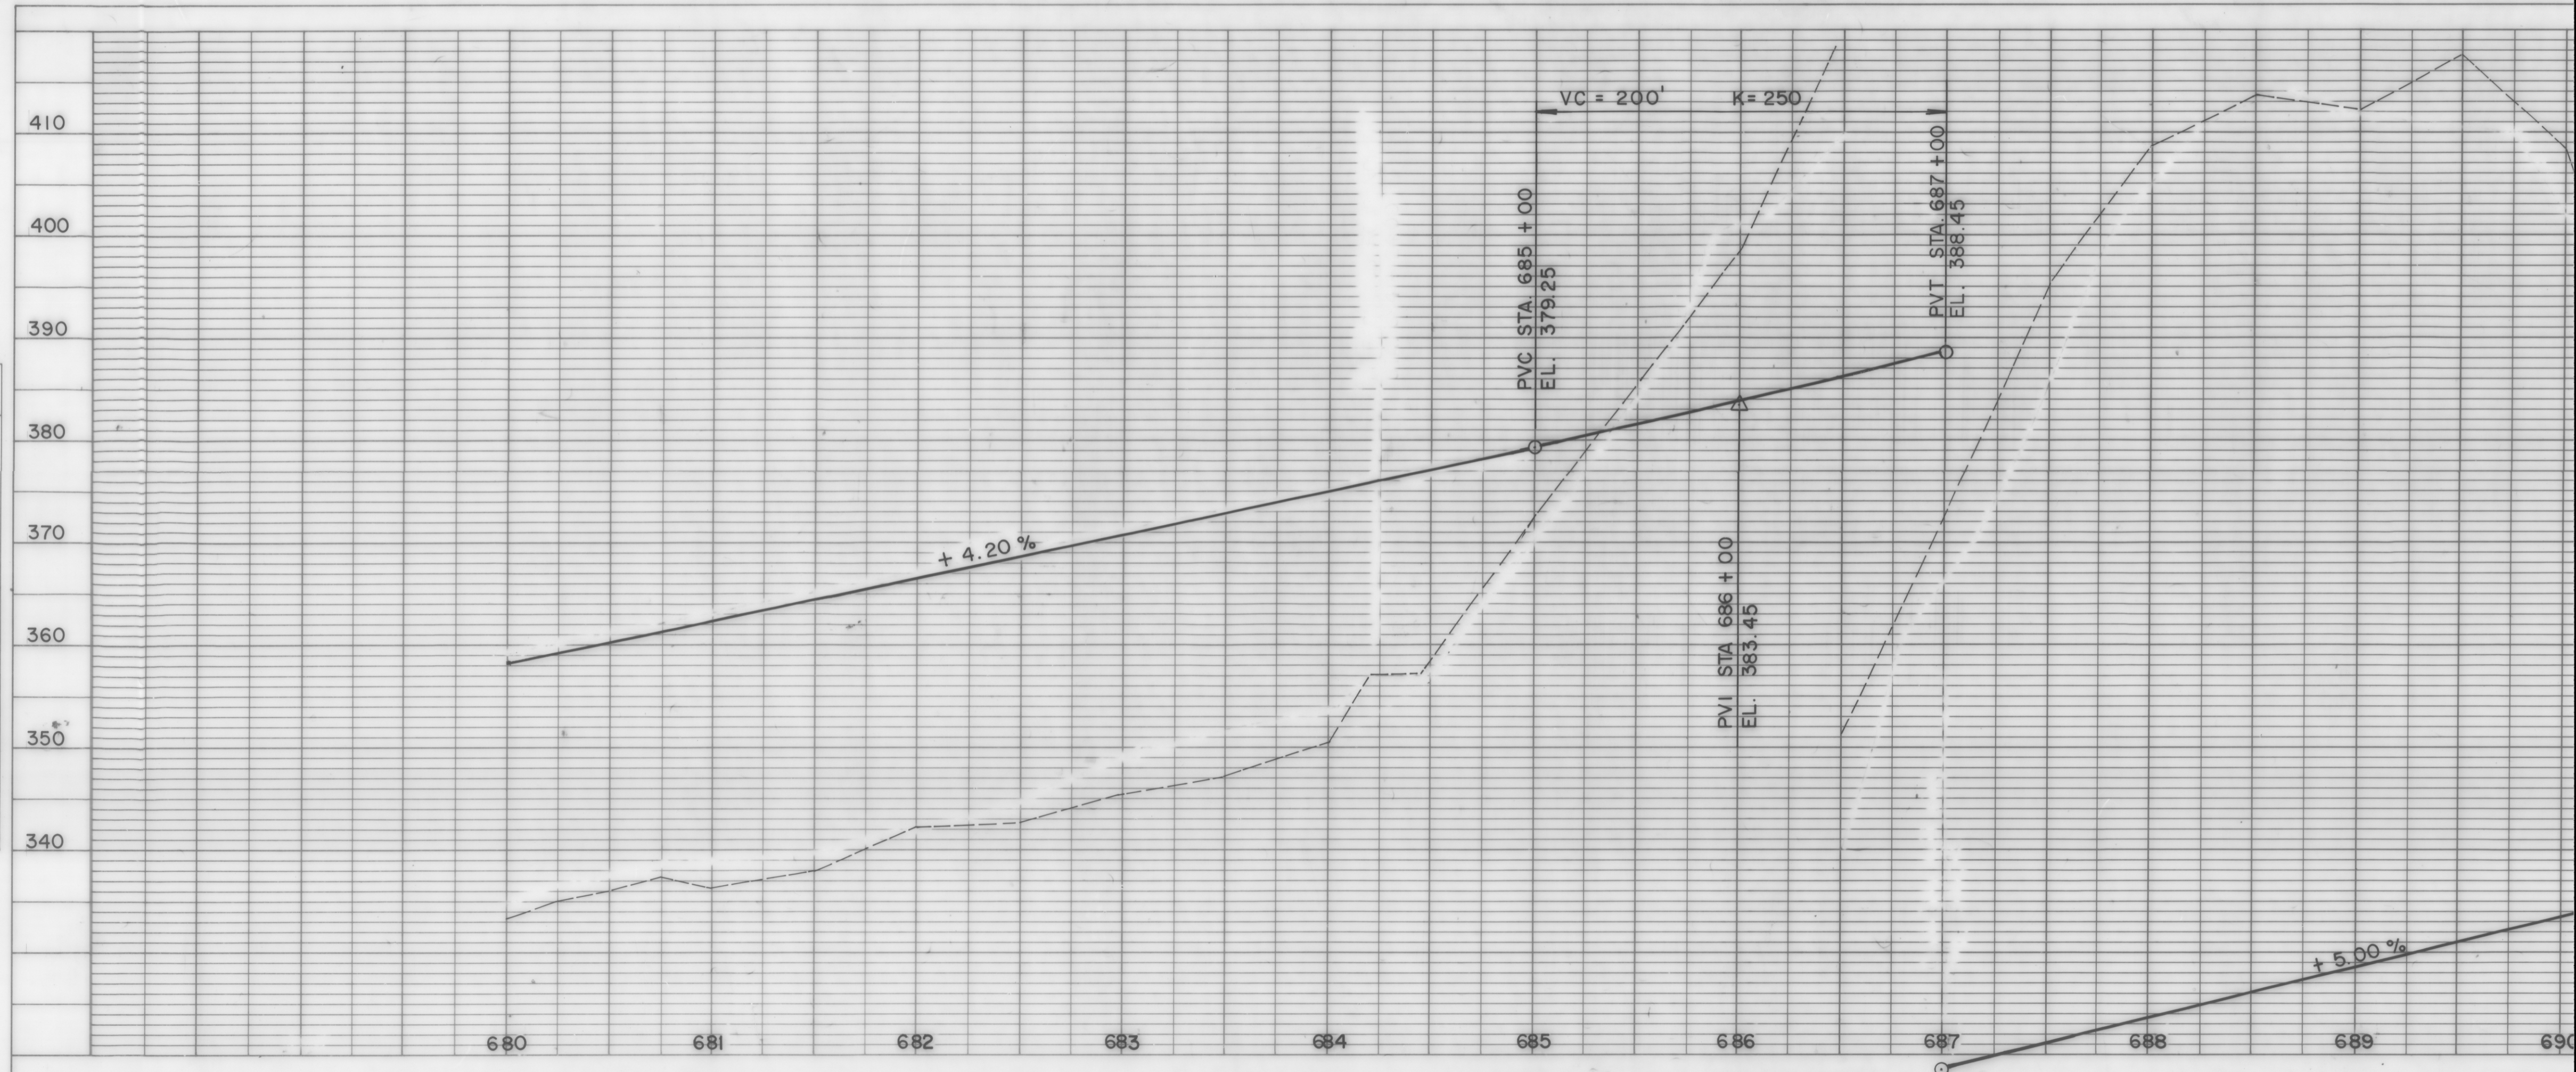