


PROFILE	SURVEYED	BY	DATE
NOTE BOOK	PLOTTED		
NO.	GRADES CHECKED		
	S.A.M.'S NOTED		
	STRUCTURE NOTATIONS CH'KD		



PROFILE	SURVEYED	BY	DATE
NOTE BOOK	PLOTTED		
NO.	GRADES CHECKED		
	S.A.M.'S NOTED		
	STRUCTURE NOTATIONS CH'KD		

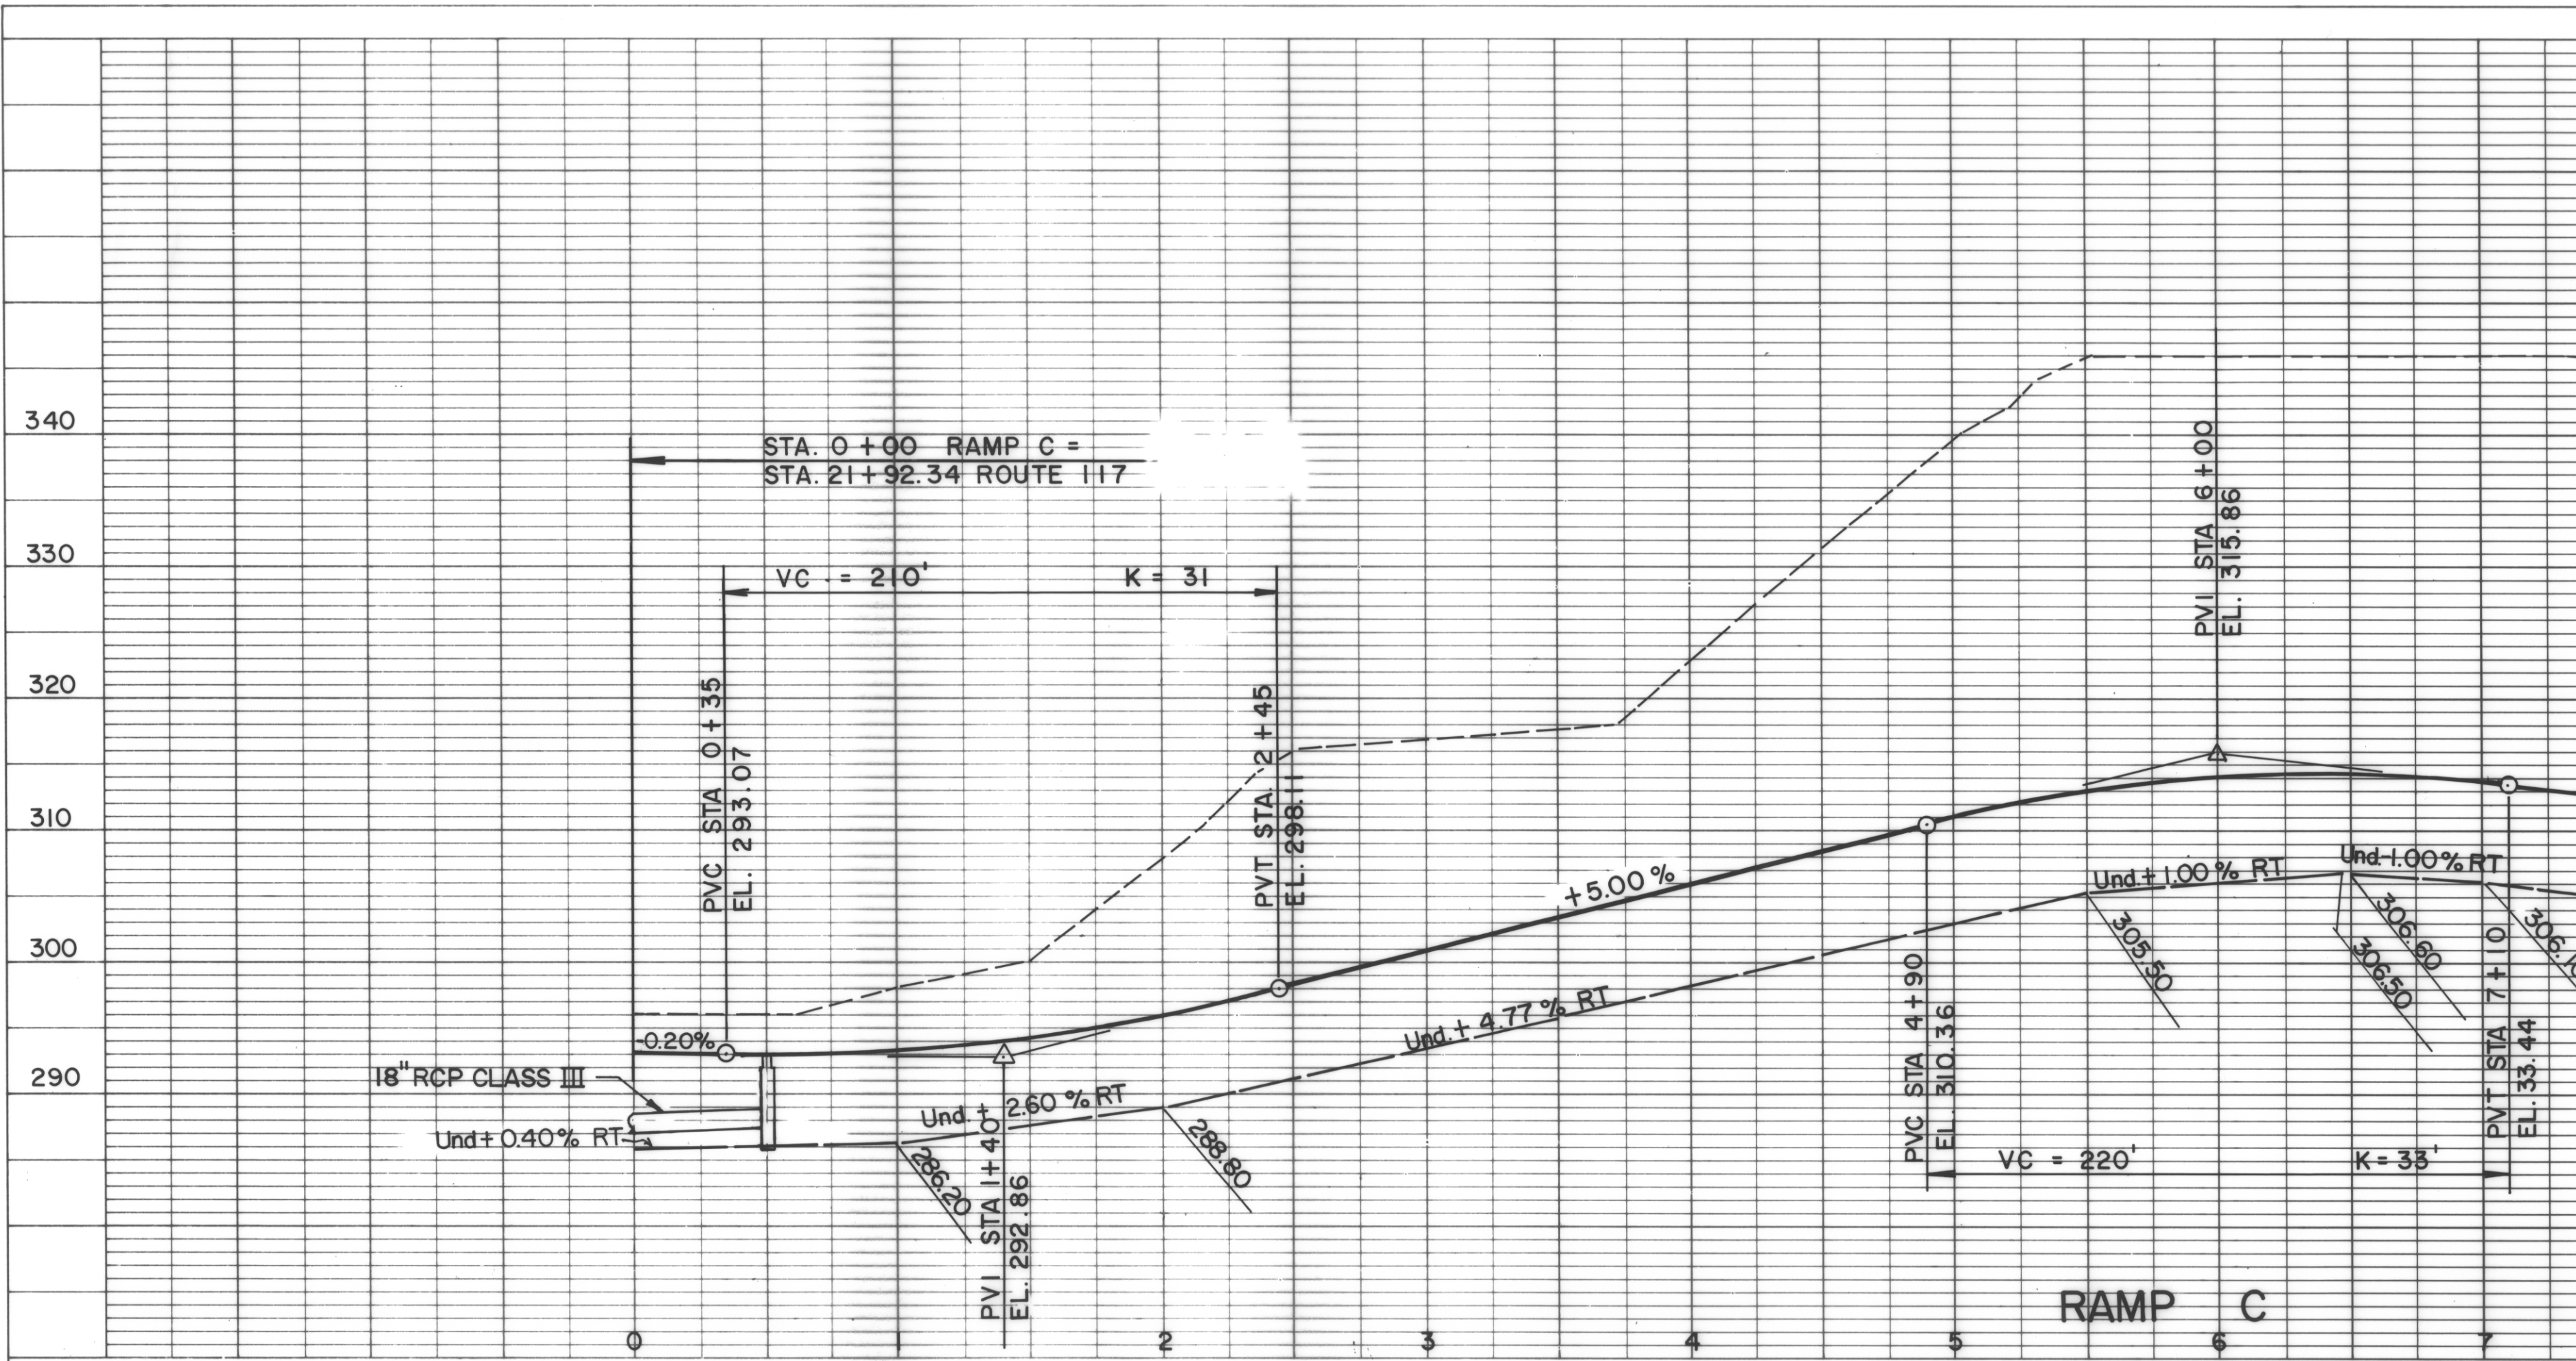