
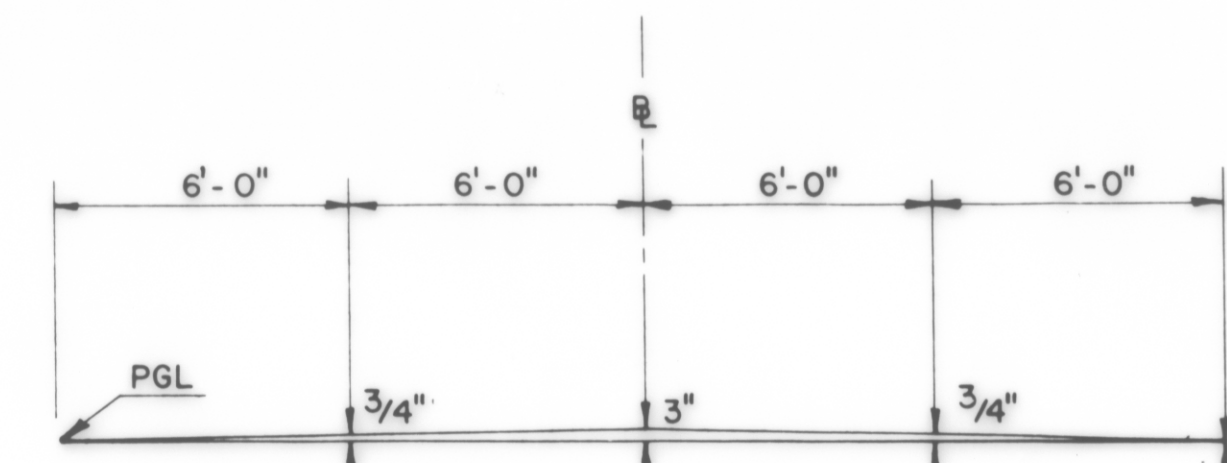
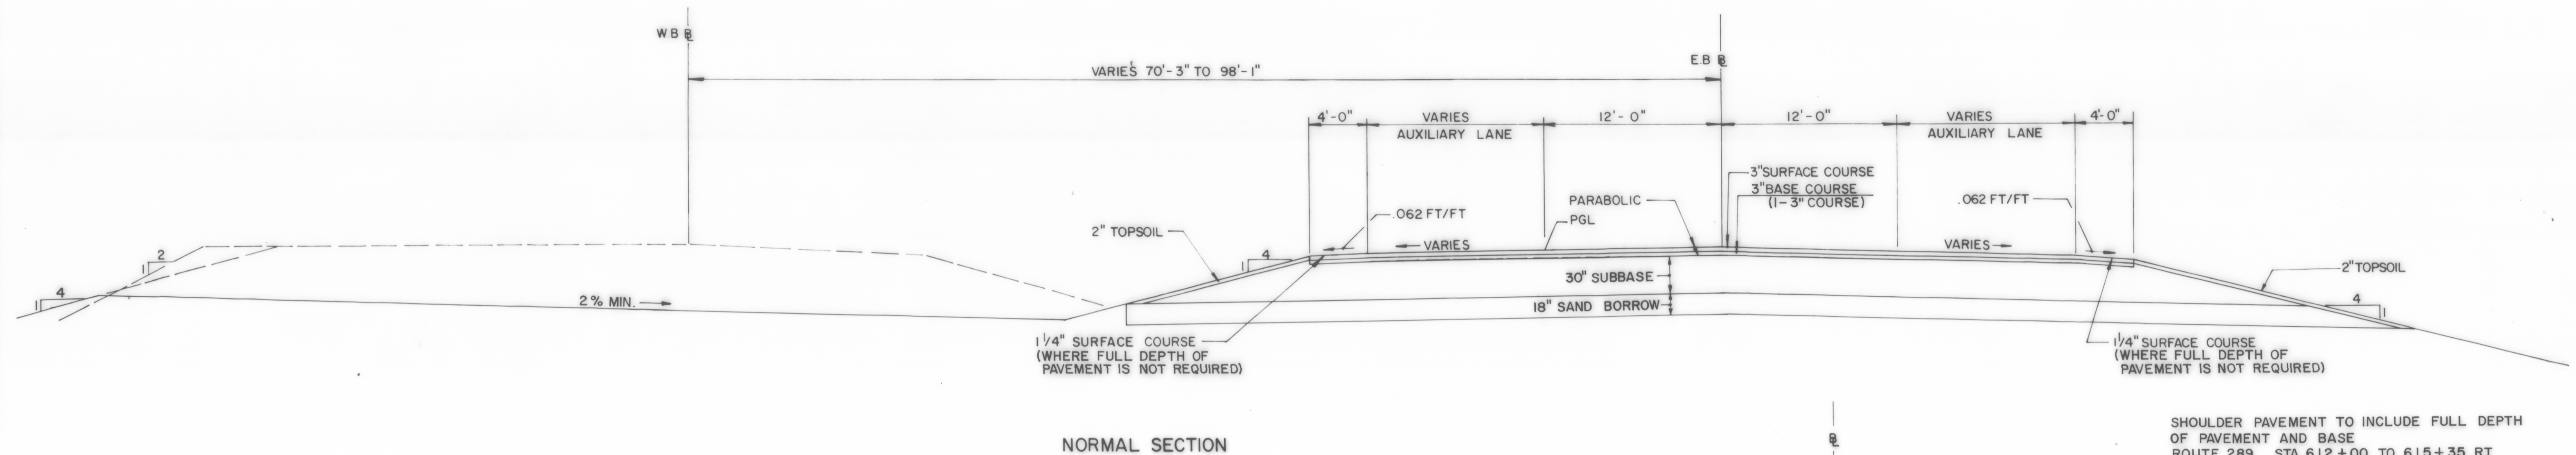


TYPICAL SECTIONS

3" BITUMINOUS CONCRETE PAVEMENT — 1 1/4" TYPE III WEARING COURSE, 1 3/4" TYPE II BINDING COURSE
 3" BITUMINOUS CONCRETE PAVEMENT, TYPE I - BASE COURSE 1-3" COURSE
 30" SUBBASE OF DENSE GRADED CRUSHED STONE
 SHOULDERS 1 1/4" BITUMINOUS CONCRETE PAVEMENT
 18" SAND BORROW

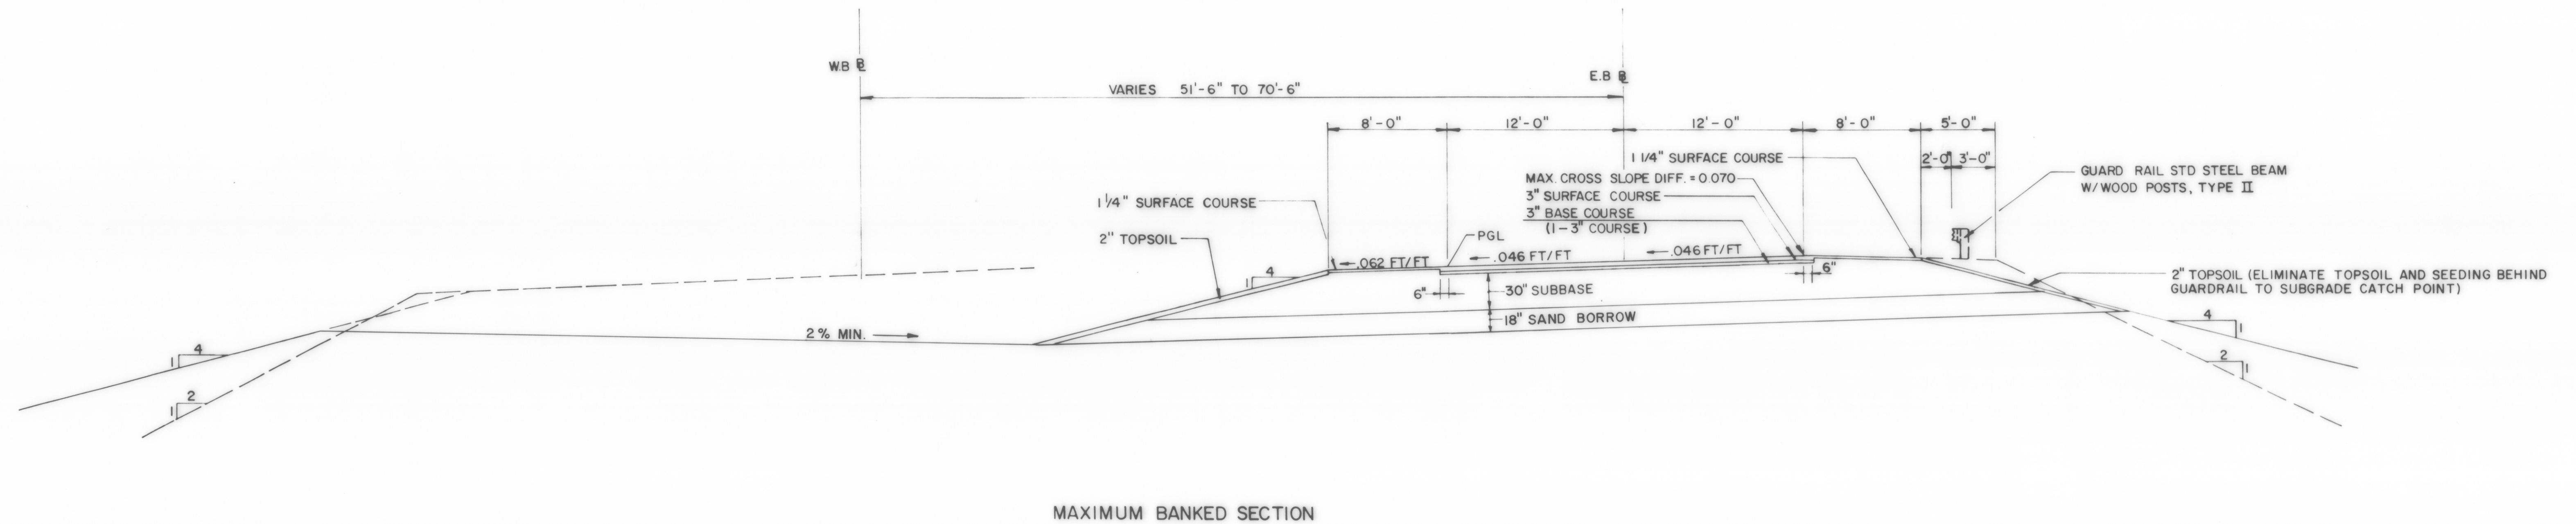

DATUM
 VERTICAL _____
 HORIZONTAL _____

R. O. W. PLANS
 SURVEYED BY PINKHAM ENG DATE 6/86
 DRAWN BY RCA DATE 6/87
 TRACED BY NPD DATE 6/87
 VERMONT ROUTE 289 (F.A.P.)
 TOWN OF ESSEX
 PROJ WILLISTON NO. PB 033-1(1)
 COLCHESTER
 SHEET 6 OF 55