


TYPICAL SECTIONS


3" BITUMINOUS CONCRETE PAVEMENT - 1/4" TYPE III WEARING COURSE, 1 3/4" TYPE II BINDING COURSE
 3" BITUMINOUS CONCRETE PAVEMENT, TYPE I - BASE COURSE 1-3" COURSE
 30" SUBBASE OF DENSE GRADED CRUSHED STONE
 SHOULDERS 1/4" BITUMINOUS CONCRETE PAVEMENT
 18" SAND BORROW

TYPICAL SECTIONS-TEMPORARY ROAD


2" BITUMINOUS CONCRETE PAVEMENT, TYPE III
 18" SUBBASE OF GRAVEL (RTE. 15)
 12" SUBBASE OF GRAVEL (ESSEX WAY)

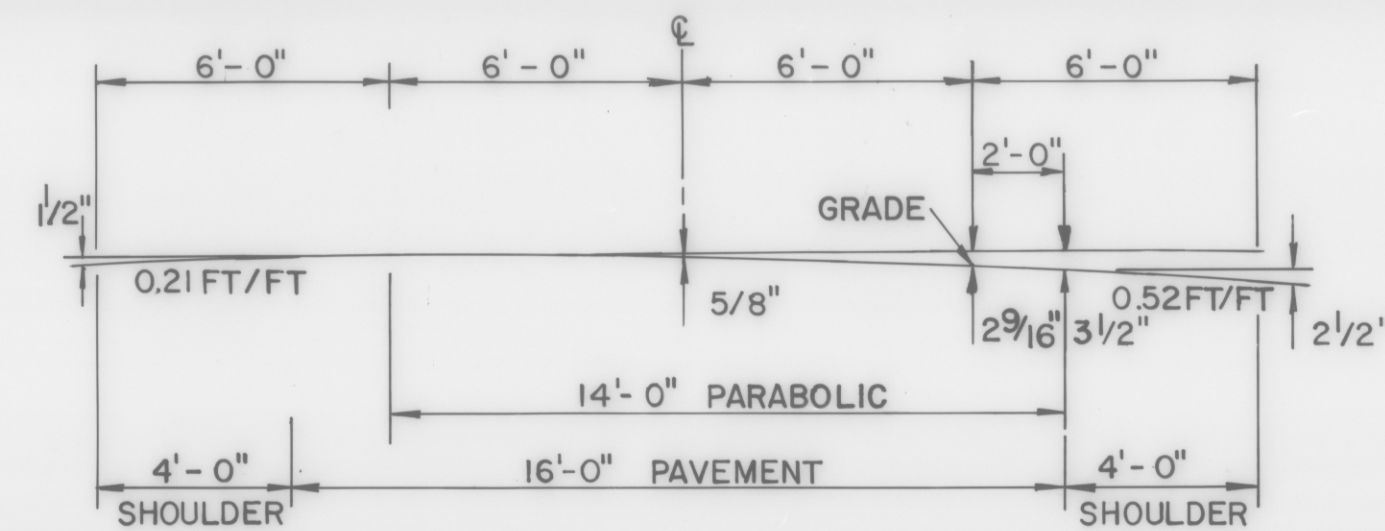


CROSS-SLOPE & PARABOLIC DETAIL

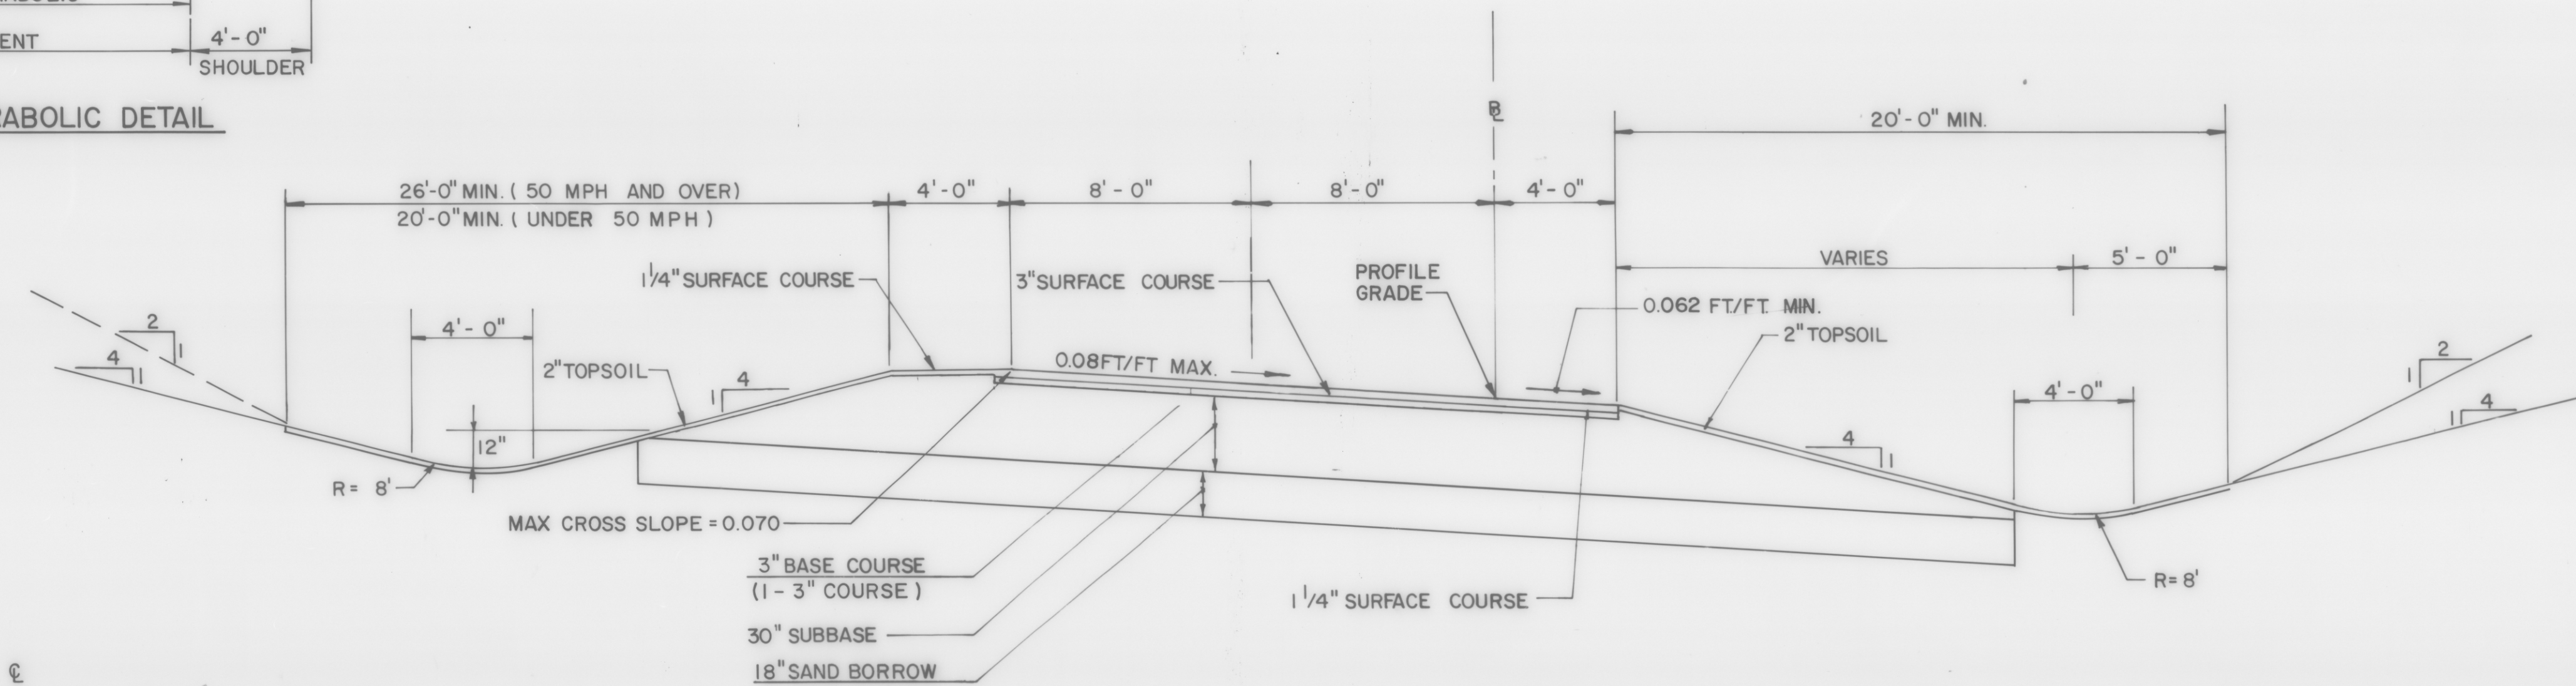


TYPICAL RAMP - BANKED SECTION

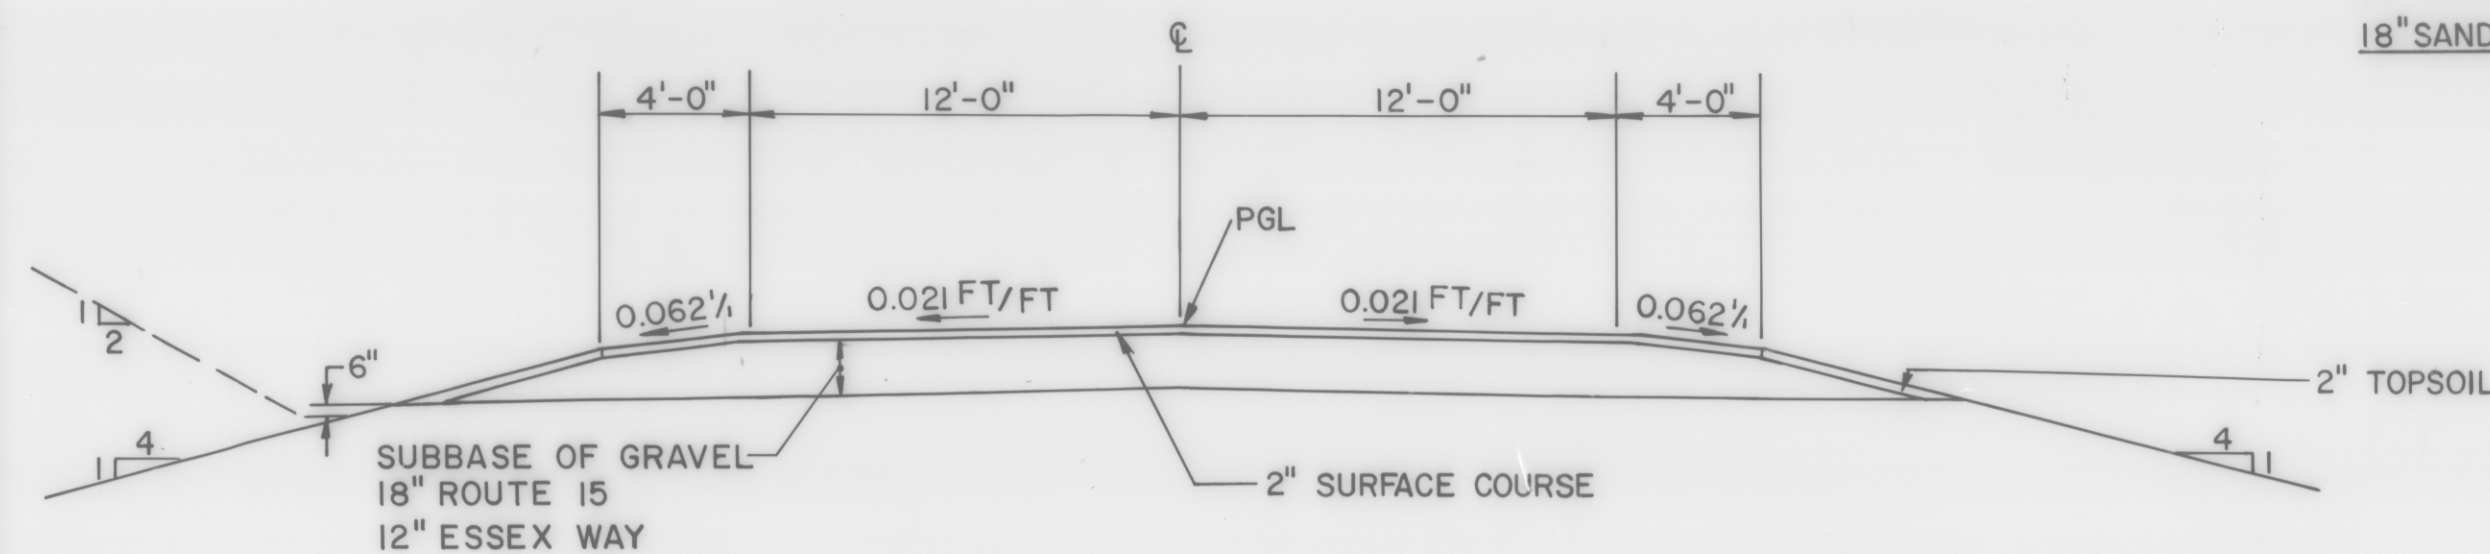

TEMPORARY ROAD-NORMAL SECTION
ROUTE 15 AND ESSEX WAY

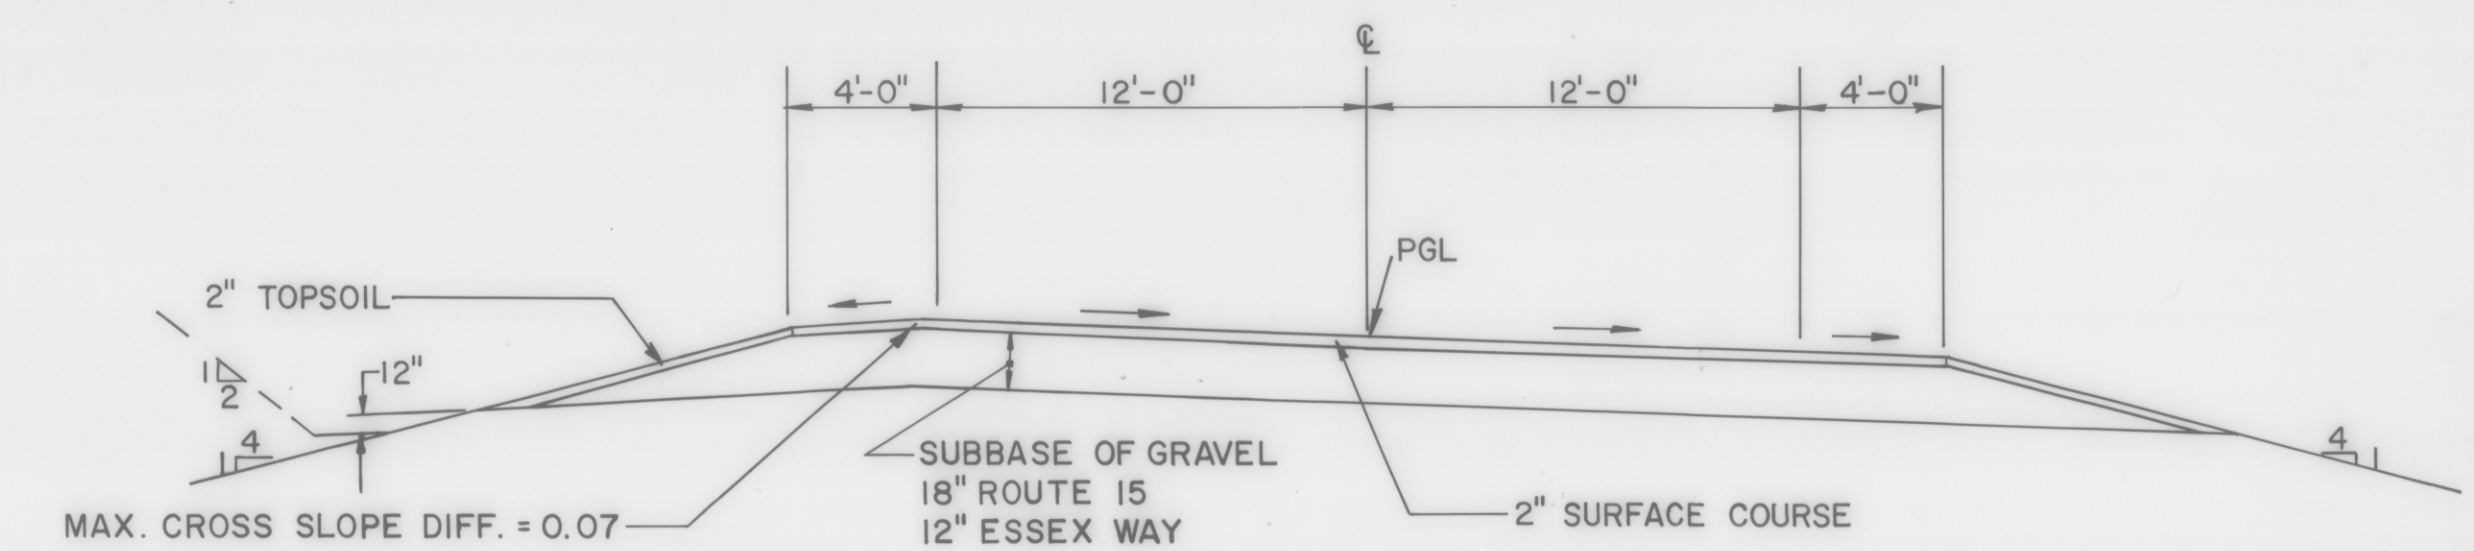

TEMPORARY ROAD-BANKED SECTION
ROUTE 15 AND ESSEX WAY

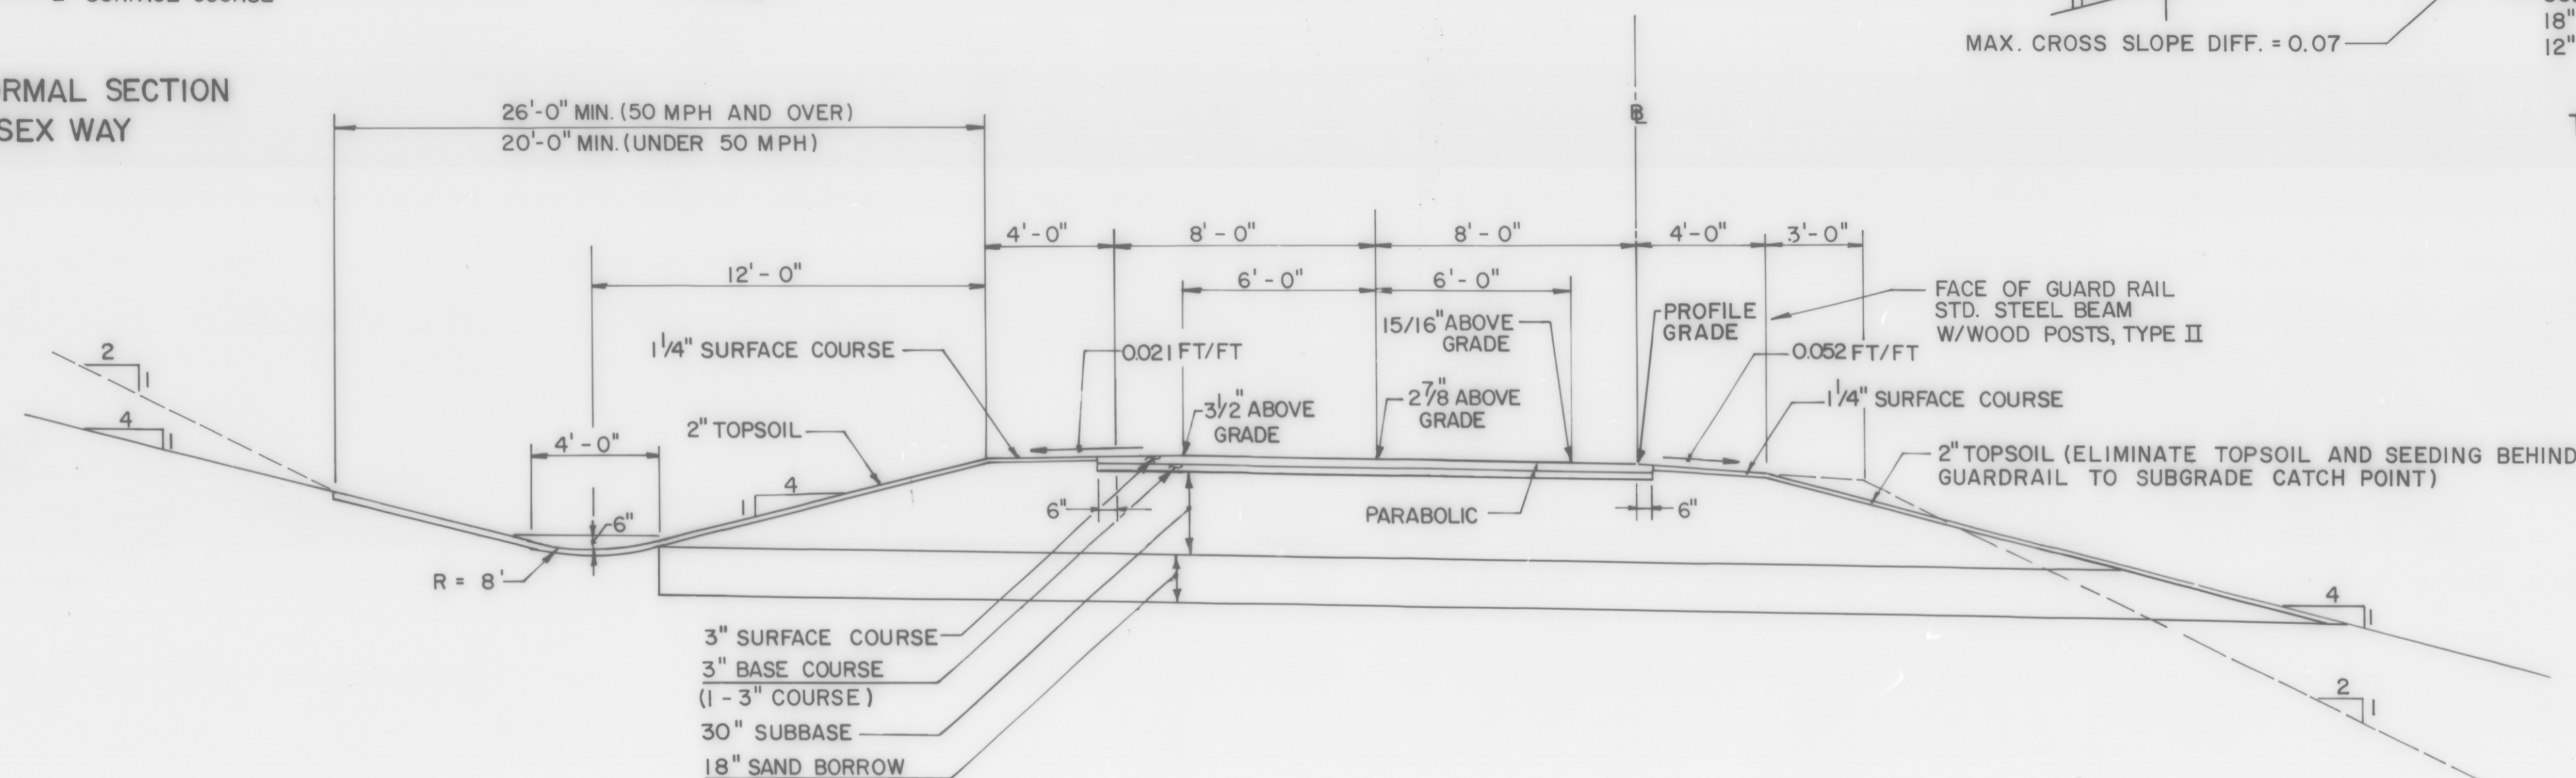

TYPICAL RAMP - NORMAL SECTION

SHOULDER PAVEMENT TO INCLUDE FULL DEPTH PAVEMENT AND BASE:

ROUTE 15 INTERCHANGE

RAMP A STA 9+61 TO 15+00 RT
 STA 21+00 TO 24+29 RT
 RAMP B STA 0+00 TO 3+00 RT
 STA 1+15 TO 2+50 LT
 STA 6+00 TO 9+86 RT
 RAMP C STA 0+00 TO 4+00 RT
 STA 8+00 TO 10+89 RT
 RAMP D STA 0+00 TO 4+00 RT
 STA 11+00 TO 14+78 RT

ESSEX WAY INTERCHANGE

RAMP A STA 0+00 TO 3+50 RT
 STA 6+00 TO 9+75 RT
 RAMP B STA 0+00 TO 5+00 RT
 STA 10+00 TO 14+53 RT
 RAMP C STA 0+24 TO 5+00 RT
 STA 11+00 TO 14+06 RT
 STA 11+00 TO 12+60 LT
 RAMP D STA 0+00 TO 4+00 RT
 STA 8+00 TO 11+02 RT

DATUM
 VERTICAL _____
 HORIZONTAL _____

R.O.W. PLANS

SURVEYED BY PINKHAM ENG DATE 6/86
 DRAWN BY RCA DATE 9/87
 TRACED BY NPD DATE 11/87
 VERMONT ROUTE 289 (F.A.P.)
 TOWN OF ESSEX
 PROJ. WILLISTON NO. PB 033-1(1)
 COLCHESTER
 SHEET 9 OF 55