


TYPICAL SECTIONS

2 1/2" BITUMINOUS CONCRETE PAVEMENT - 1" TYPE III WEARING COURSE, 1 1/2" TYPE II


24" SUBBASE OF DENSE GRADED CRUSHED STONE

SHOULDERS 1 1/4" BITUMINOUS CONCRETE PAVEMENT

0" TO 12" GRANULAR BORROW (IN FILLS) } AS DIRECTED BY THE ENGINEER
0" TO 24" SAND BORROW (IN CUTS)

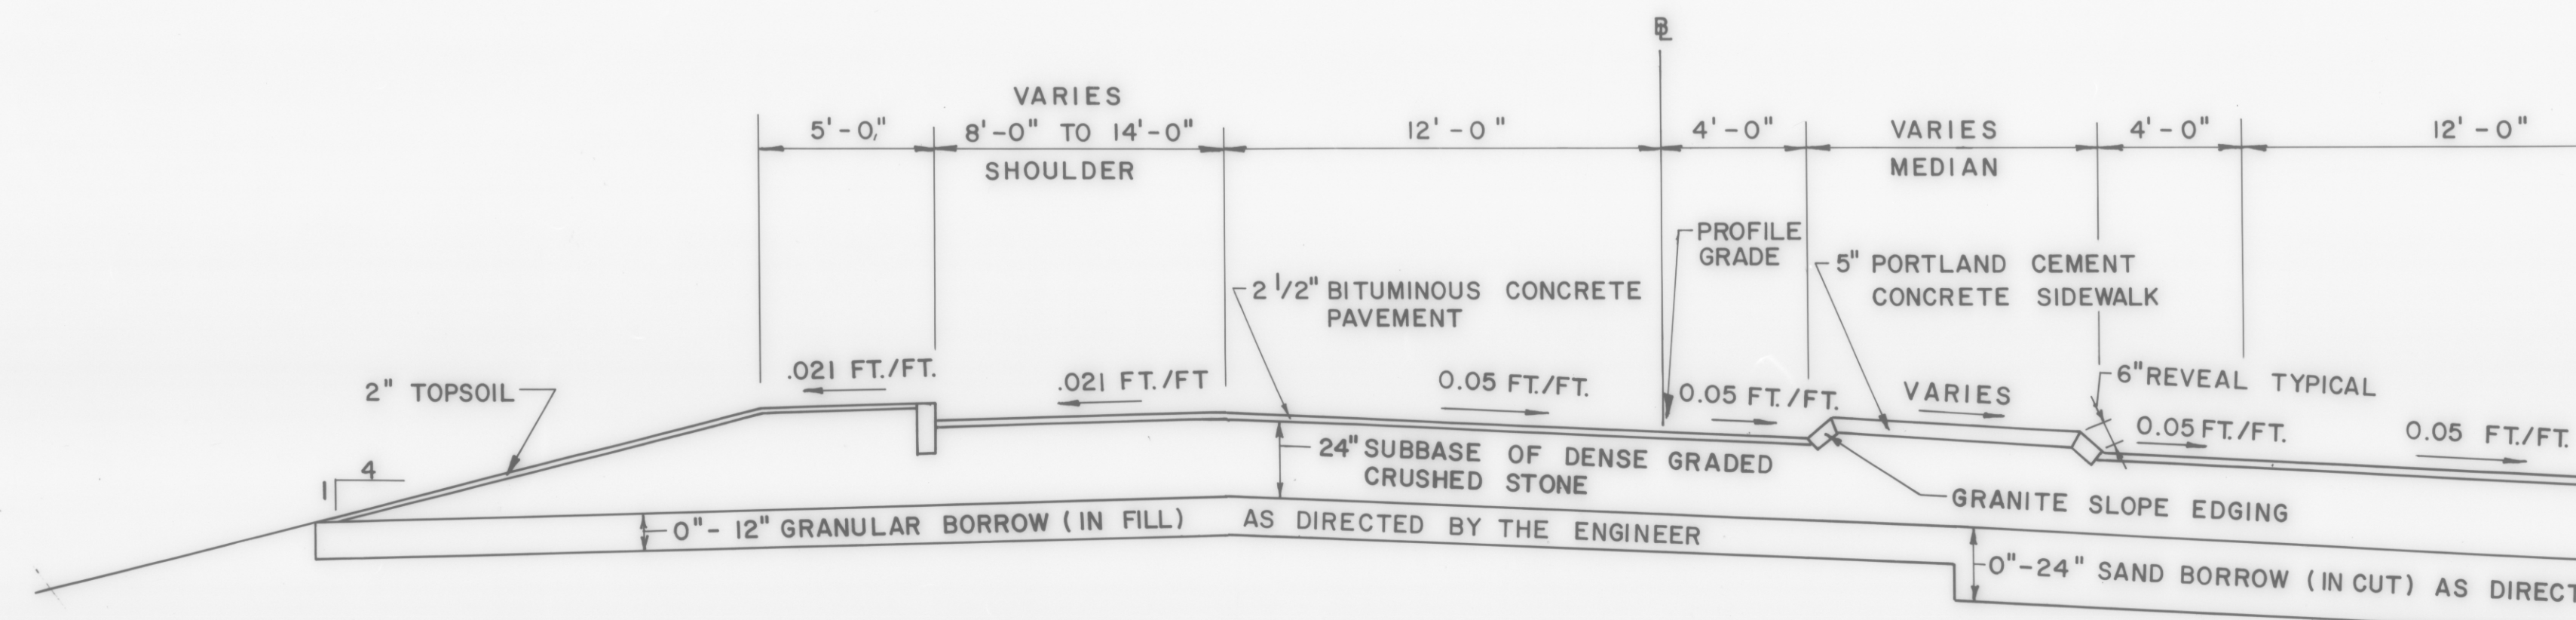

ESSEX WAY BANKED SECTION
(WITH MEDIAN)

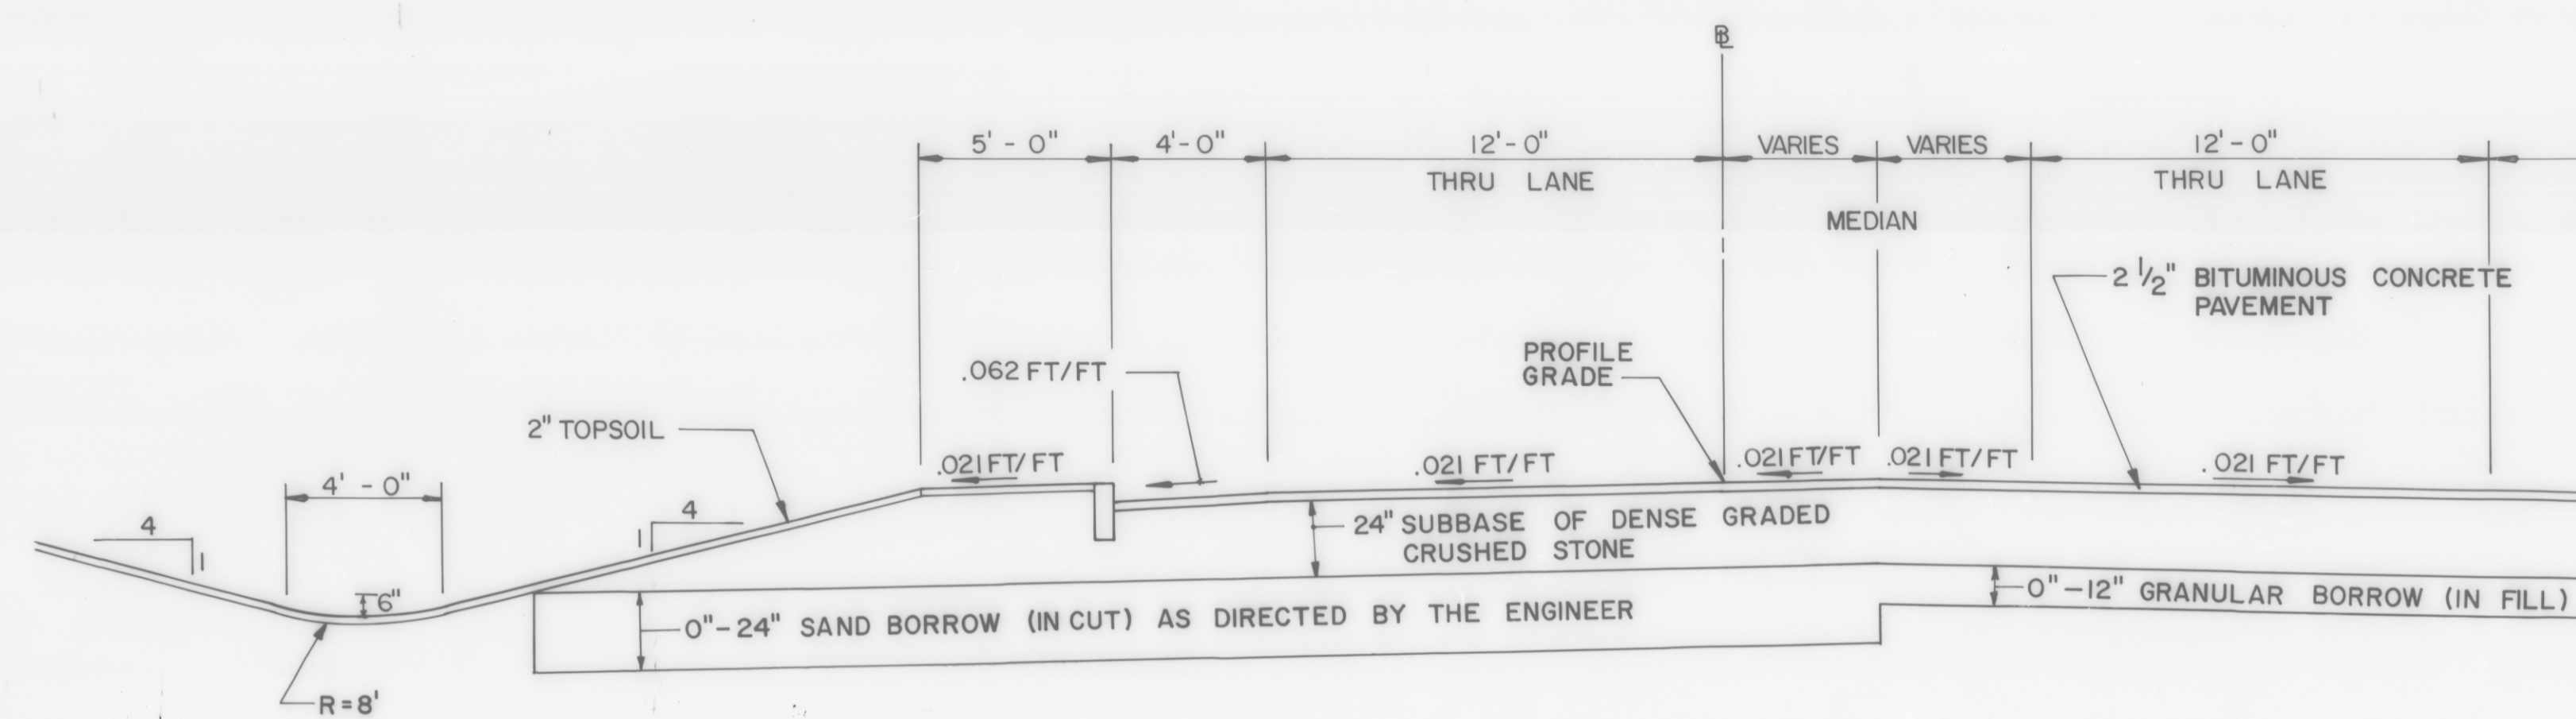

ESSEX WAY NORMAL SECTION

DATUM	
VERTICAL	_____
HORIZONTAL	_____