


PROFILE		DATE
SUBMITTED	BY	
NOTED		
GRADES CHECKED		
B.M. # NOTED		
NO.	STRUCTURE	NOTATION CHNO



PROFILE		DATE
SUBMITTED	BY	
NOTED		
GRADES CHECKED		
B.M. # NOTED		
NO.	STRUCTURE	NOTATION CHNO

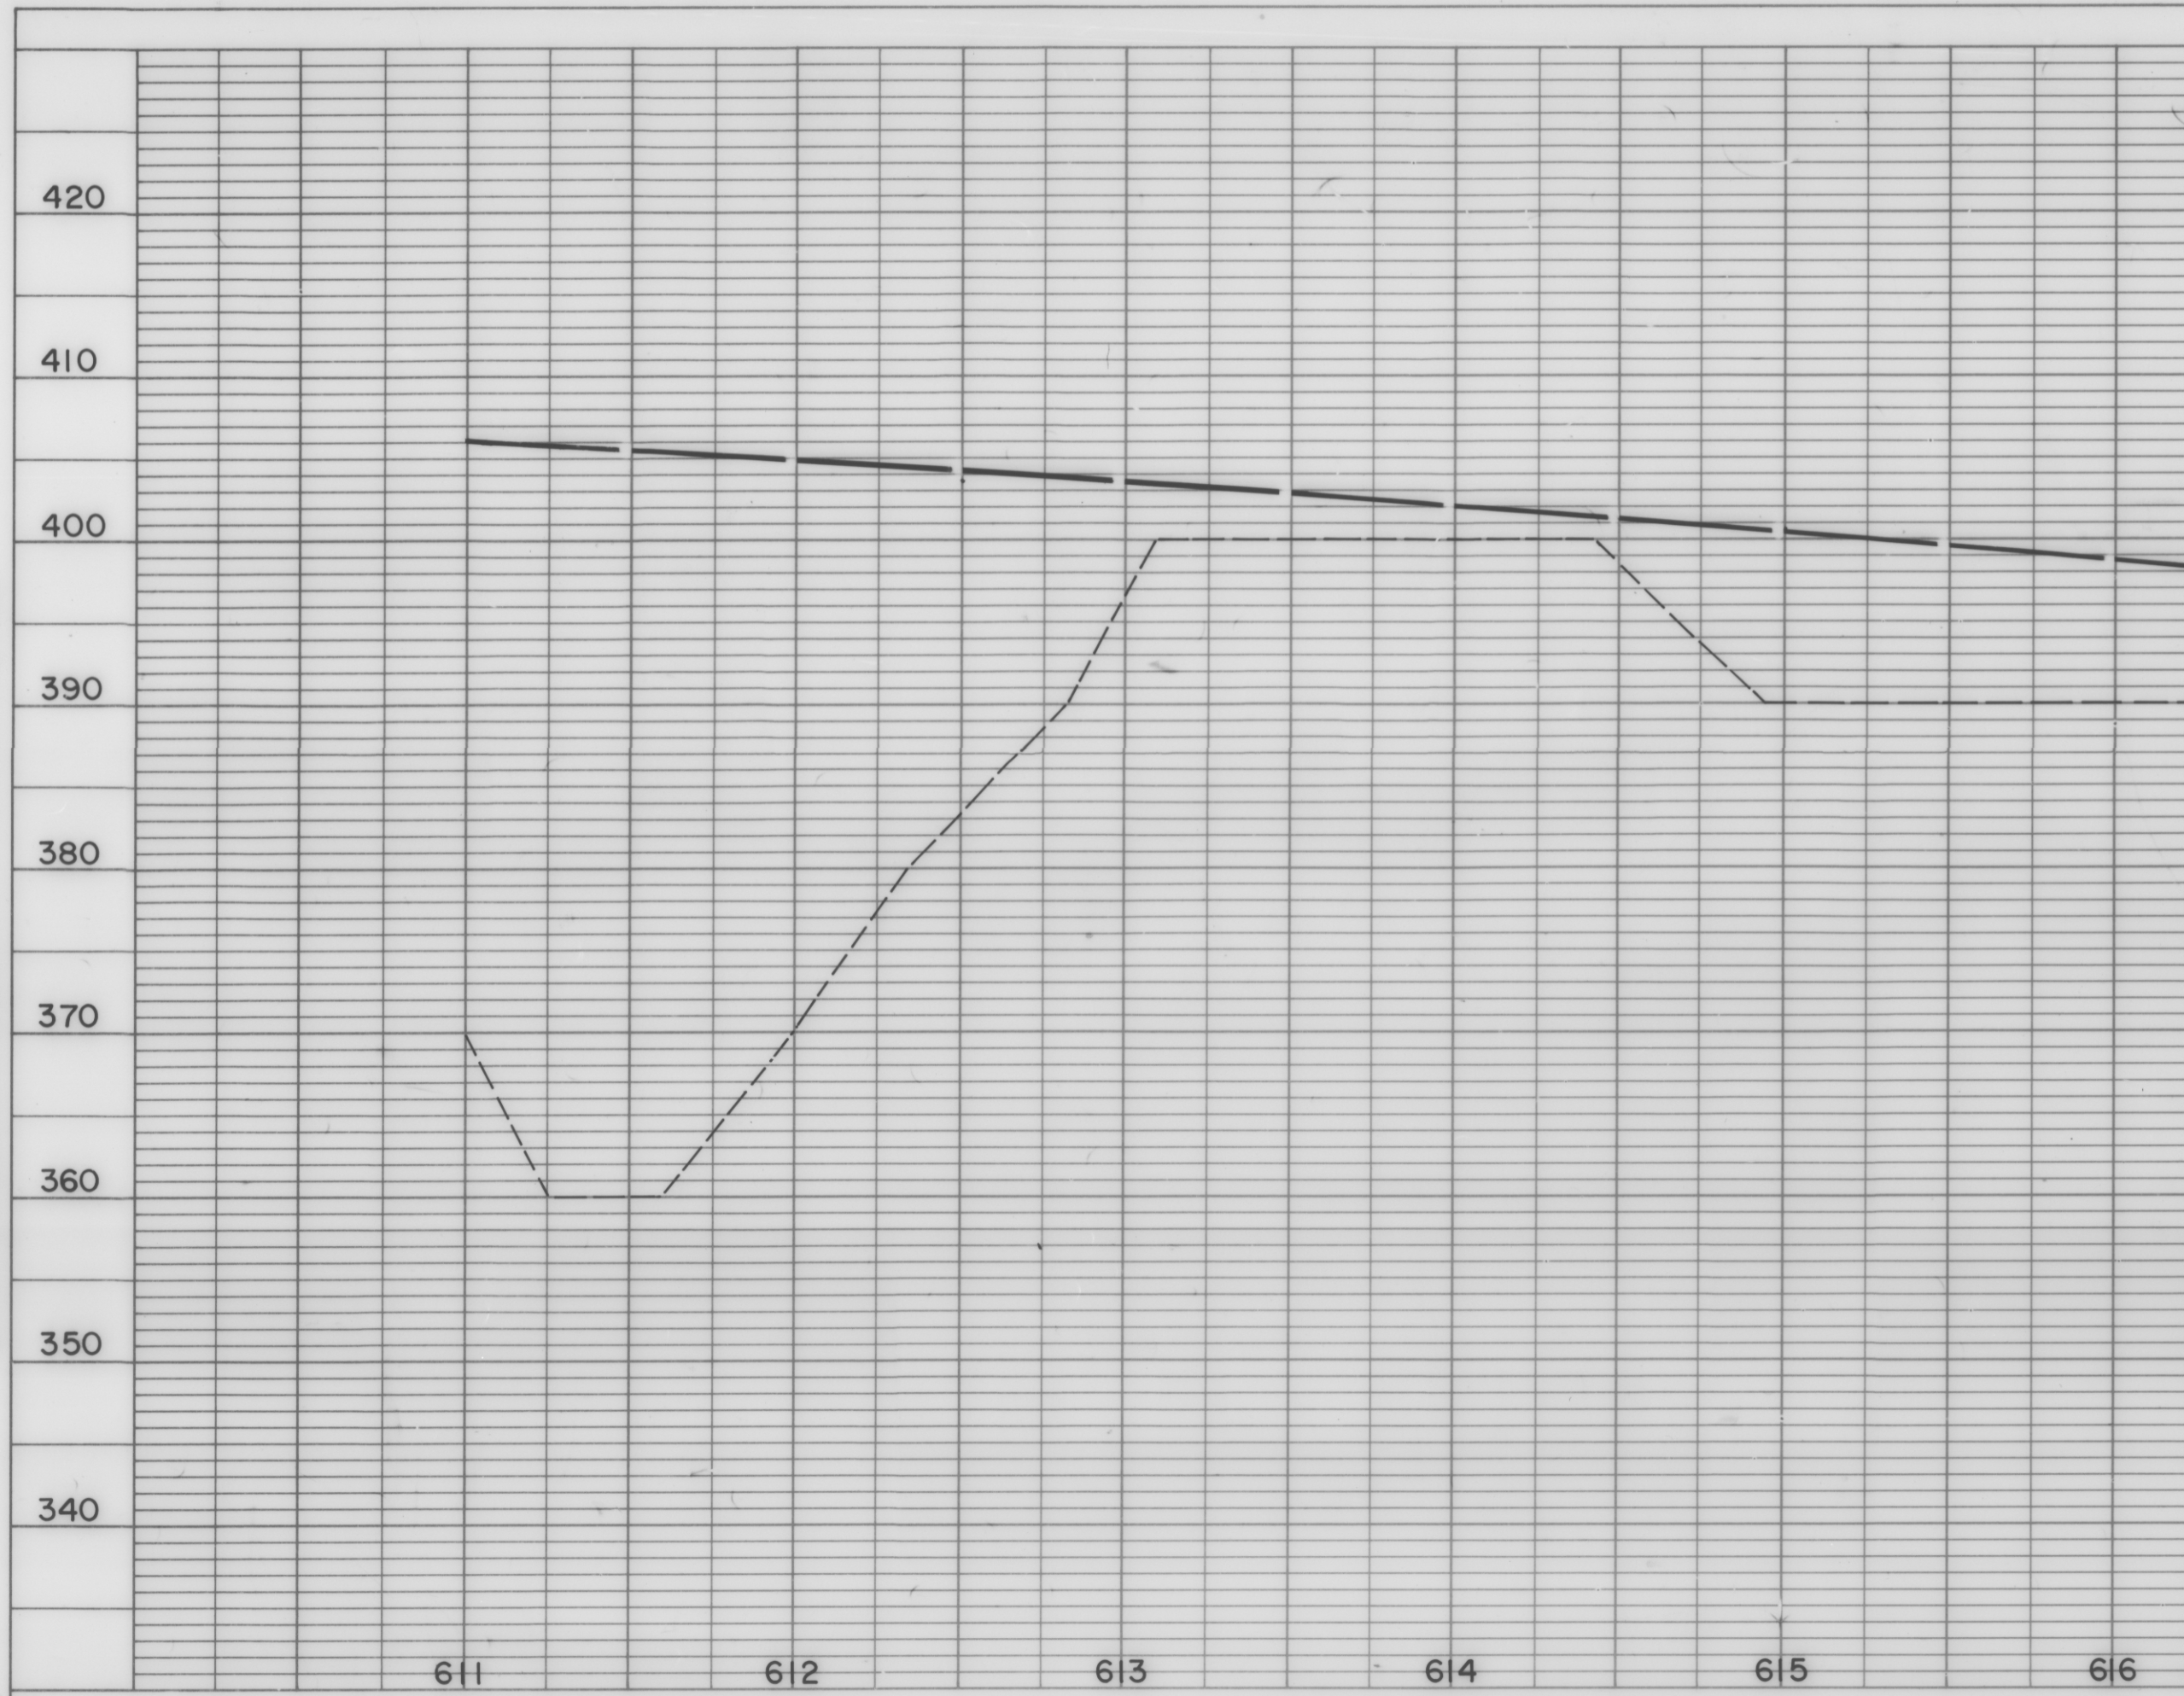