


PROFILE	SURVEYED	BY	DATE
	PLOTTED		
	NOTE BOOK		
	GRADES CHECKED		
	B.M. * NOTED		
	NO.		
	STRUCTURE NOTATIONS CH'RD		



PROFILE	SURVEYED	BY	DATE
	PLOTTED		
	NOTE BOOK		
	GRADES CHECKED		
	B.M. * NOTED		
	NO.		
	STRUCTURE NOTATIONS CH'RD		

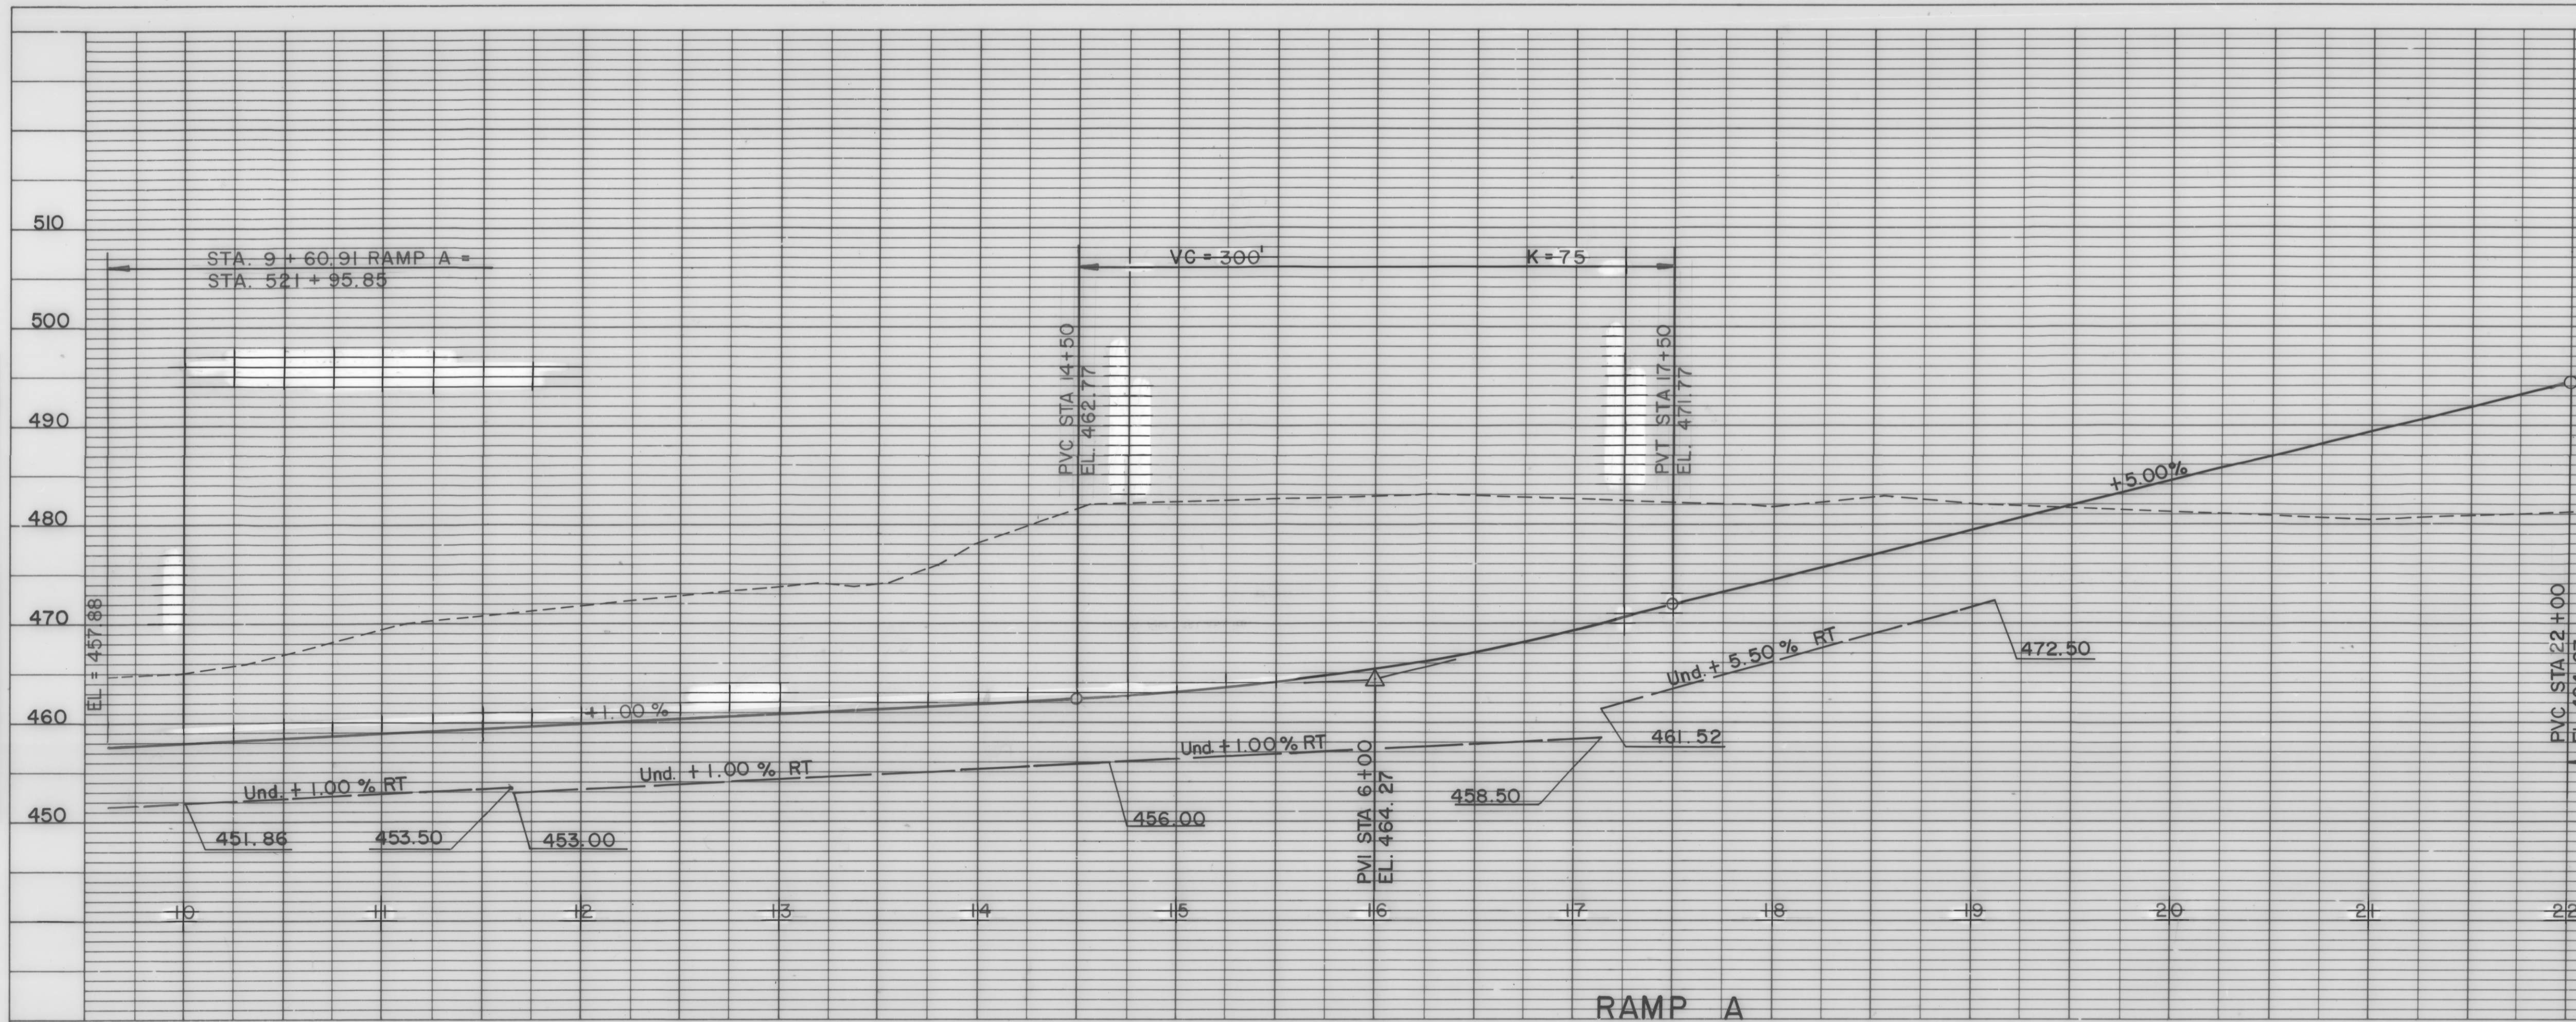