

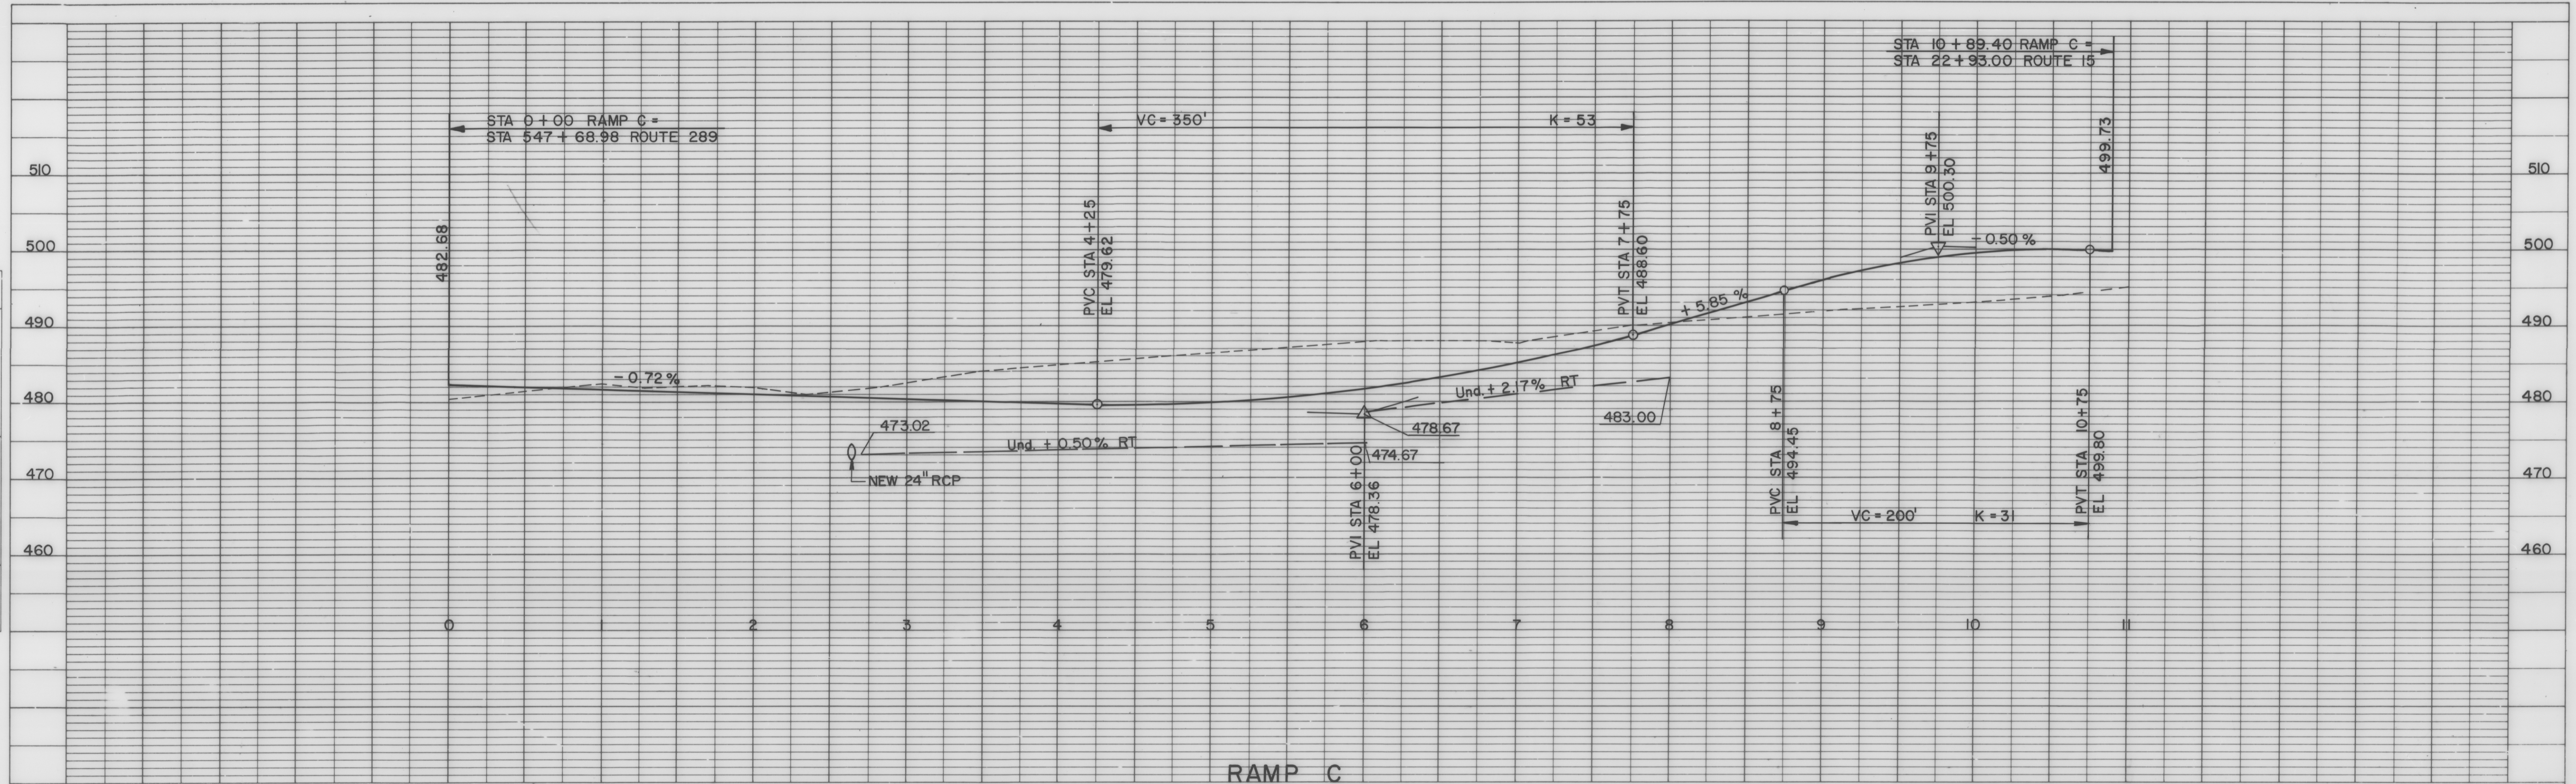


PROFILE	SURVEYED	DATE
NOTE BOOK	GRADES CHECKED	
NO.	BY	
	STRUCTURE NOTATIONS CH'RD	

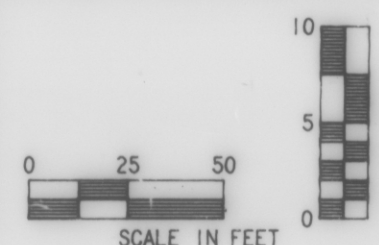

PROFILE	SURVEYED	DATE
NOTE BOOK	GRADES CHECKED	
NO.	BY	
	STRUCTURE NOTATIONS CH'RD	

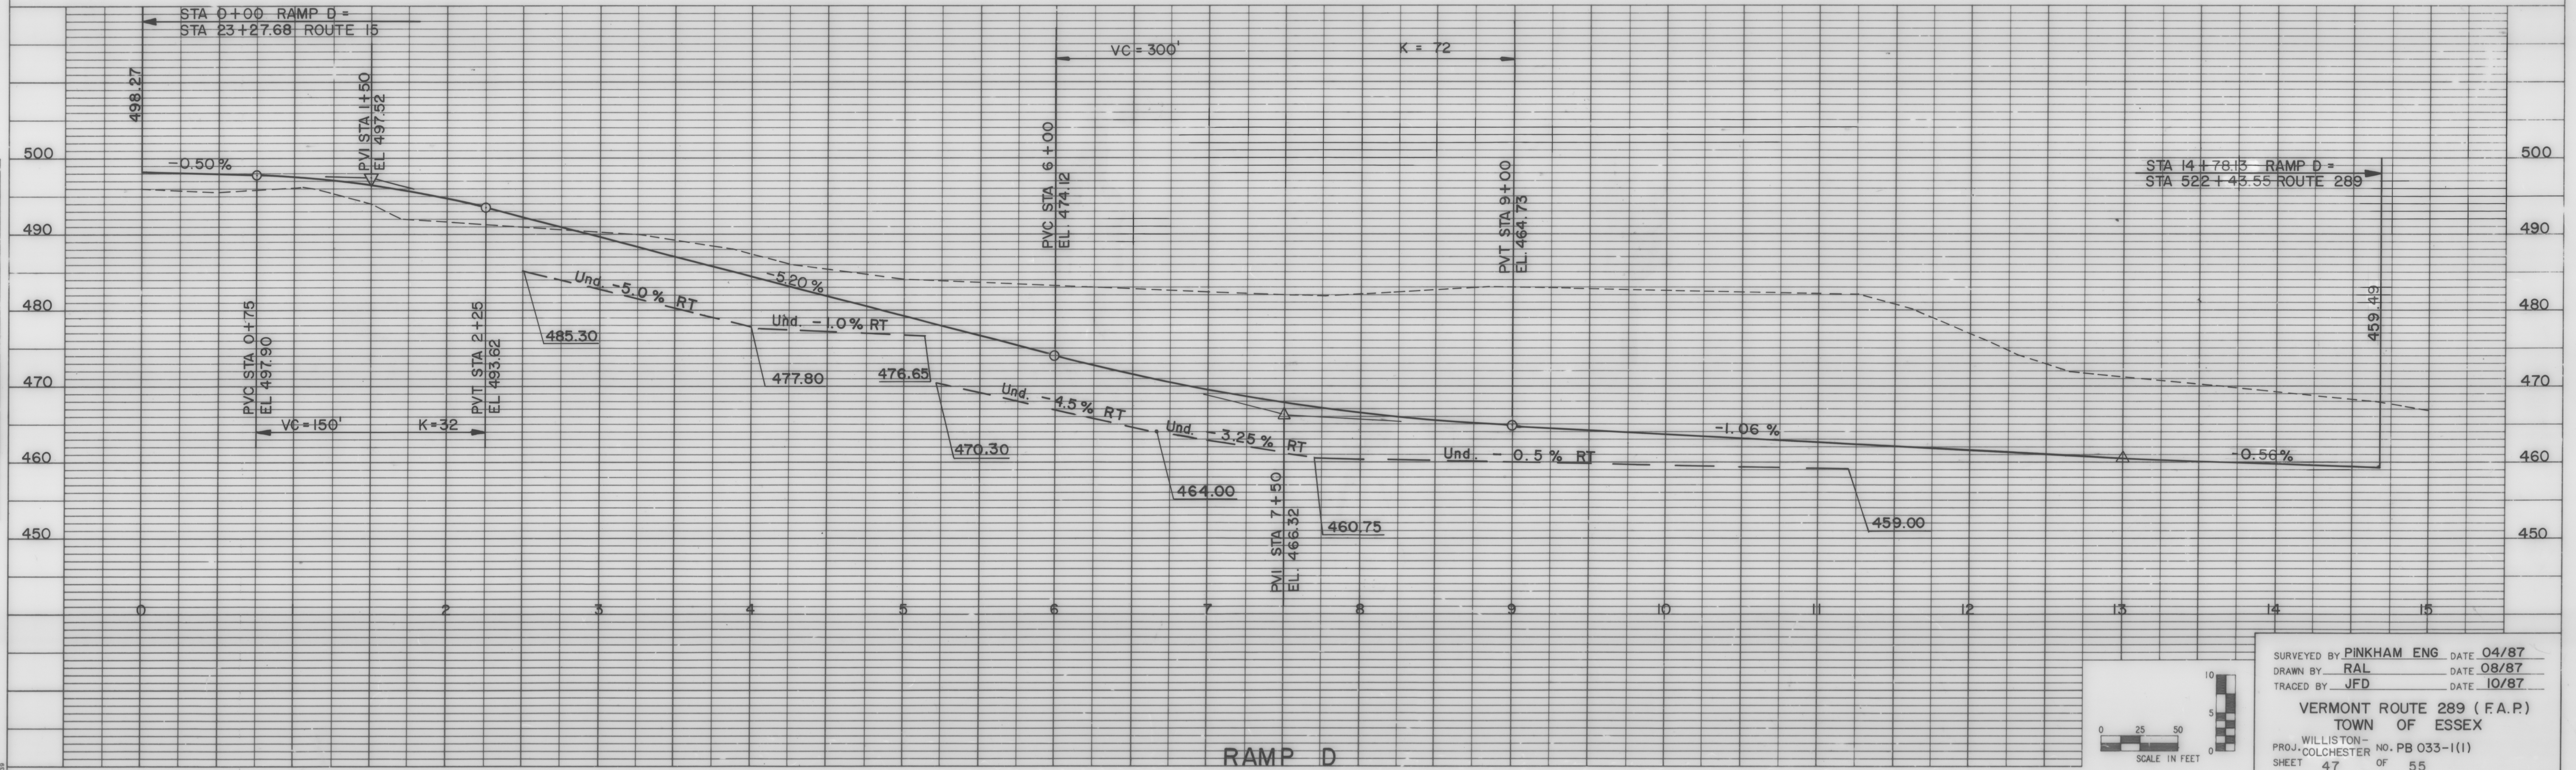

SURVEYED BY PINKHAM ENG. DATE 04/87
 DRAWN BY RAL DATE 08/87
 TRACED BY JFD DATE 10/87

VERMONT ROUTE 289 (F.A.P.)
 TOWN OF ESSEX

WILLISTON-
 PROJ. COLCHESTER NO. PB 033-1(1)
 SHEET 47 OF 55