


PROFILE		DATE	
SURVEYED	BY		
NOTE BOOK			
GRADES CHECKED			
S.M. # NOTED			
NO.			
STRUCTURE NOTATIONS CH'RD			



PROFILE		DATE	
SURVEYED	BY		
NOTE BOOK			
GRADES CHECKED			
S.M. # NOTED			
NO.			
STRUCTURE NOTATIONS CH'RD			

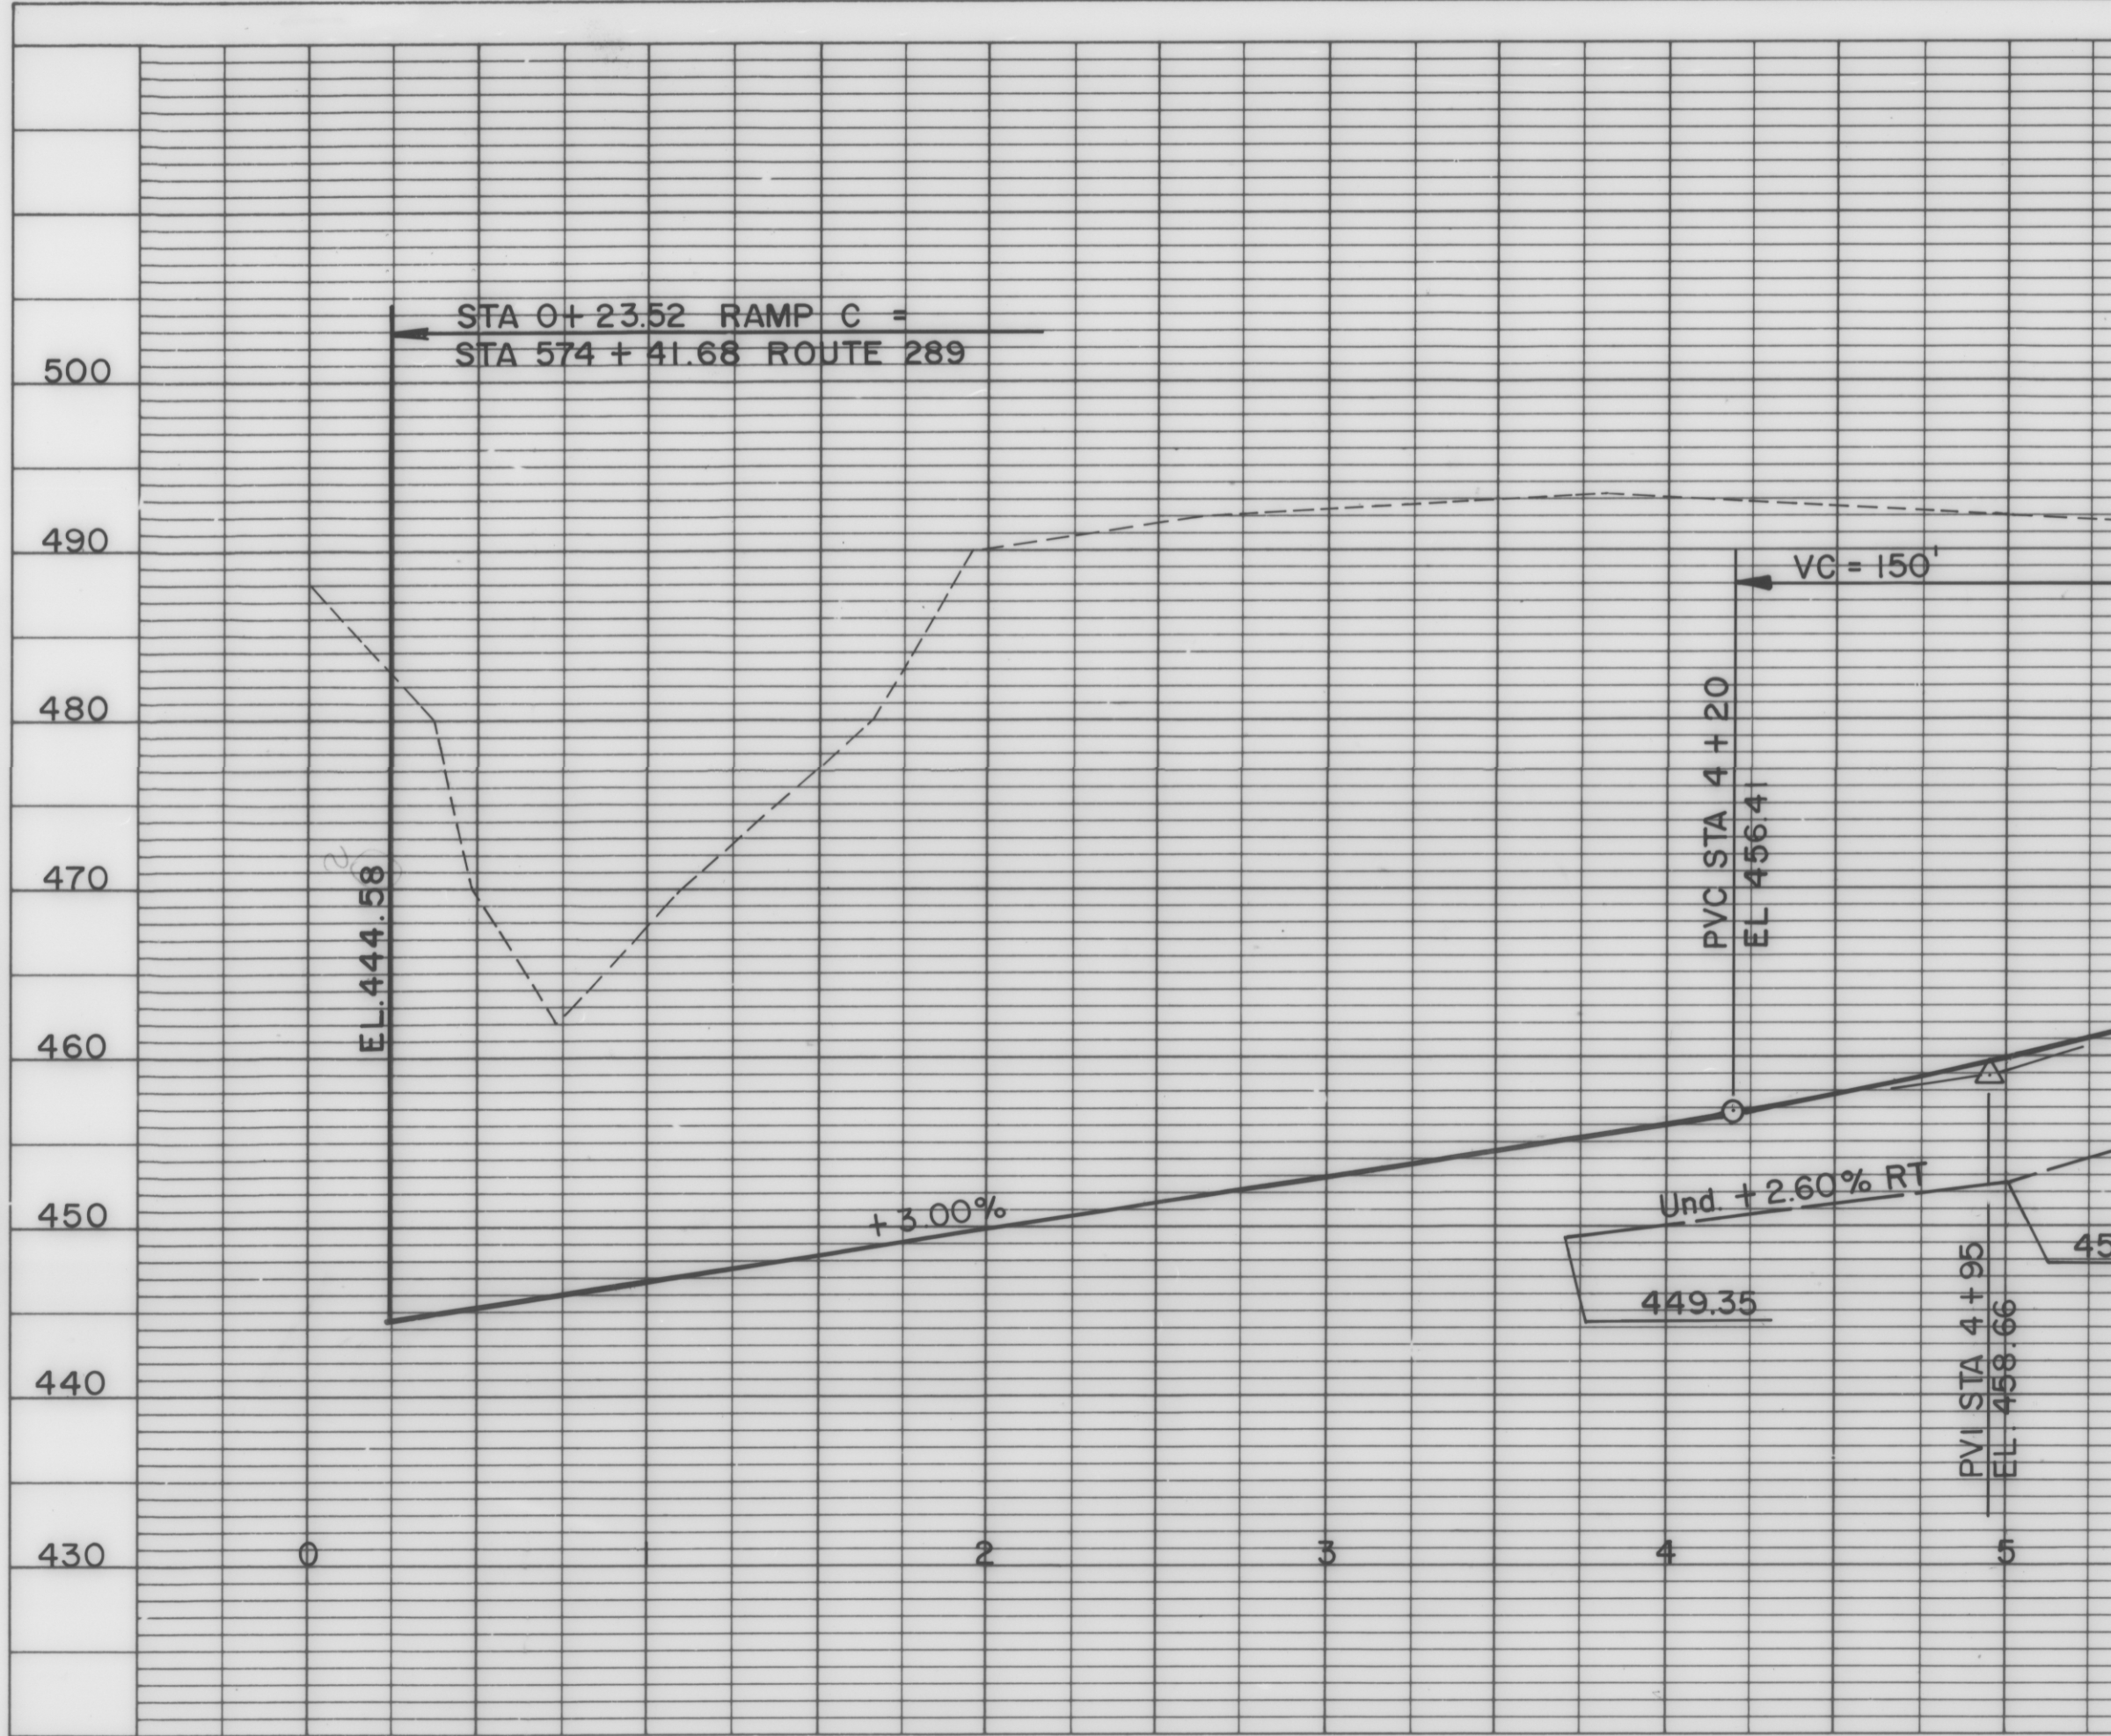