


PROFILE		DATE
SURVEYED	BY	
NOTE BOOK		
GRADES CHECKED		
B.M.'s NOTED		
NO.	STRUCTURE NOTATIONS CH'NO	



PROFILE		DATE
SURVEYED	BY	
NOTE BOOK		
GRADES CHECKED		
B.M.'s NOTED		
NO.	STRUCTURE NOTATIONS CH'NO	

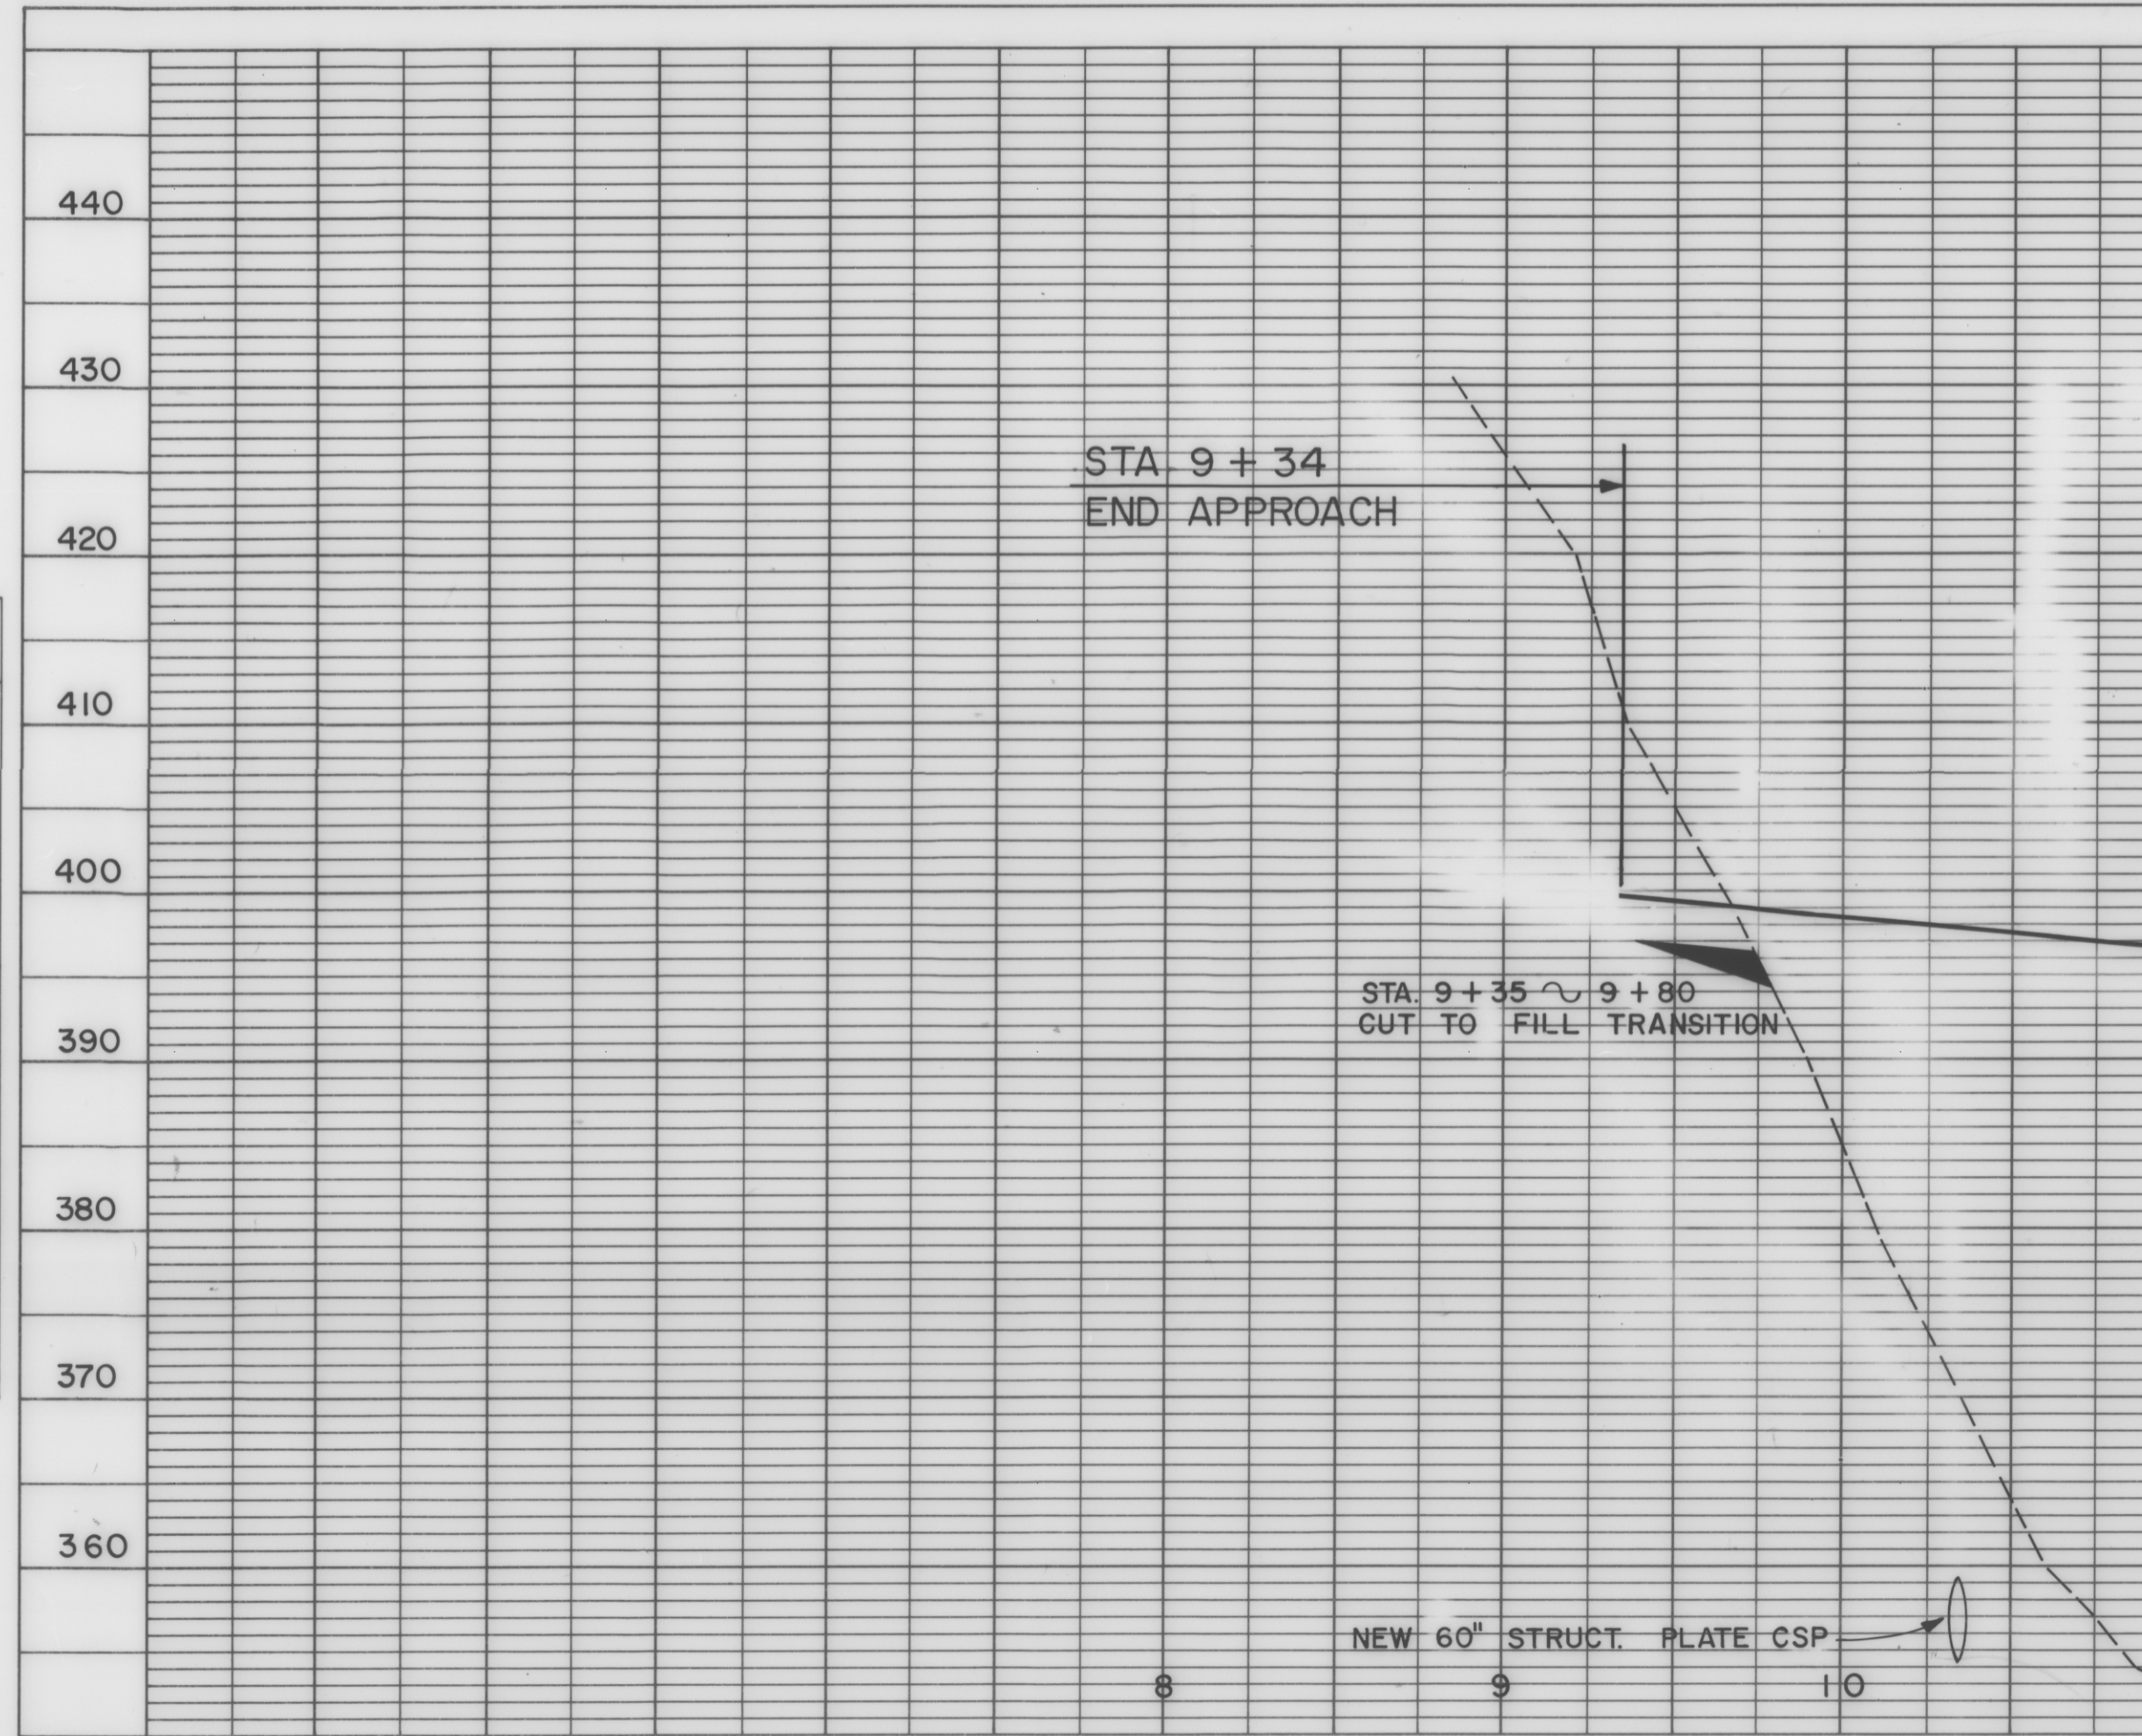