



NOTE: DESIGN FROST DEPTH - 53 "

TYPICAL SECT AT INTERSTATE

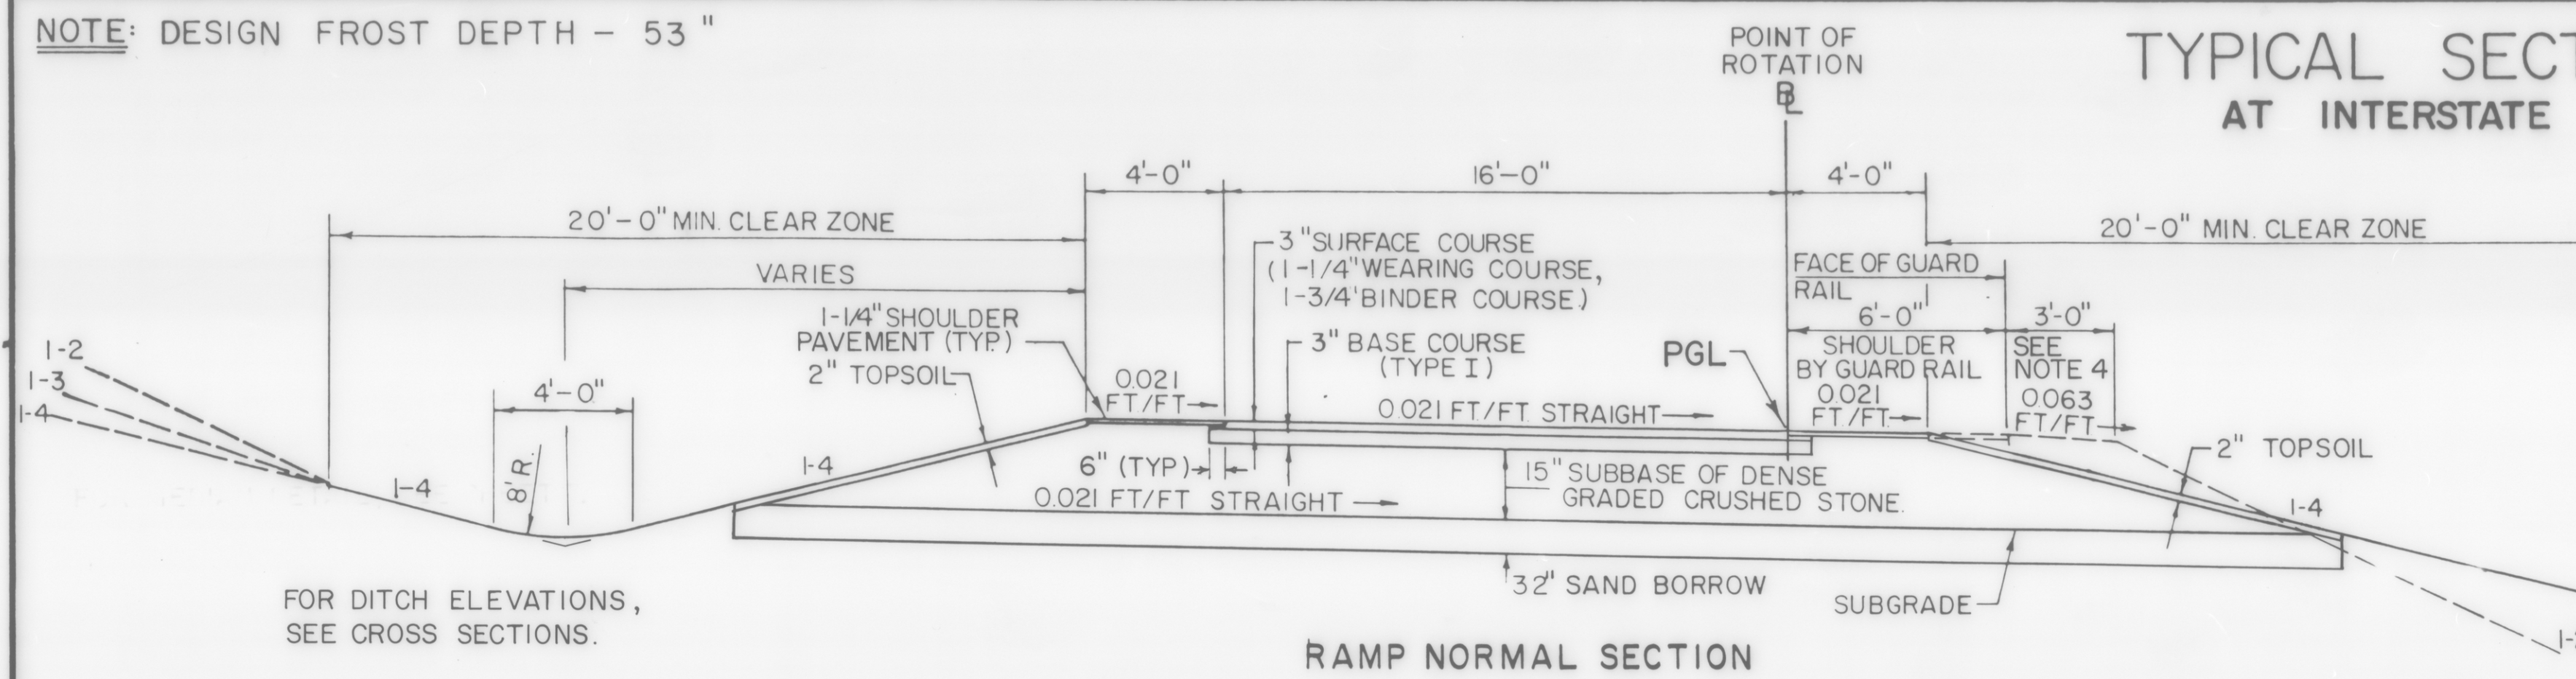

RAMP NORMAL SECTION

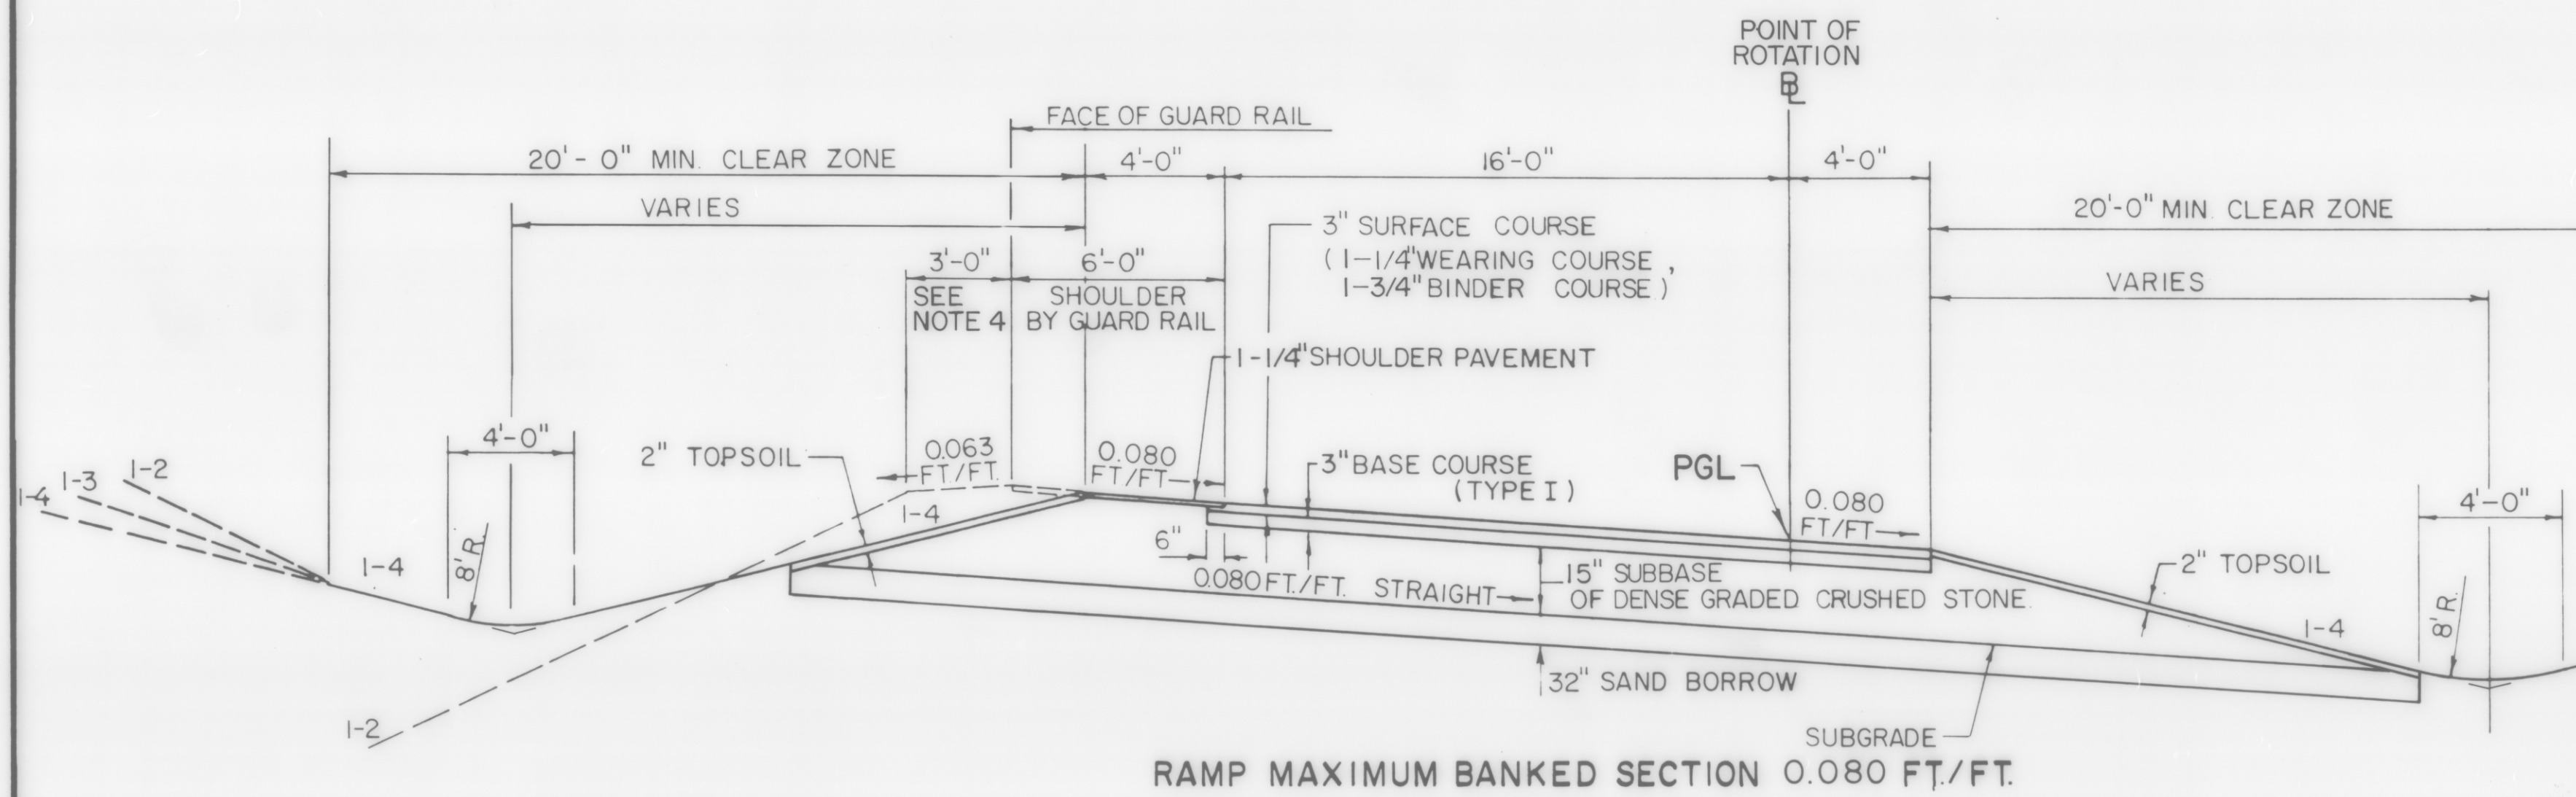

RAMP MAXIMUM BANKED SECTION 0.080 FT/FT.