



NOTE: DESIGN FROST DEPTH - 54"


TYPICAL SECTIONS - RAMPS AT SEVERANCE RD.

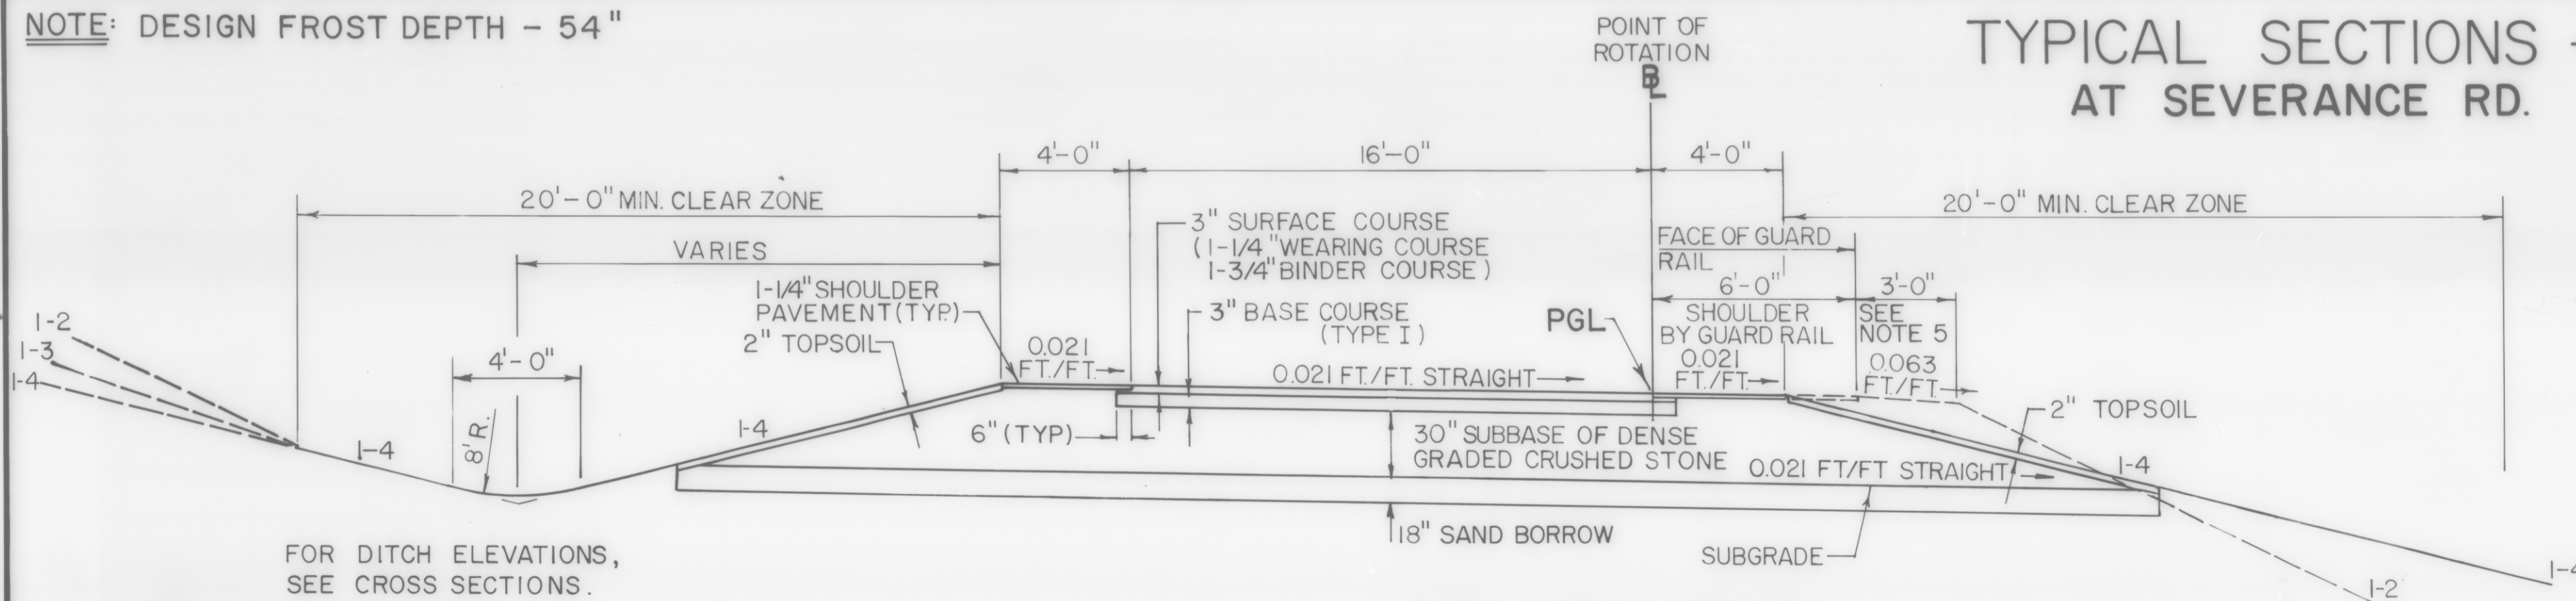


RAMP NORMAL SECTION

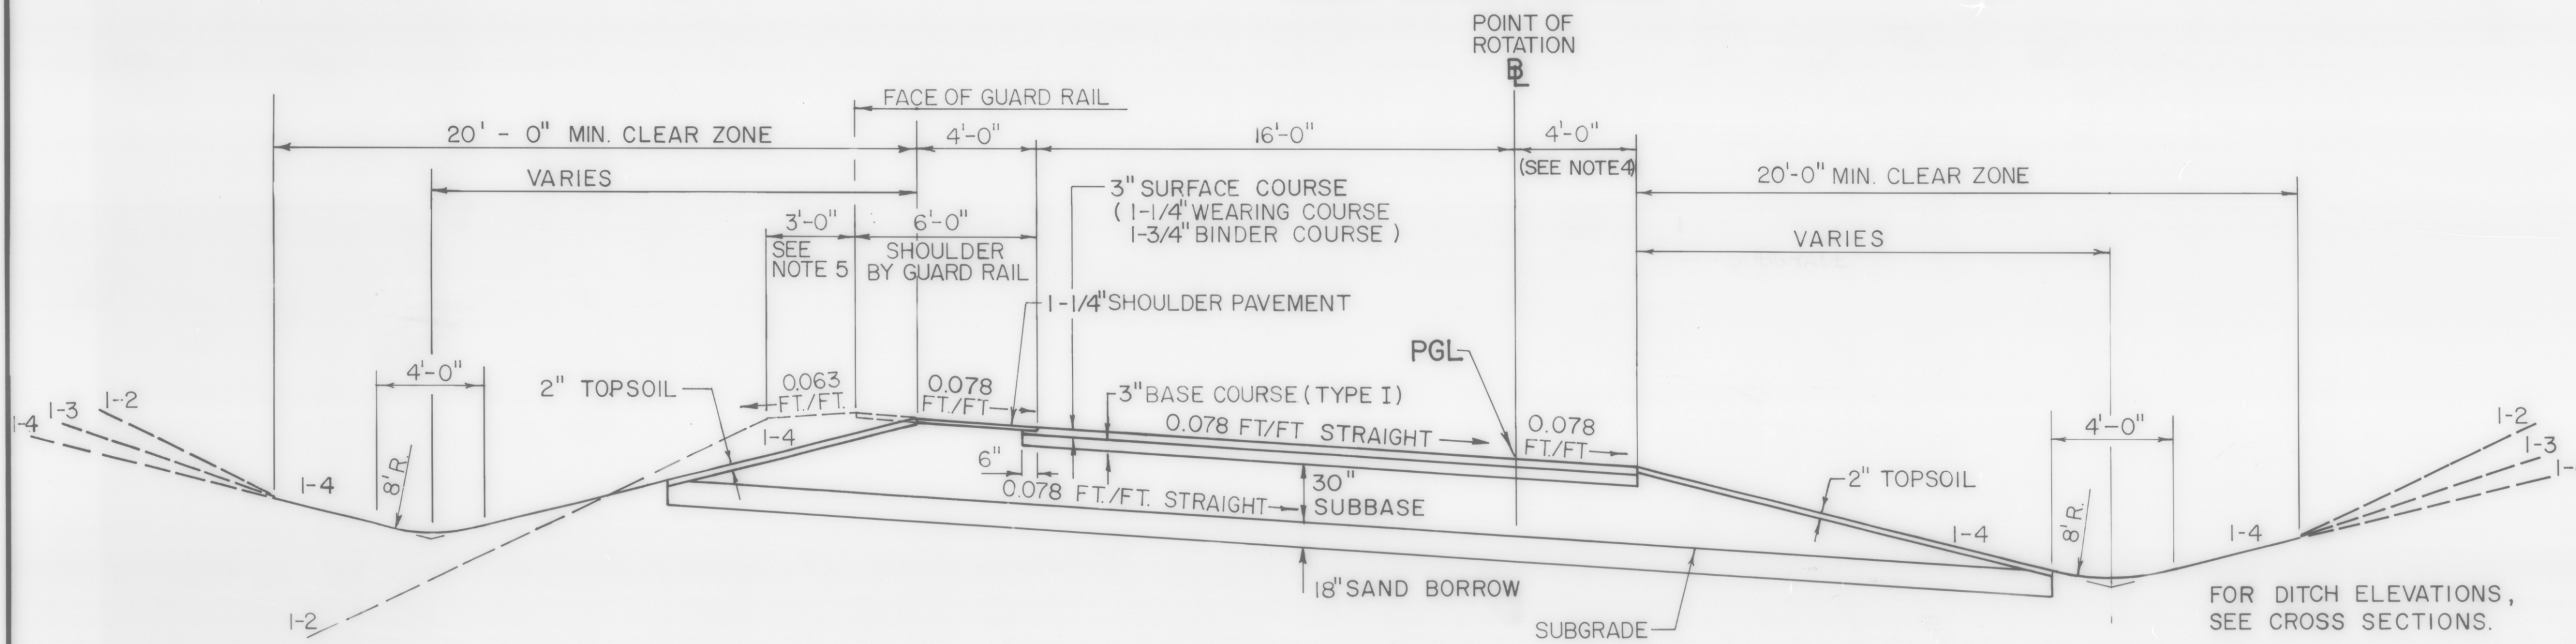


RAMP MAXIMUM BANKED SECTION 0.078 FT./FT.

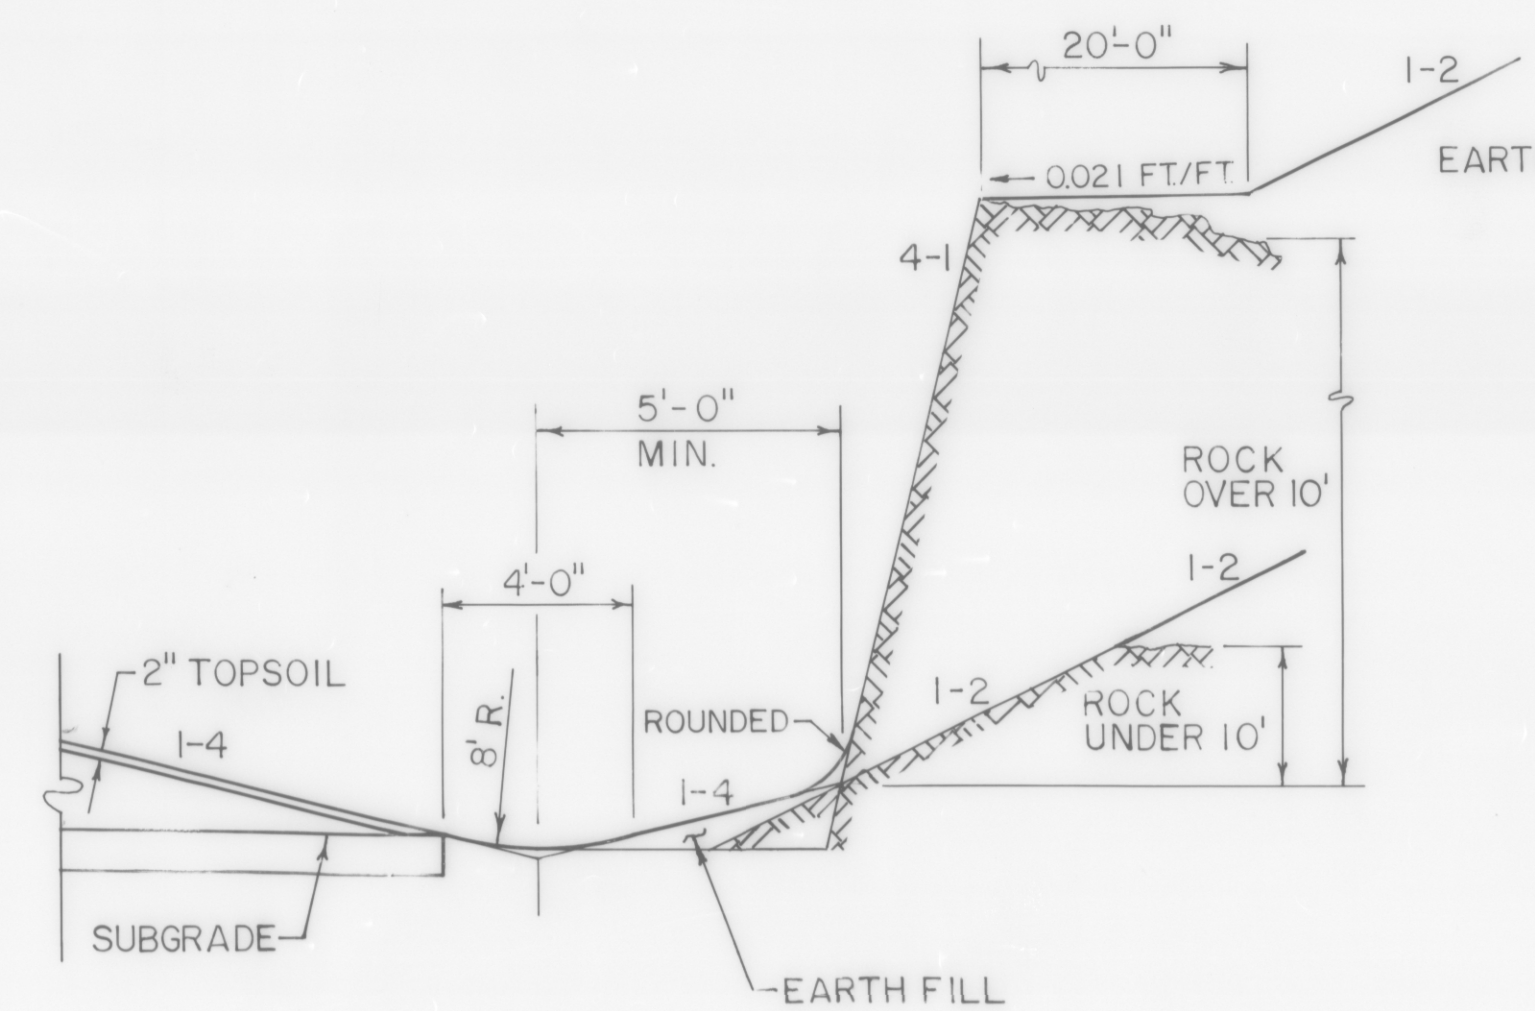


DETAIL OF DITCH AND BACKSLOPE
IN ROCK CUT

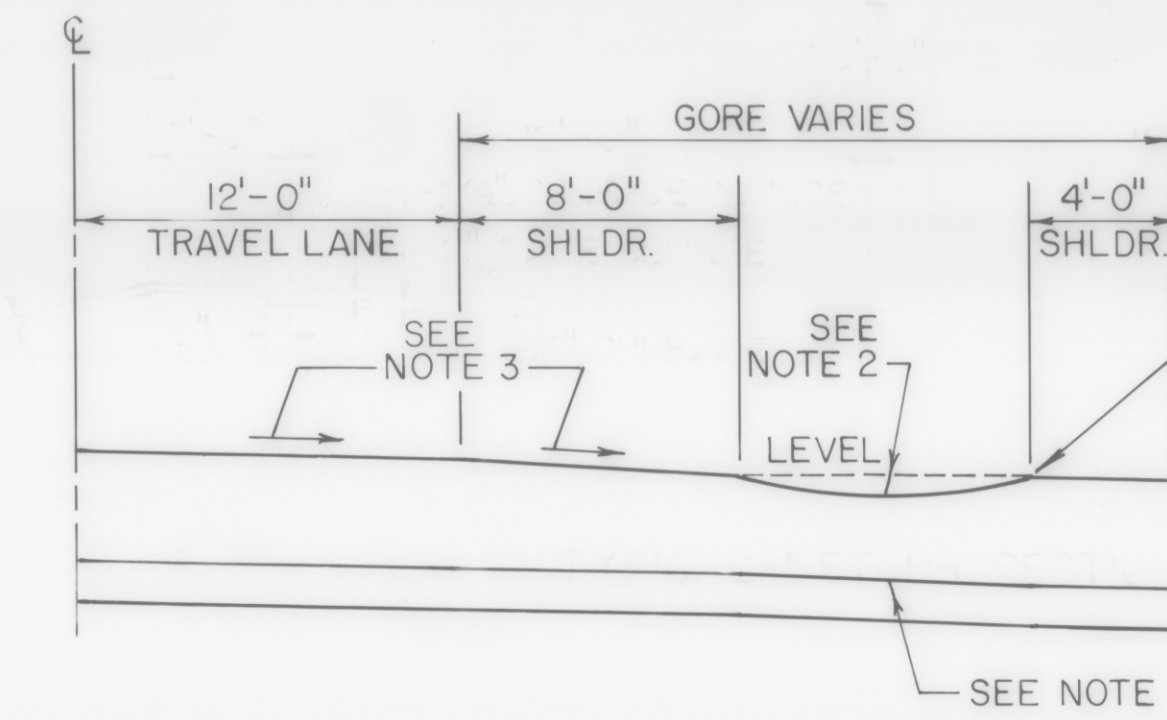

GORE DETAIL
> 12'-0"

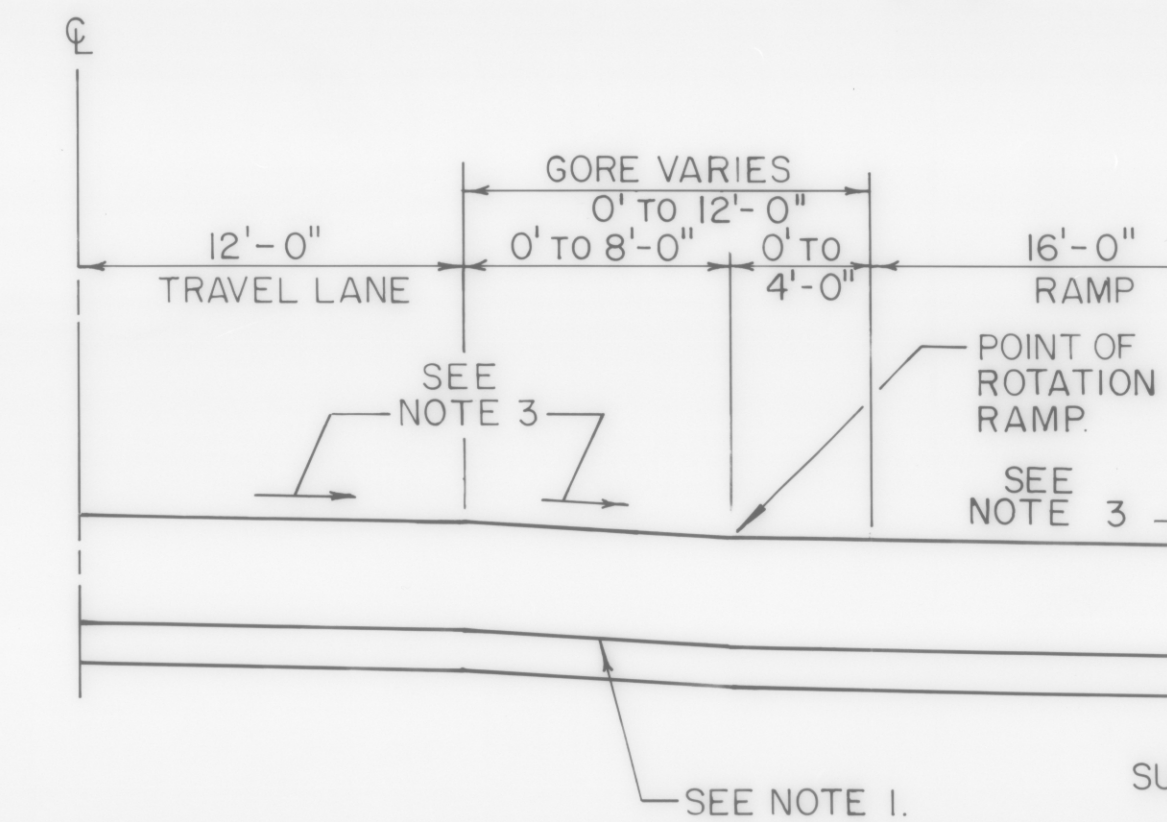

GORE DETAIL
≤ 12'-0"

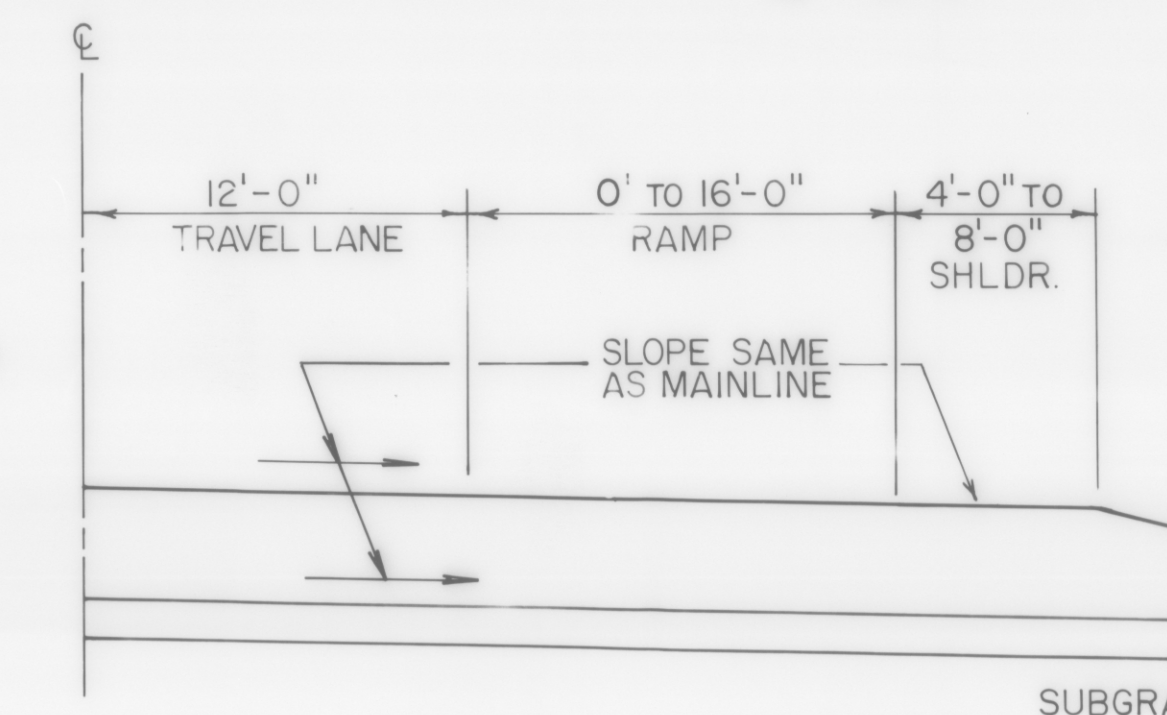

RAMP TAPER DETAIL
OUTSIDE OF GORE

R.O.W. PLA

THIS SHEET TO BE
FOR R.O.W. INFORMA
ONLY.