
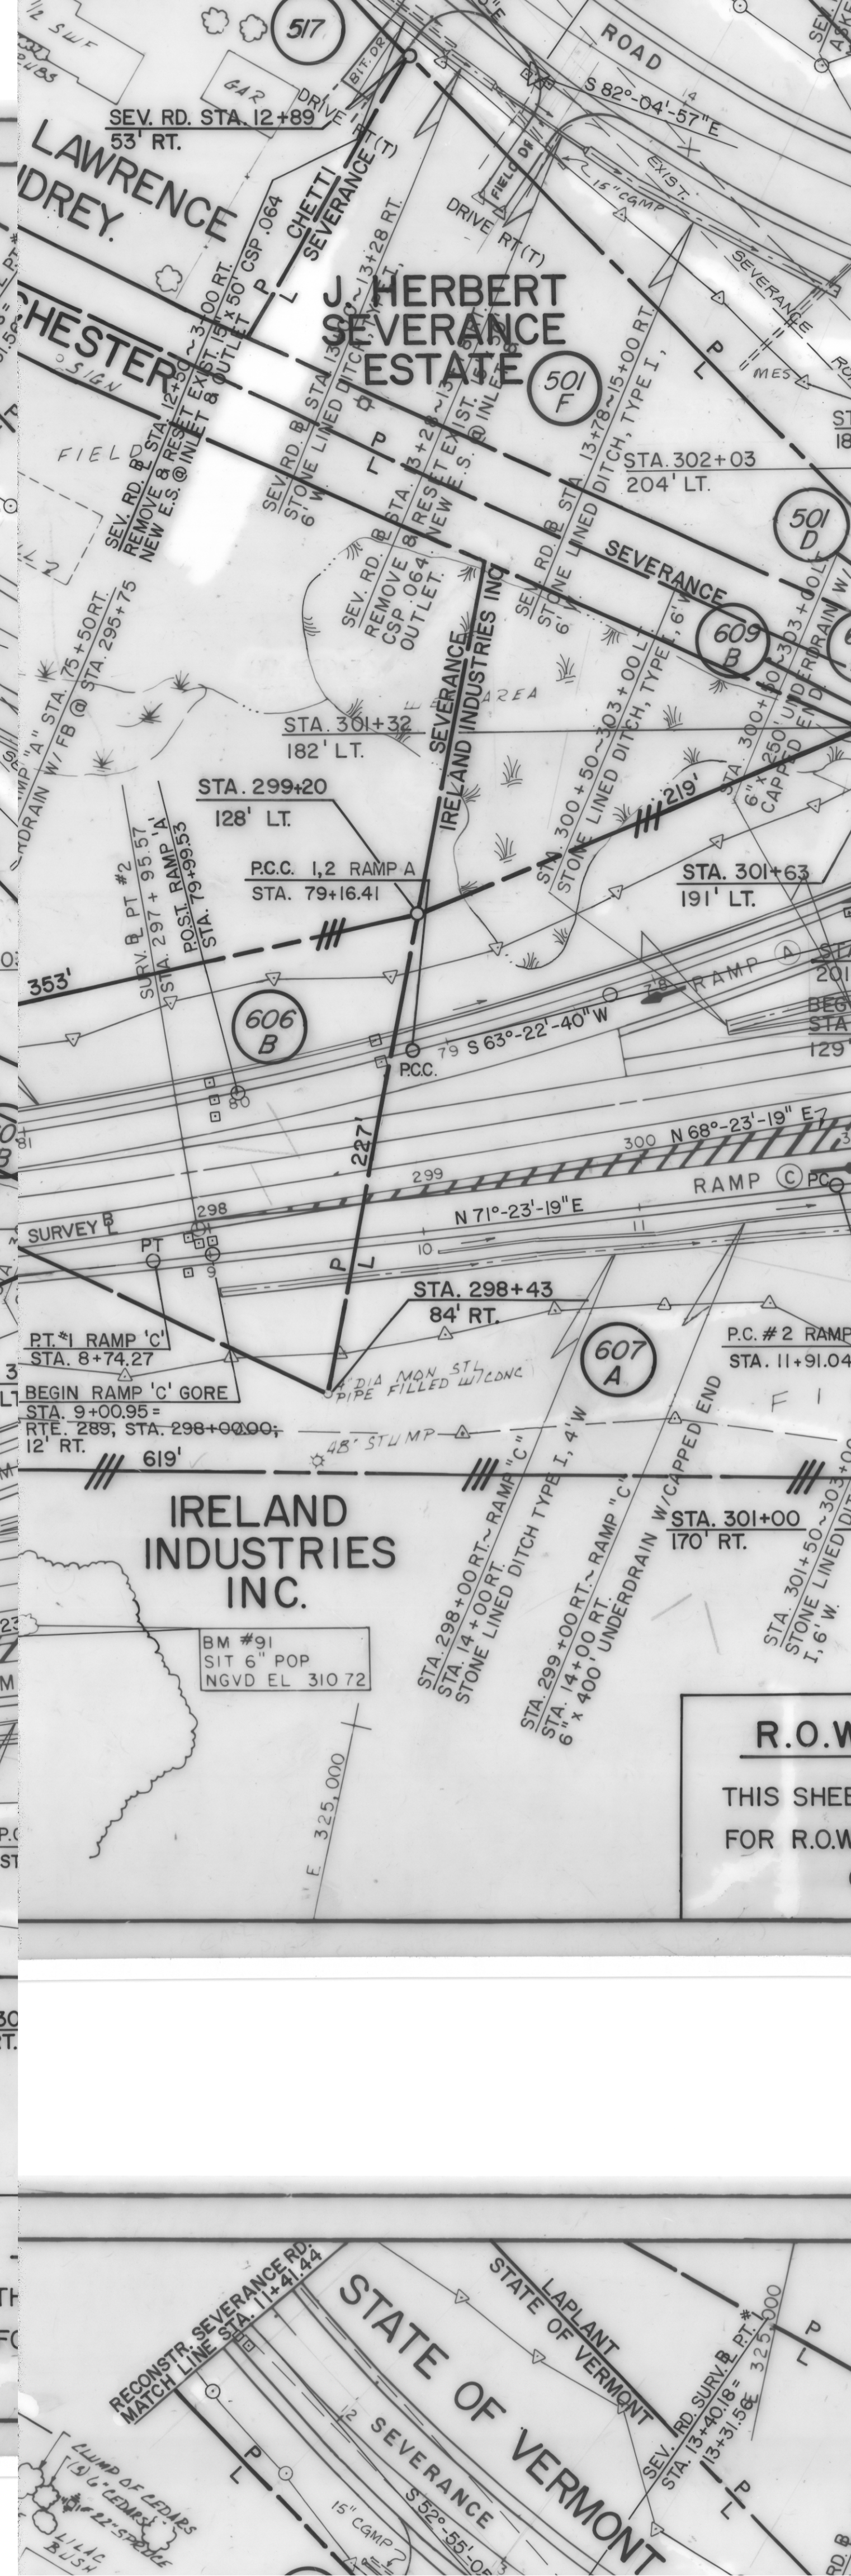


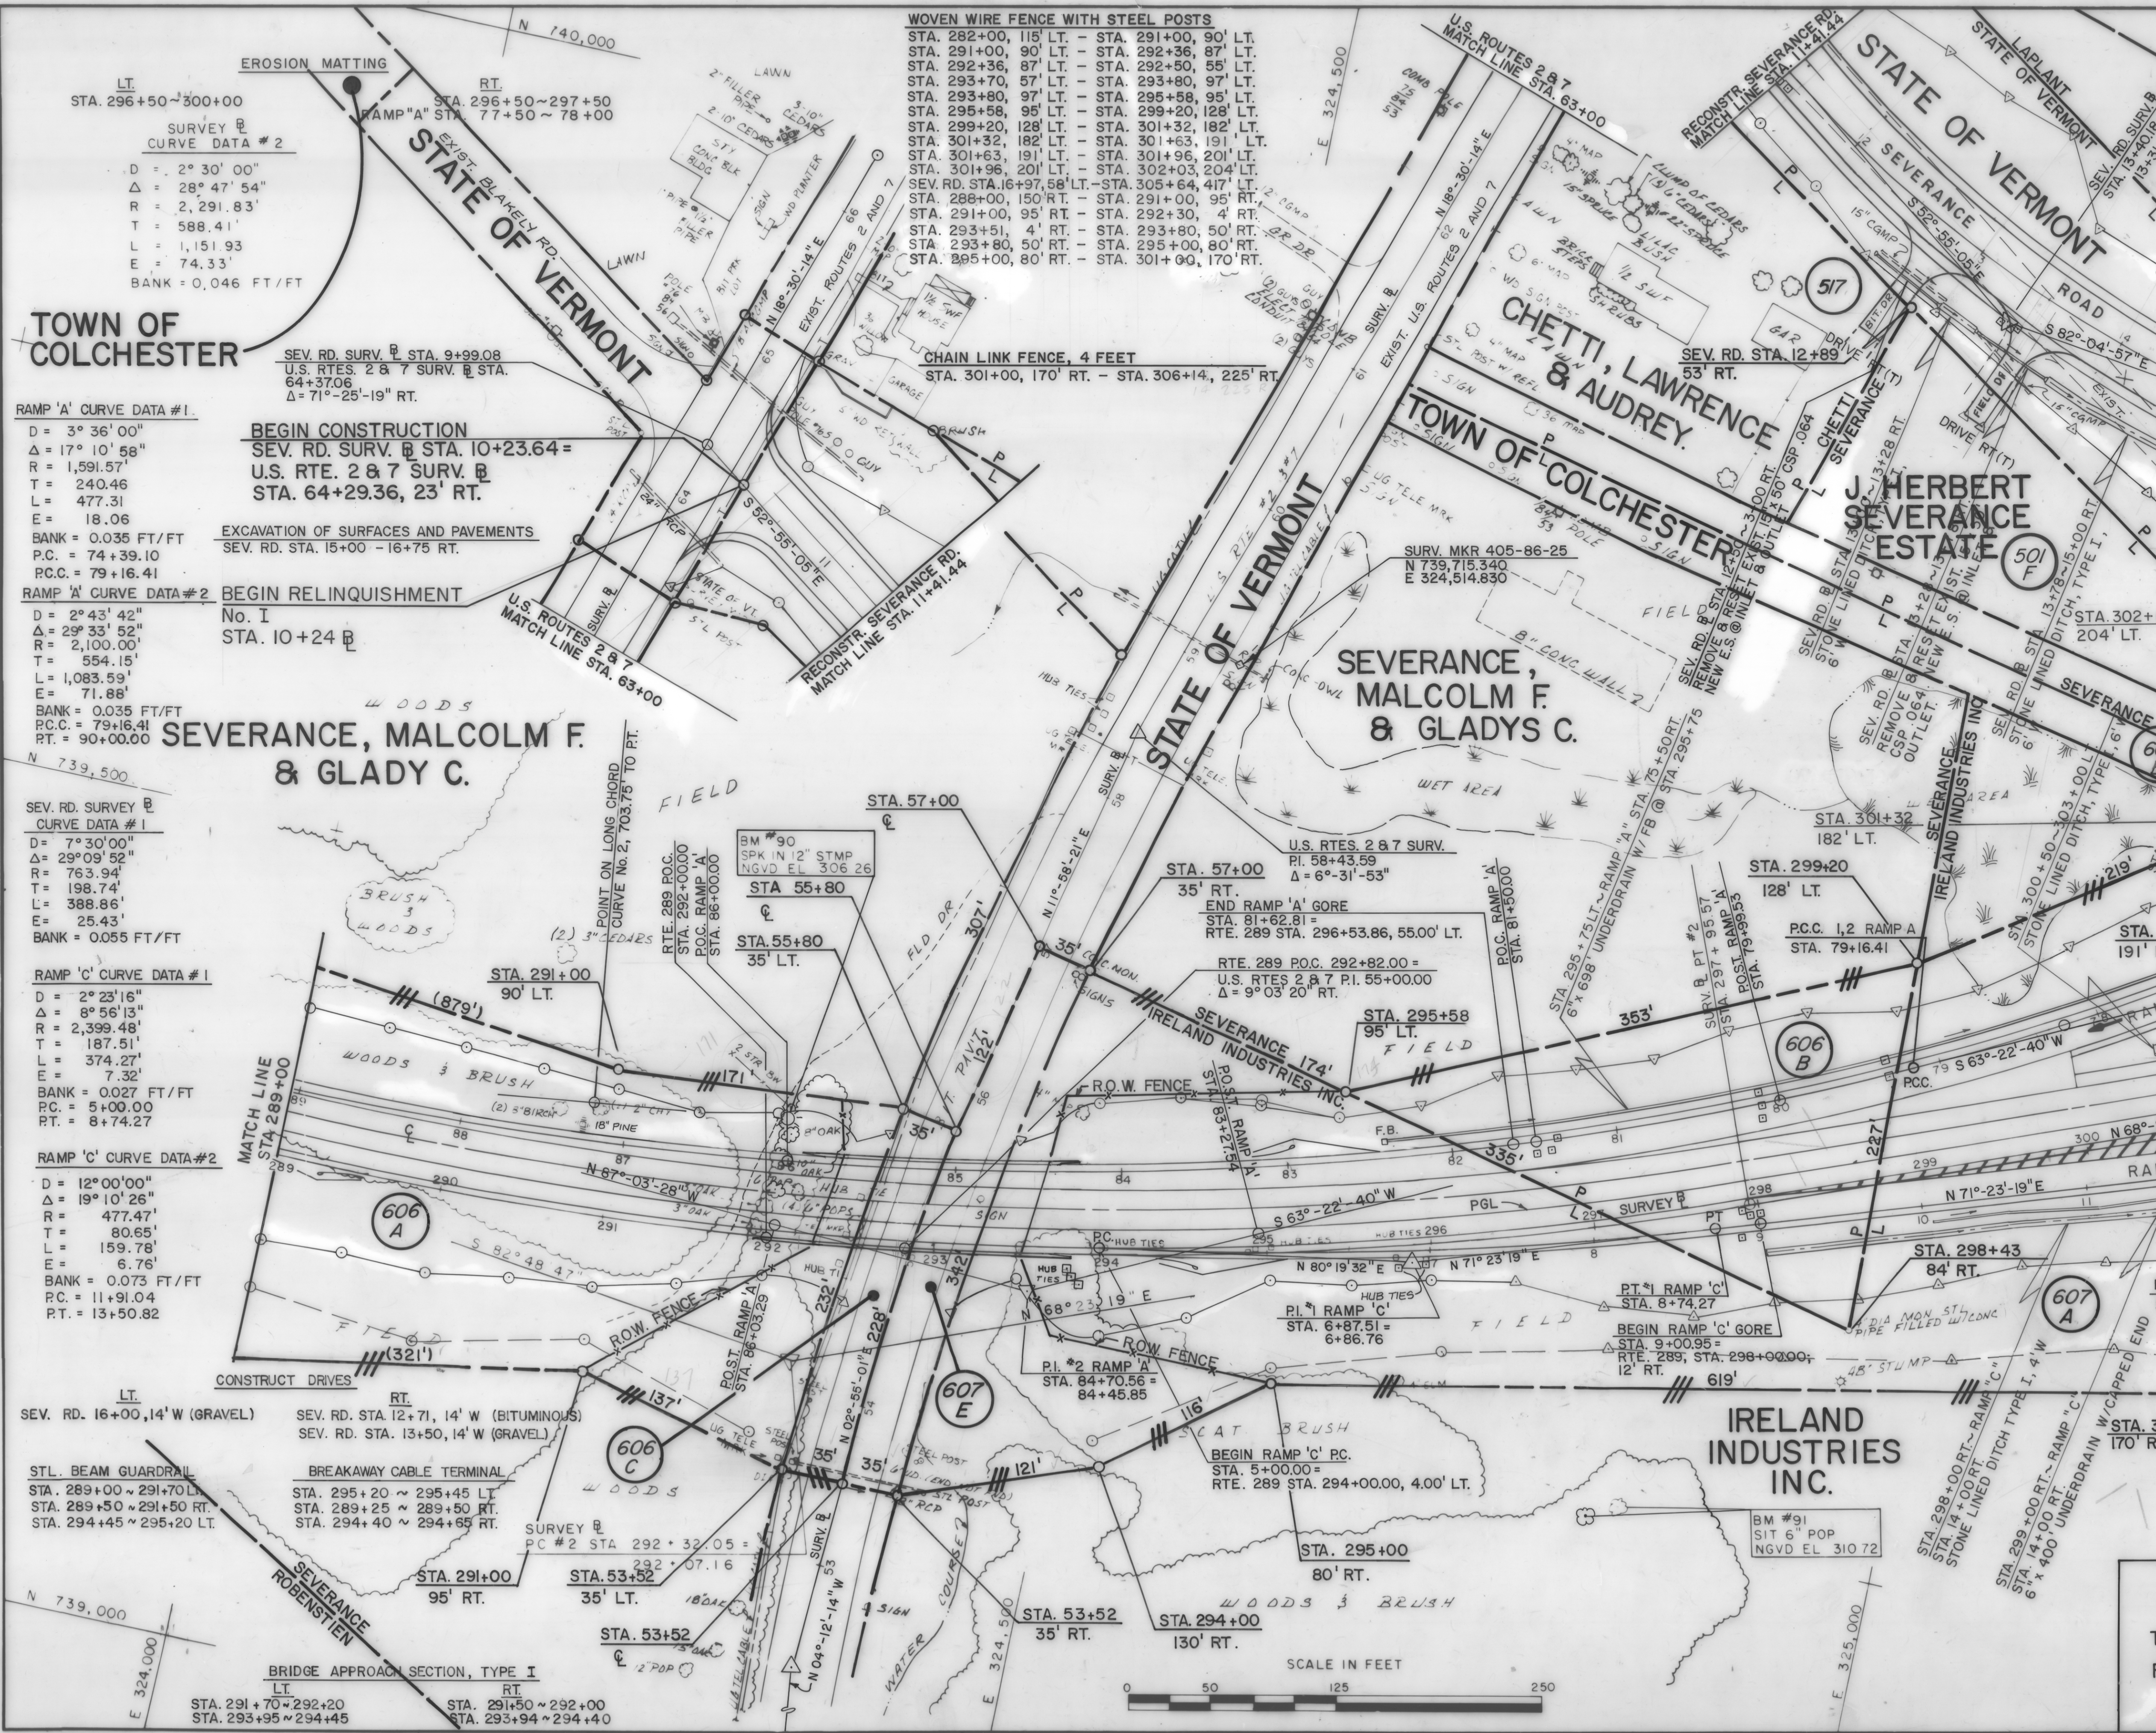

TOWN OF COLCHESTER

RAMP 'A' CURVE DATA #1  
D = 3° 36' 00"  
Δ = 17° 10' 58"  
R = 1,591.57'  
T = 240.46'  
L = 477.31'  
E = 18.06'  
BANK = 0.035 FT/FT  
P.C. = 74+39.10  
P.C.C. = 79+16.41

RAMP 'A' CURVE DATA #2  
D = 2° 43' 42"  
Δ = 29° 33' 52"  
R = 2,100.00'  
T = 554.15'  
L = 1,083.59'  
E = 71.88'  
BANK = 0.035 FT/FT  
P.C. = 79+16.41  
P.T. = 90+00.00

SEV. RD. SURVEY  
CURVE DATA #1  
D = 7° 30' 00"  
Δ = 29° 09' 52"  
R = 763.94'  
T = 198.74'  
L = 388.86'  
E = 25.43'  
BANK = 0.055 FT/FT

RAMP 'C' CURVE DATA #1  
D = 2° 23' 16"  
Δ = 8° 56' 13"  
R = 2,399.48'  
T = 187.51'  
L = 374.27'  
E = 7.32'  
BANK = 0.027 FT/FT  
P.C. = 5+00.00  
P.T. = 8+74.27

RAMP 'C' CURVE DATA #2  
D = 12° 00' 00"  
Δ = 19° 10' 26"  
R = 477.47'  
T = 80.65'  
L = 159.78'  
E = 6.76'  
BANK = 0.073 FT/FT  
P.C. = 11+91.04  
P.T. = 13+50.82

SEV. RD. STA. 12+71, 14' W (BITUMINOUS)  
SEV. RD. STA. 13+50, 14' W (GRAVEL)  
STL. BEAM GUARDRAIL  
STA. 289+00 ~ 291+70 LT.  
STA. 289+50 ~ 291+50 RT.  
STA. 294+45 ~ 295+20 LT.

BEGIN CONSTRUCTION  
SEV. RD. SURV. STA. 10+23.64 =  
U.S. RTE. 2 & 7 SURV. STA. 64+29.36, 23' RT.

EXCAVATION OF SURFACES AND PAVEMENTS  
SEV. RD. STA. 15+00 ~ 16+75 RT.

BEGIN RELINQUISHMENT  
No. 1  
STA. 10+24 B

SEVERANCE, MALCOLM F. & GLADY C.

BREAKAWAY CABLE TERMINAL  
STA. 295+20 ~ 295+45 LT.  
STA. 289+25 ~ 289+50 RT.  
STA. 294+40 ~ 294+65 RT.

BRIDGE APPROACH SECTION, TYPE I  
STA. 291+70 ~ 292+20  
STA. 293+95 ~ 294+45

WOVEN WIRE FENCE WITH STEEL POSTS  
STA. 282+00, 115' LT. - STA. 291+00, 90' LT.  
STA. 291+00, 90' LT. - STA. 292+36, 87' LT.  
STA. 292+36, 87' LT. - STA. 292+50, 55' LT.  
STA. 293+70, 57' LT. - STA. 293+80, 97' LT.  
STA. 293+80, 97' LT. - STA. 295+58, 95' LT.  
STA. 295+58, 95' LT. - STA. 299+20, 128' LT.  
STA. 299+20, 128' LT. - STA. 301+32, 182' LT.  
STA. 301+32, 182' LT. - STA. 301+63, 191' LT.  
STA. 301+63, 191' LT. - STA. 301+96, 201' LT.  
STA. 301+96, 201' LT. - STA. 302+03, 204' LT.  
SEV. RD. STA. 16+97, 58' LT. - STA. 305+64, 417' LT.  
STA. 288+00, 150' RT. - STA. 291+00, 95' RT.  
STA. 291+00, 95' RT. - STA. 292+30, 4' RT.  
STA. 293+51, 4' RT. - STA. 293+80, 50' RT.  
STA. 293+80, 50' RT. - STA. 295+00, 80' RT.  
STA. 295+00, 80' RT. - STA. 301+90, 170' RT.

CHAIN LINK FENCE, 4 FEET  
STA. 301+00, 170' RT. - STA. 306+14, 225' RT.

SEVERANCE, MALCOLM F. & GLADYS C.

IRELAND INDUSTRIES INC.

SCALE IN FEET  
0 50 125 250