


SHANGRAW,
HARRISON B.
& MARION S.



SHIRLAND, LARRY E.
& SUSAN H.

SCALE IN FEET

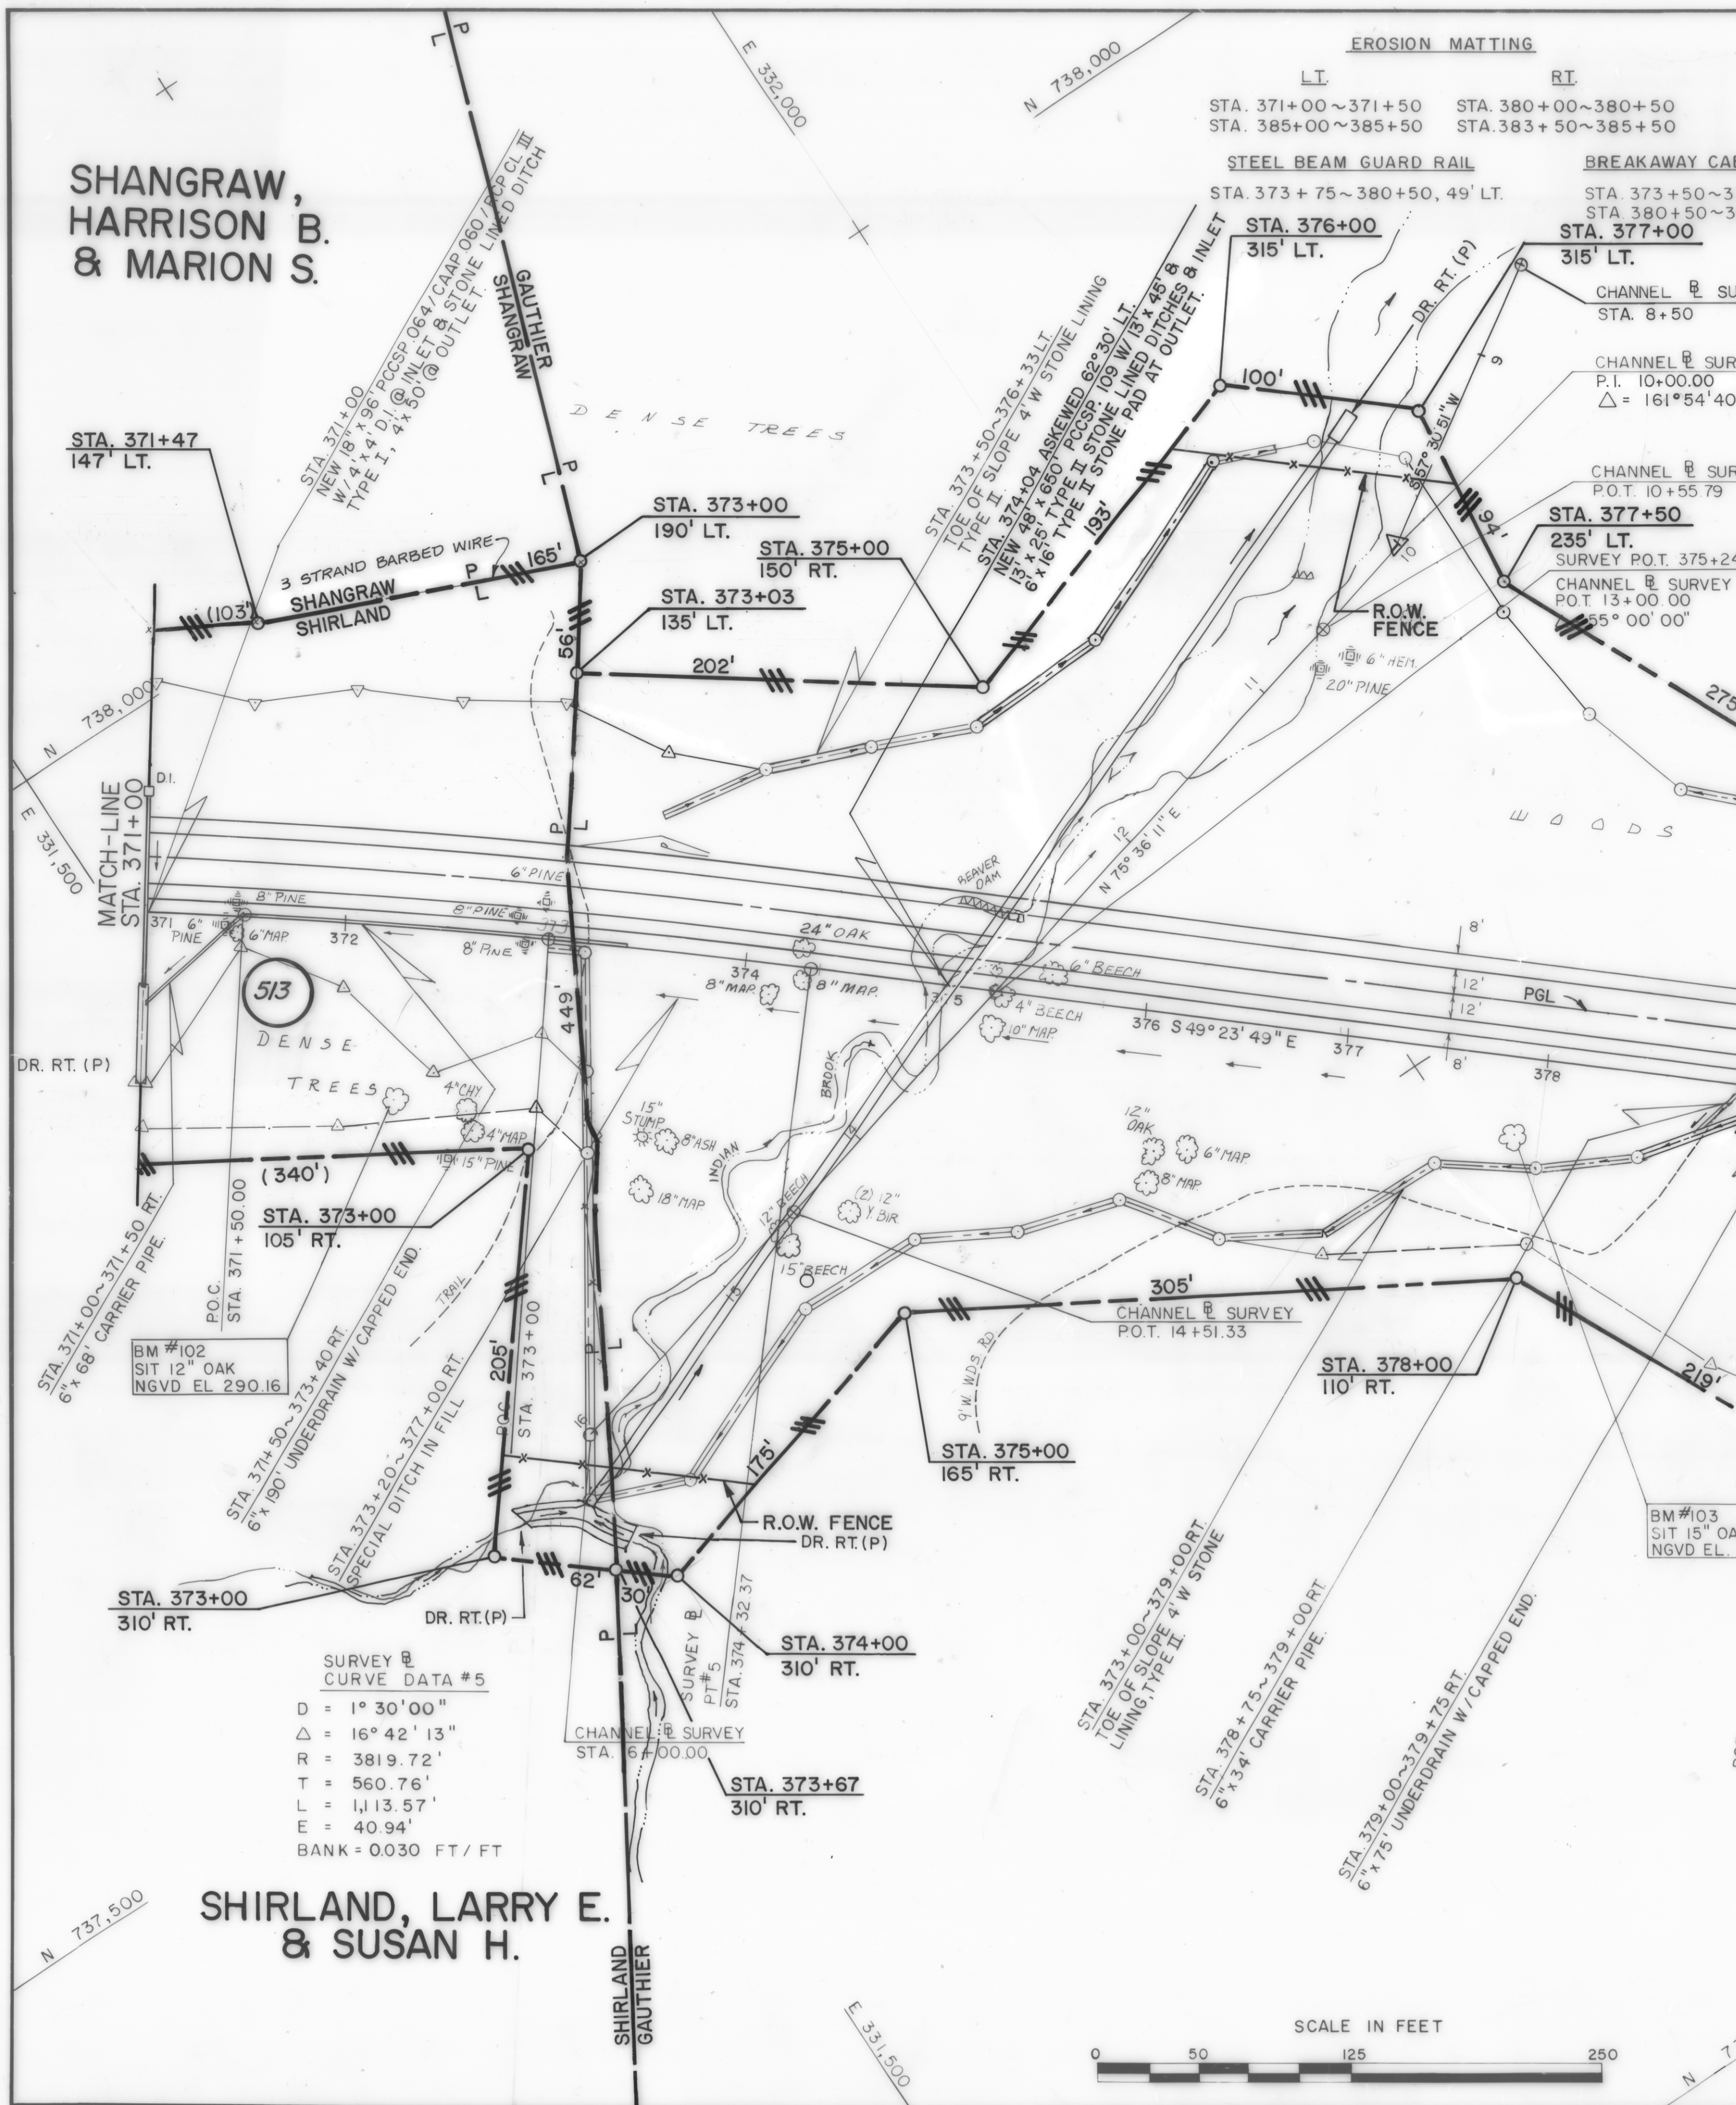