


|           |      |     |          |         |         |         |    |
|-----------|------|-----|----------|---------|---------|---------|----|
| PLAN      | DATE | BY  | SURVEYED | PLOTTED | ALIGNED | CHECKED | BY |
|           |      |     |          |         |         |         |    |
|           |      |     |          |         |         |         |    |
|           |      |     |          |         |         |         |    |
| NOTE BOOK |      | No. |          |         |         |         |    |

|           |      |     |          |         |                |                             |
|-----------|------|-----|----------|---------|----------------|-----------------------------|
| PROFILE   | DATE | BY  | SURVEYED | PLOTTED | GRADES CHECKED | STRUCTURE NOTATIONS CHECKED |
|           |      |     |          |         |                |                             |
|           |      |     |          |         |                |                             |
|           |      |     |          |         |                |                             |
| NOTE BOOK |      | No. |          |         |                |                             |

# R.O.W. PLAN

THIS SHEET TO BE USED  
FOR R.O.W. INFORMATION  
ONLY.

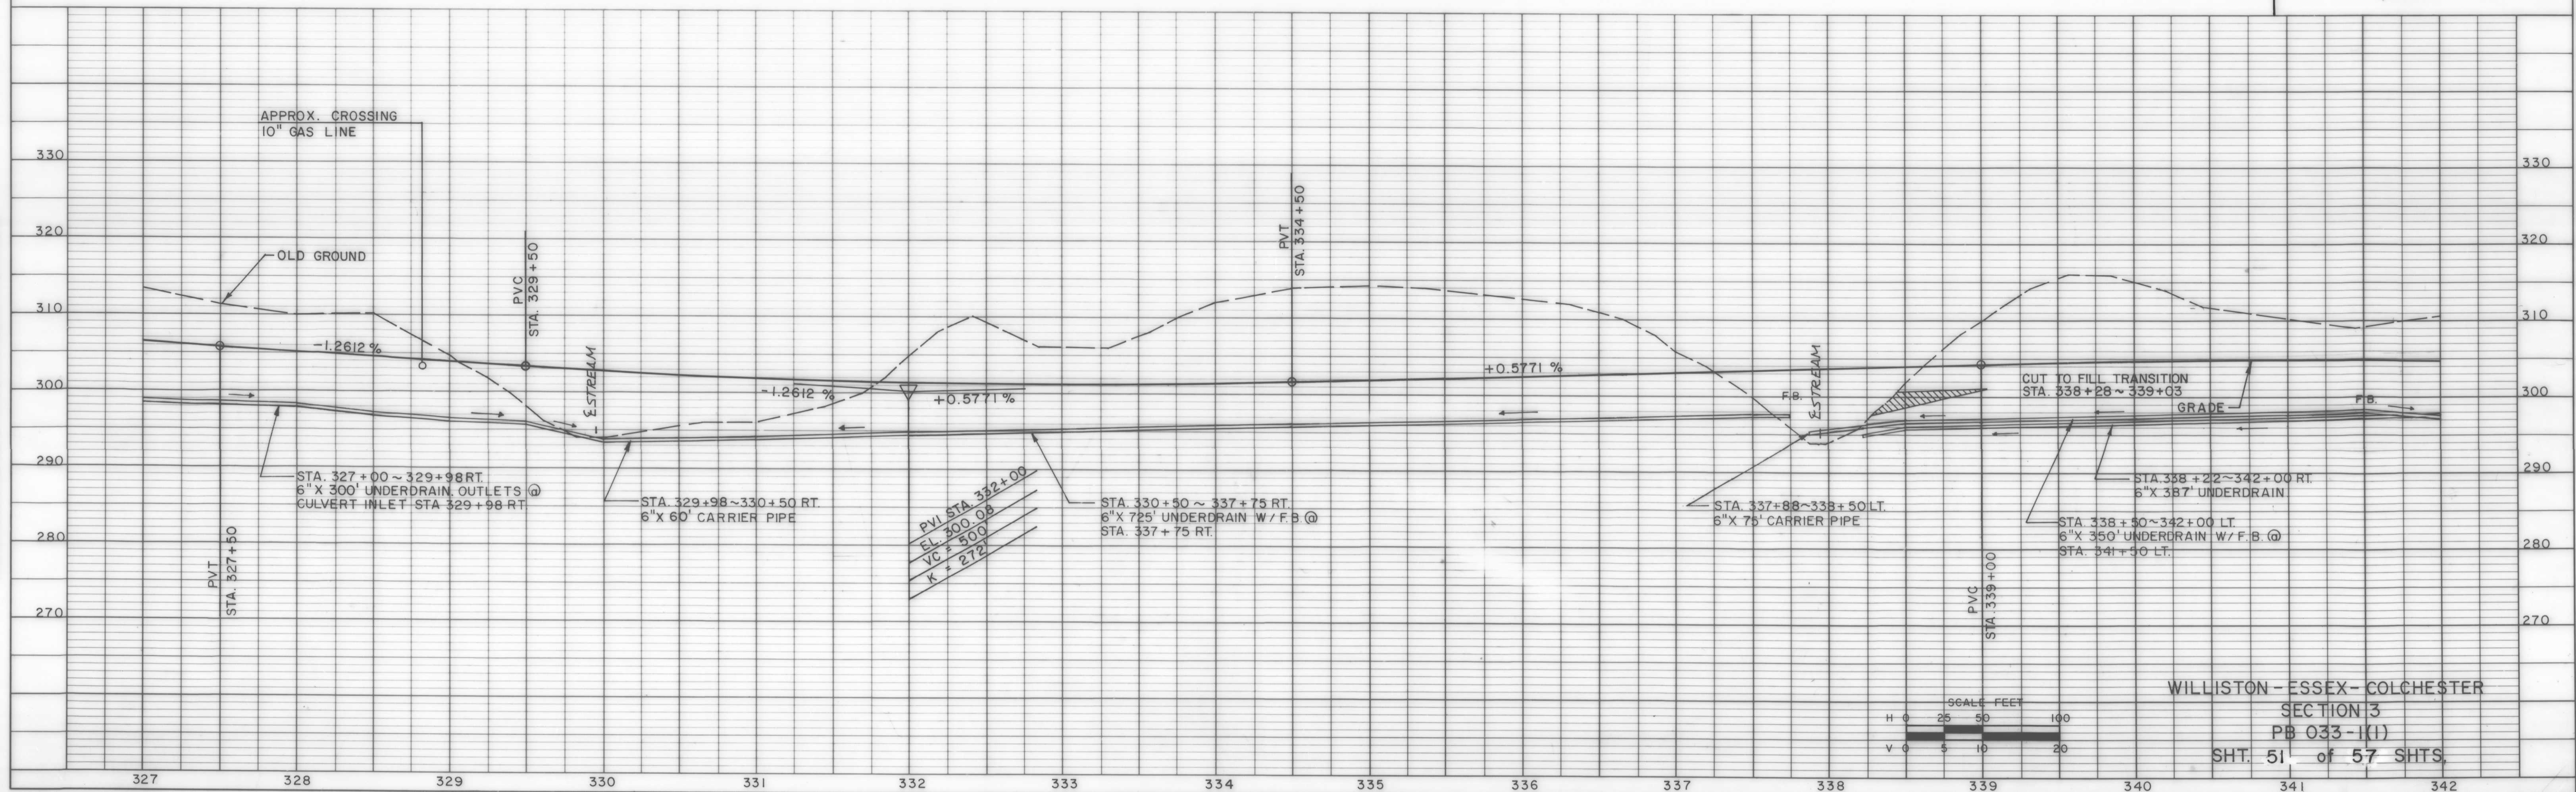

WILLISTON - ESSEX - COLCHESTER  
SECTION 3  
PB 033 - (11)  
SHT. 51 of 57 SHTS.