



TYPICAL SECTIONS - SUSIE B. WILSON
CHITTENDEN COUNTY CIRCUMFERENCE

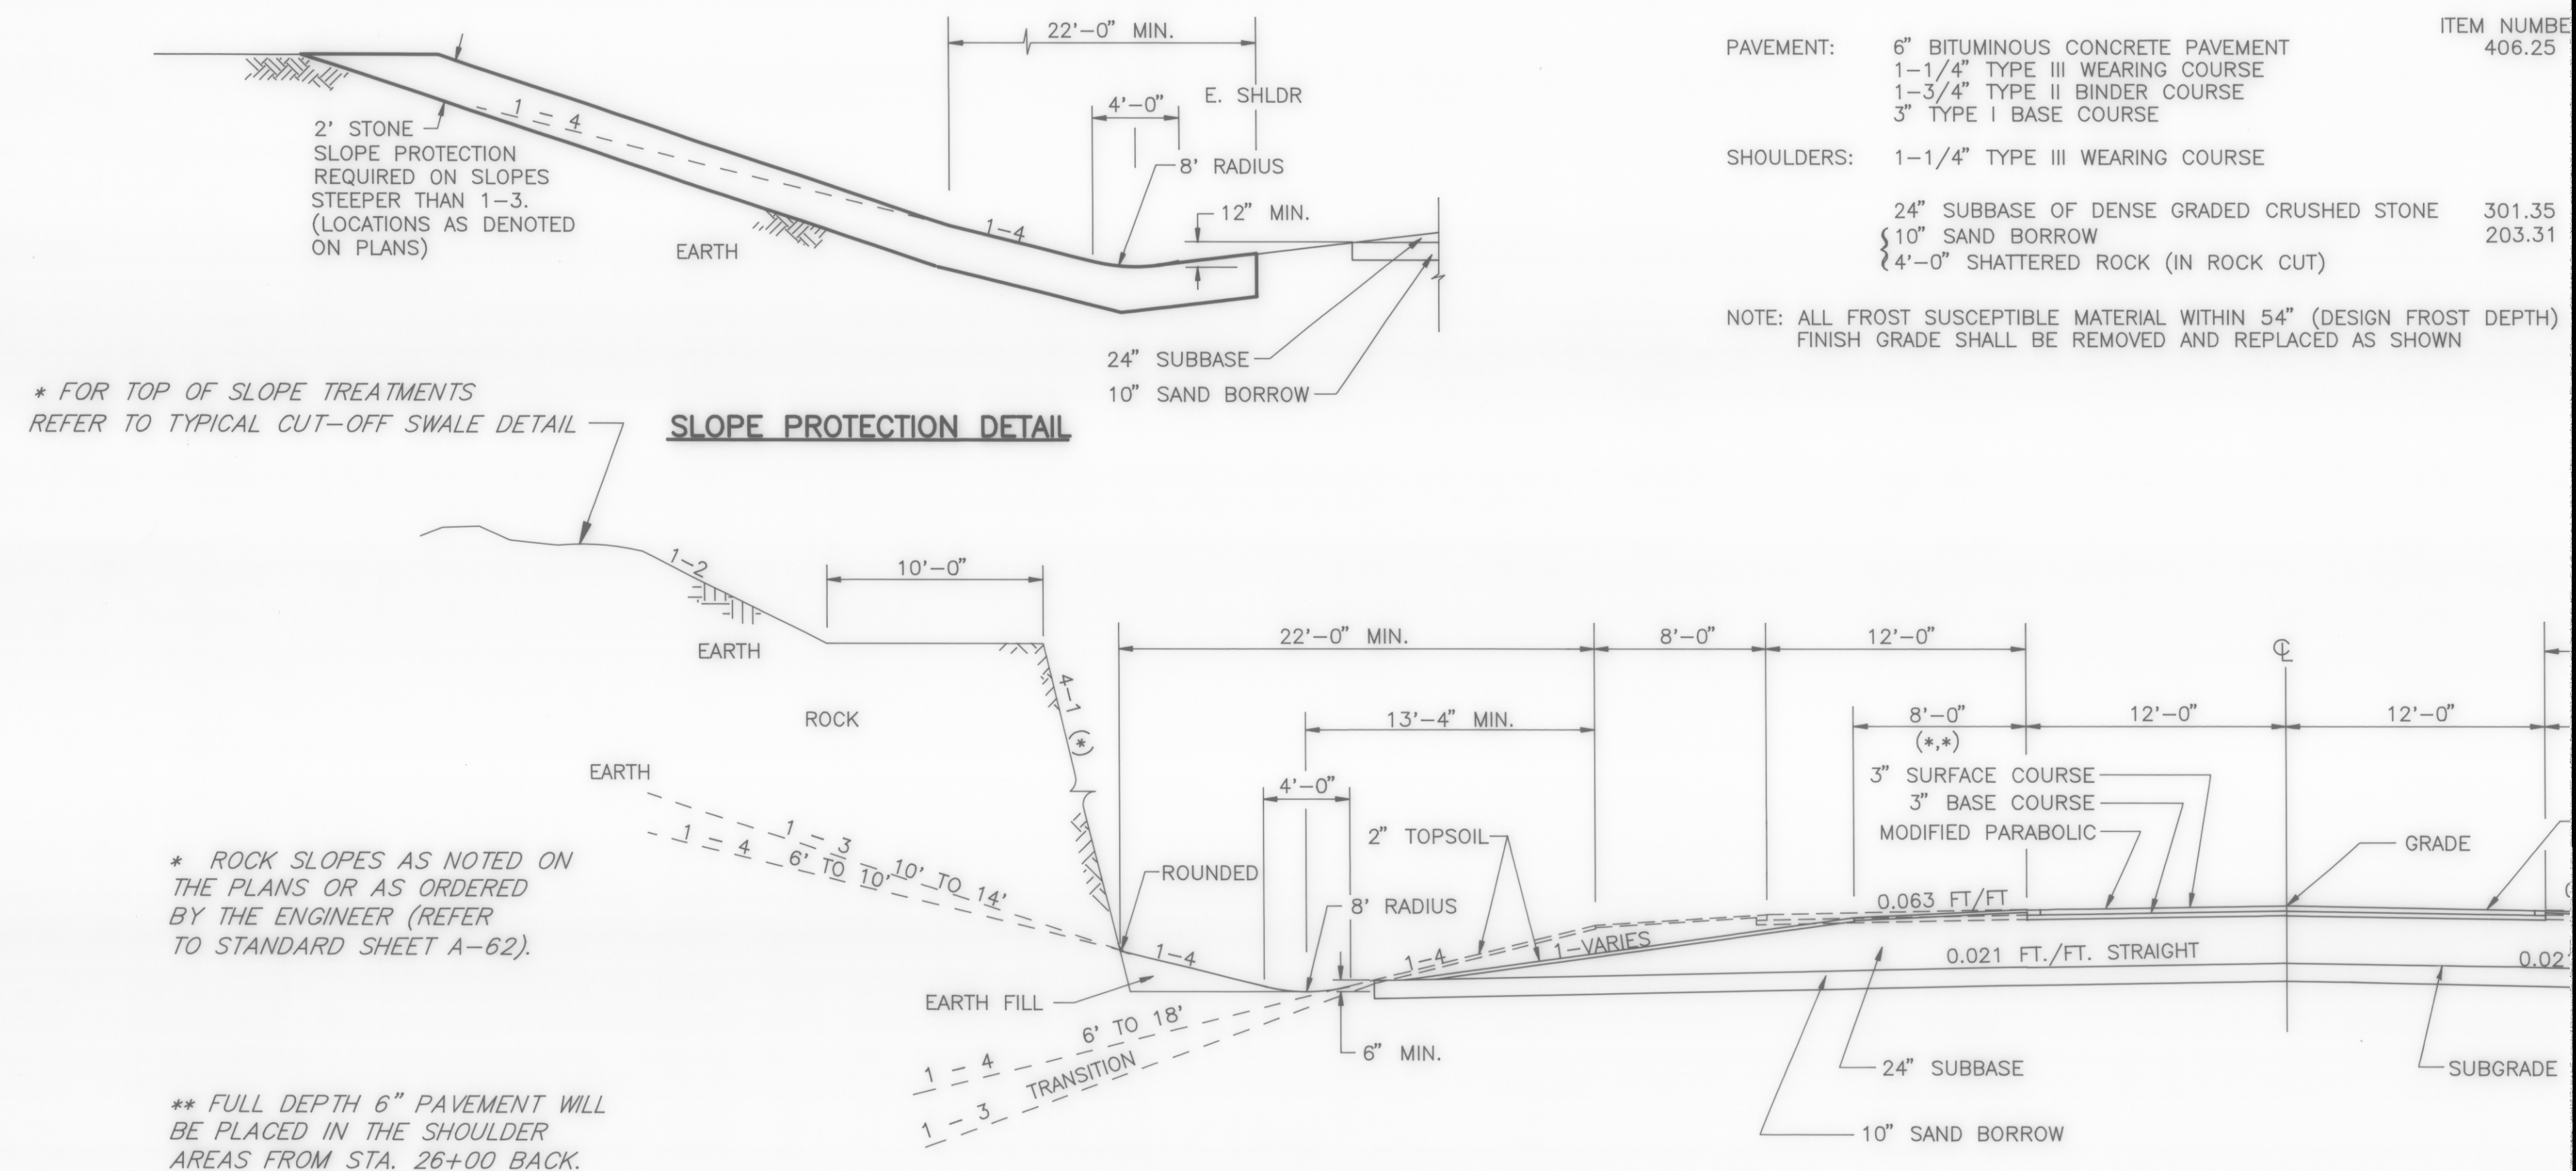

NORMAL SECTION

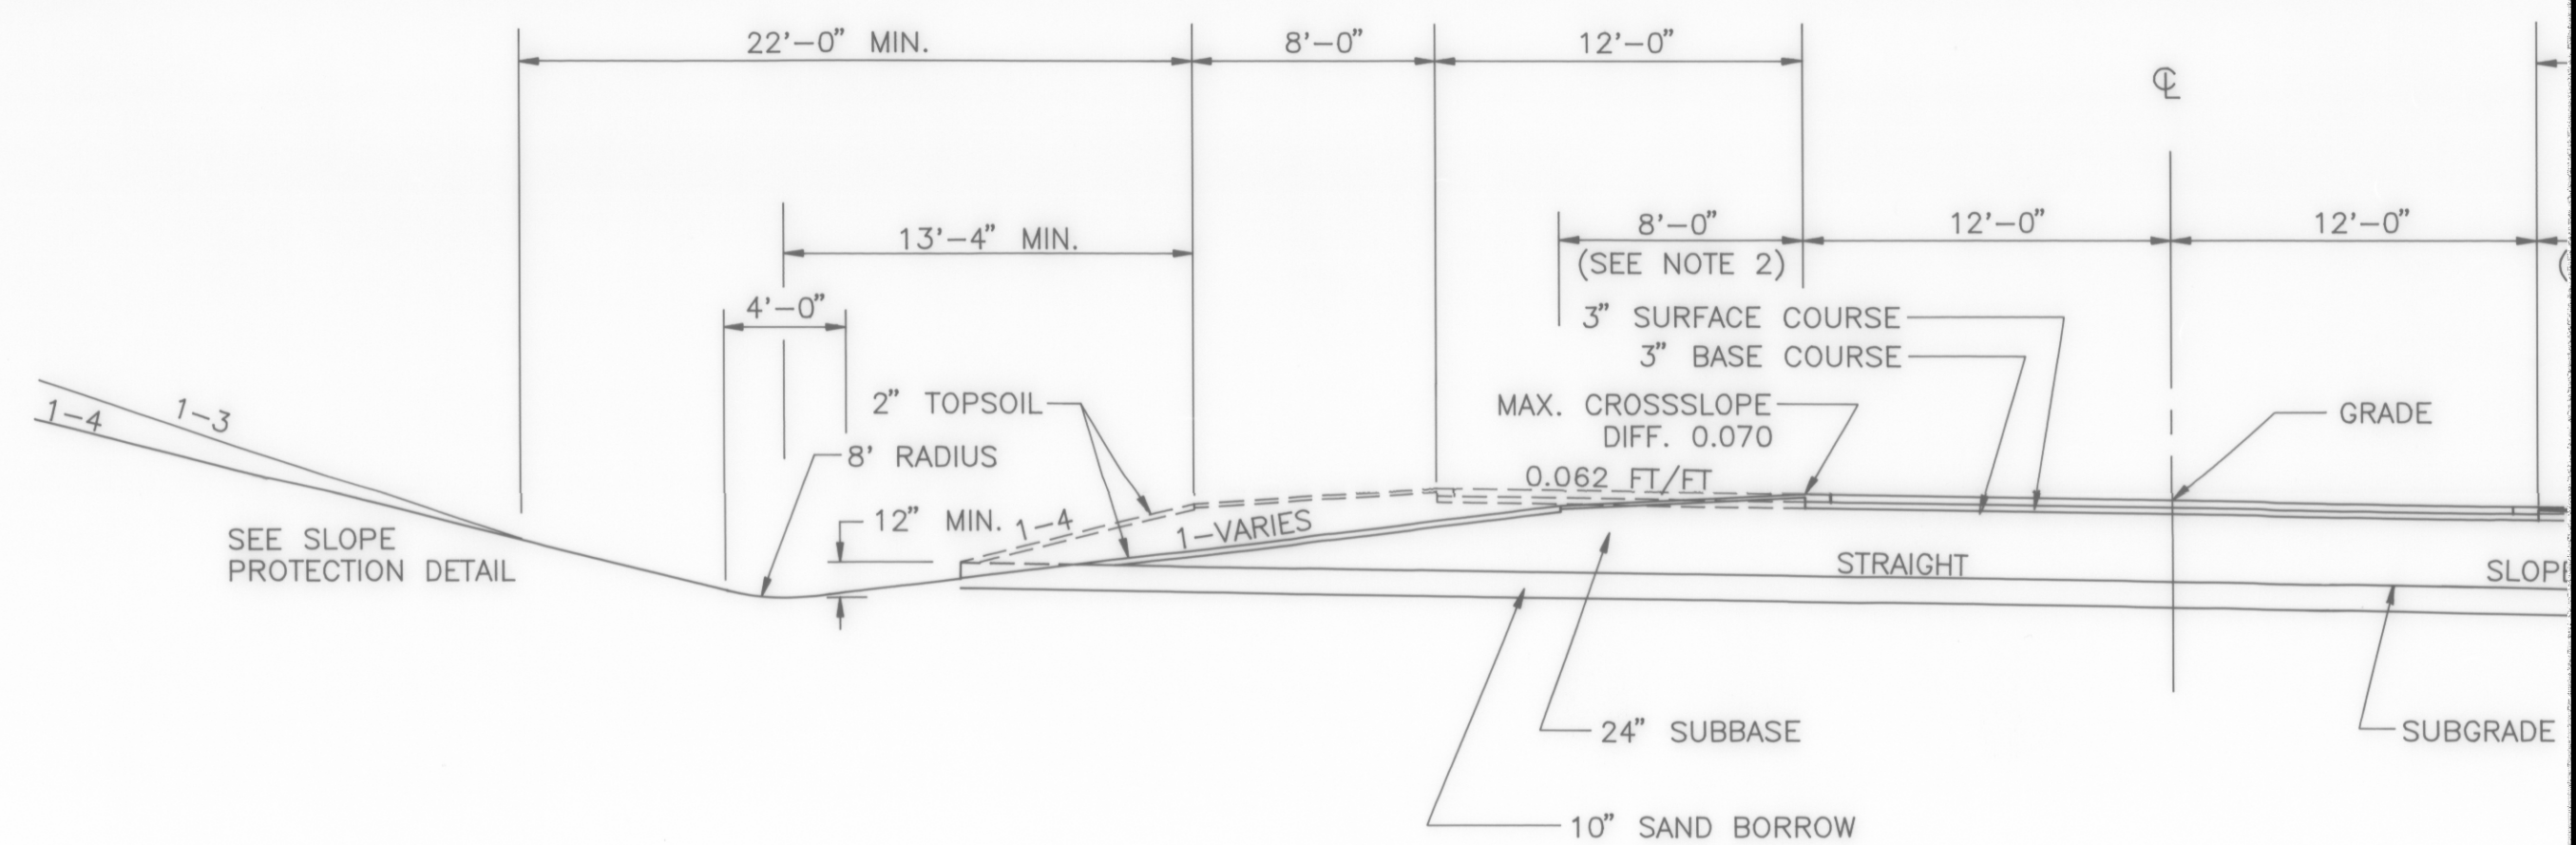

MAXIMUM BANKED RIGHT SECTION (BANKED LEFT OF

$$e=0.061 \text{ FT./FT.}$$

DATUM	
VERTICAL	N.G.V.D. 1929
HORIZONTAL	N.A.D. 1927

NOTES: 1.) ENHANCED EMBANKMENT TO BE USED WHERE GUARDRAIL
2.) CONSTRUCT FULL DEPTH ASPHALT SHOULDER THROUGH S