


CURVE DATA #1

Δ = 23°-23'-45" RT.
Dc = 01°-00'-00"
R = 5729.58'
T = 1186.32'
E = 121.53'
L = 2339.58'
BANK = 0.021 FT./FT.

LECLERK, ARMOND A. & LINDA L.

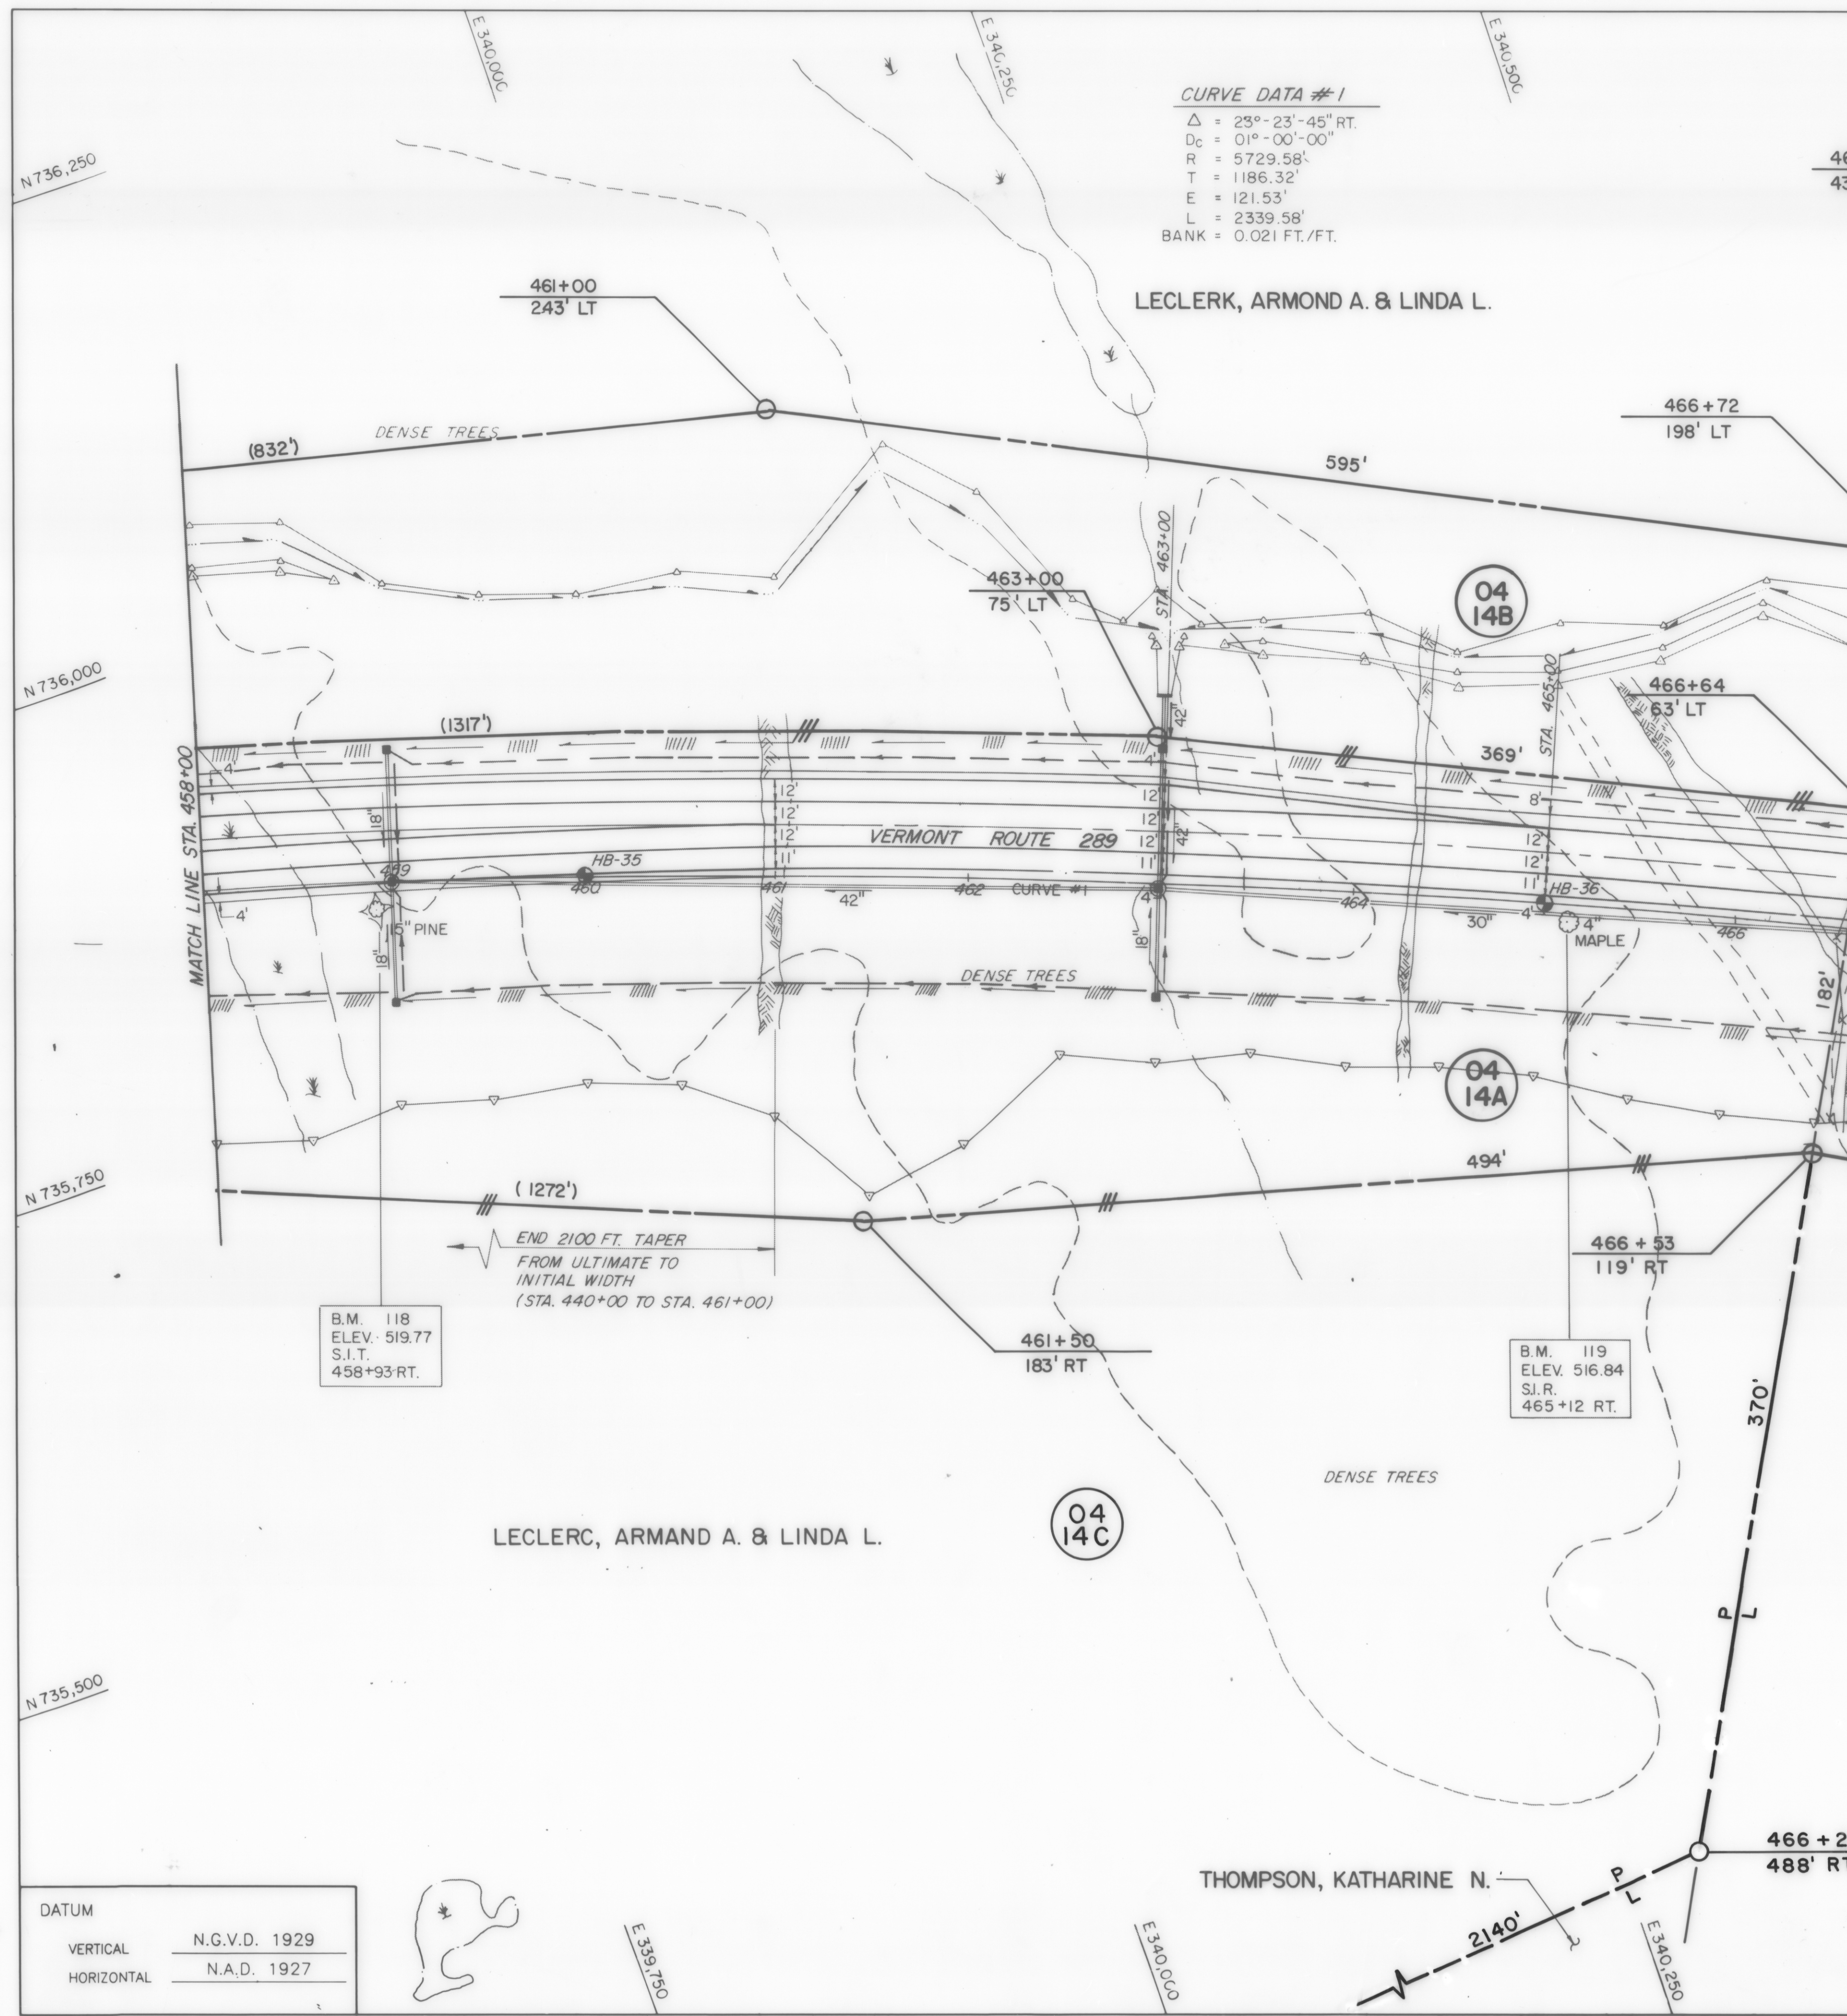

DATUM

VERTICAL N.G.V.D. 1929
HORIZONTAL N.A.D. 1927