


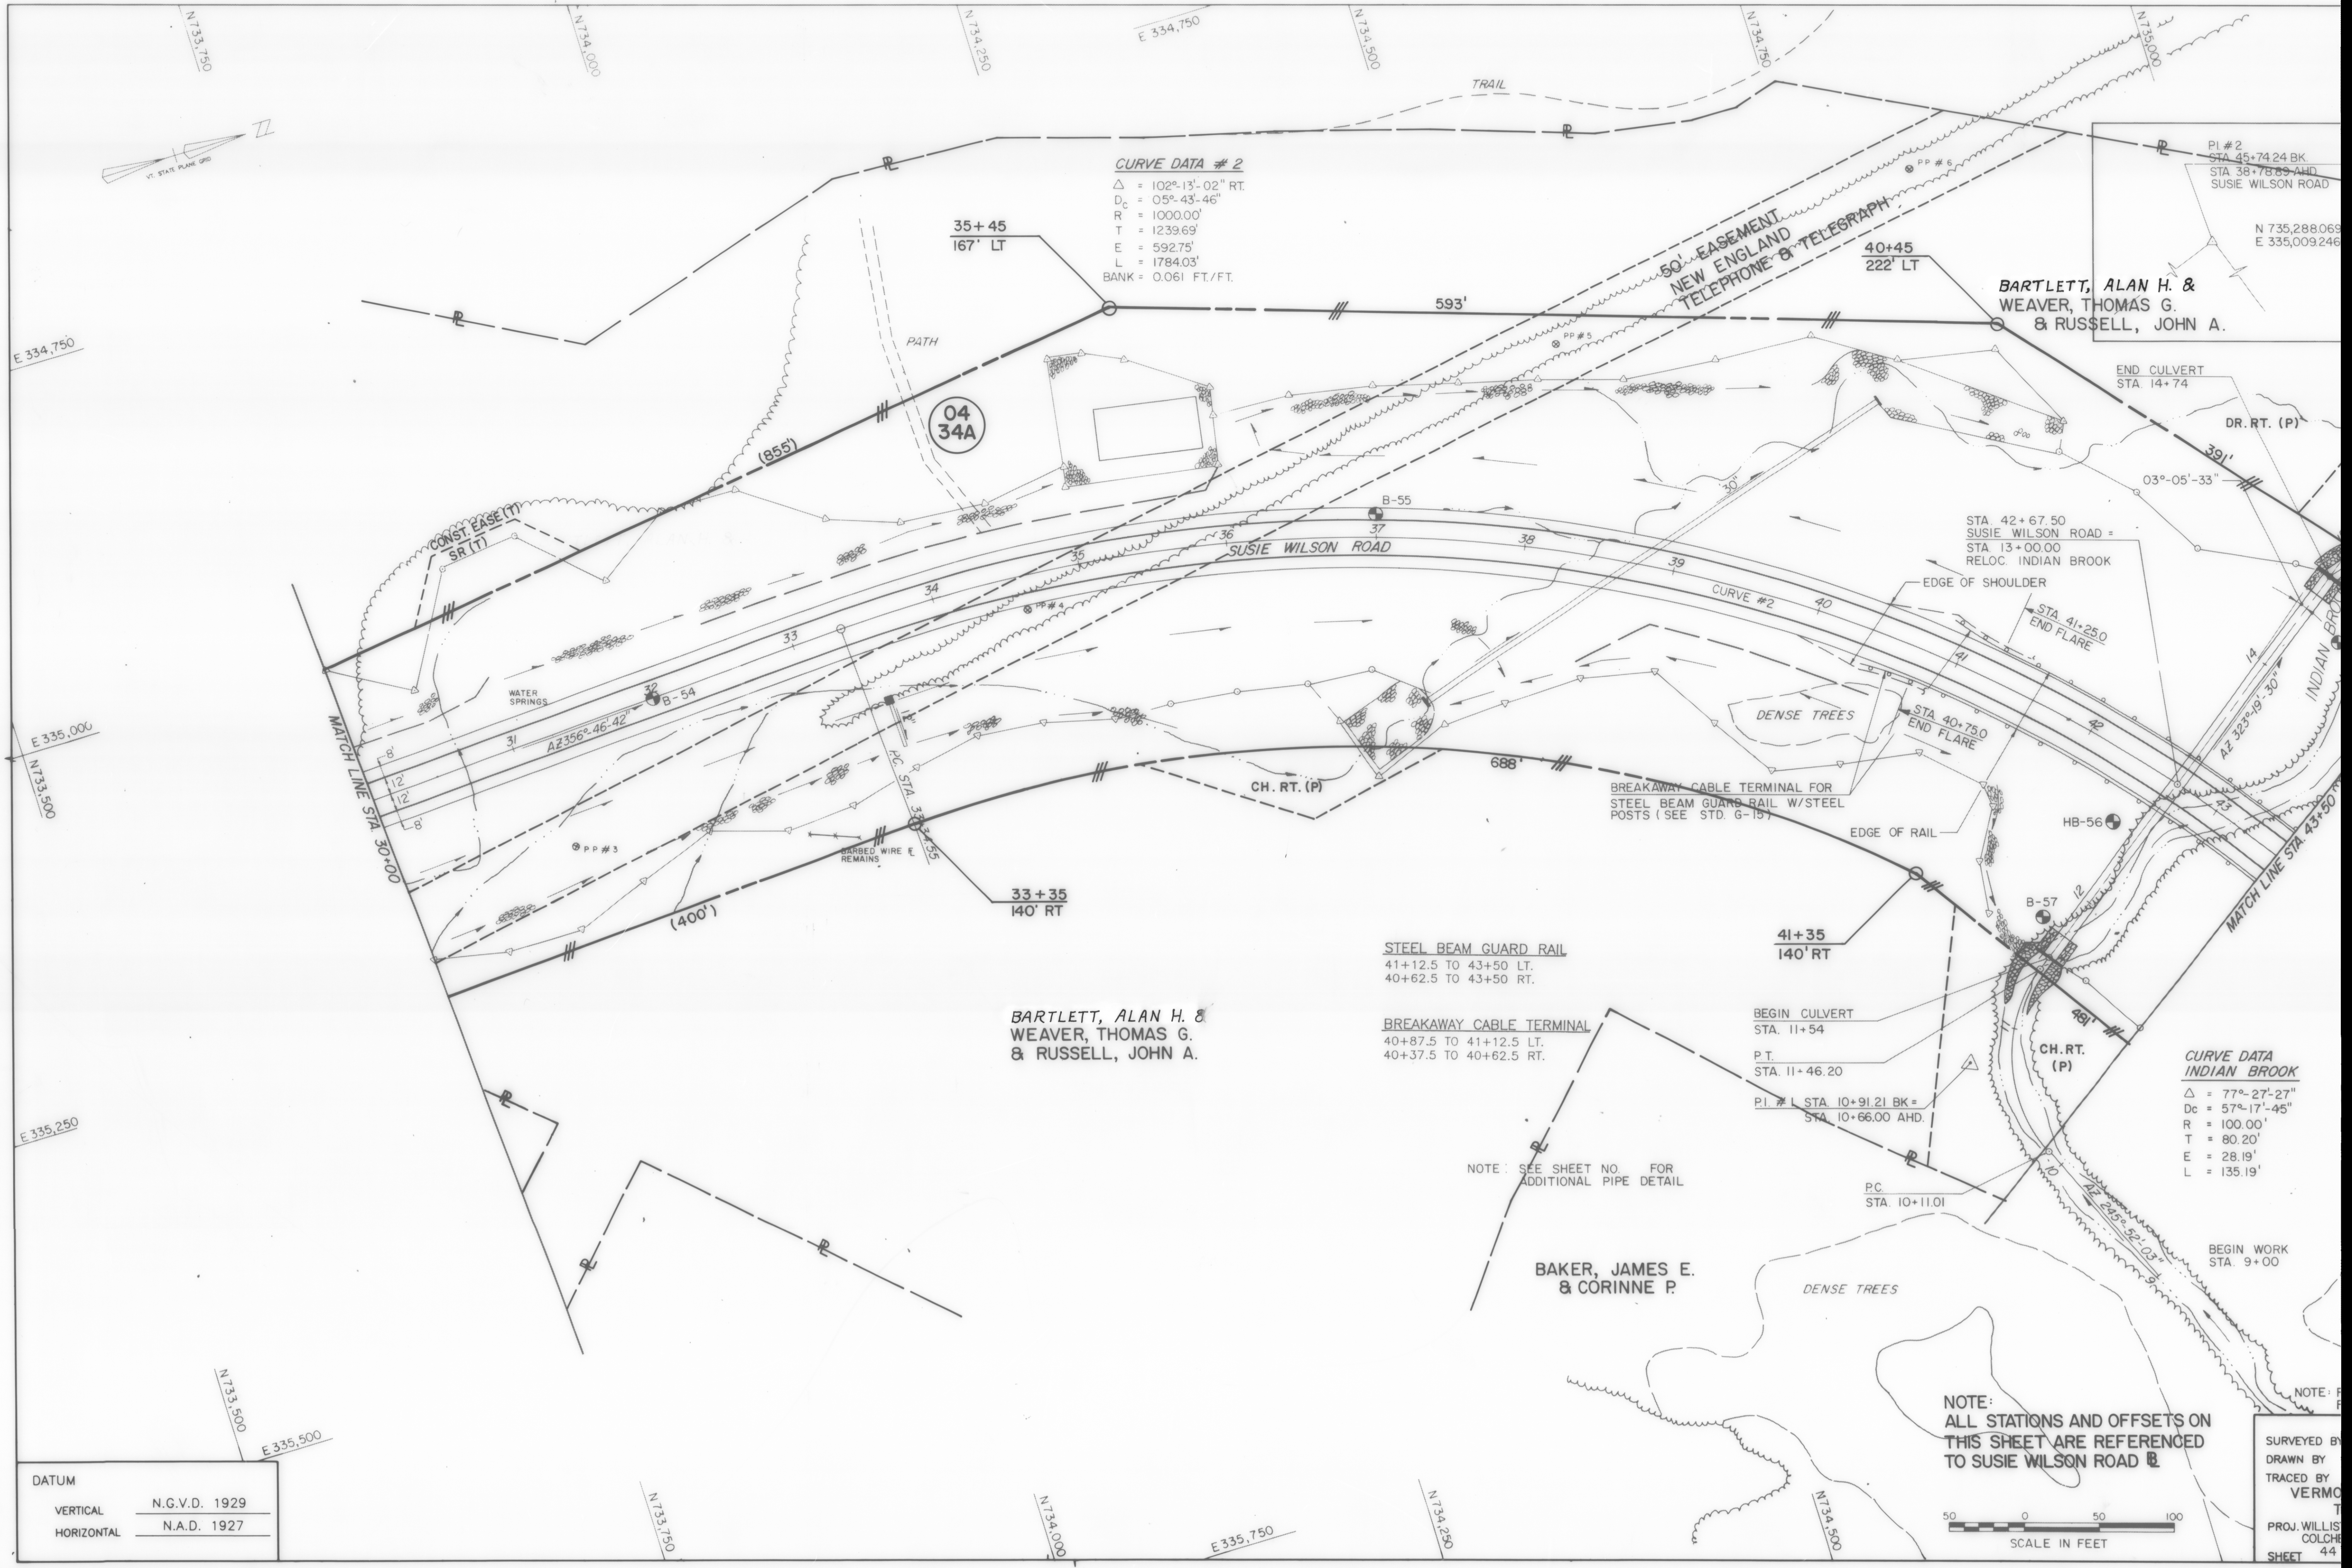


**CURVE DATA #2**  
 $\Delta = 102^\circ 13' 02''$  RT.  
 $D_c = 05^\circ 43' 46''$   
 $R = 1000.00'$   
 $T = 1239.69'$   
 $E = 592.75'$   
 $L = 1784.03'$   
BANK = 0.061 FT./FT.

**CURVE DATA INDIAN BROOK**  
 $\Delta = 77^\circ 27' 27''$   
 $D_c = 57^\circ 17' 45''$   
 $R = 100.00'$   
 $T = 80.20'$   
 $E = 28.19'$   
 $L = 135.19'$

BARTLETT, ALAN H. &  
WEAVER, THOMAS G.  
& RUSSELL, JOHN A.

BAKER, JAMES E.  
& CORINNE P.

NOTE:  
ALL STATIONS AND OFFSETS ON  
THIS SHEET ARE REFERENCED  
TO SUSIE WILSON ROAD

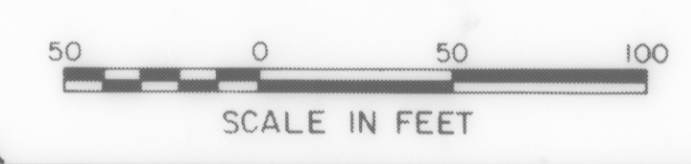

|            |               |
|------------|---------------|
| DATUM      |               |
| VERTICAL   | N.G.V.D. 1929 |
| HORIZONTAL | N.A.D. 1927   |

SURVEYED BY  
DRAWN BY  
TRACED BY  
VERMONT  
T  
PROJ. WILLIS  
COLCHIE  
SHEET 44