


PLAN	
NO.	DATE
SURVEYED BY	
PLOTTED BY	
NOTE BOOK NO.	
ALIGNMENT CHECKED	
BY	
DATE	

PROFILE	
NO.	DATE
SURVEYED BY	
PLOTTED BY	
NOTE BOOK NO.	
GRADES CHECKED	
BY	
DATE	
STRUCTURE NOTATIONS CH/KQ	

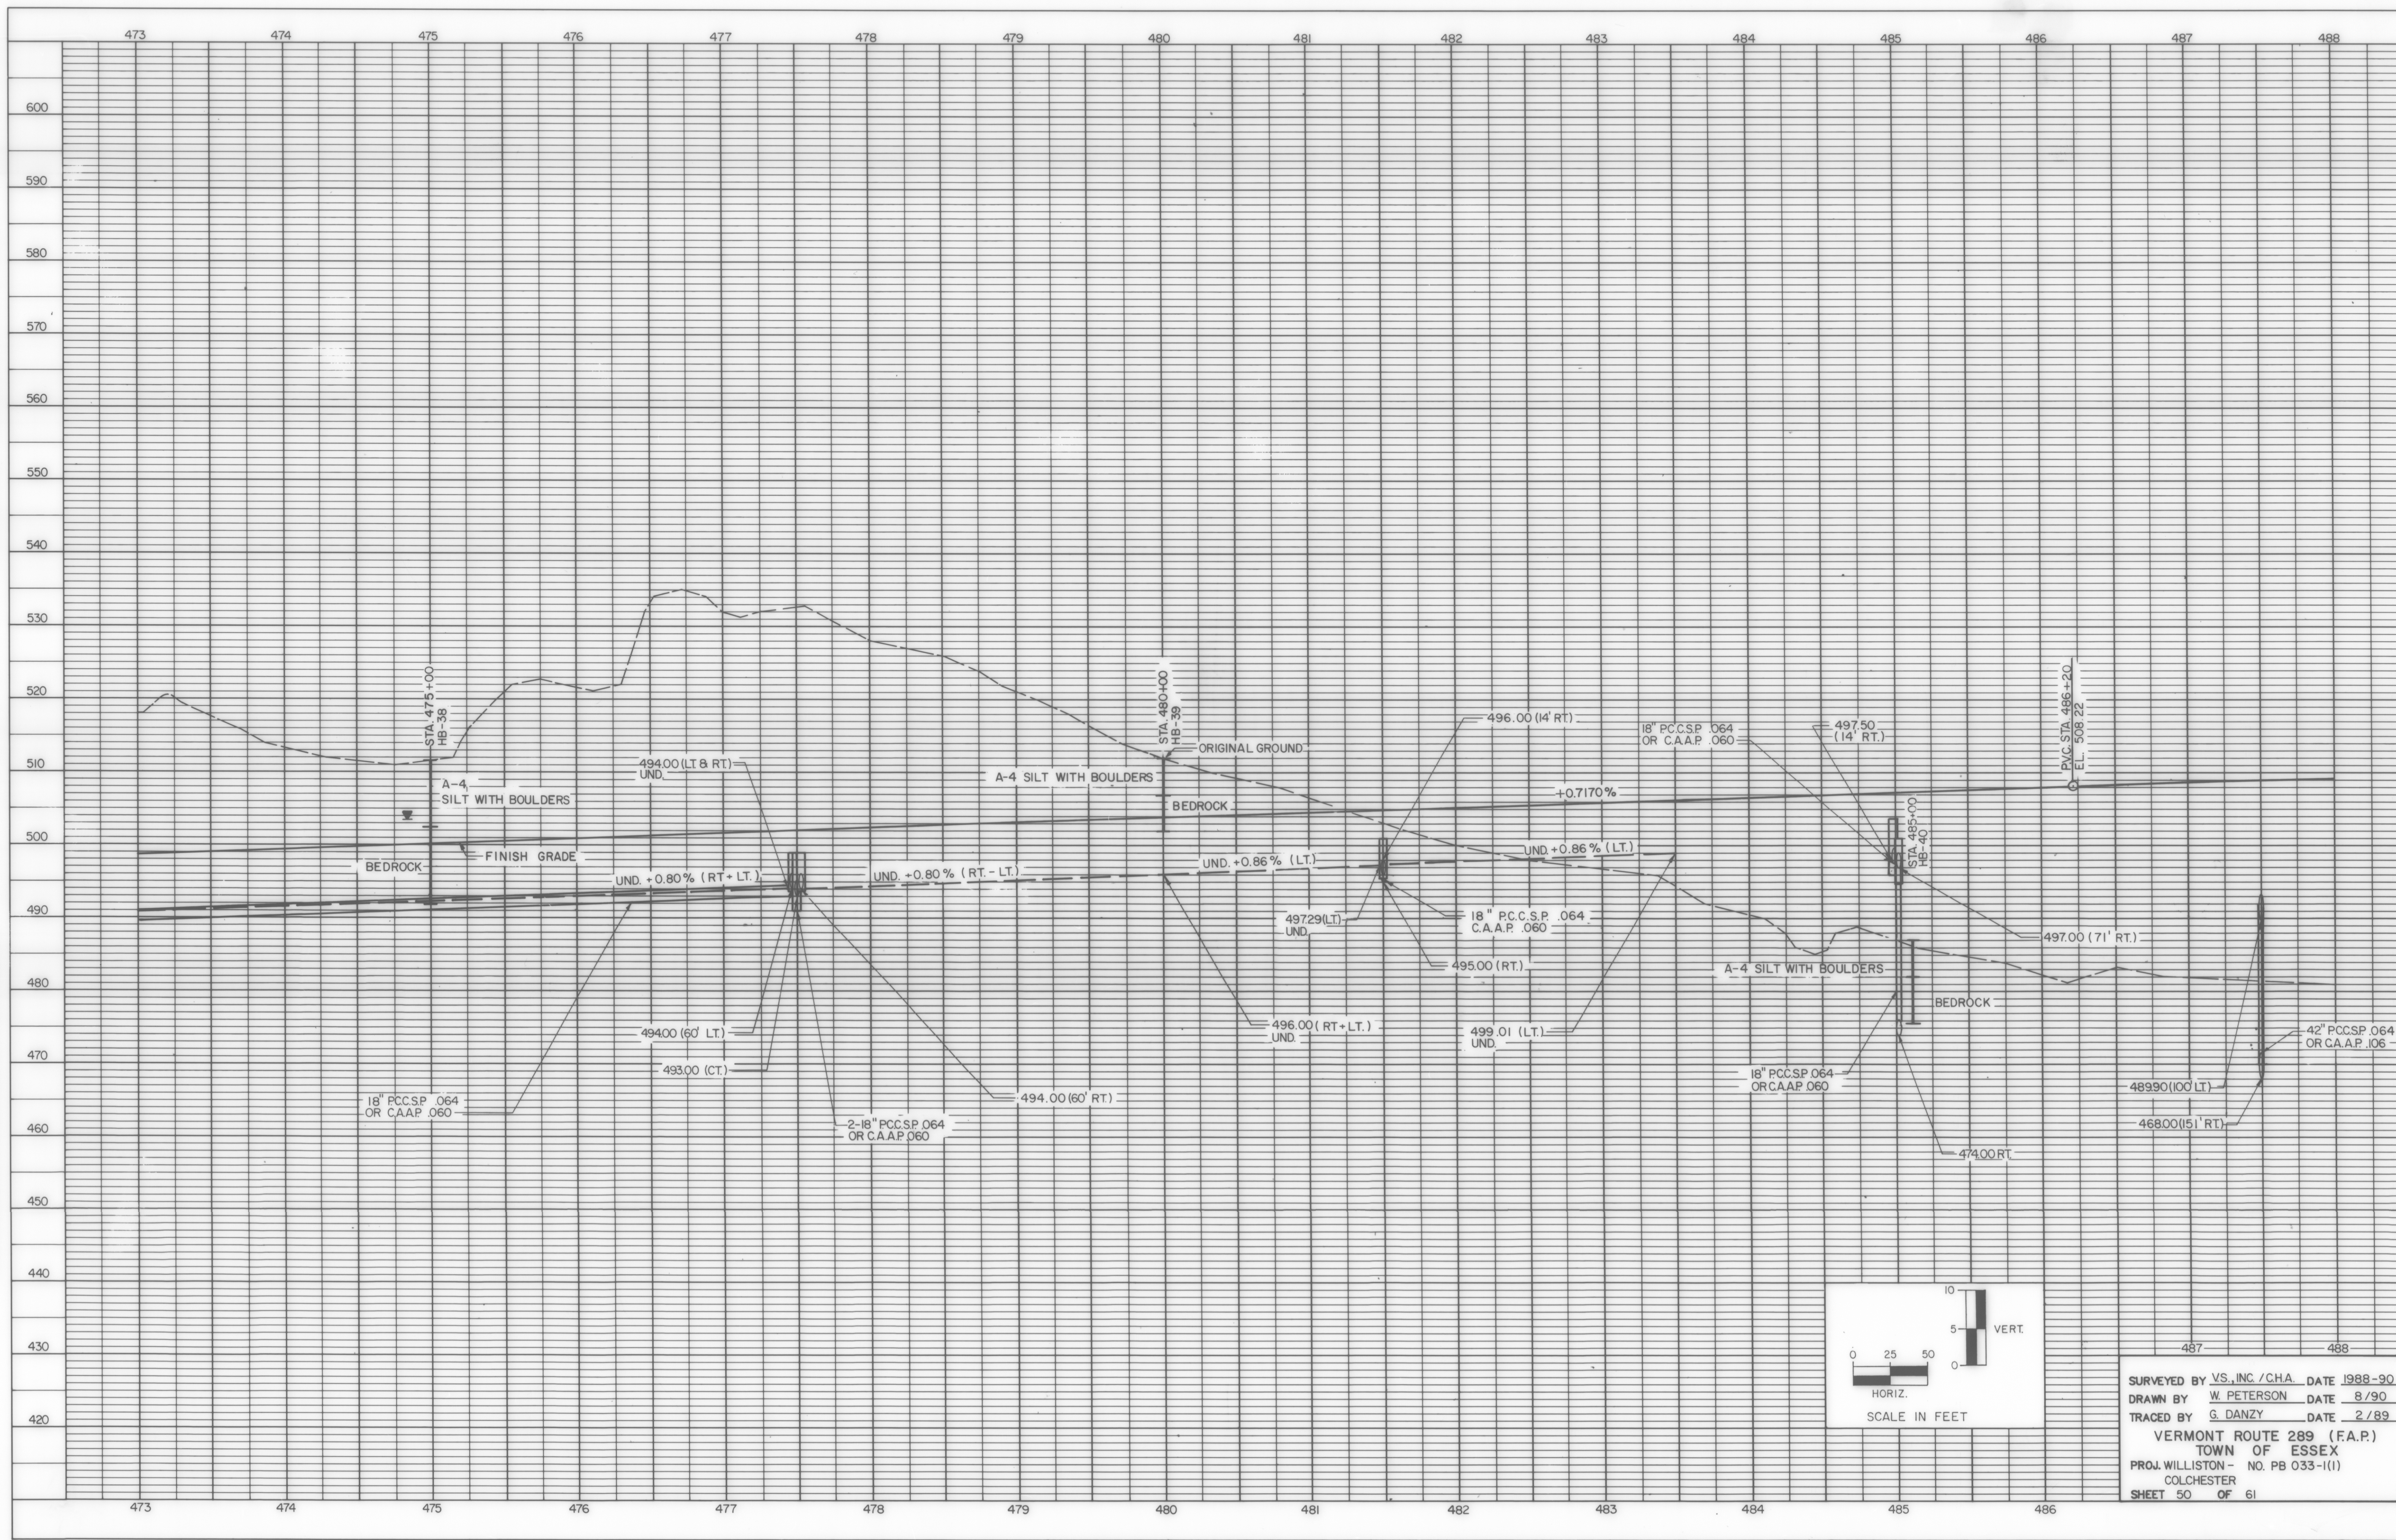

SURVEYED BY VS, INC./CHA. DATE 1988-90
 DRAWN BY W. PETERSON DATE 8/90
 TRACED BY G. DANZY DATE 2/89
 VERMONT ROUTE 289 (F.A.P.)
 TOWN OF ESSEX
 PROJ. WILLISTON - NO. PB 033-1(1)
 COLCHESTER
 SHEET 50 OF 61