
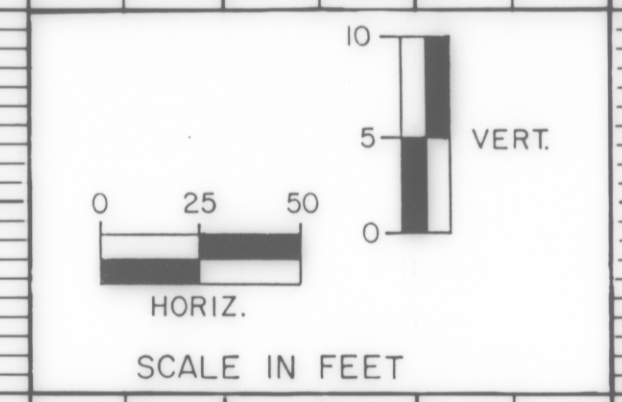


PLAN	SURVEYED	DATE
	ALIGNED	
	CHECKED	
	RT. OF WAY CHECKED	
NO. _____		

PROFILE	SURVEYED	DATE
	PLOTTED	
	CHECKED	
	STRUCTURE NOTATIONS CH'KD	
NO. _____		

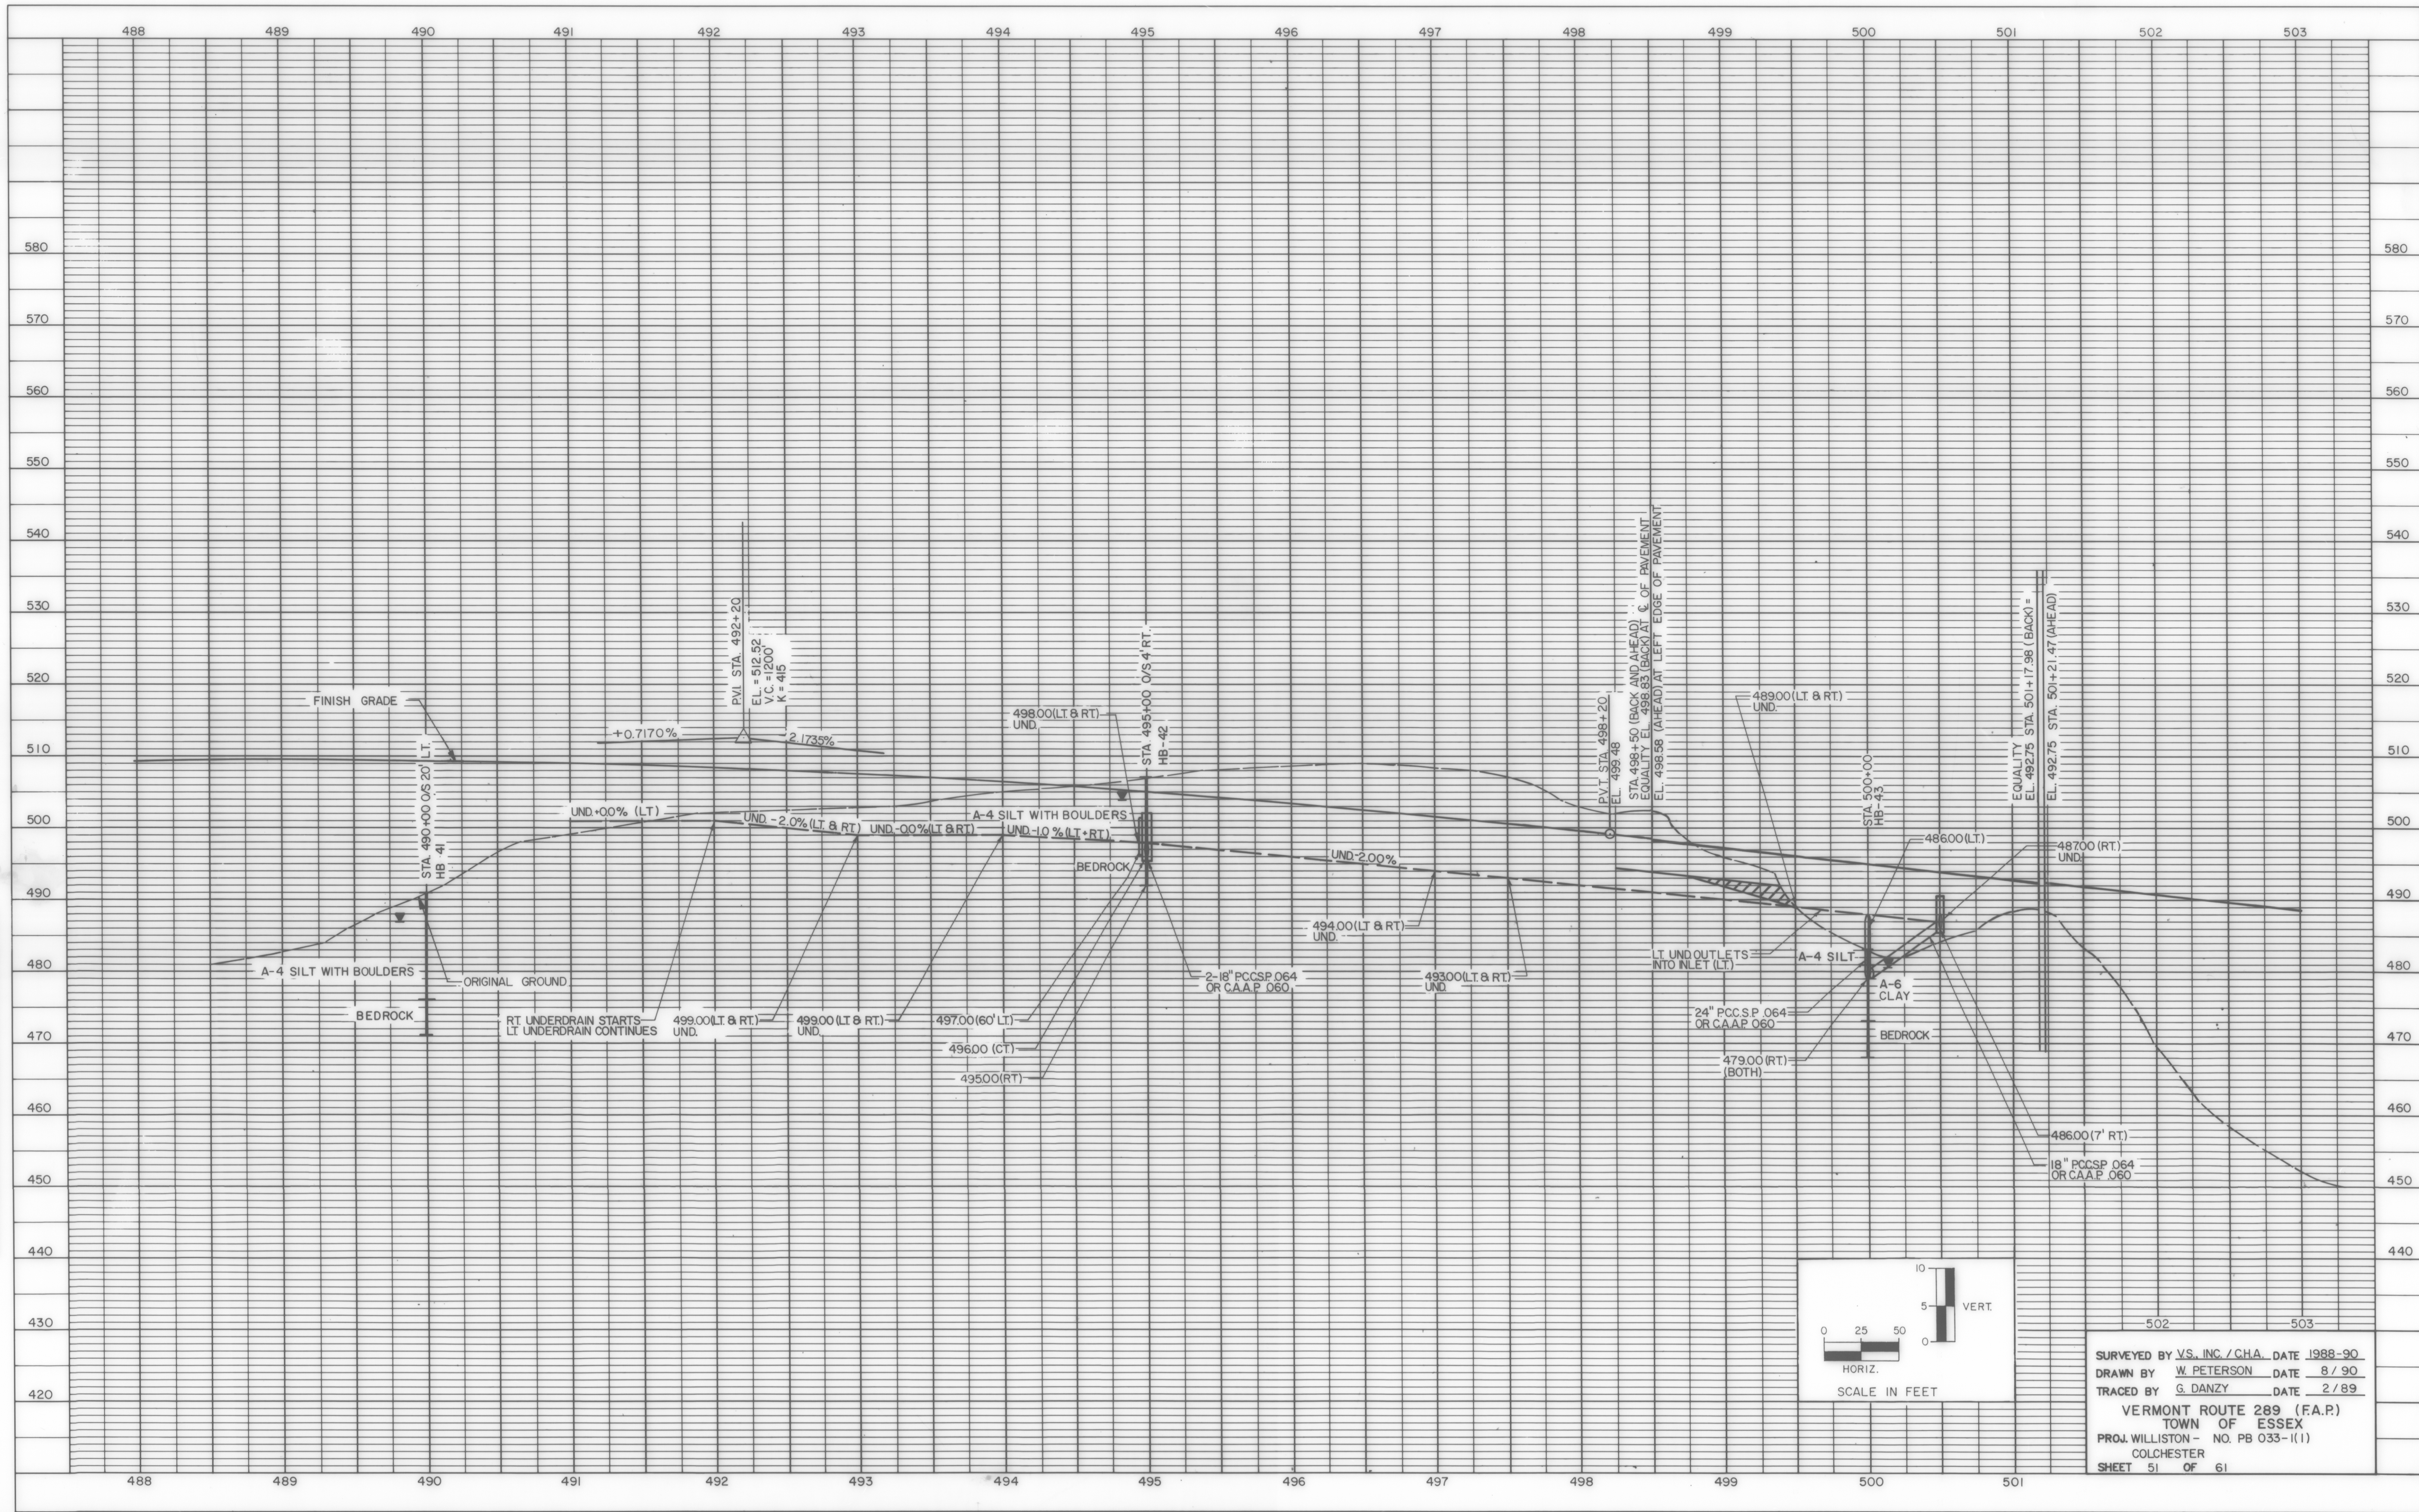

SURVEYED BY V.S. INC. / C.H.A. DATE 1988-90
 DRAWN BY W. PETERSON DATE 8/90
 TRACED BY G. DANZY DATE 2/89
 VERMONT ROUTE 289 (F.A.P.)
 TOWN OF ESSEX
 PROJ. WILLISTON - NO. PB 033-1(1)
 COLCHESTER
 SHEET 51 OF 61