


PROFILE	SURVEYED	BY	DATE
	NOTE BOOK		
	GRADES CHECKED		
	B.M.'s NOTED		
	STRUCTURE NOTATIONS CHECKED		



PROFILE	SURVEYED	BY	DATE
	NOTE BOOK		
	GRADES CHECKED		
	B.M.'s NOTED		
	STRUCTURE NOTATIONS CHECKED		

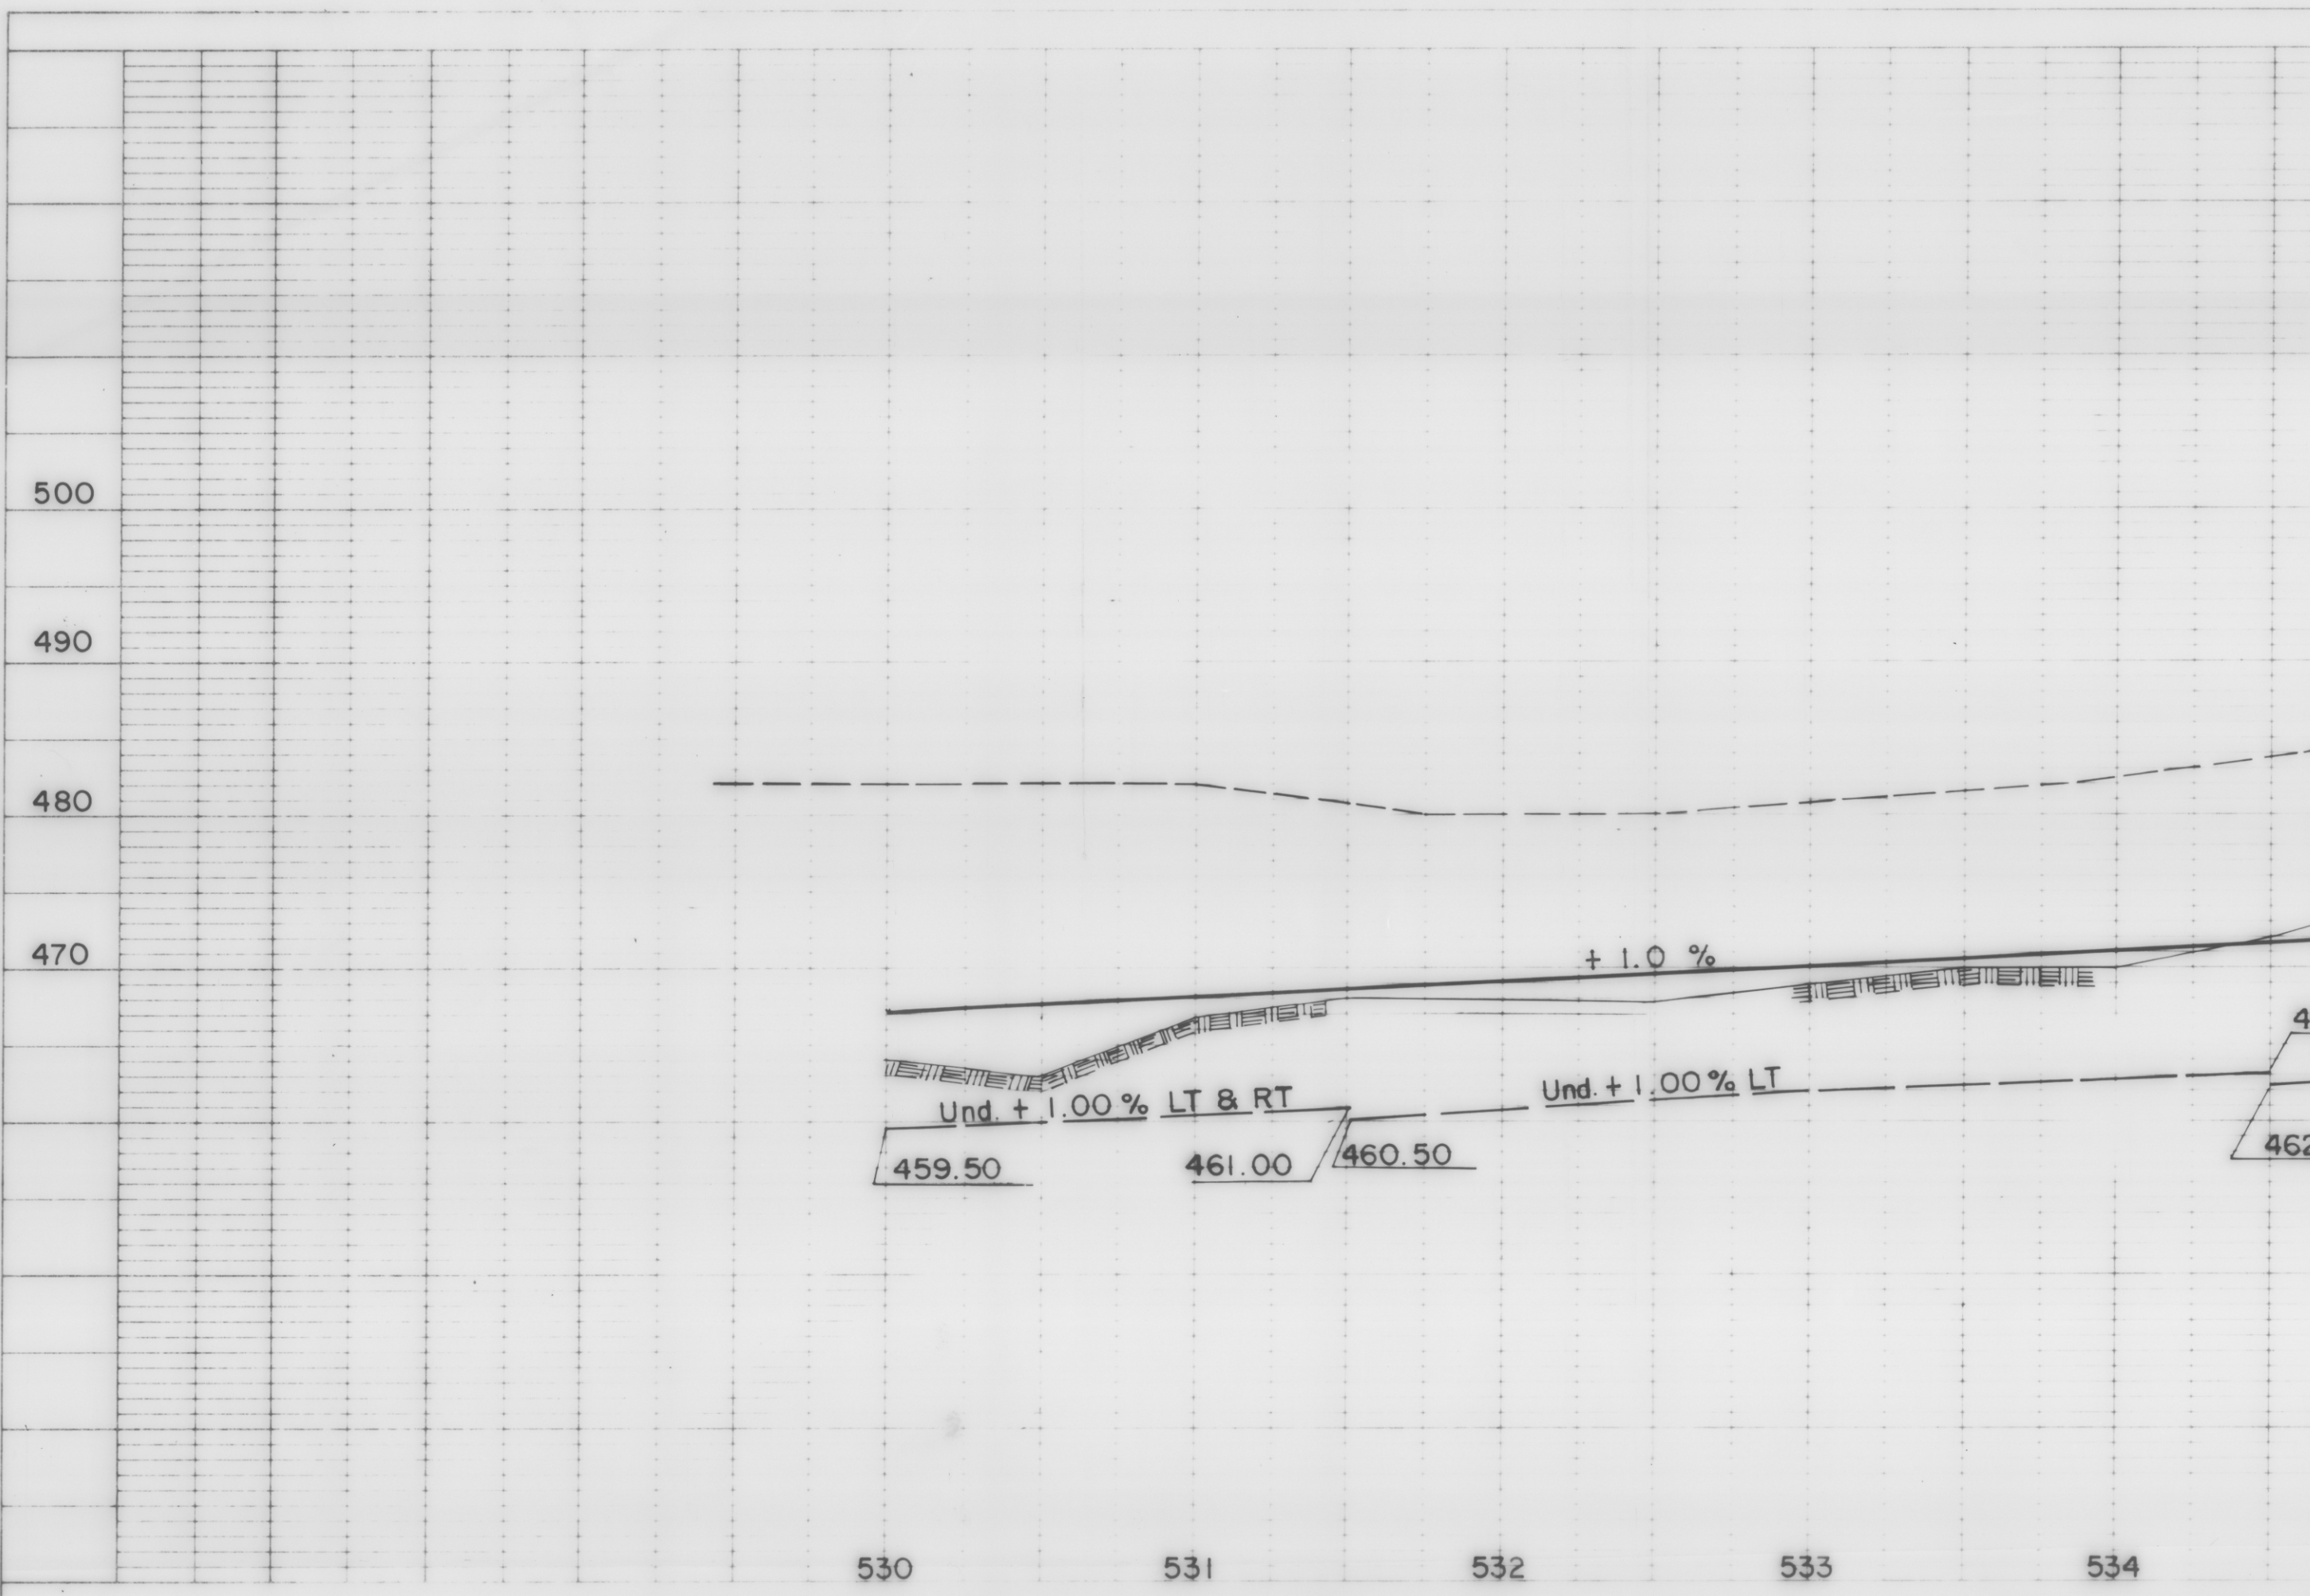