

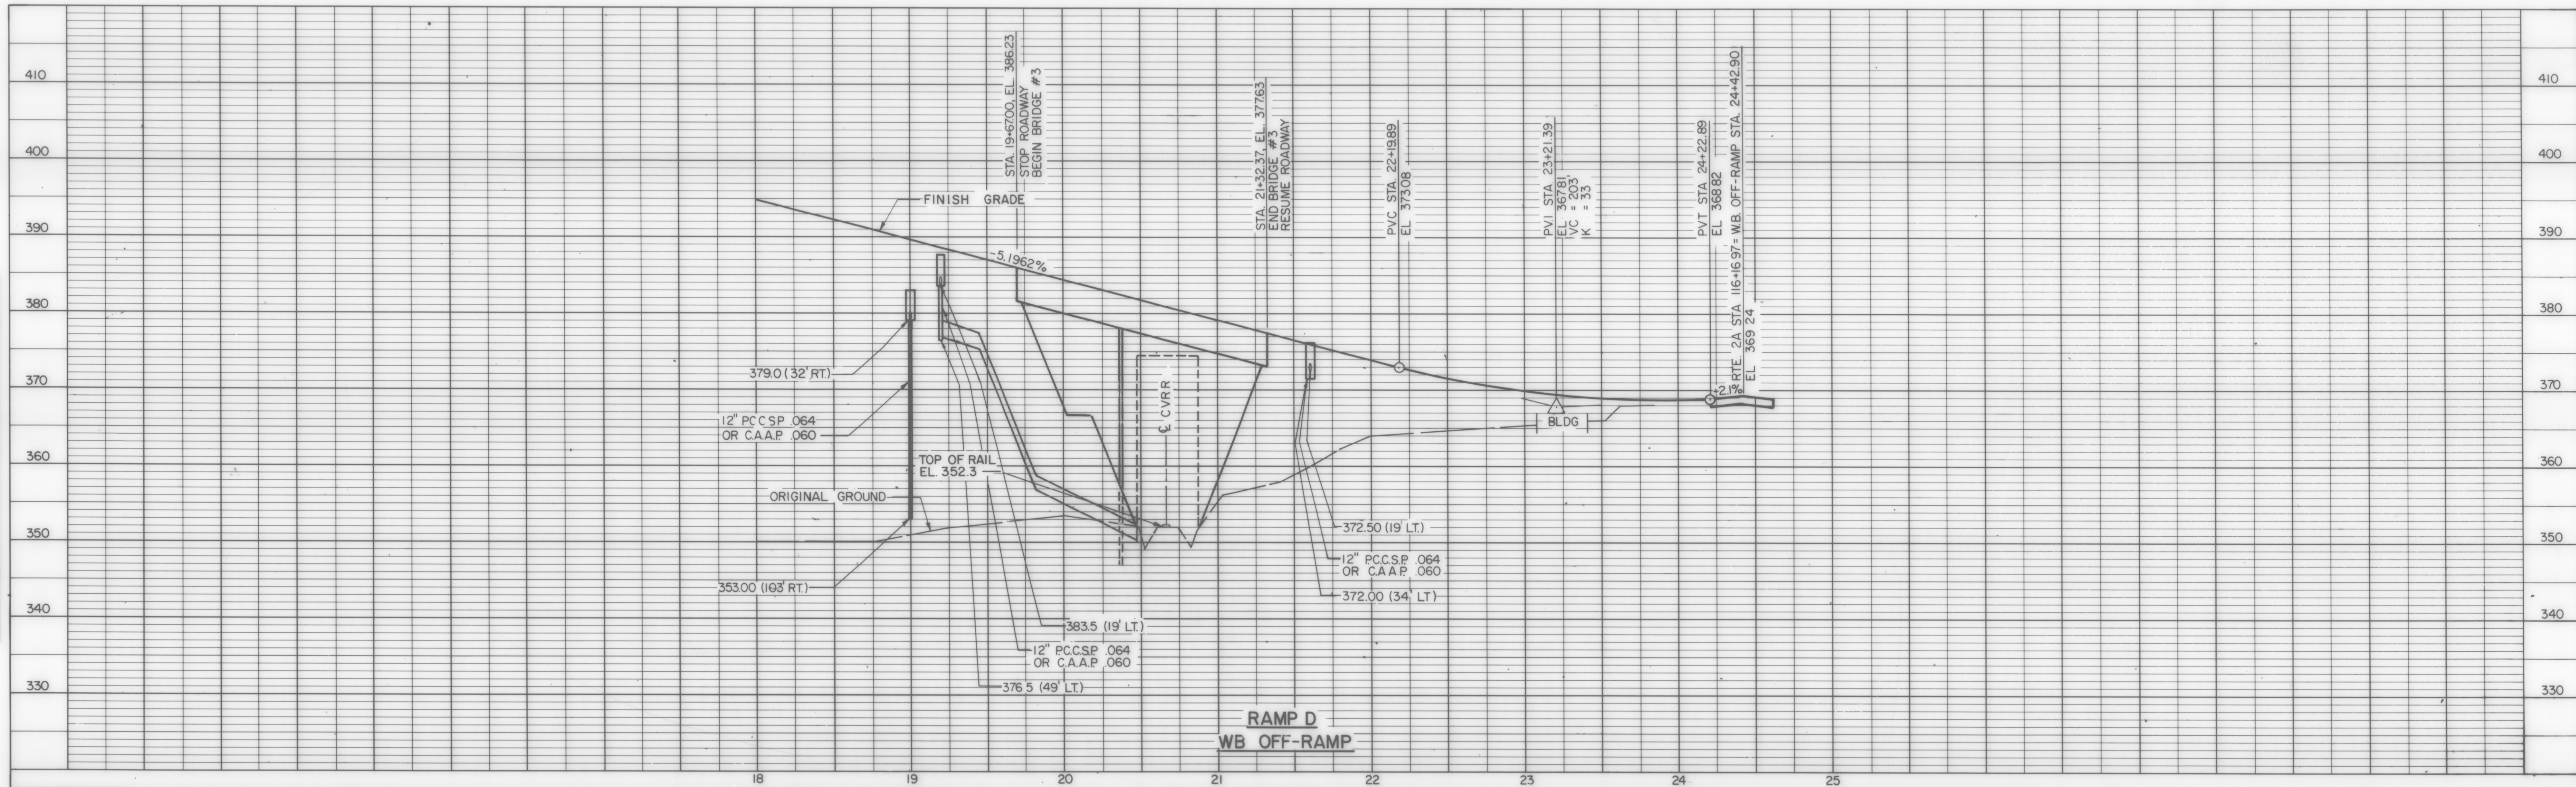


PLAN	SURVEYED	DATE
	PLOTTED	BY
	CHECKED	
	RT. OF WAY CHECKED	
NOTE BOOK NO.		

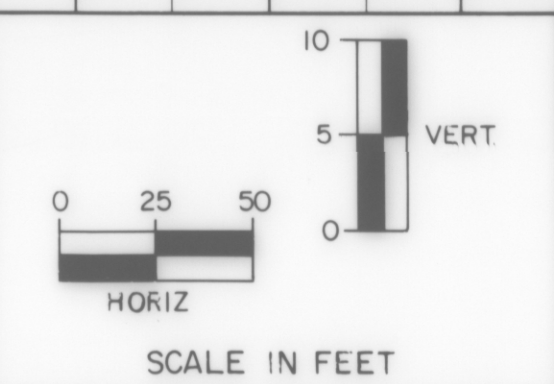

PROFILE	SURVEYED	DATE
	PLOTTED	BY
	CHECKED	
	STRUCTURE NOTATIONS OK'D	
NOTE BOOK NO.		

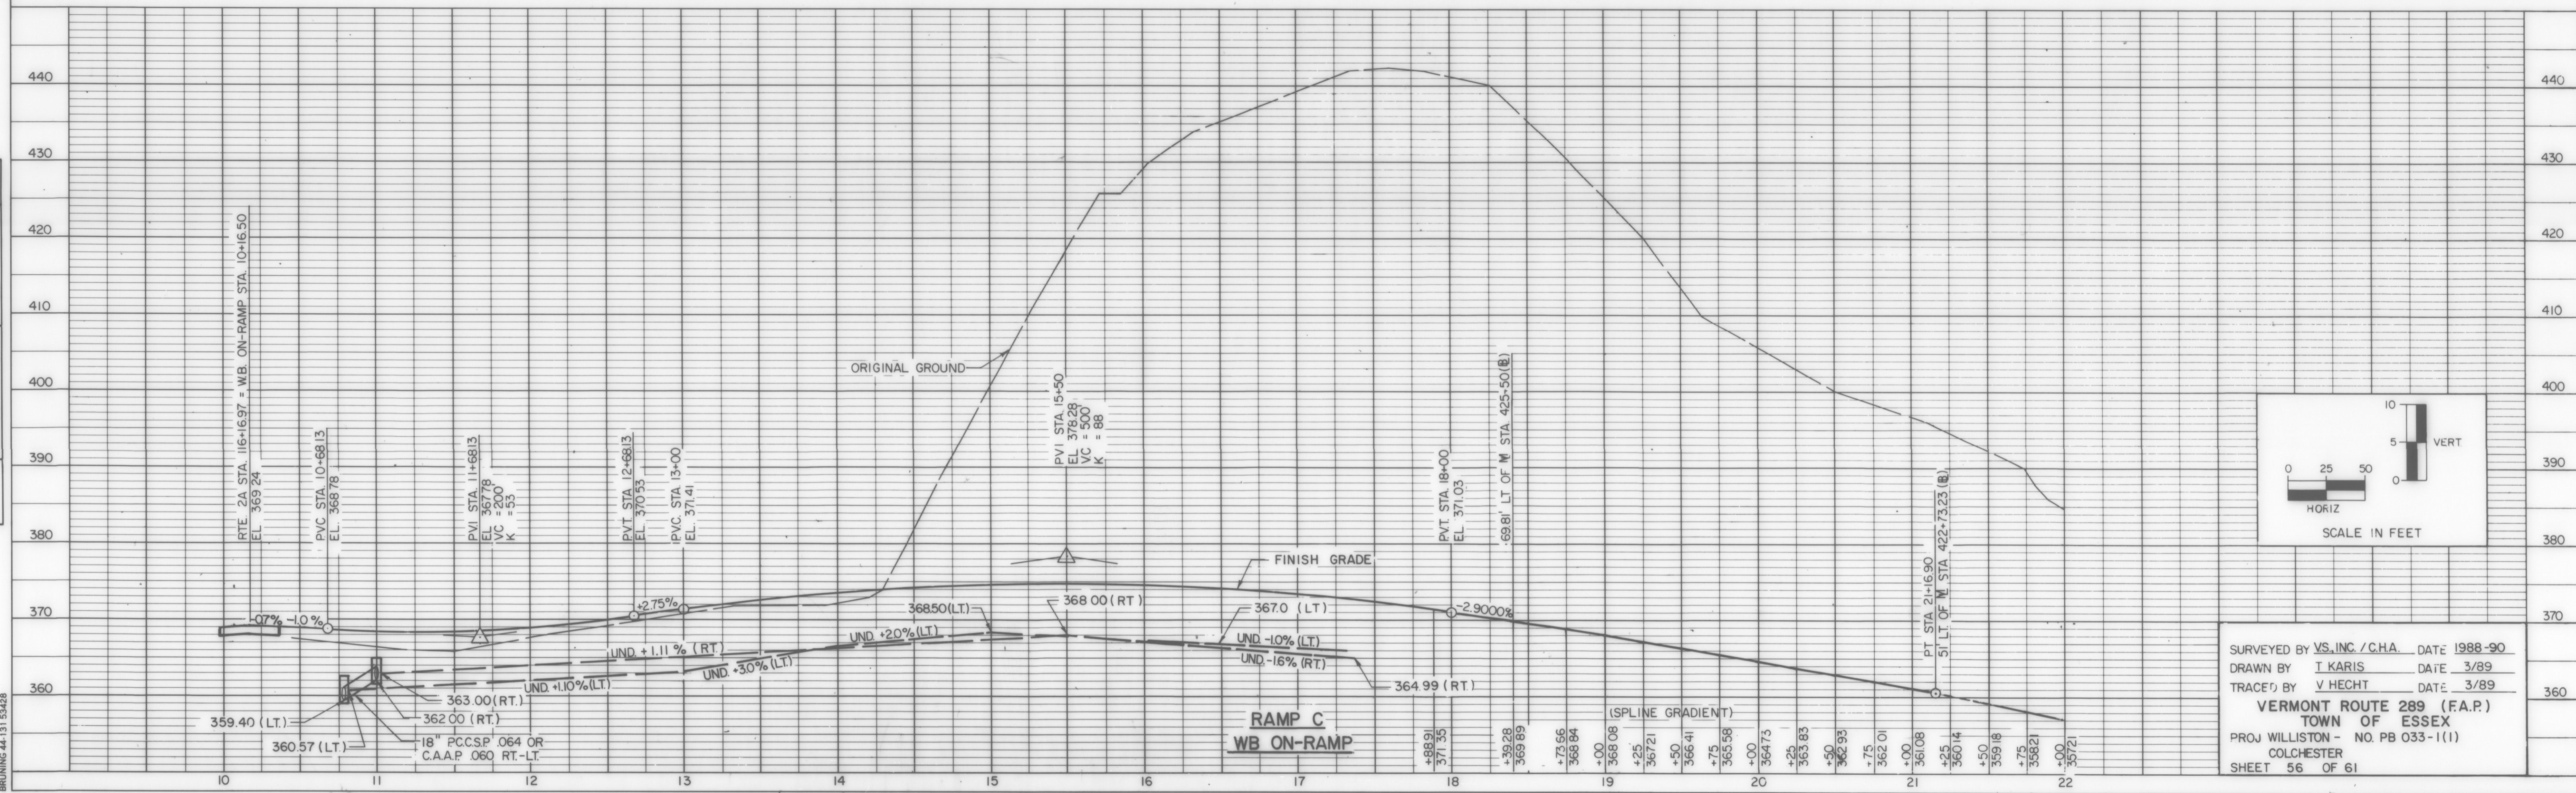

SURVEYED BY VS. INC. / C.H.A. DATE 1988-90
 DRAWN BY I. KARIS DATE 3/89
 TRACED BY V. HECHT DATE 3/89
 VERMONT ROUTE 289 (F.A.P.)
 TOWN OF ESSEX
 PROJ WILLISTON - NO. PB 033-1(1)
 COLCHESTER
 SHEET 56 OF 61