

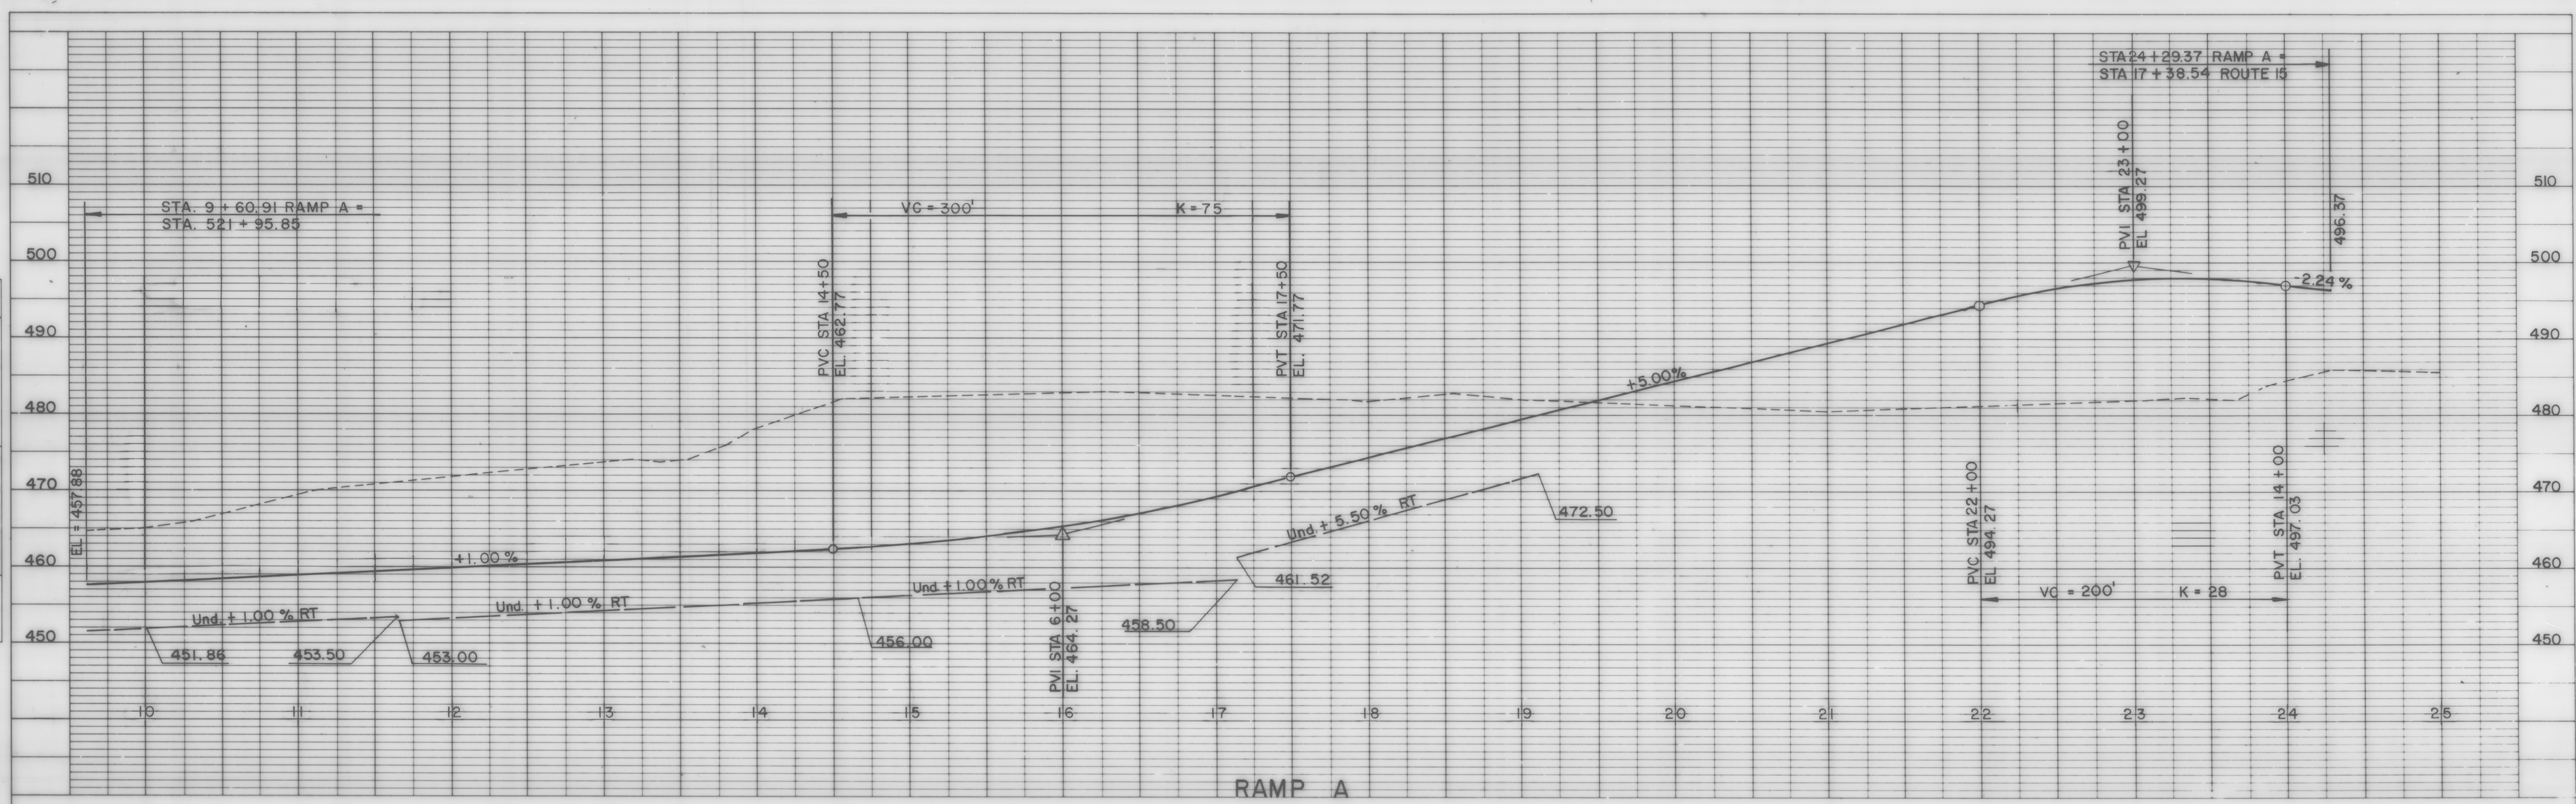


PROFILE	SURVEYED	DATE
	PLOTTED	BY
	GRADES CHECKED	
	NOTE BOOK NO.	

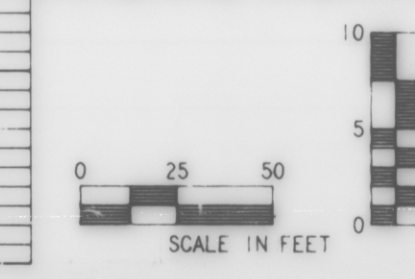

PROFILE	SURVEYED	DATE
	PLOTTED	BY
	GRADES CHECKED	
	NOTE BOOK NO.	

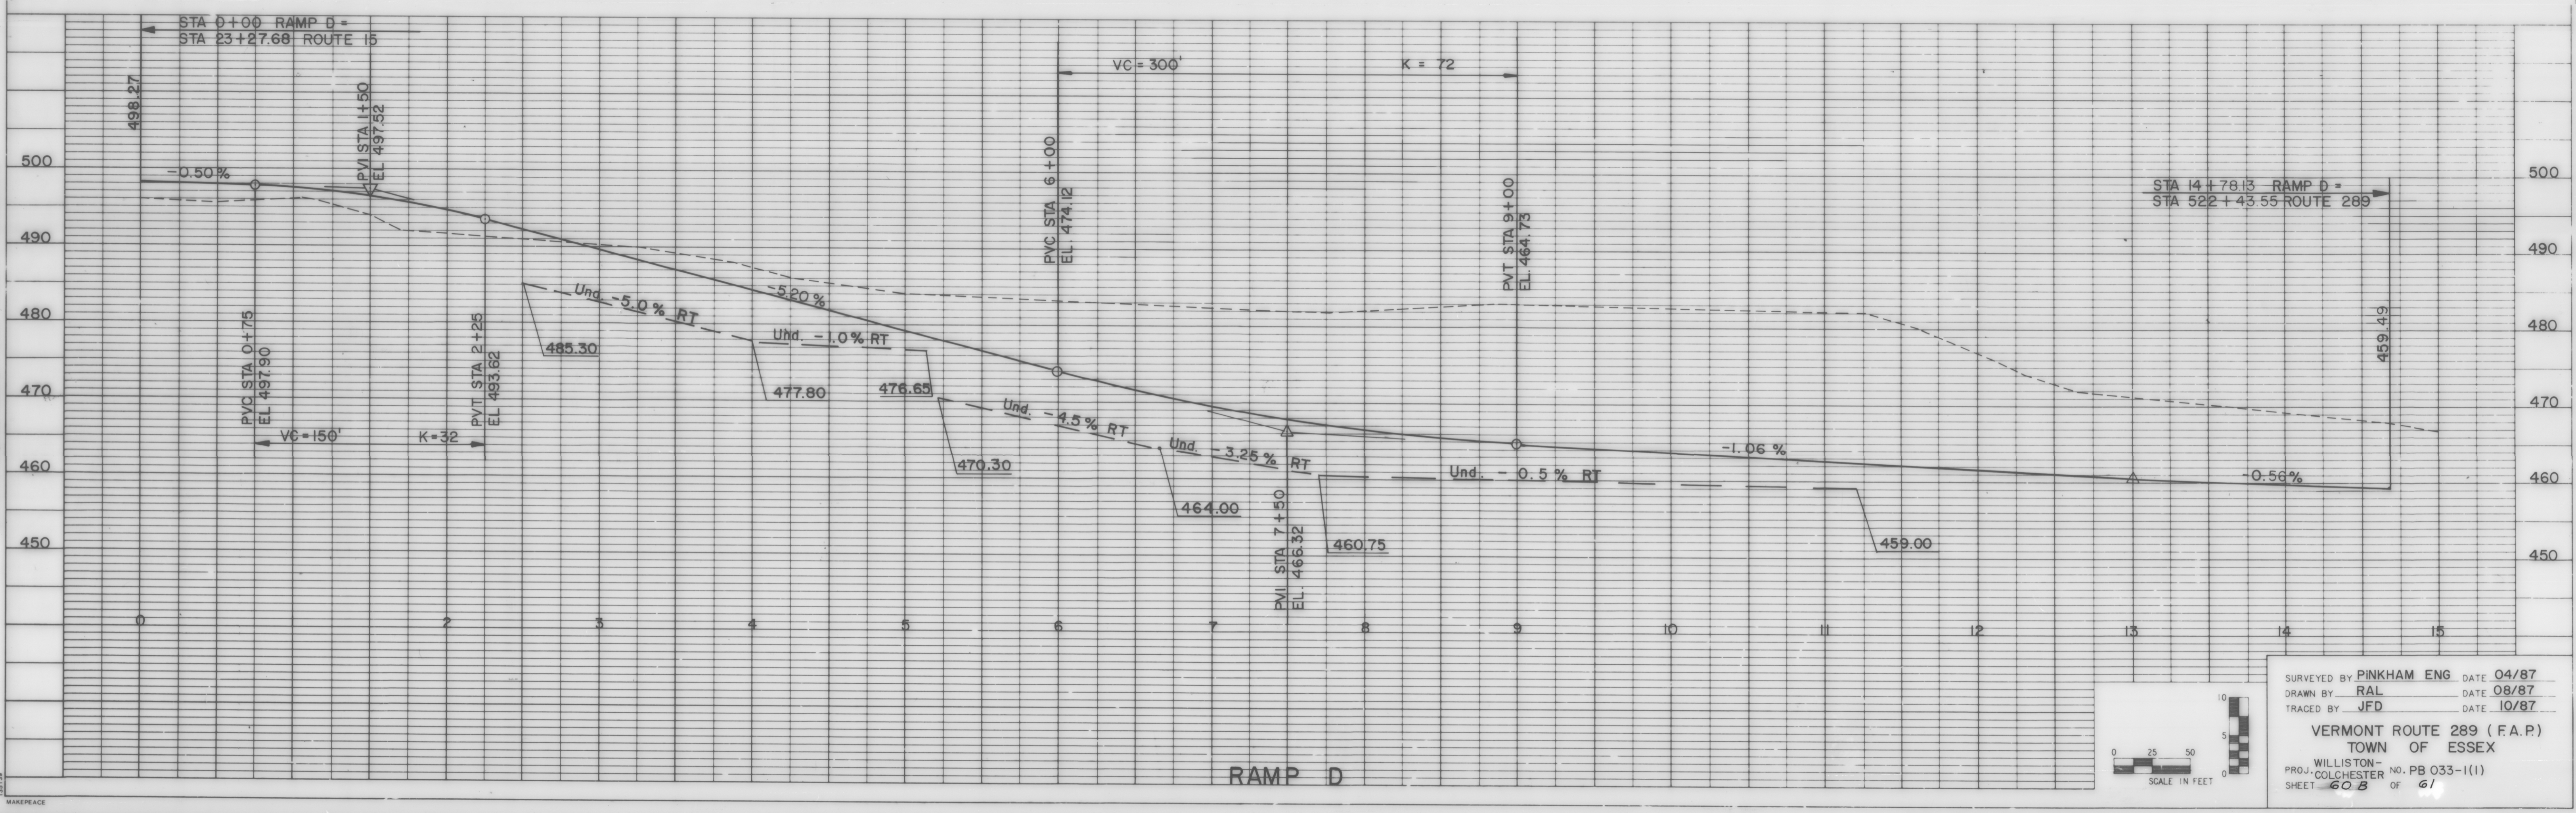

SURVEYED BY PINKHAM ENG DATE 04/87
 DRAWN BY RAL DATE 08/87
 TRACED BY JFD DATE 10/87
 VERMONT ROUTE 289 (F.A.P.)
 TOWN OF ESSEX
 PROJ. WILLISTON- NO. PB 033-1(1)
 SHEET 60 B OF 61

ROUTE 15 INTERCHANGE