


TYPICAL SECTION


- 3" BITUMINOUS CONCRETE PAVEMENT (1-1/4" TYPE
- 3" BASE COURSE, BITUMINOUS CONCRETE, TYPE
- 30" SUBBASE OF DENSE GRADED CRUSHED STONE
- 18" SAND BORROW

SHOULDERS: 1-1/4" BITUMINOUS CONCRETE PAVEMENT, TYPE III


NOTE: DESIGN FROST DEPTH - 54"

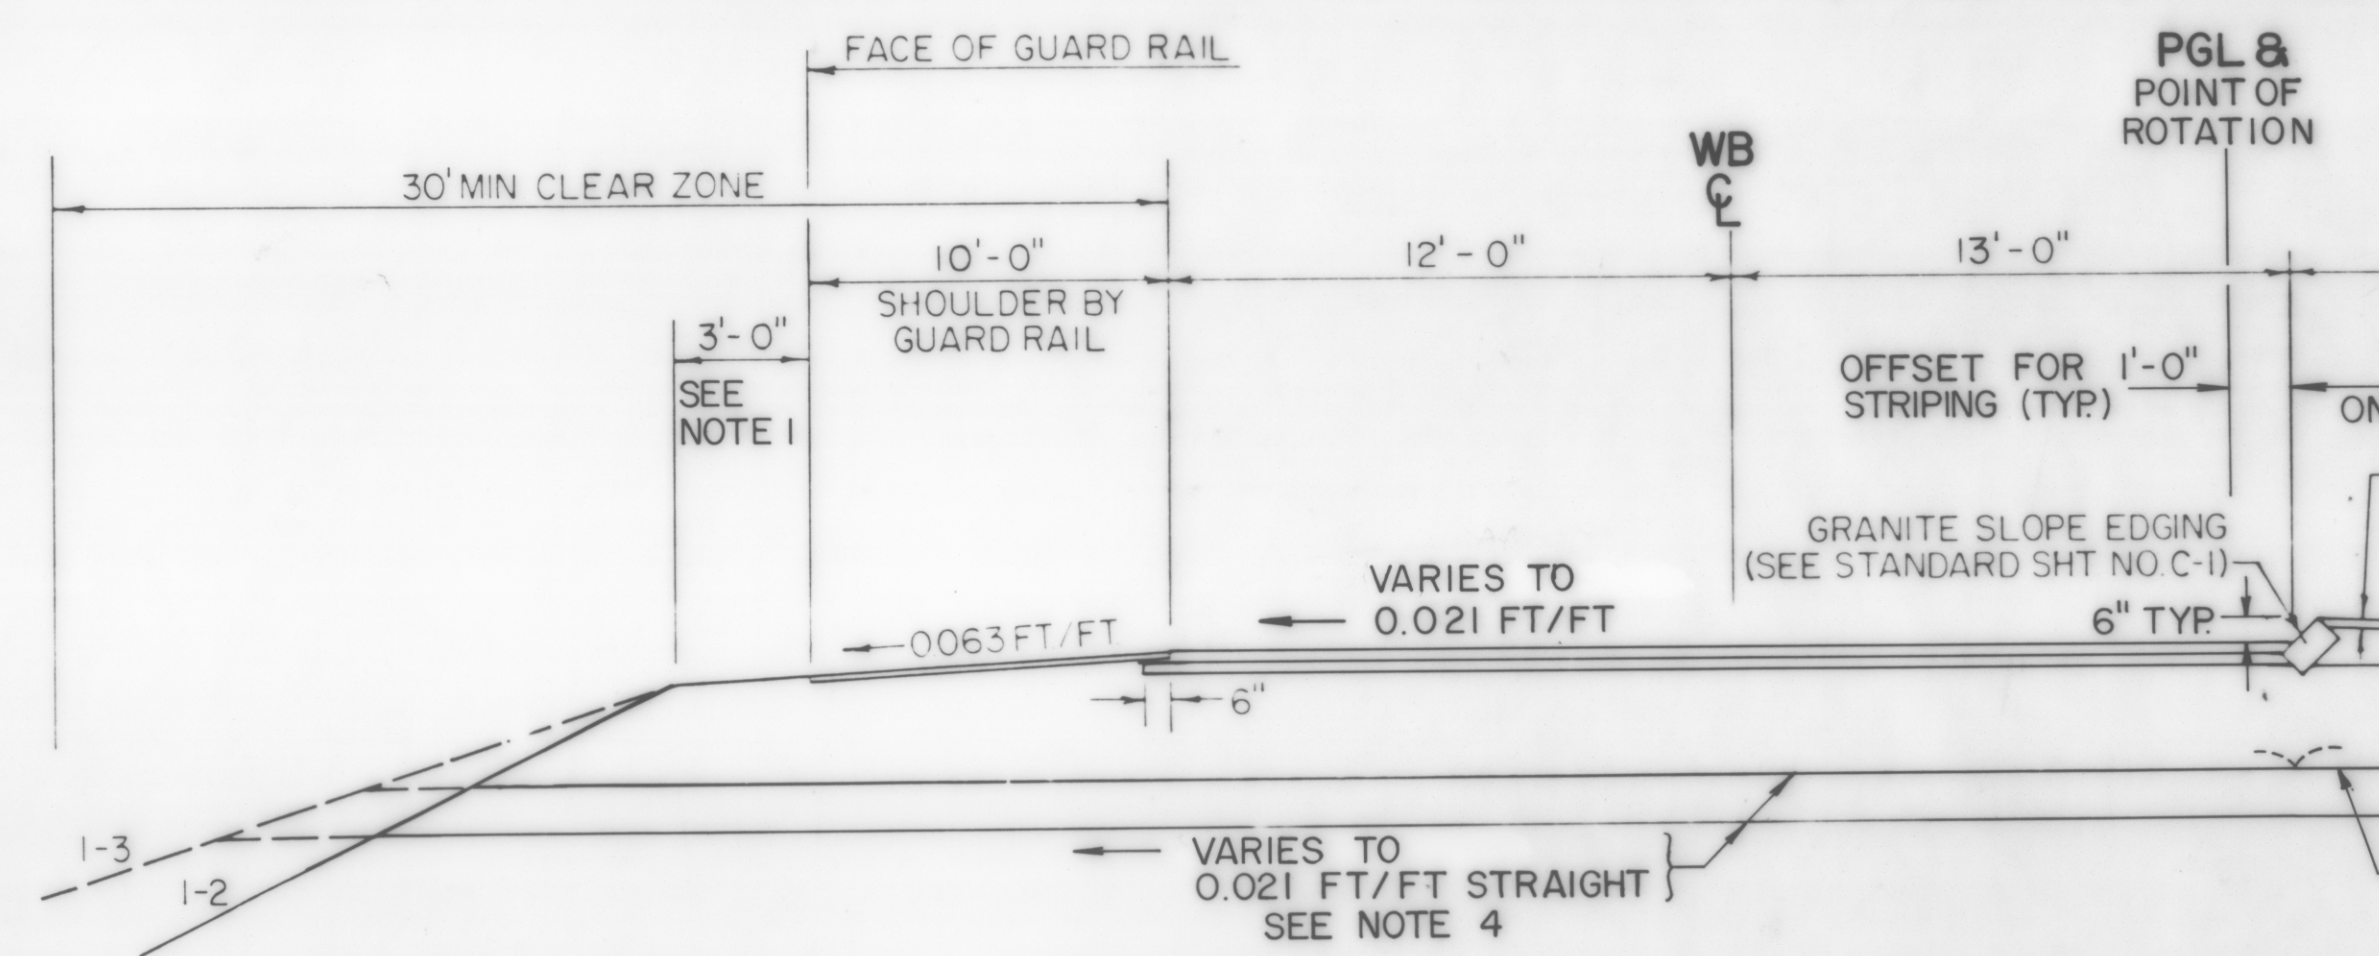

I-89
STA. 22

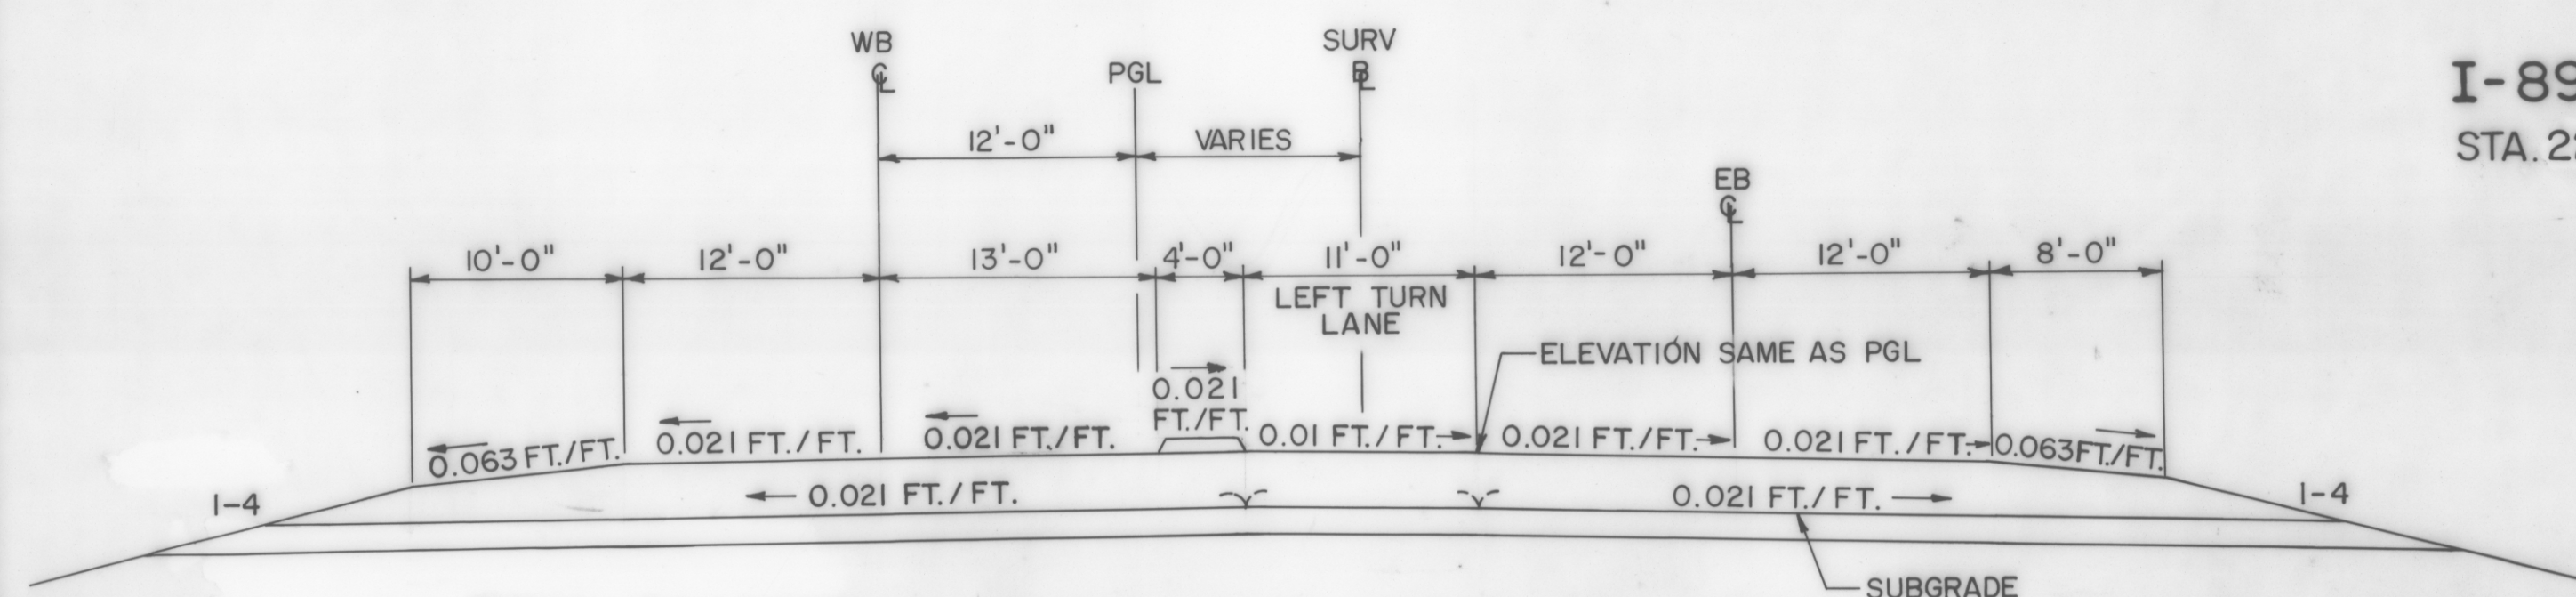

STA. 245+50 TO STA. 246+14

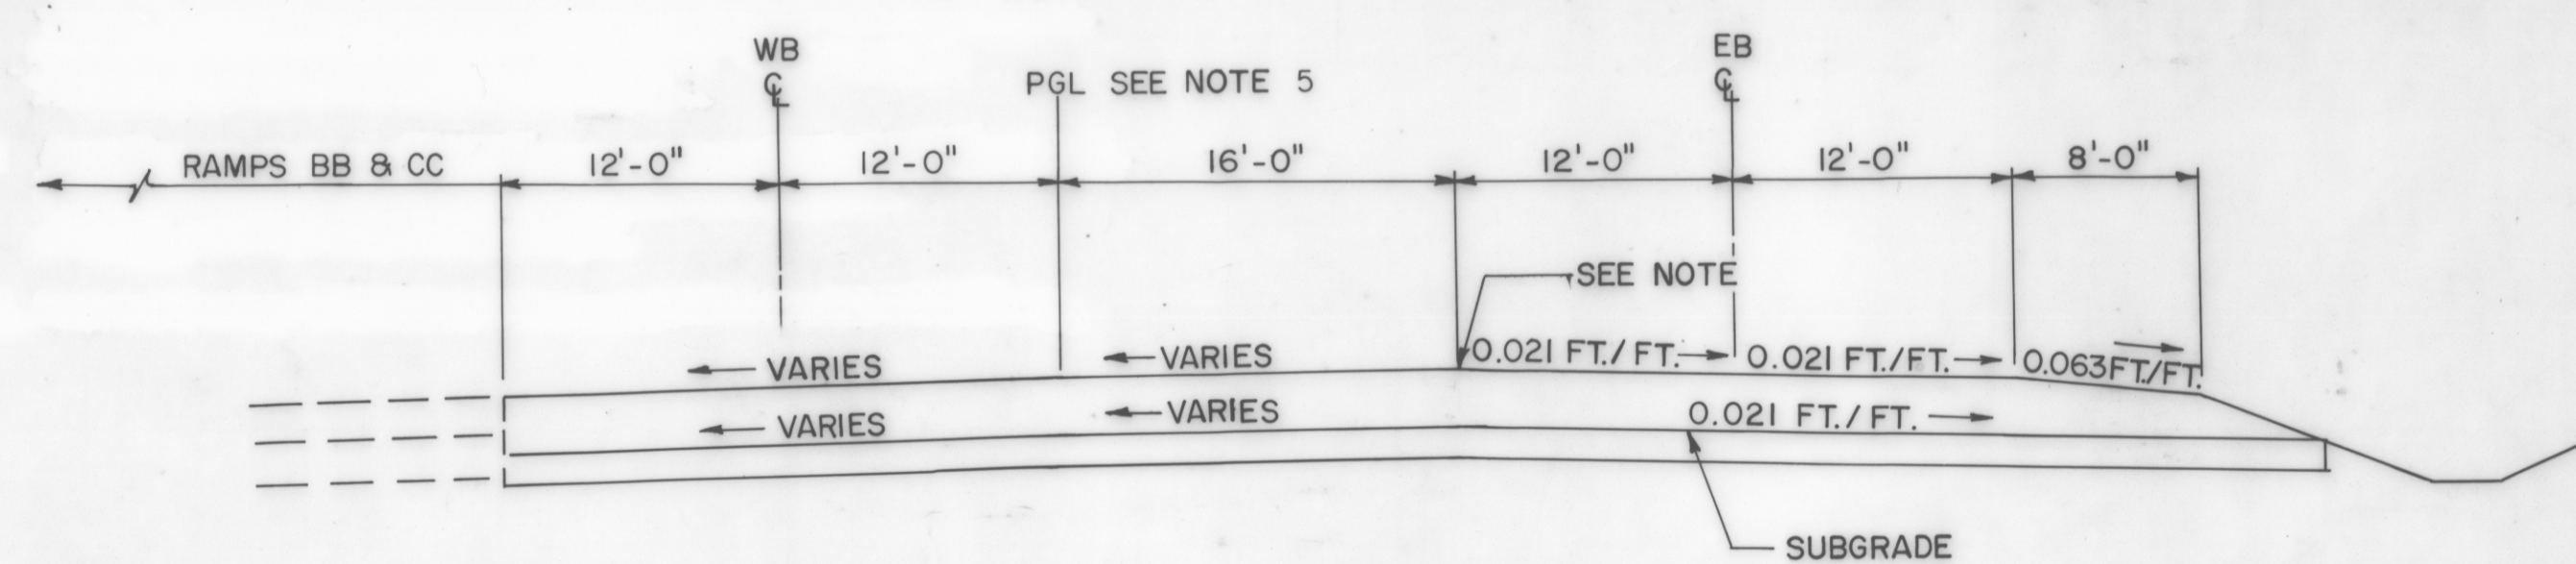

STA. 246+14 TO STA. 246+96